


A TURNING DIAMETER | B CLEAR FLOOR SPACE | C CLEAR FLOOR SPACE PARALLEL APPROACH | D HI & LO SIDE REACH LIMITS

E MAX. FORWARD REACH OVER AN OBSTRUCTION | F MAX. SIDE REACH OVER AN OBSTRUCTION | G MAX. SIDE REACH PARALLEL APPROACH

1 WHEELCHAIR CLEAR FLOOR SPACE AND REACH REQUIREMENTS

N.T.S.

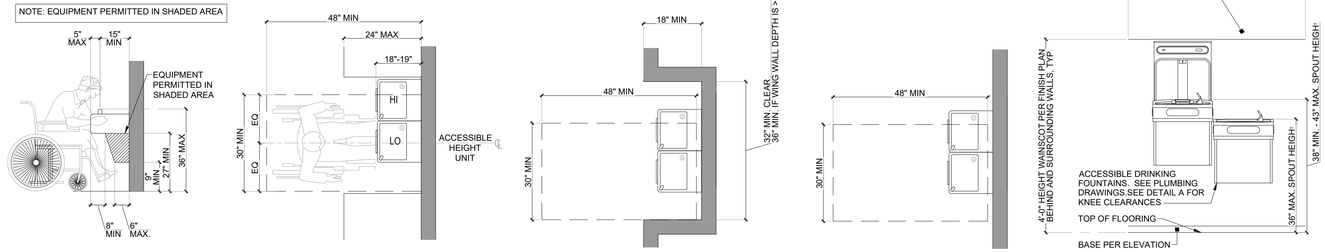


A SPOUT HEIGHT & KNEE CLR. | B CLEAR FLOOR SPACE | C BUILT-IN FOUNTAIN / COOLER | D FREE-STANDING FOUNTAIN / COOLER | E DRINKING FOUNTAIN OUTLET HT.

2 DRINKING FOUNTAIN ADA CLEARANCES


N.T.S.

NOTE:
1. ACCESSIBILITY SIGNAGE: PROVIDE ACRYLIC REVERSE SILK SCREENED SIGNS WITH INTERNATIONAL SYMBOL OF ACCESSIBILITY, RAISED LETTERS, AND BRAILLE, AT ACCESSIBLE TOILET FACILITIES; ONE FOR EACH SEX OR ONE UNISEX.


2. REFER TO ACCESSIBLE SIGNAGE TABLE ON THE ENLARGED RESTROOM SHEETS.

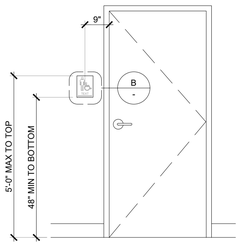

A ELEVATION VIEW

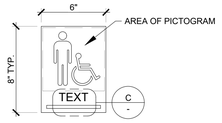


B RESTROOM PLAQUE

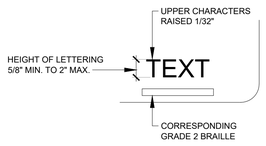


C SIGN VIEW

3 ACCESSIBLE RESTROOM SIGNAGE


1/4" = 1'-0"

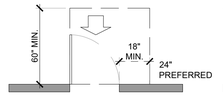


FRONT APPROACH
SWINGING DOOR
PULL SIDE

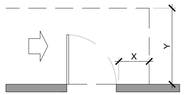


HINGE SIDE APPROACH
SWINGING DOOR
PULL SIDE
NOTE: X=36" MIN. IF Y=60";
X=42" MIN. IF Y=54" MIN.

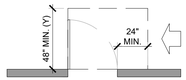


LATCH SIDE APPROACH
SWINGING DOOR
PULL SIDE
NOTE: Y=54" MIN. IF DOOR HAS A CLOSER

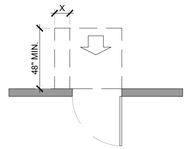

FRONT APPROACH
SWINGING DOOR
PUSH SIDE
NOTE: X=12" MIN. IF DOOR HAS BOTH A LATCH AND A CLOSER

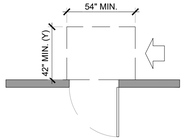

HINGE SIDE APPROACH
SWINGING DOOR
PUSH SIDE
NOTE: Y=48" MIN. IF DOOR HAS BOTH A LATCH AND A CLOSER

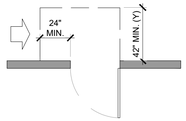


LATCH SIDE APPROACH
SWINGING DOOR
PUSH SIDE
NOTE: Y=48" MIN. IF DOOR HAS A CLOSER

4 MANEUVERING CLEARANCES AT DOORS

N.T.S.

NOTE:
1. TACTILE SIGNAGE SHALL BE ALLOWED ON THE PUSH SIDE OF A DOOR WHEN THE FOLLOWING CONDITIONS EXIST: DOOR HAS A CLOSER, DOOR DOES NOT HAVE A HOLD OPEN DEVICE THAT PREVENTS IT FROM CLOSING.


2. REFER TO ACCESSIBLE SIGNAGE TABLE ON THE ENLARGED RESTROOM SHEETS.

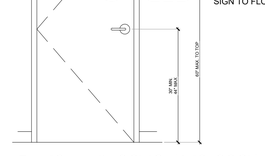


A TACTILE EXIT SIGNAGE (PLASTIC SIGN) | B EXIT SIGN DETAIL

5 TACTILE EXIT SIGNAGE DETAILS


1/4" = 1'-0"

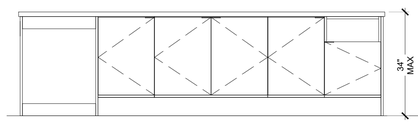


A BEVERAGE COUNTER | A1 BACK COUNTER ELEVATION

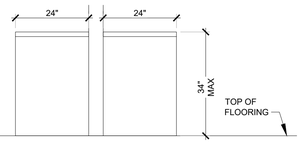


A2 BEVERAGE/BACK COUNTER SIDE ELEVATION

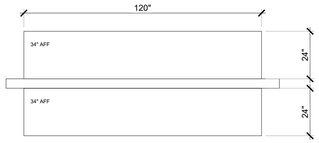


A3 BEVERAGE/BACK COUNTER PLAN VIEW

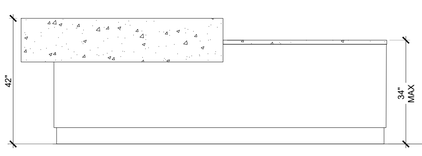

B SALES COUNTER ELEVATION

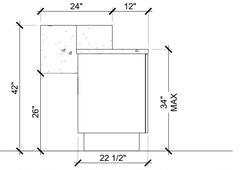

B1 SALES COUNTER SIDE ELEVATION

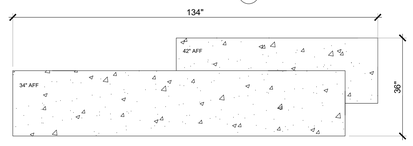


B2 SALES COUNTER PLAN VIEW

#42

6 ADA SERVICE COUNTER ELEVATIONS


N.T.S.

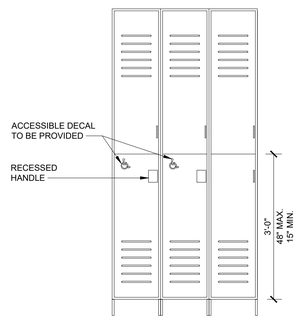

7 ADA COMPLIANT LOCKERS

N.T.S.

NOTE: FIRE EXTINGUISHERS SHALL BE INSTALLED IN ACCORDANCE WITH NFPA 10. OPERABLE PARTS SHALL BE MOUNTED WITHIN ACCESSIBLE REACH RANGES IN ACCORDANCE WITH ANSI A117.1-2009 SECTIONS 308 AND 309. PROVIDE FIRE EXTINGUISHER OPERATING HANDLE AT 48" MAXIMUM A.F.F.

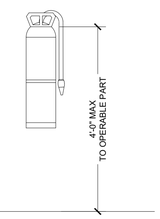

8 FIRE EXTINGUISHER

N.T.S.

TACTILE EXIT SIGNAGE REQUIREMENTS

1. EACH GRADE-LEVEL EXTERIOR DOOR SHALL BE IDENTIFIED BY A TACTILE SIGN WITH THE WORD "EXIT"
2. EACH EXIT DOOR THAT LEADS DIRECTLY TO A GRADE-LEVEL EXTERIOR EXIT BY MEANS OF AN EXIT ENCLOSURE OR AN EXIT PASSAGEWAY IS IDENTIFIED BY A TACTILE EXIT SIGN WITH THE WORDS, "EXIT ROUTE".
3. EACH EXIT DOOR THAT LEADS DIRECTLY TO A GRADE-LEVEL EXTERIOR EXIT BY MEANS OF A STAIRWAY OR RAMP IS IDENTIFIED BY A TACTILE EXIT SIGN THAT STATES "EXIT STAIR DOWN", "EXIT RAMP DOWN", "EXIT STAIR UP" OR "EXIT RAMP UP", AS APPROPRIATE.
4. EACH EXIT ACCESS DOOR FROM AN INTERIOR ROOM OR AREA TO A CORRIDOR OR HALLWAY THAT IS REQUIRED TO HAVE A VISUAL EXIT SIGN IS IDENTIFIED BY A TACTILE EXIT SIGN WITH THE WORDS, "EXIT ROUTE".
5. EACH EXIT DOOR THROUGH A HORIZONTAL EXIT SHALL BE IDENTIFIED BY A SIGN WITH THE WORDS, "TO EXIT".
6. LETTERS ON SIGNS ARE RAISED 1/32", SANS SERIF UPPERCASE CHARACTERS AND ARE ACCOMPANIED BY GRADE 2 BRAILLE.
7. RAISED CHARACTERS ARE BETWEEN 5/8" AND 2" HIGH.
8. BRAILLE DOTS ARE 1/10" ON CENTER IN EACH CELL WITH 2/10" SPACE BETWEEN CELLS, MEASURED FROM THE SECOND COLUMN OF DOTS IN THE FIRST CELL TO THE FIRST COLUMN OF DOTS IN THE SECOND CELL. [NOTE: CA AND OTHER JURISDICTIONS ONLY]
9. BRAILLE DOTS ARE RAISED A MIN. OF 1/40" ABOVE THE BACKGROUND.
10. CHARACTERS AND BACKGROUND OF SIGNS IS EGGSHELL, MATTE, OR OTHER NON-GLARE FINISH.
11. CHARACTERS CONTRAST WITH THEIR BACKGROUND (LIGHT CHARACTERS ON A DARK BACKGROUND, OR DARK CHARACTERS ON A LIGHT BACKGROUND.
12. LETTERS ON SIGNS HAVE A WIDTH-TO-HEIGHT RATIO BETWEEN 3:5 AND 1:1 AND A STROKE WIDTH-TO-HEIGHT BETWEEN 1:5 AND 1:10.
13. SIGNS ARE TO BE INSTALLED ON THE WALL ADJACENT TO THE LATCH SIDE OF THE DOOR. (AT DOUBLE LEAF DOORS AND WHEN THERE IS NO WALL SPACE AT THE LATCH SIDE, SIGNS SHALL BE PLACED ON THE NEAREST ADJACENT WALL, PREFERABLY ON THE RIGHT.)
14. MOUNTING HEIGHT IS 60" MAX. FROM THE FINISHED FLOOR TO THE TOP OF THE SIGN.
15. MOUNTING LOCATION ALLOWS A PERSON TO APPROACH WITHIN 3" OF THE SIGNAGE WITHOUT ENCOUNTERING PROTRUDING OBJECTS OR STANDING WITHIN THE SWING OF A DOOR.

SARGENTI
5840 LEGACY CIR - STE D230, PLANO, TX 75024
T|201.316.5491 ■ WWW.SARGARCH.COM

SEAL:

STATE OF COLORADO ★ ROBERT J. SARGENTI 305929 ★ LICENSED ARCHITECT

DATE SIGNED: 10/15/2026

CONTRACTOR'S NOTES:

WRITTEN DIMENSIONS HOLD PREFERENCE OVER SCALED DIMENSIONS. DO NOT SCALE THE DRAWINGS. THE CONTRACTORS MUST VISIT JOB SITE TO VERIFY ALL EXISTING CONDITIONS AND DIMENSIONS BEFORE SUBMITTING BIDS. REPORT ANY DISCREPANCIES OF ANY CONDITIONS WHICH MAY INTERFERE WITH THE PROPER EXECUTION OF, THE CONTRACT TO THE TENANT'S REPRESENTATIVE. REPORT DISCREPANCIES DURING BIDDING PROCESS AND BEFORE START OF CONSTRUCTION. CHANGE ORDERS NEED TO BE APPROVED BY THE CONSTRUCTION MANAGER FOR ISSUES ARISING FROM THE FIELD CONDITIONS OR CONFLICTS BETWEEN THE PLANS AND THE EXISTING CONDITIONS PRIOR TO THE COMMENCEMENT OF WORK.

DATE	ISSUE

△ DATE	REVISION

LOCATION:

Consumer Cellular

8283 S. AKRON ST.
SUITE #110
CENTENNIAL, CO 80112

STORE NUMBER:

CO2

PROJECT INFORMATION:

DATE: 10/14/2026
PROJECT NUMBER: 15066 - 26
STORE TYPE: TIER 2
DRAWN BY: GV REVIEWED BY: AN

TITLE:

ACCESSIBILITY DETAILS (ADAAG)

SHEET NUMBER:

G002


SHEET SYMBOLS

- # — SEE SHEET A600 FOR WALL CONFIGURATION, CONSTRUCTION AND INSULATION DETAILS
- EXISTING AREA N.I.C.
- DECK HEIGHT / DECK TYPE @ XX'-X" / DECK TYPE
- EXISTING DOOR. PATCH AND REPAIR TO "AS-NEW" CONDITION AS NECESSARY
- NEW DOOR AS SCHEDULED
- # - DOOR NUMBER / DOOR TYPE

NOTE: SEE SHEET A600 FOR DOOR SCHEDULE AND DETAILS.

GENERAL NOTES

1. G.C. TO FIELD VERIFY ALL DIMENSIONS AND NOTIFY ARCHITECTS IMMEDIATELY OF ANY DISCREPANCIES OR UNFORESEEN ITEMS NOT SHOWN ON DRAWINGS.
2. FOR ALL PARTITION CONNECTION DETAILS (TOP AND BOTTOM) SEE SHEET A500.
3. ALL ANGLED WALLS ARE 45°, 90°, OR 135° U.O.N.
4. MAINTAIN FIRE RESISTANCE RATING FOR ALL TENANT DEMISING WALLS.
5. PROVIDE WATER RESISTANT GYPSUM BOARD AT ALL WET LOCATIONS (UTILITY SINK, KITCHENETTE, DRINKING FOUNTAIN, TOILET ROOM, ETC.)
6. G.C. TO COORDINATE LOCATION OF ELECTRICAL FLOOR BOXES WITH ELECTRICAL DRAWINGS AND FIXTURE PLAN.
7. WHERE EXISTING INSULATION IS REMOVED OR MISSING, PATCH AND REPLACE INSULATION TO MATCH EXISTING CONDITIONS AND MAINTAIN REQUIRED R-VALUES.
8. ALL DOORS TO BE LOCATED 4" FROM PERPENDICULAR WALL UNLESS OTHERWISE NOTED. ALL DOORS DIMENSIONED TO ROUGH OPENING OF DOOR.
9. ALL DIMENSIONS ARE FROM FACE OF GYPSUM BOARD TO FACE OF GYPSUM BOARD UNLESS OTHERWISE NOTED.
10. SLAB PENETRATIONS SHALL BE MADE WITH PROPER LOCATION AND X-RAY IDENTIFICATION OF EXISTING REBAR AND/OR POST TENSION CABLES.
11. GYPSUM BOARD INSTALLED IN WET AREAS SUCH AS KITCHENS AND RESTROOMS SHALL BE AT LEAST WATER RESISTANT (GREEN BOARD) OR AN EQUIVALENT WATERPROOF SHEATHING MATERIAL.

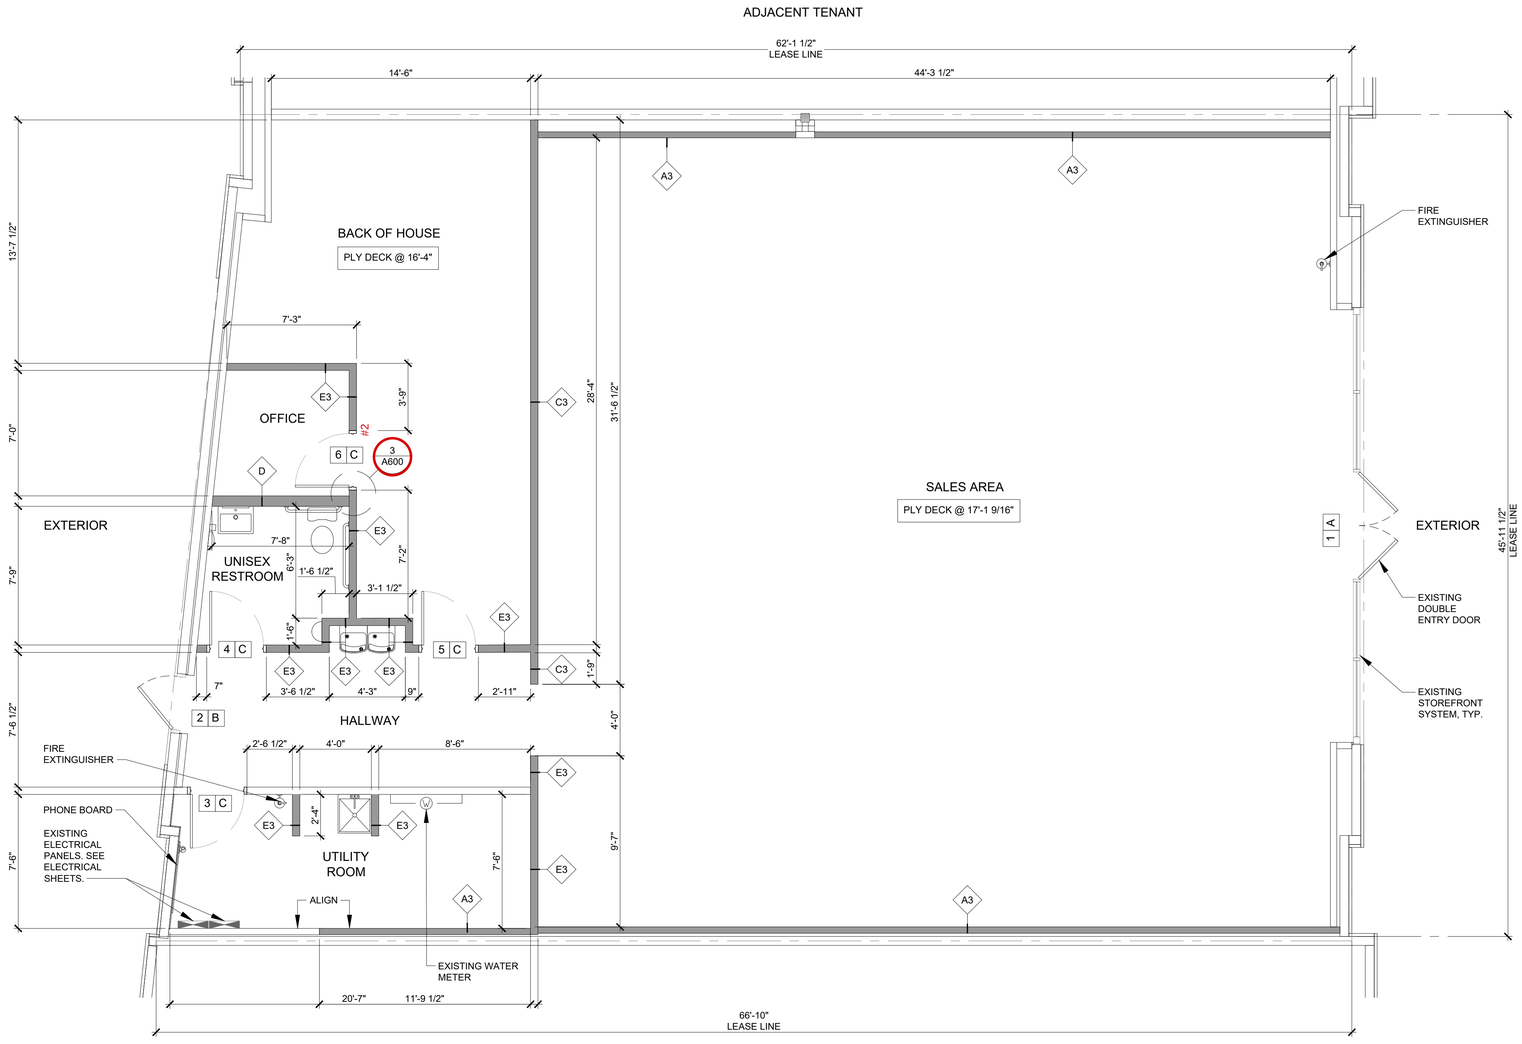

1 CONSTRUCTION FLOOR PLAN
1/4" = 1'-0"

SARGENTI
5840 LEGACY CIR - STE D230, PLANO, TX 75024
T|201.316.5491 ■ WWW.SARGARCH.COM

SEAL:

STATE OF COLORADO ★ ROBERT J. SARGENTI 305929 ★ LICENSED ARCHITECT

DATE SIGNED: 10/15/2026

CONTRACTOR'S NOTES:

WRITTEN DIMENSIONS HOLD PREFERENCE OVER SCALED DIMENSIONS. DO NOT SCALE THE DRAWINGS. THE CONTRACTORS MUST VISIT JOB SITE TO VERIFY ALL EXISTING CONDITIONS AND DIMENSIONS BEFORE SUBMITTING BIDS. REPORT ANY DISCREPANCIES OF ANY CONDITIONS WHICH MAY INTERFERE WITH THE PROPER EXECUTION OF, THE CONTRACT TO THE TENANT'S REPRESENTATIVE. REPORT DISCREPANCIES DURING BIDDING PROCESS AND BEFORE START OF CONSTRUCTION. CHANGE ORDERS NEED TO BE APPROVED BY THE CONSTRUCTION MANAGER FOR ISSUES ARISING FROM THE FIELD CONDITIONS OR CONFLICTS BETWEEN THE PLANS AND THE EXISTING CONDITIONS PRIOR TO THE COMMENCEMENT OF WORK.

	DATE	ISSUE
△	DATE	REVISION

LOCATION:

Consumer Cellular

8283 S. AKRON ST.
SUITE #110
CENTENNIAL, CO 80112

STORE NUMBER:

CO2

PROJECT INFORMATION:

DATE: 10/14/2026
PROJECT NUMBER: 15066 - 26
STORE TYPE: TIER 2
DRAWN BY: GV REVIEWED BY: AN

TITLE:

CONSTRUCTION FLOOR PLAN

SHEET NUMBER:

A100

SHEET SYMBOLS

ROOM NAME
FLR-#
B-#
PT-#

FLOOR FINISH TAG
BASE FINISH TAG
WALL FINISH TAG

EXISTING AREA N.I.C.


18"X18" VCT

12"X24" LVT

NOTE: ALL EQUIPMENT, FINISHES, FIXTURES AND FURNITURE TO BE INSTALLED PER MANUFACTURER'S RECOMMENDATIONS. SEE SHEET A700 FOR ALL SCHEDULES.

GENERAL NOTES

1. SEE SHEET A502 FOR FLOOR TRANSITION AND BASE DETAILS.
2. PREPARE EXISTING FLOOR SURFACE PER MANUFACTURER SPECIFICATIONS FOR INSTALLATION OF NEW FLOORING MATERIALS AS INDICATED IN THESE PLANS. SEE SPECIFICATIONS AND MANUFACTURER INSTRUCTIONS FOR ADDITIONAL FLOOR INSTALLATION NOTES. CLEAN AND FINISH FLOOR PER MANUFACTURER INSTRUCTIONS.
3. FOR FLOOR FINISHES, COMPLY WITH THESE RECOMMENDATIONS AT MINIMUM OR NOT LESS THAN MANUFACTURER'S WRITTEN INSTRUCTIONS. REFER TO MANUFACTURER'S INSTALLATION SPECIFICATIONS FOR ALL FINISHES INCLUDING FLOOR LEVELING REQUIREMENTS, EXPANSION SPACES, VAPOR BARRIERS, UNDERLAYMENT, SITE CONDITIONS, ETC.
   - 3.1. SUBFLOOR PREPARATION: GRIND HIGH SPOTS AND FILL LOW SPOTS TO PRODUCE A MAXIMUM 1/8" (3-MM) DEVIATION IN ANY DIRECTION WHEN CHECKED WITH A 10' (3-M) STRAIGHT EDGE
   - 3.2. EXPANSION: PROVIDE EXPANSION SPACE AT WALLS AND OTHER OBSTRUCTIONS AND TERMINATIONS OF FLOORING OF NOT LESS THAN DIRECTED BY MANUFACTURER.
   - 3.3. PROTECTION: PROVIDE FLOOR PROTECTION UP UNTIL FINAL CLEANING.
4. CENTER FLOORING WITHIN EACH ROOM. FIRST PLANK SHOULD BE CENTERED BETWEEN THE DEMISING WALLS AND PLACED SO THAT PARTIAL PLANKS ARE NEAR THE DEMISING WALLS AND UNDERNEATH THE SYSTEM WALL UNLESS OTHERWISE NOTED.

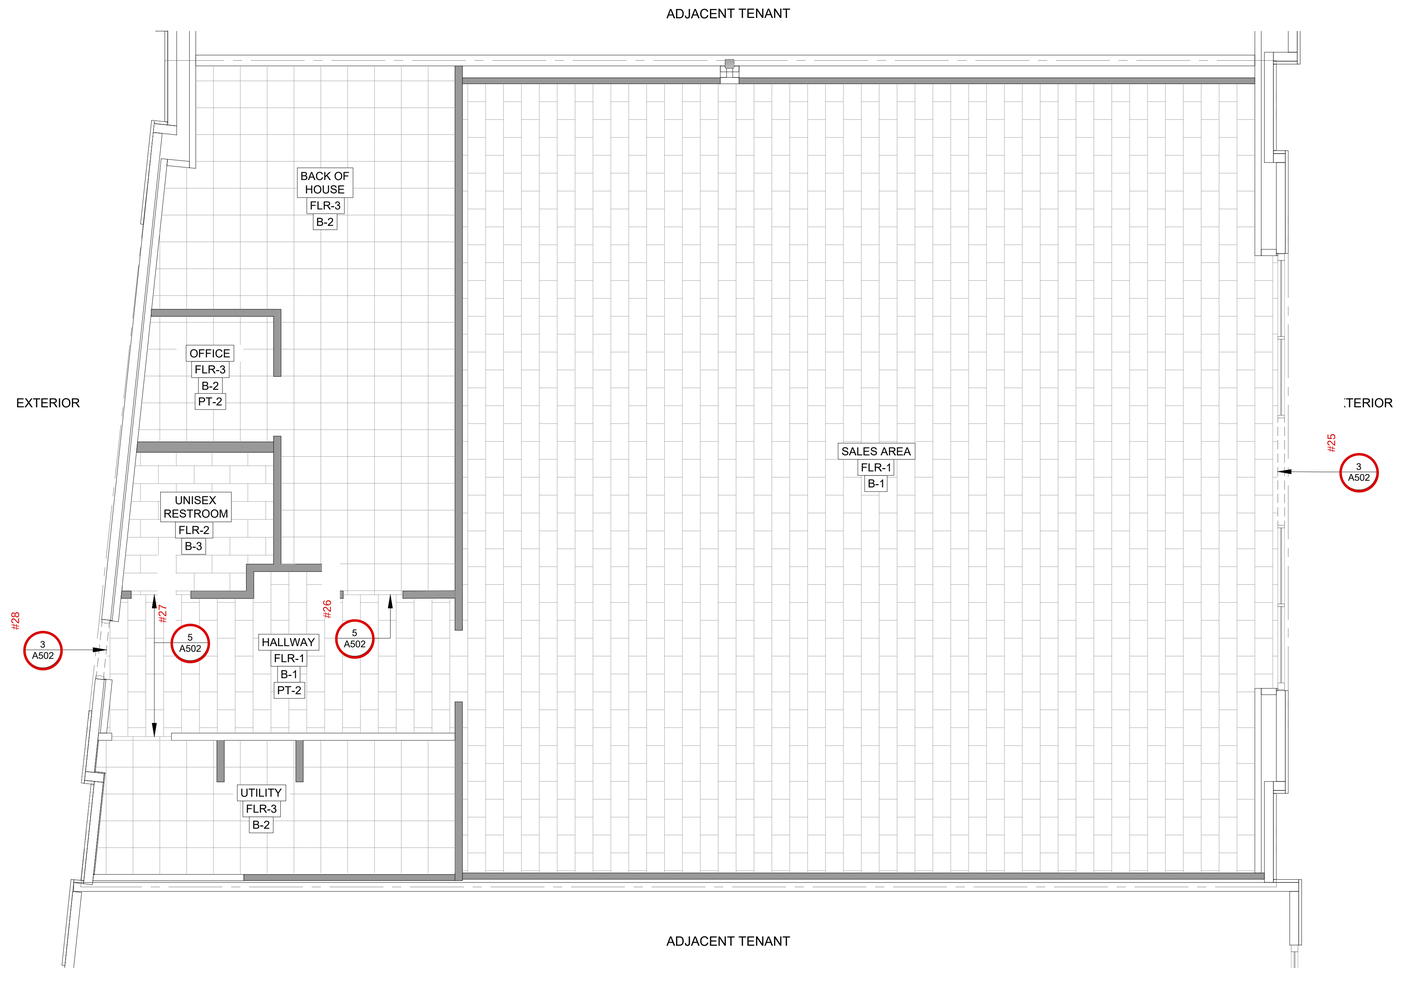

1 FINISH PLAN
1/4" = 1'-0"

SARGENTI
5840 LEGACY CIR - STE D230, PLANO, TX 75024
T|201.316.5491 ★ WWW.SARGARCH.COM

SEAL:

STATE OF COLORADO
ROBERT J. SARGENTI
305929
LICENSED ARCHITECT

DATE SIGNED: 10/15/2026

CONTRACTOR'S NOTES:

WRITTEN DIMENSIONS HOLD PREFERENCE OVER SCALED DIMENSIONS. DO NOT SCALE THE DRAWINGS. THE CONTRACTORS MUST VISIT JOB SITE TO VERIFY ALL EXISTING CONDITIONS AND DIMENSIONS BEFORE SUBMITTING BIDS. REPORT ANY DISCREPANCIES OF ANY CONDITIONS WHICH MAY INTERFERE WITH THE PROPER EXECUTION OF, THE CONTRACT TO THE TENANT'S REPRESENTATIVE. REPORT DISCREPANCIES DURING BIDDING PROCESS AND BEFORE START OF CONSTRUCTION. CHANGE ORDERS NEED TO BE APPROVED BY THE CONSTRUCTION MANAGER FOR ISSUES ARISING FROM THE FIELD CONDITIONS OR CONFLICTS BETWEEN THE PLANS AND THE EXISTING CONDITIONS PRIOR TO THE COMMENCEMENT OF WORK.

	DATE	ISSUE

△	DATE	REVISION

LOCATION:

Consumer Cellular

8283 S. AKRON ST.
SUITE #110
CENTENNIAL, CO 80112

STORE NUMBER:

CO2

PROJECT INFORMATION:

DATE: 10/14/2026
PROJECT NUMBER: 15066 - 26
STORE TYPE: TIER 2
DRAWN BY: GV REVIEWED BY: AN

TITLE:

FINISH PLAN

SHEET NUMBER:

A101

GENERAL NOTES

1. G.C. TO FIELD VERIFY ALL DIMENSIONS AND NOTIFY ARCHITECTS IMMEDIATELY OF ANY DISCREPANCIES OR UNFORESEEN ITEMS NOT SHOWN ON DRAWINGS.
2. G.C. TO VERIFY THAT ADA COUNTERTOPS COMPLY WITH 21/G002
3. FIXTURES FURNISHED BY CONSUMER CELLULAR AND INSTALLED BY G.C. OR FIXTURE VENDOR. REFER TO FIXTURE MANUFACTURER INSTRUCTIONS FOR ALL ATTACHMENTS TO WALL AND FLOOR. PROVIDE ALL BLOCKING AND ANCHORS AS REQUIRED.
4. G.C. TO COORDINATE FLOOR POWER WITH ELECTRICAL SHEETS AND FIXTURE PLAN.
5. RELOCATE ALL THERMOSTATS AND OTHER WALL MOUNTED DEVICES AS PER LOCAL CODE AS REQUIRED PER NEW FIXTURE LAYOUT. COORDINATE WITH CONSTRUCTION PM/ARCHITECT.

SHEET SYMBOLS

EXISTING AREA N.I.C.

LINETYPE INDICATES ACCESSIBLE CLEARANCE


F-1 FIXTURE TAG

X# / X#### EXTERIOR ELEVATION TAG

X1 / X2 X### X4 / X3 INTERIOR ELEVATION TAG

X# / X### DETAIL TAG

NOTE: ALL EQUIPMENT, FINISHES, FIXTURES AND FURNITURE TO BE INSTALLED PER MANUFACTURER'S RECOMMENDATIONS. SEE SHEET A700 FOR ALL SCHEDULES.

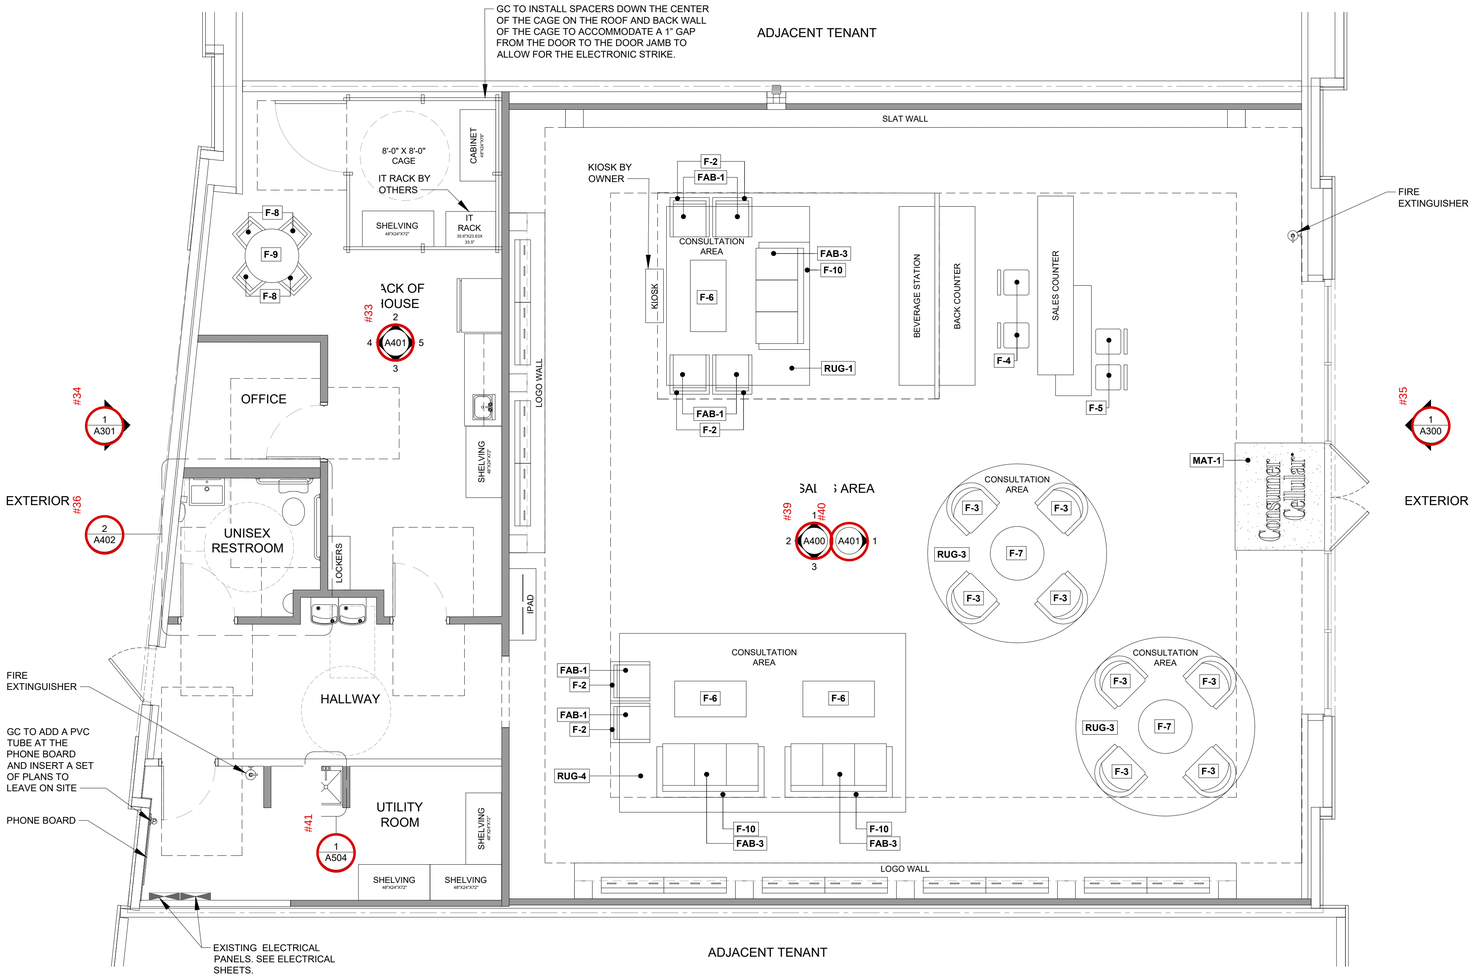

1 FURNITURE FLOOR PLAN
1/4" = 1'-0"

SARGENTI
5840 LEGACY CIR - STE D230, PLANO, TX 75024
T|201.316.5491 ● WWW.SARGARCH.COM

SEAL:

STATE OF COLORADO
ROBERT J. SARGENTI
305929
LICENSED ARCHITECT

DATE SIGNED: 10/15/2026

CONTRACTOR'S NOTES:

WRITTEN DIMENSIONS HOLD PREFERENCE OVER SCALED DIMENSIONS. DO NOT SCALE THE DRAWINGS. THE CONTRACTORS MUST VISIT JOB SITE TO VERIFY ALL EXISTING CONDITIONS AND DIMENSIONS BEFORE SUBMITTING BIDS. REPORT ANY DISCREPANCIES OF ANY CONDITIONS WHICH MAY INTERFERE WITH THE PROPER EXECUTION OF, THE CONTRACT TO THE TENANT'S REPRESENTATIVE. REPORT DISCREPANCIES DURING BIDDING PROCESS AND BEFORE START OF CONSTRUCTION. CHANGE ORDERS NEED TO BE APPROVED BY THE CONSTRUCTION MANAGER FOR ISSUES ARISING FROM THE FIELD CONDITIONS OR CONFLICTS BETWEEN THE PLANS AND THE EXISTING CONDITIONS PRIOR TO THE COMMENCEMENT OF WORK.

△	DATE	ISSUE

△	DATE	REVISION

LOCATION:

Consumer Cellular

8283 S. AKRON ST.
SUITE #110
CENTENNIAL, CO 80112

STORE NUMBER:

CO2

PROJECT INFORMATION:

DATE: 10/14/2026
PROJECT NUMBER: 15066 - 26
STORE TYPE: TIER 2
DRAWN BY: GV
REVIEWED BY: AN

TITLE:

FURNITURE FLOOR PLAN

SHEET NUMBER:

A102


GENERAL NOTES

1. G.C. TO FIELD VERIFY ALL DIMENSIONS AND NOTIFY ARCHITECTS IMMEDIATELY OF ANY DISCREPANCIES OR UNFORESEEN ITEMS NOT SHOWN ON DRAWINGS.
2. G.C. TO VERIFY THAT ADA COUNTERTOPS COMPLY WITH C1G002
3. FIXTURES FURNISHED BY CONSUMER CELLULAR AND INSTALLED BY G.C. OR FIXTURE VENDOR. REFER TO FIXTURE MANUFACTURER INSTRUCTIONS FOR ALL ATTACHMENTS TO WALL AND FLOOR. PROVIDE ALL BLOCKING AND ANCHORS AS REQUIRED. SEE SHEET A104 FOR ADDITIONAL INFORMATION.
4. G.C. TO COORDINATE FLOOR POWER WITH ELECTRICAL SHEETS AND FIXTURE PLAN.
5. RELOCATE ALL THERMOSTATS AND OTHER WALL MOUNTED DEVICES AS PER LOCAL CODE AS REQUIRED PER NEW FIXTURE LAYOUT. COORDINATE WITH CONSTRUCTION PM/ARCHITECT.

KEYED NOTES

(##)	NOTES
1	POS COUNTER
2	BEVERAGE STATION & BACK COUNTER
3	WOOD TRELLIS TO BE INSTALLED 18" MIN. BELOW ACT CEILING. GC TO PREP ABOVE THE CEILING FOR TRELLIS INSTALL, REACH OUT TO K & J WOODWORKS FOR INSTALL DRAWINGS
4	LOGO WALL
5	IPAD DISPLAY
6	SLAT WALL
7	NOT USED
8	KITCHENETTE
9	ACRYLIC DISPLAY BOXES. G.C. TO ADD A PLUG TO THE POWER SIDE OF THE LIGHT DRIVER TO BE PLUGGED INTO THE QUADS FOR ACRYLIC BOXES AT THE LOGO WALL. SEE ELECTRICAL AND MILLWORK DRAWINGS FOR ADDITIONAL INFORMATION. GC TO MAKE FINAL CONNECTIONS BETWEEN ALL UL-LISTED ACRYLIC BOX EQUIPMENT AND ADJACENT WALL OUTLETS AS SHOWN ON PLANS.

NOTE: MILLWORK DRAWINGS ARE FOR REFERENCE ONLY. G.C. TO REFER TO INSTALL DRAWINGS PROVIDED BY MILLWORK VENDOR FOR ADDITIONAL INFORMATION.

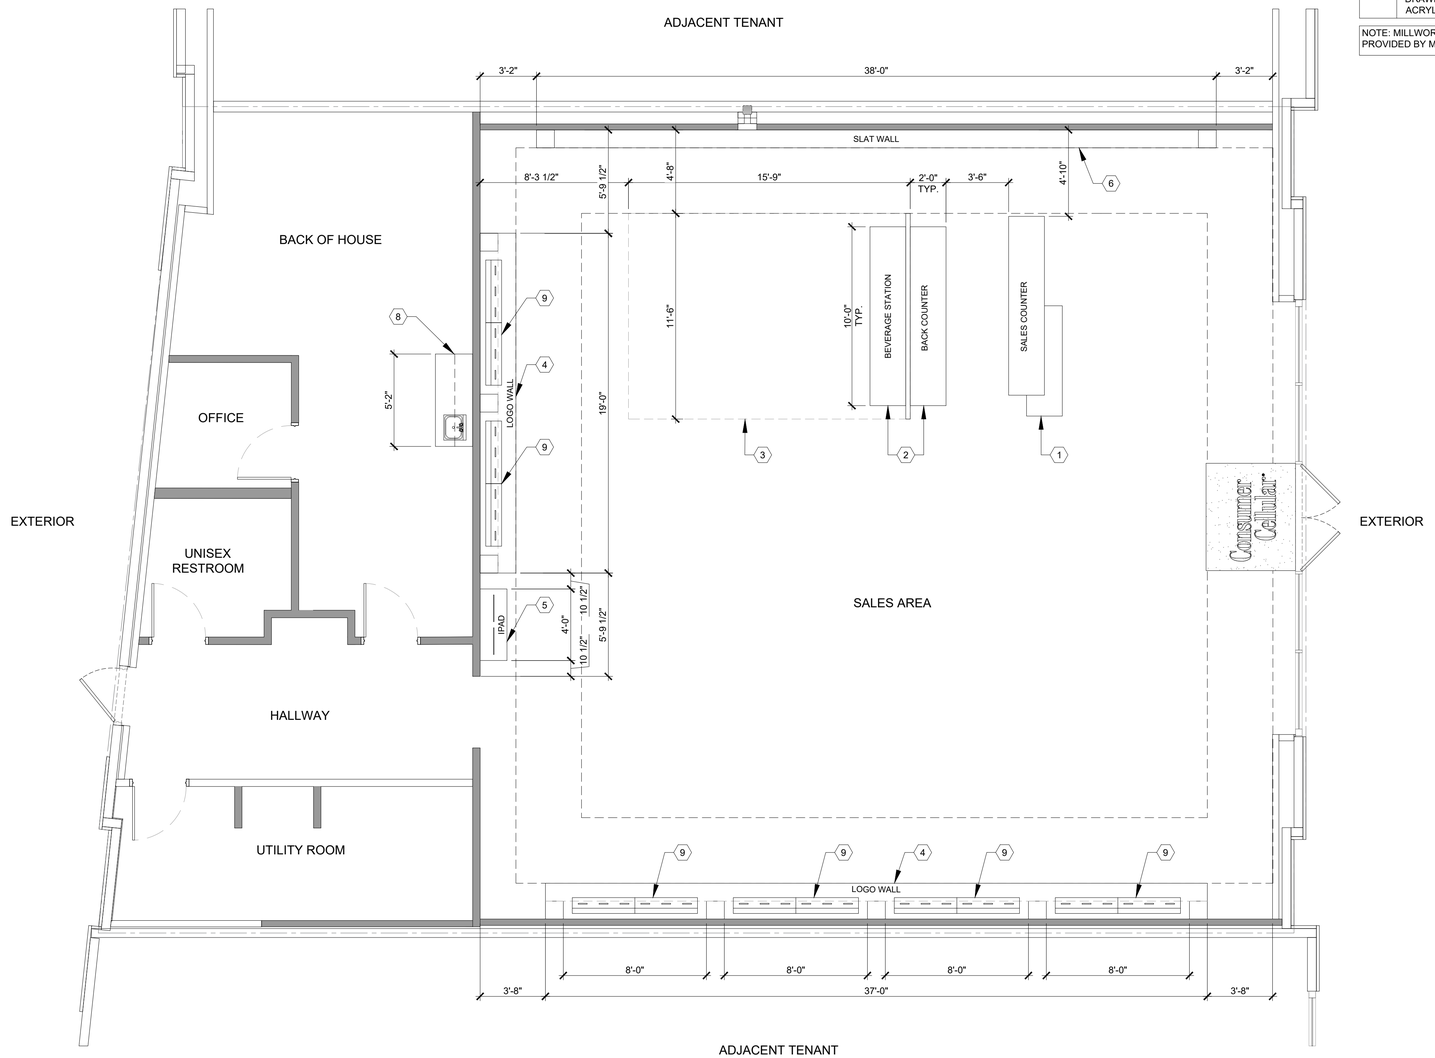

1 MILLWORK FLOOR PLAN

1/4" = 1'-0"

SARGENTI

5840 LEGACY CIR - STE D230, PLANO, TX 75024
T|201.316.5491 ★ WWW.SARGARCH.COM

SEAL:

STATE OF COLORADO ★ ROBERT J. SARGENTI 305929 ★ LICENSED ARCHITECT

DATE SIGNED: 10/15/2026

CONTRACTOR'S NOTES:

WRITTEN DIMENSIONS HOLD PREFERENCE OVER SCALED DIMENSIONS. DO NOT SCALE THE DRAWINGS. THE CONTRACTORS MUST VISIT JOB SITE TO VERIFY ALL EXISTING CONDITIONS AND DIMENSIONS BEFORE SUBMITTING BIDS. REPORT ANY DISCREPANCIES OF ANY CONDITIONS WHICH MAY INTERFERE WITH THE PROPER EXECUTION OF, THE CONTRACT TO THE TENANT'S REPRESENTATIVE. REPORT DISCREPANCIES DURING BIDDING PROCESS AND BEFORE START OF CONSTRUCTION. CHANGE ORDERS NEED TO BE APPROVED BY THE CONSTRUCTION MANAGER FOR ISSUES ARISING FROM THE FIELD CONDITIONS OR CONFLICTS BETWEEN THE PLANS AND THE EXISTING CONDITIONS PRIOR TO THE COMMENCEMENT OF WORK.

	DATE	ISSUE

△	DATE	REVISION

LOCATION:

Consumer Cellular

8283 S. AKRON ST.
SUITE #110
CENTENNIAL, CO 80112

STORE NUMBER:

CO2

PROJECT INFORMATION:

DATE: 10/14/2026
PROJECT NUMBER: 15066 - 26
STORE TYPE: TIER 2
DRAWN BY: GV REVIEWED BY: AN

TITLE:


MILLWORK FLOOR PLAN

SHEET NUMBER:

A103

GENERAL NOTES

1. G.C. TO VERIFY FIELD CONDITIONS AND DIMENSIONS AND NOTIFY ARCHITECTS IMMEDIATELY OF ANY DISCREPANCIES AFTER DEMOLITION AND PRIOR TO RECLADDING OR CONSTRUCTION. G.C. TO FIELD VERIFY ALL DIMENSIONS PRIOR TO ORDERING ANY MATERIALS.
2. G.C. TO VERIFY AND INSTALL BLOCKING FOR EXTERIOR SIGNAGE AS REQUIRED. COORDINATE WITH LANDLORD AND SIGNAGE VENDOR REGARDING LOCATION OF SIGNAGE AND EXISTING SHELL CONSTRUCTION/FINISH CONDITIONS.
3. SIGN MANUFACTURER TO REVIEW THE LANDLORD'S SIGN CRITERIA AND SUBMIT SHOP DRAWINGS FOR THE PROPOSED SIGN TO THE LANDLORD AND ANY OTHER GOVERNING AUTHORITIES. THE SIGN MANUFACTURER SHALL SECURE ANY AND ALL PERMITS REQUIRED FOR THE INSTALLATION AND DISPLAY OF THE PROPOSED SIGNAGE.
4. SIGN MANUFACTURER'S SHOP DRAWINGS SHALL BE REVIEWED UNDER SEPARATE SUBMITTAL.
5. SIGNAGE AS SHOWN IN THESE DRAWINGS IS SCHEMATIC ONLY FOR ILLUSTRATION PURPOSES AND DOES NOT IMPLY OR DESCRIBE ANY MEANS, METHODS, OR DETAILS PERTAINING TO INSTALLATION OF SIGNAGE. IT SHALL BE SOLELY THE SIGN MANUFACTURER'S RESPONSIBILITY TO DESIGN, FABRICATE, AND INSTALL THE SIGN UNDER SEPARATE PERMIT. ANY AND ALL STRUCTURAL CONSIDERATIONS SHALL BE COORDINATED BETWEEN THE SIGN MANUFACTURER, THE LANDLORD, AND HIS DESIGN PROFESSIONALS.
6. SUITE NUMBERS SHOULD BE A MINIMUM OF 3" HIGH, 1/2" STROKE WIDE, AND A CONTRASTING COLOR. PREMISES IDENTIFICATION MUST BE VISIBLE FROM STREET OR DRIVE. ALL EXTERIOR SUITE DOORS SHALL BE LABELED. POST 6" STREET NUMBERS AND 3" SUITE NUMBERS. COORDINATE WITH LANDLORD REPRESENTATIVE AND CONSUMER CELLULAR CONSTRUCTION PM FOR FINAL PLACEMENT OF SUITE NUMBERS.
7. ALL MATERIALS TO BE A CLASS A RATING WITH A FLAME SPREAD INDEX OF 0-25 AND A SMOKE DEVELOPED INDEX OF 0-450.

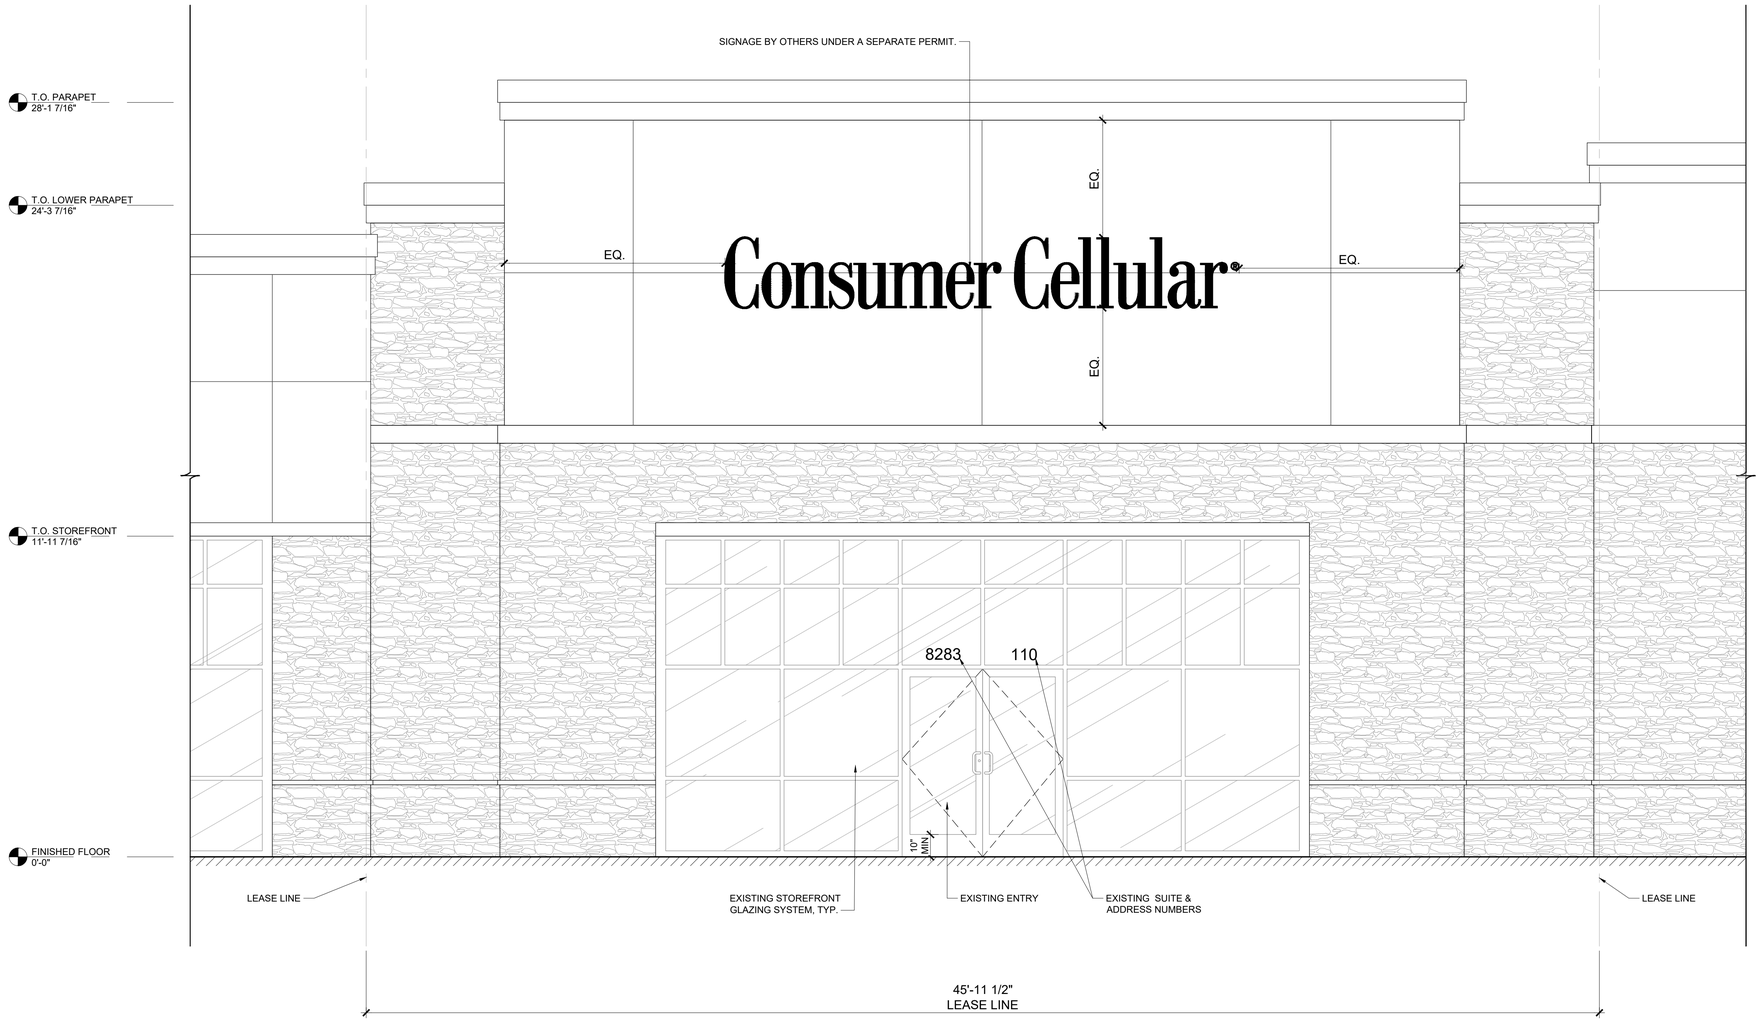

#35 1 EXISTING EXTERIOR ELEVATION

3/8" = 1'-0"

SARGENTI

5840 LEGACY CIR - STE D230, PLANO, TX 75024
T|201.316.5491 ★ WWW.SARGARCH.COM

SEAL:

STATE OF COLORADO ★ ROBERT J. SARGENTI 305929 ★ LICENSED ARCHITECT

DATE SIGNED: 10/15/2026

CONTRACTOR'S NOTES:

WRITTEN DIMENSIONS HOLD PREFERENCE OVER SCALED DIMENSIONS. DO NOT SCALE THE DRAWINGS. THE CONTRACTORS MUST VISIT JOB SITE TO VERIFY ALL EXISTING CONDITIONS AND DIMENSIONS BEFORE SUBMITTING BIDS. REPORT ANY DISCREPANCIES OF ANY CONDITIONS WHICH MAY INTERFERE WITH THE PROPER EXECUTION OF, THE CONTRACT TO THE TENANT'S REPRESENTATIVE. REPORT DISCREPANCIES DURING BIDDING PROCESS AND BEFORE START OF CONSTRUCTION. CHANGE ORDERS NEED TO BE APPROVED BY THE CONSTRUCTION MANAGER FOR ISSUES ARISING FROM THE FIELD CONDITIONS OR CONFLICTS BETWEEN THE PLANS AND THE EXISTING CONDITIONS PRIOR TO THE COMMENCEMENT OF WORK.

	DATE	ISSUE
△	DATE	REVISION

LOCATION:

Consumer Cellular®

8283 S. AKRON ST.
SUITE #110
CENTENNIAL, CO 80112

STORE NUMBER:

CO2

PROJECT INFORMATION:


DATE: 10/14/2026
PROJECT NUMBER: 15066 - 26
STORE TYPE: TIER 2
DRAWN BY: GV REVIEWED BY: AN

TITLE:

EXTERIOR ELEVATIONS

SHEET NUMBER:

A300

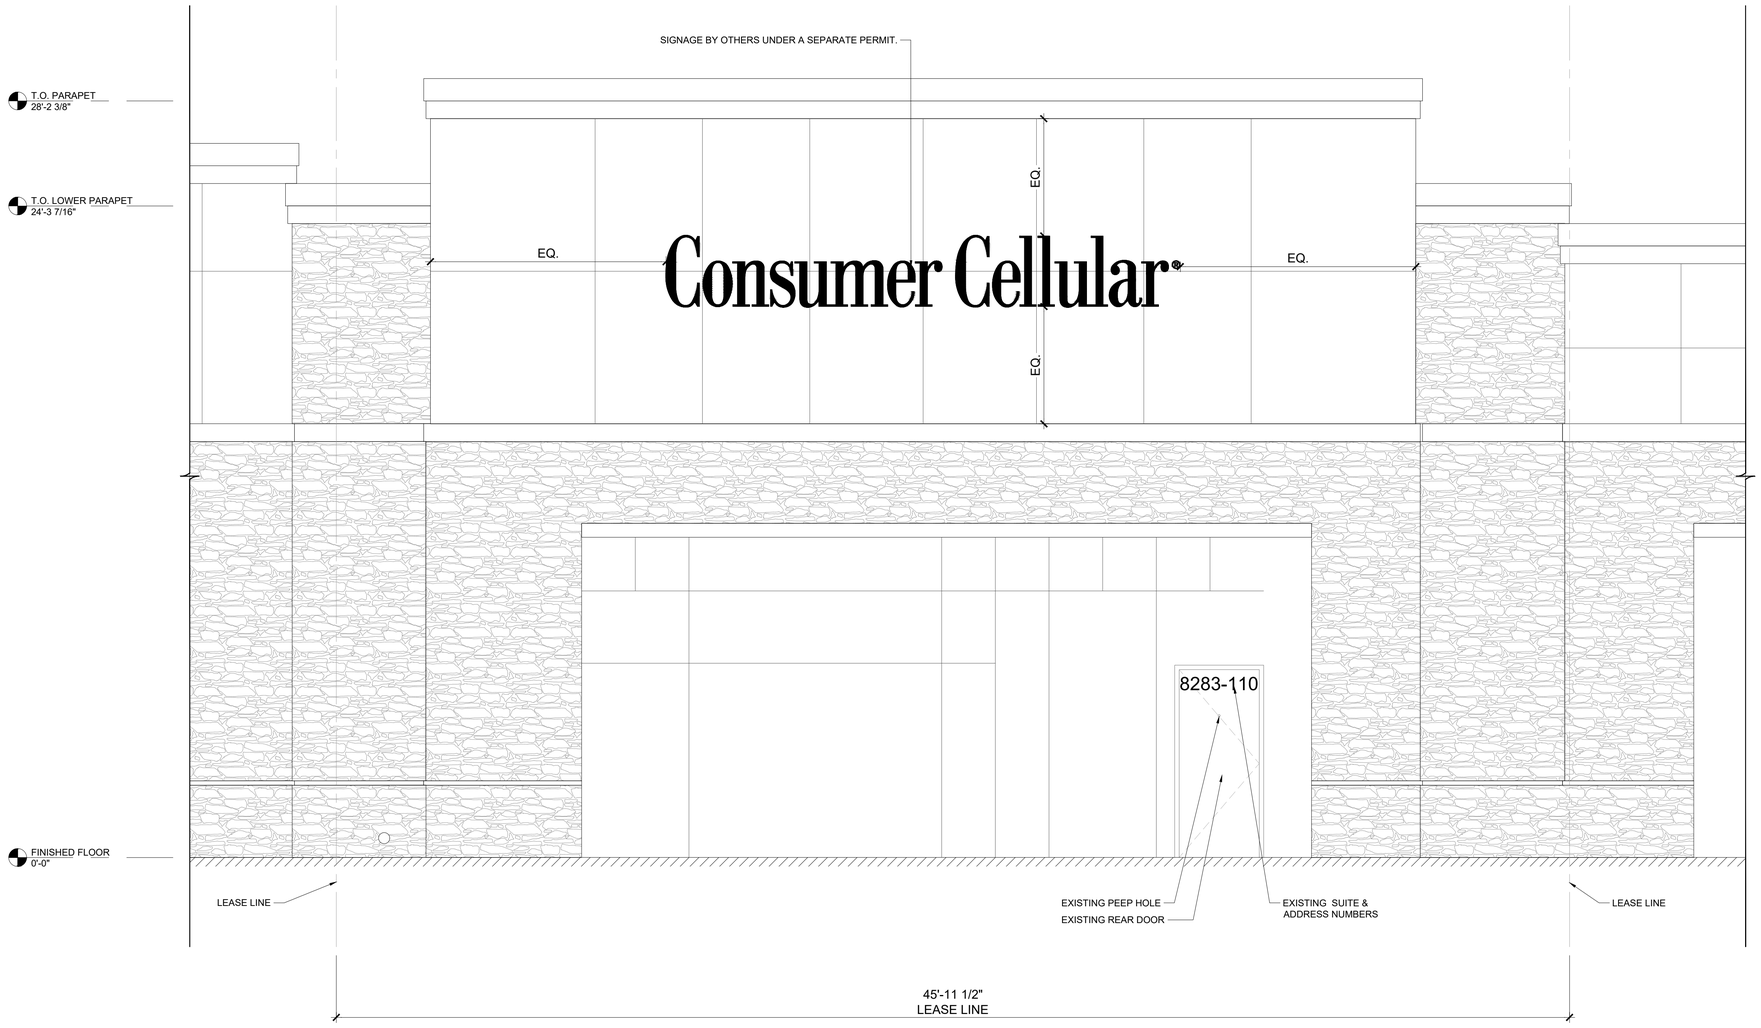

#34 1 EXISTING EXTERIOR ELEVATION

3/8" = 1'-0"

GENERAL NOTES

1. G.C. TO VERIFY FIELD CONDITIONS AND DIMENSIONS AND NOTIFY ARCHITECTS IMMEDIATELY OF ANY DISCREPANCIES AFTER DEMOLITION AND PRIOR TO RECLADDING OR CONSTRUCTION. G.C. TO FIELD VERIFY ALL DIMENSIONS PRIOR TO ORDERING ANY MATERIALS.
2. G.C. TO VERIFY AND INSTALL BLOCKING FOR EXTERIOR SIGNAGE AS REQUIRED. COORDINATE WITH LANDLORD AND SIGNAGE VENDOR REGARDING LOCATION OF SIGNAGE AND EXISTING SHELL CONSTRUCTION/FINISH CONDITIONS.
3. SIGN MANUFACTURER TO REVIEW THE LANDLORD'S SIGN CRITERIA AND SUBMIT SHOP DRAWINGS FOR THE PROPOSED SIGN TO THE LANDLORD AND ANY OTHER GOVERNING AUTHORITIES. THE SIGN MANUFACTURER SHALL SECURE ANY AND ALL PERMITS REQUIRED FOR THE INSTALLATION AND DISPLAY OF THE PROPOSED SIGNAGE.
4. SIGN MANUFACTURER'S SHOP DRAWINGS SHALL BE REVIEWED UNDER SEPARATE SUBMITTAL.
5. SIGNAGE AS SHOWN IN THESE DRAWINGS IS SCHEMATIC ONLY FOR ILLUSTRATION PURPOSES AND DOES NOT IMPLY OR DESCRIBE ANY MEANS, METHODS, OR DETAILS PERTAINING TO INSTALLATION OF SIGNAGE. IT SHALL BE SOLELY THE SIGN MANUFACTURER'S RESPONSIBILITY TO DESIGN, FABRICATE, AND INSTALL THE SIGN UNDER SEPARATE PERMIT. ANY AND ALL STRUCTURAL CONSIDERATIONS SHALL BE COORDINATED BETWEEN THE SIGN MANUFACTURER, THE LANDLORD, AND HIS DESIGN PROFESSIONALS.
6. SUITE NUMBERS SHOULD BE A MINIMUM OF 3" HIGH, 1/2" STROKE WIDE, AND A CONTRASTING COLOR. PREMISES IDENTIFICATION MUST BE VISIBLE FROM STREET OR DRIVE. ALL EXTERIOR SUITE DOORS SHALL BE LABELED. POST 6" STREET NUMBERS AND 3" SUITE NUMBERS. COORDINATE WITH LANDLORD REPRESENTATIVE AND CONSUMER CELLULAR CONSTRUCTION PM FOR FINAL PLACEMENT OF SUITE NUMBERS.
7. ALL MATERIALS TO BE A CLASS A RATING WITH A FLAME SPREAD INDEX OF 0-25 AND A SMOKE DEVELOPED INDEX OF 0-450.

SARGENTI
5840 LEGACY CIR - STE D230, PLANO, TX 75024
T|201.316.5491 ★ WWW.SARGARCH.COM

SEAL:

STATE OF COLORADO
ROBERT J. SARGENTI
305929
LICENSED ARCHITECT

DATE SIGNED: 10/15/2026

CONTRACTOR'S NOTES:

WRITTEN DIMENSIONS HOLD PREFERENCE OVER SCALED DIMENSIONS. DO NOT SCALE THE DRAWINGS. THE CONTRACTORS MUST VISIT JOB SITE TO VERIFY ALL EXISTING CONDITIONS AND DIMENSIONS BEFORE SUBMITTING BIDS. REPORT ANY DISCREPANCIES OF ANY CONDITIONS WHICH MAY INTERFERE WITH THE PROPER EXECUTION OF, THE CONTRACT TO THE TENANT'S REPRESENTATIVE. REPORT DISCREPANCIES DURING BIDDING PROCESS AND BEFORE START OF CONSTRUCTION. CHANGE ORDERS NEED TO BE APPROVED BY THE CONSTRUCTION MANAGER FOR ISSUES ARISING FROM THE FIELD CONDITIONS OR CONFLICTS BETWEEN THE PLANS AND THE EXISTING CONDITIONS PRIOR TO THE COMMENCEMENT OF WORK.

	DATE	ISSUE
△	DATE	REVISION

LOCATION:

Consumer Cellular®

8283 S. AKRON ST.
SUITE #110
CENTENNIAL, CO 80112

STORE NUMBER:

CO2

PROJECT INFORMATION:


DATE: 10/14/2026
PROJECT NUMBER: 15066 - 26
STORE TYPE: TIER 2
DRAWN BY: GV REVIEWED BY: AN

TITLE:


EXTERIOR ELEVATIONS

SHEET NUMBER:


A301

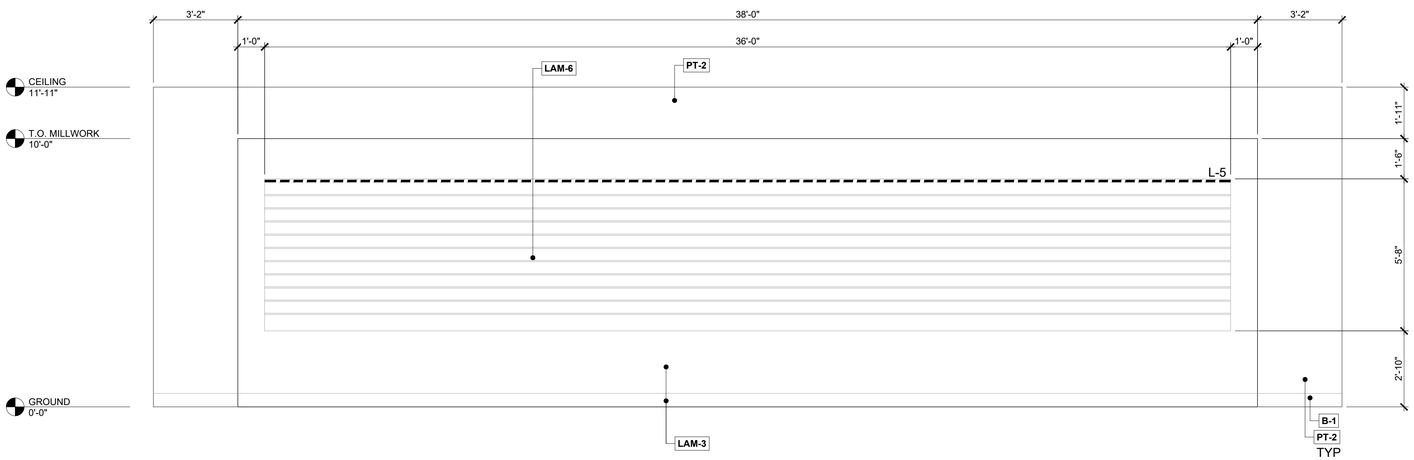

#37 1 INTERIOR ELEVATION
3/8" = 1'-0"

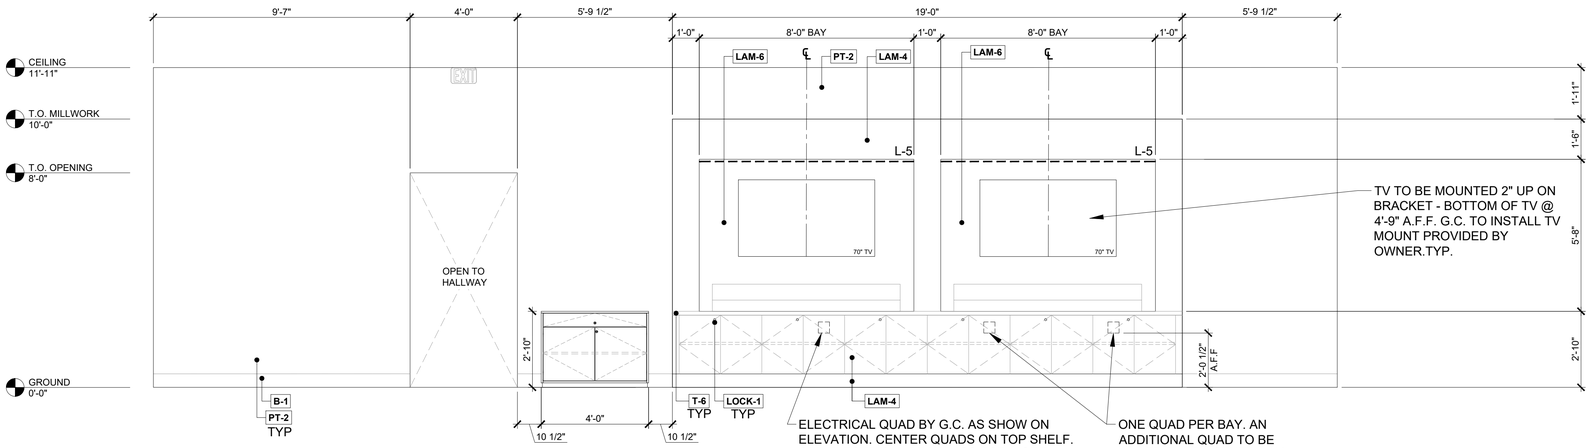

#38 2 INTERIOR ELEVATION LOGO WALL
3/8" = 1'-0"

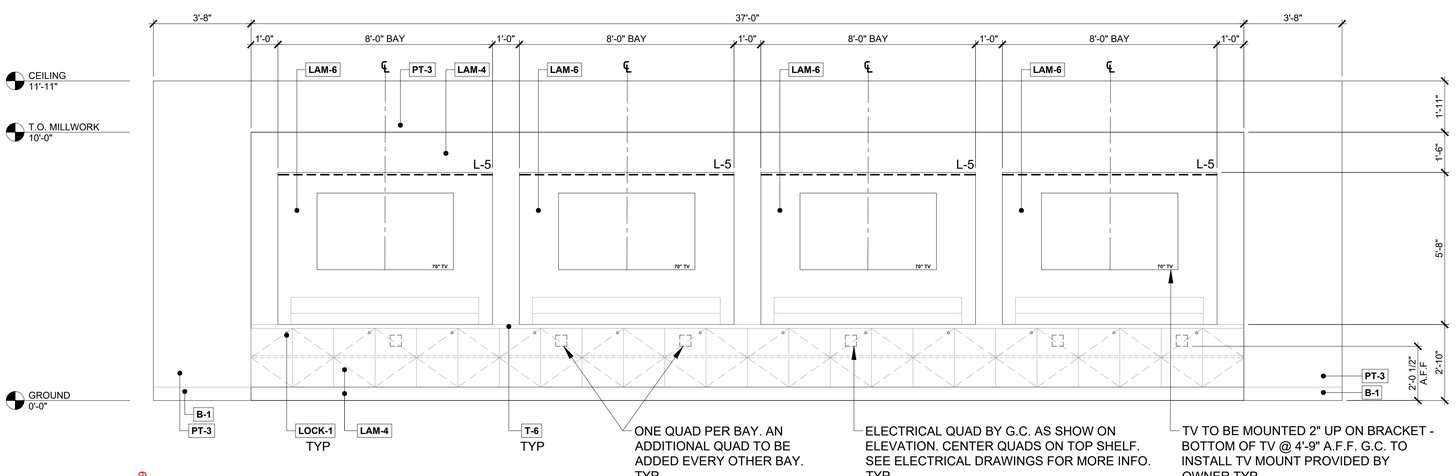

#39 3 INTERIOR ELEVATION
3/8" = 1'-0"

NOTE: ALL MILLWORK BY OWNER, INSTALLED BY G.C. SEE SHEET A-103 FOR MILLWORK LAYOUT.

SARGENTI
5840 LEGACY CIR - STE D230, PLANO, TX 75024
T|201.316.5491 ★ WWW.SARGARCH.COM

SEAL:

STATE OF COLORADO ★ ROBERT J. SARGENTI 305929 ★ LICENSED ARCHITECT

DATE SIGNED: 10/15/2026

CONTRACTOR'S NOTES:

WRITTEN DIMENSIONS HOLD PREFERENCE OVER SCALED DIMENSIONS. DO NOT SCALE THE DRAWINGS. THE CONTRACTORS MUST VISIT JOB SITE TO VERIFY ALL EXISTING CONDITIONS AND DIMENSIONS BEFORE SUBMITTING BIDS. REPORT ANY DISCREPANCIES OF ANY CONDITIONS WHICH MAY INTERFERE WITH THE PROPER EXECUTION OF, THE CONTRACT TO THE TENANT'S REPRESENTATIVE. REPORT DISCREPANCIES DURING BIDDING PROCESS AND BEFORE START OF CONSTRUCTION. CHANGE ORDERS NEED TO BE APPROVED BY THE CONSTRUCTION MANAGER FOR ISSUES ARISING FROM THE FIELD CONDITIONS OR CONFLICTS BETWEEN THE PLANS AND THE EXISTING CONDITIONS PRIOR TO THE COMMENCEMENT OF WORK.

	DATE	ISSUE
△	DATE	REVISION

LOCATION:

Consumer Cellular®

8283 S. AKRON ST.
SUITE #110
CENTENNIAL, CO 80112

STORE NUMBER:

CO2

PROJECT INFORMATION:


DATE: 10/14/2026
PROJECT NUMBER: 15066 - 26
STORE TYPE: TIER 2
DRAWN BY: GV
REVIEWED BY: AN

TITLE:


INTERIOR ELEVATIONS

SHEET NUMBER:


A400

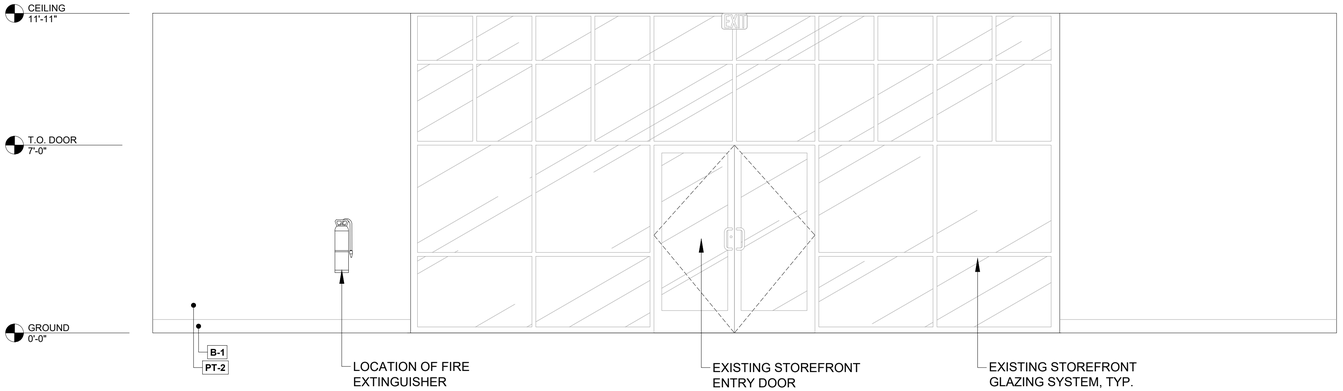


#40 1 INTERIOR ELEVATION
3/8" = 1'-0"

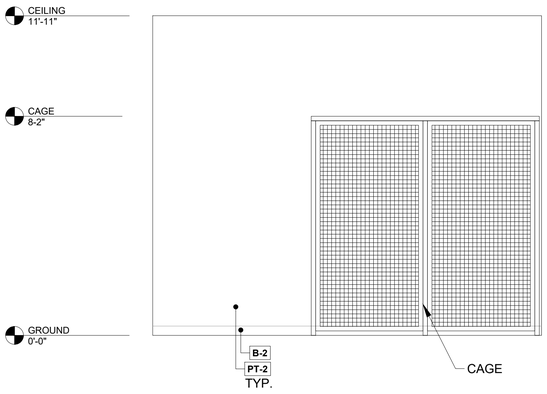


#30 2 INTERIOR ELEVATION
3/8" = 1'-0"

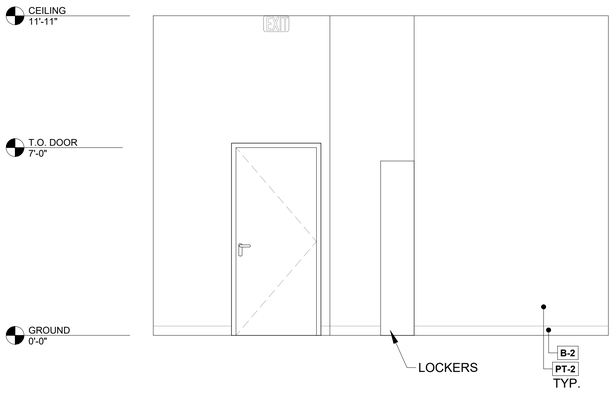

#31 3 INTERIOR ELEVATION
3/8" = 1'-0"

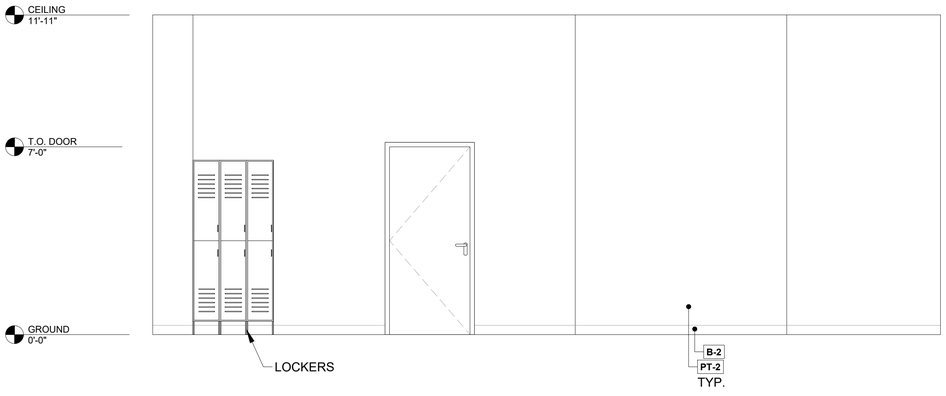

#32 4 INTERIOR ELEVATION
3/8" = 1'-0"

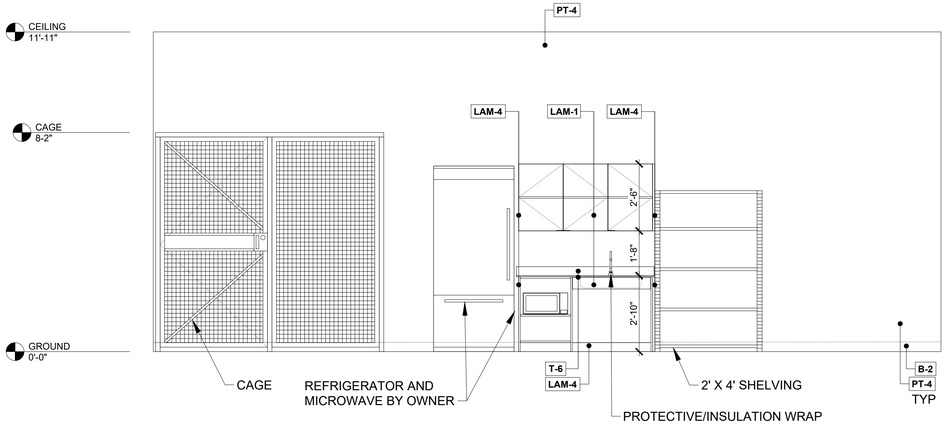

#33 5 INTERIOR ELEVATION
3/8" = 1'-0"

NOTE: ALL MILLWORK BY OWNER, INSTALLED BY G.C. SEE SHEET A-103 FOR MILLWORK LAYOUT.

SARGENTI
5840 LEGACY CIR - STE D230, PLANO, TX 75024
T|201.316.5491 ■ WWW.SARGARCH.COM

SEAL:

STATE OF COLORADO
ROBERT J. SARGENTI
305929
LICENSED ARCHITECT

DATE SIGNED: 10/15/2026

CONTRACTOR'S NOTES:

WRITTEN DIMENSIONS HOLD PREFERENCE OVER SCALED DIMENSIONS. DO NOT SCALE THE DRAWINGS. THE CONTRACTORS MUST VISIT JOB SITE TO VERIFY ALL EXISTING CONDITIONS AND DIMENSIONS BEFORE SUBMITTING BIDS. REPORT ANY DISCREPANCIES OF ANY CONDITIONS WHICH MAY INTERFERE WITH THE PROPER EXECUTION OF, THE CONTRACT TO THE TENANT'S REPRESENTATIVE. REPORT DISCREPANCIES DURING BIDDING PROCESS AND BEFORE START OF CONSTRUCTION. CHANGE ORDERS NEED TO BE APPROVED BY THE CONSTRUCTION MANAGER FOR ISSUES ARISING FROM THE FIELD CONDITIONS OR CONFLICTS BETWEEN THE PLANS AND THE EXISTING CONDITIONS PRIOR TO THE COMMENCEMENT OF WORK.

	DATE	ISSUE
△	DATE	REVISION

LOCATION:

Consumer Cellular®

8283 S. AKRON ST.
SUITE #110
CENTENNIAL, CO 80112

STORE NUMBER:

CO2

PROJECT INFORMATION:


DATE: 10/14/2026
PROJECT NUMBER: 15066 - 26
STORE TYPE: TIER 2
DRAWN BY: GV REVIEWED BY: AN

TITLE:

INTERIOR ELEVATIONS


SHEET NUMBER:

A401

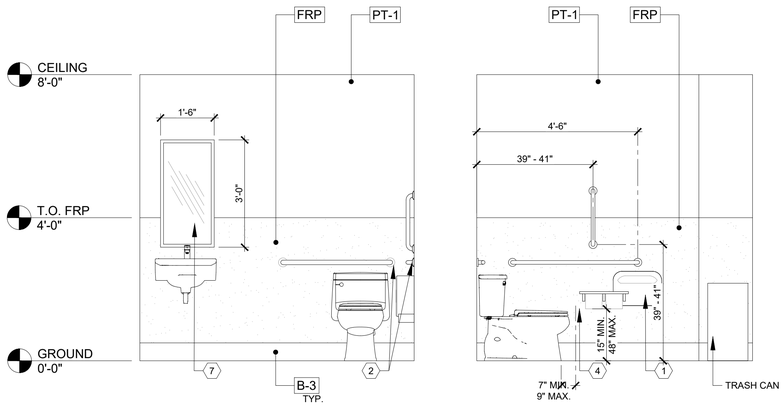


A

B

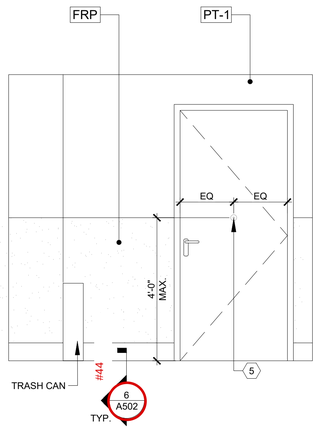

C

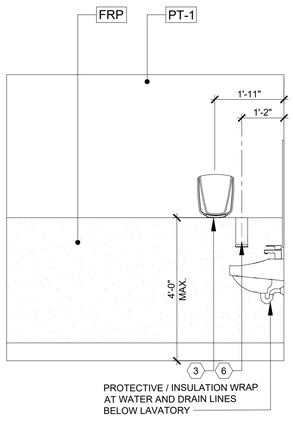


D

1 RESTROOM ELEVATIONS

#43


1/2" = 1'-0"

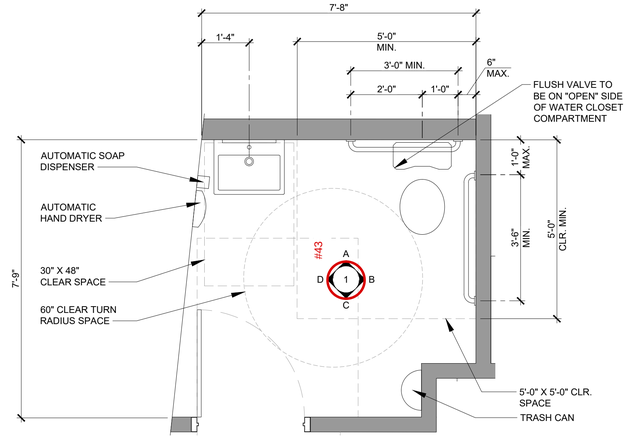

2 ENLARGED UNISEX RESTROOM PLAN


#36

1/2" = 1'-0"

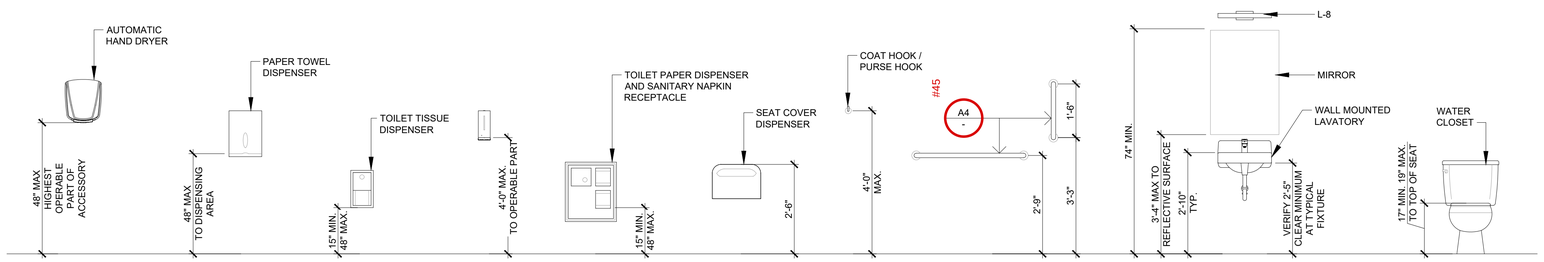


3 TYPICAL MOUNTING HEIGHTS

1/2" = 1'-0"

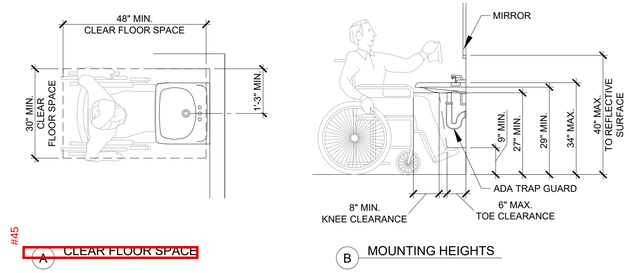

4 LAVATORY DETAIL

1/2" = 1'-0"

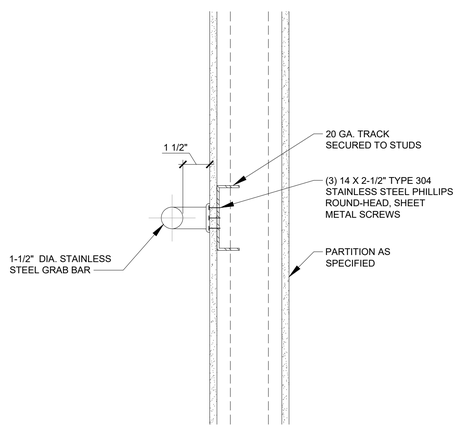

5 GRAB BAR DETAIL

3" = 1'-0"

GRAB BAR NOTES

1) GC TO INSTALL WITH MOUNTING KIT # 252-30.

2) THE STRUCTURAL STRENGTH OF GRAB BARS SHALL MEET THE FOLLOWING SPECIFICATIONS:

(A) BENDING STRESS IN A GRAB BAR INDUCED BY THE MAXIMUM BENDING MOMENT FROM THE APPLICATION OF 250 lbf (1112N) SHALL BE LESS THAN THE ALLOWABLE STRESS FOR THE MATERIAL OF THE GRAB BAR.

(B) SHEAR STRESS INDUCED IN A GRAB BAR BY THE APPLICATION OF 250 lbf (1112N) SHALL BE LESS THAN THE ALLOWABLE SHEAR STRESS FOR THE MATERIAL OF THE GRAB BAR. IF THE CONNECTIONS BETWEEN THE GRAB BAR AND ITS MOUNTING BRACKET OR OTHER SUPPORT IS CONSIDERED TO BE FULLY RESTRAINED, THEN DIRECT AND TORSIONAL SHEAR STRESSES SHALL BE TOTALED FOR THE COMBINED SHEAR STRESS, WHICH SHALL NOT EXCEED THE ALLOWABLE SHEAR STRESS.

(C) SHEAR FORCE INDUCED IN A FASTENER OR MOUNTING DEVICE FROM THE APPLICATION OF 250 lbf (1112N) SHALL BE LESS THAN THE ALLOWABLE LATERAL LOAD OF EITHER THE FASTENER OR MOUNTING DEVICE OR THE SUPPORTING STRUCTURE, WHICHEVER IS THE SMALLER ALLOWABLE LOAD.

(D) TENSILE FORCE INDUCED IN A FASTENER BY A DIRECT TENSION FORCE OF 250 lbf (1112N) PLUS THE MAXIMUM MOMENT FROM THE APPLICATION OF 250 lbf (1112N) SHALL BE LESS THAN THE ALLOWABLE WITHDRAWAL LOAD BETWEEN THE FASTENER AND THE SUPPORTING STRUCTURE.

(E) GRAB BARS SHALL NOT ROTATE WITHIN THEIR FITTINGS.

ACCESSIBLE SIGNAGE

ADA SIGN DESCRIPTION	MODEL#	SIGNAGE
WINDOW / COUNTER DECAL SYMBOL OF ACCESSIBILITY - SIZE: 6" X 6"	ADA-1006	
"EXIT" - SIZE: 6" X 6"; W/ ADA/CBC BRAILLE	ADA-1242	
"EXIT ROUTE" - SIZE: 6" X 6"; W/ ADA/CBC BRAILLE	ADA-1243	
WHEELCHAIR ACCESSIBLE ENTRANCE - SIZE: 6" X 8"	ADA-1070	
"WOMEN" WHEELCHAIR ACCESSIBLE RESTROOM - WALL - SIZE: 6" X 8"	ADA-1024	
"MEN" WHEELCHAIR ACCESSIBLE RESTROOM - WALL - SIZE: 6" X 8"	ADA-1025	
"ALL GENDER" WHEELCHAIR ACCESSIBLE RESTROOM - WALL - SIZE: 8" X 8"	ADA-1026	
"ALL GENDER" ACCESSIBLE RESTROOM - TACTILE BRAILLE - WALL - 8" X 9"	ADA-1245	
"WOMEN" ACCESSIBILE RESTROOM - DOOR - SIZE: 12" DIA. CIRCLE	T24-1001	
"MEN" ACCESSIBLE RESTROOM - DOOR - SIZE: 12" TRIANGLE	T24-1000	
"ALL GENDER" WHEELCHAIR ACCESSIBLE RESTROOM - DOOR - 12" TRIANGLE / CIRCLE	T24-1003	
"ALL GENDER" WHEELCHAIR ACCESSIBLE RESTROOM - DOOR - 12' X 12"	ADA-1251	

G.C IS RESPONSIBLE FOR PROVIDING AND INSTALLING ALL ACCESSIBLE SIGNAGE. SIGNAGE TO BE ADA WHITE ON BLUE AVAILABLE FROM WWW.ADASIGNDEPOT.COM
*NOT ALL USED AT THIS LOCATION

GENERAL NOTES

1. DISPENSERS THAT CONTROL DELIVERY OR THAT DO NOT PERMIT CONTINUOUS PAPER FLOW SHALL NOT BE USED.
2. INTERIOR SURFACES - TOILET ROOM FLOORS SHALL HAVE A SMOOTH, HARD, NON-ABSORBENT SURFACE, SUCH AS PORTLAND CEMENT, CONCRETE, CERAMIC TILE, OR OTHER APPROVED MATERIALS WHICH EXTEND UPWARD ONTO THE WALLS AT LEAST 5".
3. THERE SHALL BE NO SHARP OR ABRASIVE SURFACES UNDER LAVATORIES OR SINKS.
4. PROVIDE BLOCKING AT ALL WALL MOUNTED FIXTURES AND ACCESSORIES.

ACCESSORY KEY NOTES

(##)	NOTES
1	SEAT COVER DISPENSER: BOBRICK - #B-221 - STAINLESS STEEL
2	GRAB BAR: AMERICAN SPECIALTIES - STAINLESS STEEL
3	SURFACE-MOUNTED HAND DRYER: WORLD DRYER - Q-973A2 - BRUSHED STAINLESS STEEL
4	TOILET PAPER DISPENSER: SURFACE-MOUNTED MULTI ROLL TISSUE DISPENSER W/ SHELF BOBRICK - B2840
5	DOOR COAT HOOK: ROCKWOOD - MODEL: RW 828 - STAINLESS STEEL
6	AUTOMATIC SOAP DISPENSER: BOBRICK - #B-2013 - STAINLESS STEEL
7	FRAMES MIRROR: ASI #0600 - STAINLESS STEEL

SARGENTI

5840 LEGACY CIR - STE D230, PLANO, TX 75024
T|201.316.5491 ★ WWW.SARGARCH.COM

SEAL:

STATE OF COLORADO
ROBERT J. SARGENTI
305929
LICENSED ARCHITECT

DATE SIGNED: 10/15/2026

CONTRACTOR'S NOTES:

WRITTEN DIMENSIONS HOLD PREFERENCE OVER SCALED DIMENSIONS. DO NOT SCALE THE DRAWINGS. THE CONTRACTORS MUST VISIT JOB SITE TO VERIFY ALL EXISTING CONDITIONS AND DIMENSIONS BEFORE SUBMITTING BIDS. REPORT ANY DISCREPANCIES OF ANY CONDITIONS WHICH MAY INTERFERE WITH THE PROPER EXECUTION OF, THE CONTRACT TO THE TENANT'S REPRESENTATIVE. REPORT DISCREPANCIES DURING BIDDING PROCESS AND BEFORE START OF CONSTRUCTION. CHANGE ORDERS NEED TO BE APPROVED BY THE CONSTRUCTION MANAGER FOR ISSUES ARISING FROM THE FIELD CONDITIONS OR CONFLICTS BETWEEN THE PLANS AND THE EXISTING CONDITIONS PRIOR TO THE COMMENCEMENT OF WORK.

	DATE	ISSUE
△	DATE	REVISION

LOCATION:

Consumer Cellular

8283 S. AKRON ST.
SUITE #110
CENTENNIAL, CO 80112

STORE NUMBER:

CO2

PROJECT INFORMATION:


DATE: 10/14/2026
PROJECT NUMBER: 15066 - 26
STORE TYPE: TIER 2
DRAWN BY: GV REVIEWED BY: AN

TITLE:

ENLARGED UNISEX RESTROOM

SHEET NUMBER:

A402

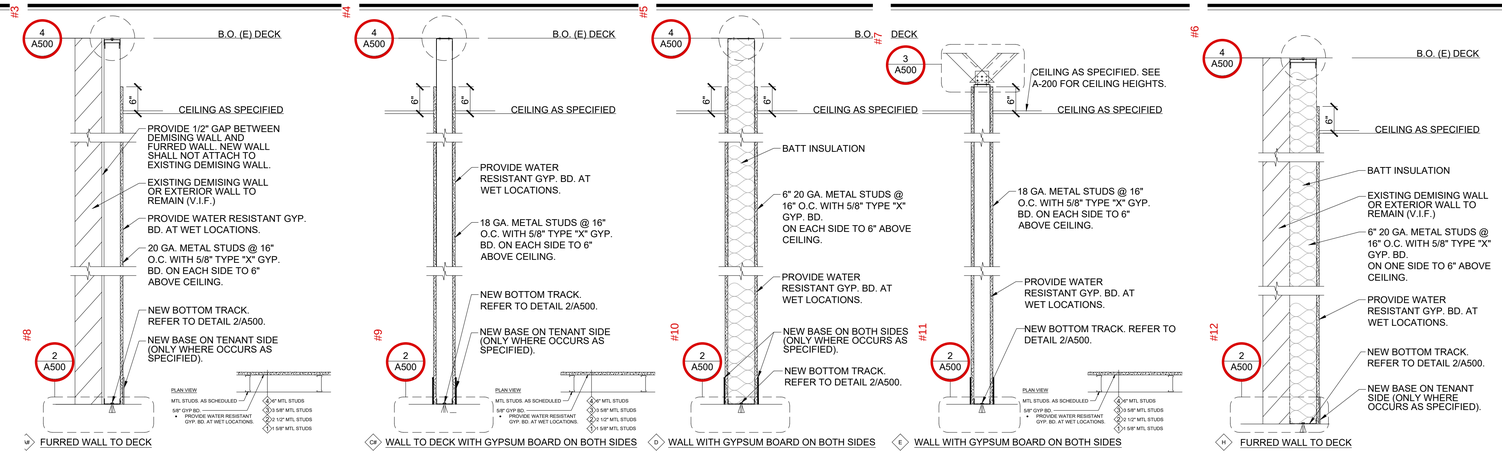

#1
1 PARTITION TYPES
3/4"=1'-0"


FASTENERS:
AT PLYWOOD FLOOR (MIN. 3/4" CDX):
PROVIDE (2) NO. 8 X 3/4" WOOD SCREWS AT 24" O.C. MAX. STAGGERED FOR (1) LAYER GYP. BD. EACH SIDE, 16" O.C. MAX. STAGGERED FOR (2) LAYERS GYP. BD. EACH SIDE.

AT CIP CONCRETE FLOOR:
PROVIDE HILTI X-DNI .145Ø X 1" EMBED (POWDER-ACTUATED FASTENERS PER ES REPORT ESR-1663) AT 24" O.C. MAX. STAGGERED FOR (1) LAYER GYP. BD. EACH SIDE, 16" O.C. MAX. STAGGERED FOR (2) LAYERS GYP. BD. EACH SIDE.


AT POST-TENSIONED CONCRETE FLOOR:
PROVIDE HILTI X-DNI .145Ø X 3/4" EMBED (POWER-ACTUATED FASTENERS PER ES REPORT ESR-1663) AT 24" O.C. MAX. STAGGERED FOR (1) LAYER GYP. BD. EACH SIDE, 16" O.C. MAX. STAGGERED FOR (2) LAYERS GYP. BD. EACH SIDE.

FOR WALLS TO 10'-0" - BRACE WITH 362S137-33 AT 48" O.C. MAX. ALTERNATE DIRECTION OF BRACES ALONG LENGTH OF WALL WHERE POSSIBLE.


FOR WALLS TO 15'-0" - BRACE WITH DOUBLE 362S137-33 AT 48" O.C. MAX. ALTERNATE DIRECTION OF BRACES ALONG LENGTH OF WALL. FASTEN DOUBLED STUDS TOGETHER WITH NO. 8 SCREWS AT 24" O.C. MAX.

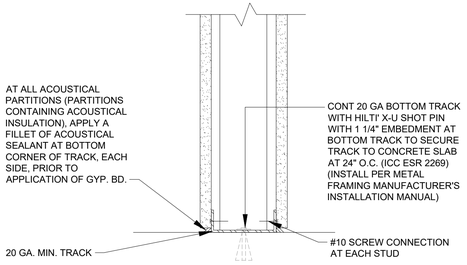


#12
2 PARTITION FLOOR CONNECTION
3" = 1'-0"

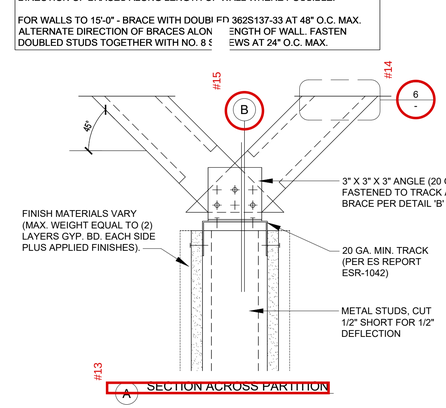

#7
3 TOP OF WALL BRACING DETAIL
3" = 1'-0"

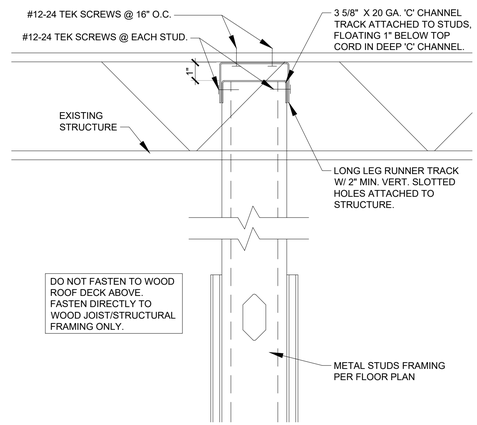


#6
4 ATTACHMENT TO STRUCTURE
3" = 1'-0"

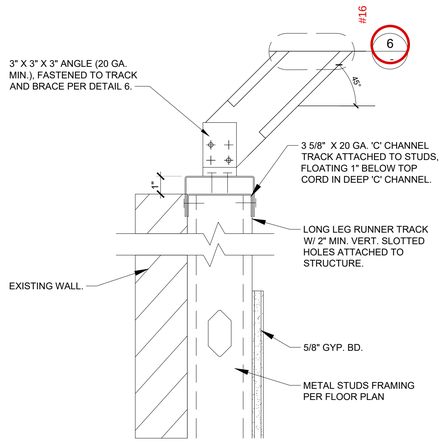

5 ATTACHMENT TO STRUCTURE
3" = 1'-0"

BRACING DETAIL FOR FLOOR SUPPORTED FRAMING ONLY!

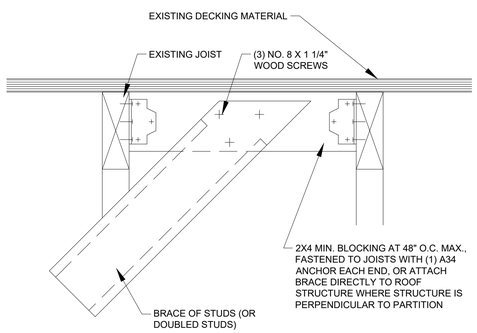

#49
6 ATTACHMENT TO STRUCTURE
3" = 1'-0"

SARGENTI
5840 LEGACY CIR - STE D230, PLANO, TX 75024
T|201.316.5491 ★ WWW.SARGARCH.COM

SEAL:
STATE OF COLORADO ★ ROBERT J. SARGENTI 305929 ★ LICENSED ARCHITECT
DATE SIGNED: 10/15/2026

CONTRACTOR'S NOTES:
WRITTEN DIMENSIONS HOLD PREFERENCE OVER SCALED DIMENSIONS. DO NOT SCALE THE DRAWINGS. THE CONTRACTORS MUST VISIT JOB SITE TO VERIFY ALL EXISTING CONDITIONS AND DIMENSIONS BEFORE SUBMITTING BIDS. REPORT ANY DISCREPANCIES OF ANY CONDITIONS WHICH MAY INTERFERE WITH THE PROPER EXECUTION OF, THE CONTRACT TO THE TENANT'S REPRESENTATIVE. REPORT DISCREPANCIES DURING BIDDING PROCESS AND BEFORE START OF CONSTRUCTION. CHANGE ORDERS NEED TO BE APPROVED BY THE CONSTRUCTION MANAGER FOR ISSUES ARISING FROM THE FIELD CONDITIONS OR CONFLICTS BETWEEN THE PLANS AND THE EXISTING CONDITIONS PRIOR TO THE COMMENCEMENT OF WORK.

	DATE	ISSUE

△	DATE	REVISION


LOCATION:
Consumer Cellular®
8283 S. AKRON ST.
SUITE #110
CENTENNIAL, CO 80112

STORE NUMBER:
CO2

PROJECT INFORMATION:
DATE: 10/14/2026
PROJECT NUMBER: 15066 - 26
STORE TYPE: TIER 2
DRAWN BY: GV
REVIEWED BY: AN


TITLE:
PARTITION TYPES & DETAILS

SHEET NUMBER:
A500

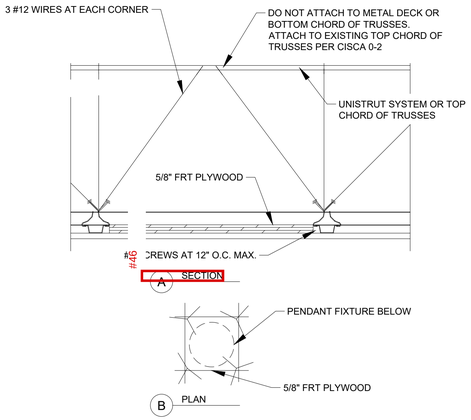


1 BLOCKING AT PENDANT LIGHT

N.T.S.

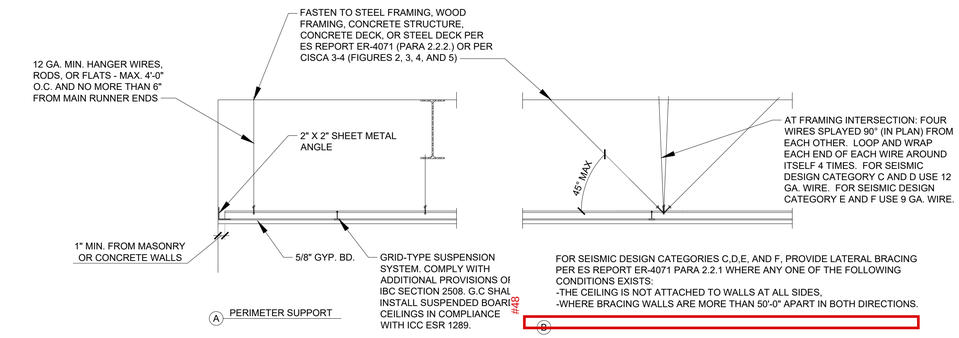

2 INSTALLATION OF SUSPENDED CEILING

USING GRID SUSPENSION SYSTEM

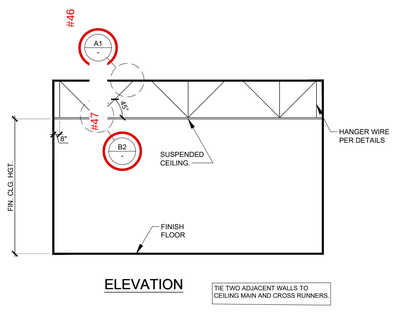


ELEVATION

TIE TWO ADJACENT WALLS TO CEILING MAIN AND CROSS RUNNERS.

3 SUSPENDED CEILING BRACING

3/4" = 1'-0"

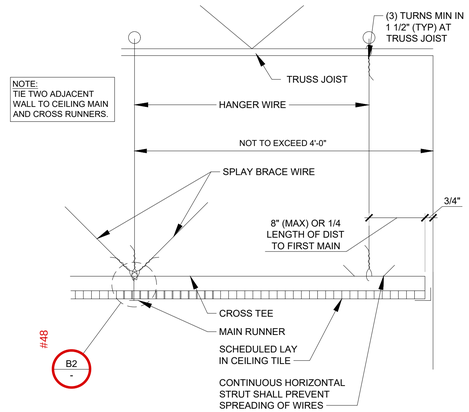

4 SUSPENDED CEILING BRACING

1" = 1'-0"

SARGENTI

5840 LEGACY CIR - STE D230, PLANO, TX 75024
T|201.316.5491 ★ WWW.SARGARCH.COM

SEAL:

STATE OF COLORADO
ROBERT J. SARGENTI
305929
LICENSED ARCHITECT

DATE SIGNED: 10/15/2026

CONTRACTOR'S NOTES:

WRITTEN DIMENSIONS HOLD PREFERENCE OVER SCALED DIMENSIONS. DO NOT SCALE THE DRAWINGS. THE CONTRACTORS MUST VISIT JOB SITE TO VERIFY ALL EXISTING CONDITIONS AND DIMENSIONS BEFORE SUBMITTING BIDS. REPORT ANY DISCREPANCIES OF ANY CONDITIONS WHICH MAY INTERFERE WITH THE PROPER EXECUTION OF, THE CONTRACT TO THE TENANT'S REPRESENTATIVE. REPORT DISCREPANCIES DURING BIDDING PROCESS AND BEFORE START OF CONSTRUCTION. CHANGE ORDERS NEED TO BE APPROVED BY THE CONSTRUCTION MANAGER FOR ISSUES ARISING FROM THE FIELD CONDITIONS OR CONFLICTS BETWEEN THE PLANS AND THE EXISTING CONDITIONS PRIOR TO THE COMMENCEMENT OF WORK.

	DATE	ISSUE
△	DATE	REVISION

LOCATION:

Consumer Cellular®

8283 S. AKRON ST.
SUITE #110
CENTENNIAL, CO 80112

STORE NUMBER:

CO2

PROJECT INFORMATION:


DATE: 10/14/2026
PROJECT NUMBER: 15066 - 26
STORE TYPE: TIER 2
DRAWN BY: GV
REVIEWED BY: AN

TITLE:


CEILING DETAILS

SHEET NUMBER:


A501

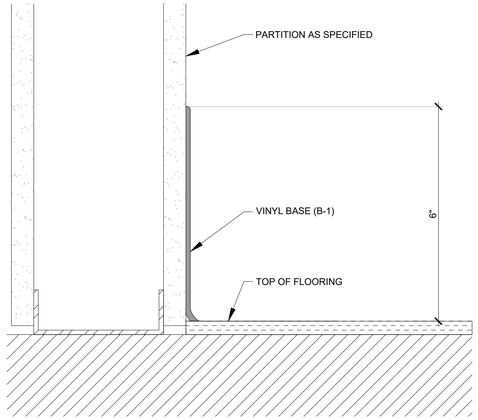

1 VINYL BASE (SALES AREA AND HALLWAY)
6" = 1'-0"

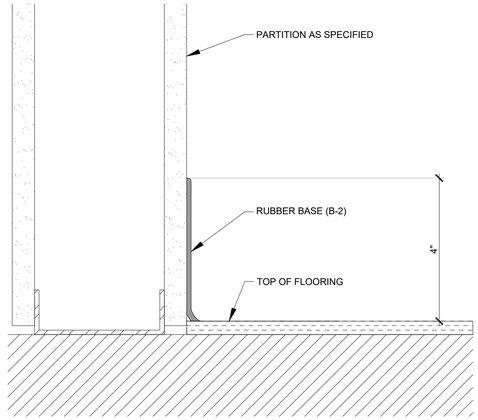


2 RUBBER BASE (BACK OF HOUSE)
6" = 1'-0"

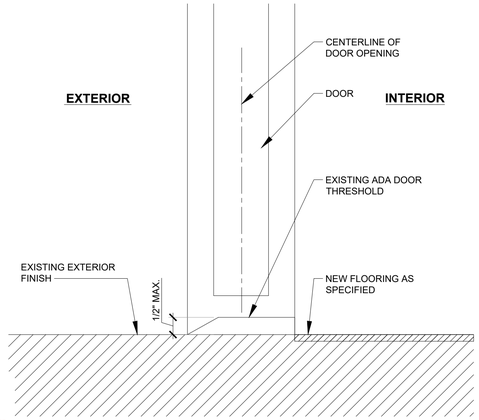


#28
3 ~~FLOOR DETAIL AT ENTRY~~
6" = 1'-0"

4 NOT USED
6" = 1'-0"

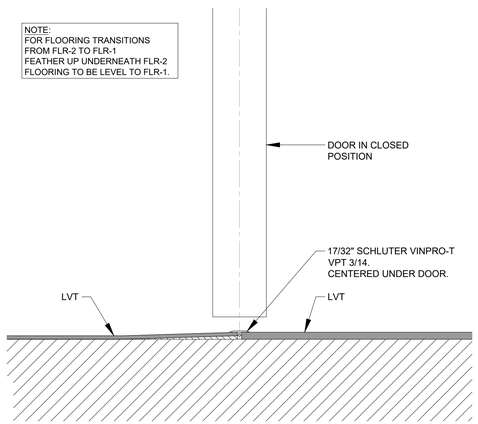

#27
5 ~~LVT TO LVT TRANSITION~~
6" = 1'-0"

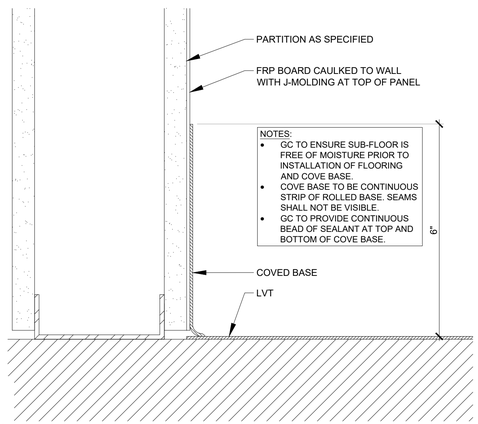


#44
6 ~~RESTROOM COVE BASE~~
6" = 1'-0"

GENERAL NOTES

1. IF EXISTING CONDITIONS VARY, CONTACT ARCHITECT FOR ALTERNATE TRANSITION PROFILES.
2. FLOORING TRANSITIONS TO BE PROVIDED BY G.C. AS INDICATED IN THE RESPONSIBILITY SCHEDULE ON SHEET G001.
3. PREPARE EXISTING FLOOR SURFACE PER MANUFACTURER SPECIFICATIONS FOR INSTALLATION OF NEW FLOORING MATERIALS AS INDICATED IN THESE PLANS
4. SEE MANUFACTURER SPECIFICATIONS FOR FLOORING EXPANSION

SARGENTI
5840 LEGACY CIR - STE D230, PLANO, TX 75024
T|201.316.5491 ★ WWW.SARGARCH.COM

SEAL:

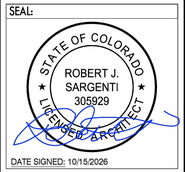

DATE SIGNED: 10/15/2026

CONTRACTOR'S NOTES:

WRITTEN DIMENSIONS HOLD PREFERENCE OVER SCALED DIMENSIONS. DO NOT SCALE THE DRAWINGS. THE CONTRACTORS MUST VISIT JOB SITE TO VERIFY ALL EXISTING CONDITIONS AND DIMENSIONS BEFORE SUBMITTING BIDS. REPORT ANY DISCREPANCIES OF ANY CONDITIONS WHICH MAY INTERFERE WITH THE PROPER EXECUTION OF, THE CONTRACT TO THE TENANT'S REPRESENTATIVE. REPORT DISCREPANCIES DURING BIDDING PROCESS AND BEFORE START OF CONSTRUCTION. CHANGE ORDERS NEED TO BE APPROVED BY THE CONSTRUCTION MANAGER FOR ISSUES ARISING FROM THE FIELD CONDITIONS OR CONFLICTS BETWEEN THE PLANS AND THE EXISTING CONDITIONS PRIOR TO THE COMMENCEMENT OF WORK.

	DATE	ISSUE
△	DATE	REVISION

LOCATION:

Consumer Cellular®

8283 S. AKRON ST.
SUITE #110
CENTENNIAL, CO 80112

STORE NUMBER:

CO2

PROJECT INFORMATION:


DATE: 10/14/2026
PROJECT NUMBER: 15066 - 26
STORE TYPE: TIER 2
DRAWN BY: GV REVIEWED BY: AN

TITLE:


FLOORING AND BASE DETAILS

SHEET NUMBER:

A502

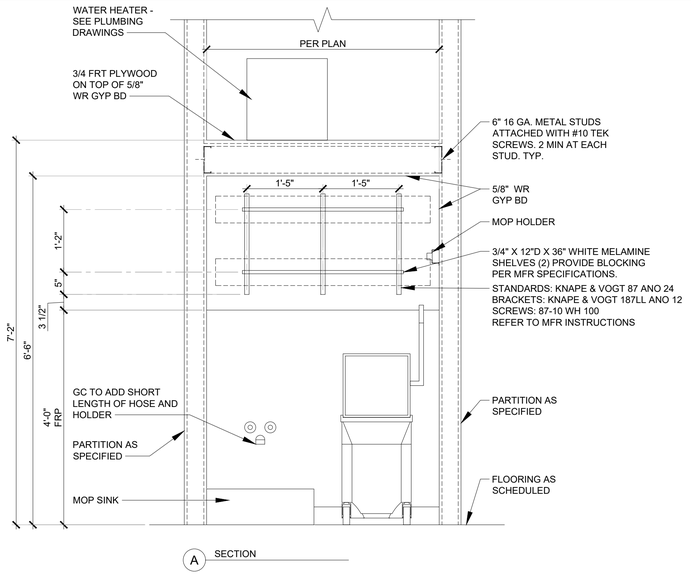

A SECTION

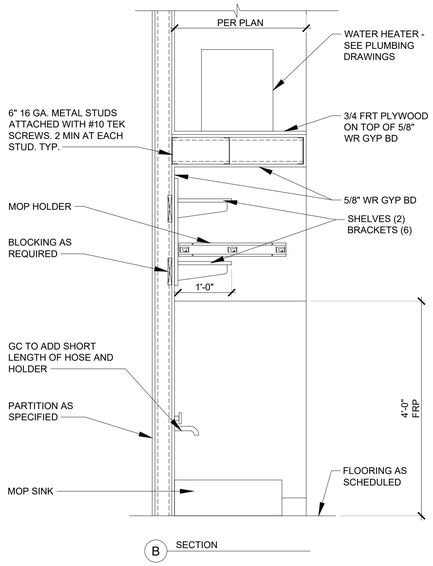

B SECTION

#41

1 MOP SINK DETAILS (FOR REFERENCE ONLY)

3/4"=1'-0"

SARGENTI
5840 LEGACY CIR - STE D230, PLANO, TX 75024
T|201.316.5491 ★ WWW.SARGARCH.COM

SEAL:

STATE OF COLORADO
ROBERT J. SARGENTI
305929
LICENSED ARCHITECT

DATE SIGNED: 10/15/2026

CONTRACTOR'S NOTES:

WRITTEN DIMENSIONS HOLD PREFERENCE OVER SCALED DIMENSIONS. DO NOT SCALE THE DRAWINGS. THE CONTRACTORS MUST VISIT JOB SITE TO VERIFY ALL EXISTING CONDITIONS AND DIMENSIONS BEFORE SUBMITTING BIDS. REPORT ANY DISCREPANCIES OF ANY CONDITIONS WHICH MAY INTERFERE WITH THE PROPER EXECUTION OF, THE CONTRACT TO THE TENANT'S REPRESENTATIVE. REPORT DISCREPANCIES DURING BIDDING PROCESS AND BEFORE START OF CONSTRUCTION. CHANGE ORDERS NEED TO BE APPROVED BY THE CONSTRUCTION MANAGER FOR ISSUES ARISING FROM THE FIELD CONDITIONS OR CONFLICTS BETWEEN THE PLANS AND THE EXISTING CONDITIONS PRIOR TO THE COMMENCEMENT OF WORK.

	DATE	ISSUE

△	DATE	REVISION

LOCATION:

Consumer Cellular®

8283 S. AKRON ST.
SUITE #110
CENTENNIAL, CO 80112

STORE NUMBER:

CO2

PROJECT INFORMATION:

DATE: 10/14/2026
PROJECT NUMBER: 15066 - 26
STORE TYPE: TIER 2
DRAWN BY: GV REVIEWED BY: AN

TITLE:

MOP SINK DETAILS

SHEET NUMBER:


A504

DOOR SCHEDULE


DOOR #	DESCRIPTION	DOOR				FRAME		DETAILS			FIRE RATING	HARDWARE	FURNISHED BY	INSTALLED BY	NOTES
		SIZE	TYPE	MATERIAL	FINISH	MATERIAL	FINISH	SILL	JAMB	HEAD					
1A	(E) EXTERIOR MAIN ENTRY/EXIT	(2) 3'-0"X7'-0"X1 3/4" V.I.F.	A	EXISTING	EXISTING	EXISTING	EXISTING	EXISTING	EXISTING	EXISTING	-	EXISTING	EXISTING	EXISTING	1, 2, 3, 4, 5, 6, 29, 30, 31,32, 33
2B	(E) EXTERIOR HALLWAY	3'-0"X7'-0"X1 3/4" V.I.F.	B	EXISTING	PAINT PT-2	EXISTING	PAINT PT-2	EXISTING	EXISTING	EXISTING	-	A6, C2, H1, P1	EXISTING	EXISTING	3, 5, 6, 7, 8, 9, 10, 26, 34
3C	UTILITY	3'-0"X7'-0"X1 3/4"	C	WOOD (WHITE BIRCH)	CLEAR SATIN STAIN	HOLLOW METAL	P-2 SEMI GLOSS	A502	3/A600	2/A600	-	A10, C3, G2, H1, L6	G.C	G.C	
4C	UNISEX RESTROOM	3'-0"X7'-0"X1 3/4"	C	WOOD (WHITE BIRCH)	CLEAR SATIN STAIN	HOLLOW METAL	P-2 SEMI GLOSS	A502	3/A600	2/A600	-	A10, C3, G2, H1, L6	G.C	G.C	
5C	BOH	3'-0"X7'-0"X1 3/4"	C	WOOD (WHITE BIRCH)	CLEAR SATIN STAIN	HOLLOW METAL	P-2 SEMI GLOSS	A502	#23 3/A600	#24 2/A600	-	A10, C3, E3, G2, H1	G.C	G.C	
6C	OFFICE	3'-0"X7'-0"X1 3/4"	C	WOOD (WHITE BIRCH)	CLEAR SATIN STAIN	HOLLOW METAL	P-2 SEMI GLOSS	A502	3/A600	2/A600	-	A10, C3, G2, H1, L6	G.C	G.C	

DOOR HARDWARE LEGEND


ACCESSORIES				CLOSERS		ELECTRONIC HARDWARE		GASKETS		HINGES		LOCKSET		PANIC ALARM	
A1	PUSH/PULL BARS - ROCKWOOD BF 15847-1	A9	IVES 10 X 34 8400 KICK PLATE	C1	LCN 6030	E1	SECURITECH TEL-210S*	G1	IVES FS436 DOORSTOP	H1	MCKINNEY TA2714 NRP 4.5X4.5 HINGE	L1	BEST CYLINDER LOCK	P1	YALE 6100ED A-ALR 36 BSP 6000 SERIES
A2	INTERMEDIATE PIVOT - RIXON #M19 - OFFSET	A10	IVES #20 SILENCERS	C2	LCN 5010	E2	SECURITECH 4850-TTBG-37 5-POINT LOCK	G2	IVES WS406 CCV DOORSTOP	H2	HAGER 253** 4 1/2 " WIDE PIVOT HINGE	L2	QMI CYLINDER SILVER SHUTTER CURTAIN - LOCK OUTSIDE		
A3	TOP PIVOT - RIXON #180 - OFFSET	A11	TOP PIVOT - RIXSON 340	C3	LCN 4000 SERIES	E3	TRILOGY DL2700IC-26D	G3	DOOR SWEEP	H3	HAGER BB1191 NRP HINGE	L3	QMI CYLINDER SILVER SHUTTER CURTAIN - LOCK INSIDE-OUTSIDE		
A4	BOTTOM PIVOT - RIXON #147 - OFFSET	A12	CENTER HUNG PIVOT SET - RIXSON 370	C4		E4	SECURITECH DETEX V40-EB-HD-AL-REW-IC7-99	G4		H4	BOTTOM PIVOT - RIXSON #147 - OFFSET	L4	FALCON ND10S RHODES PASSAGE LATCH SET		
A5	NATIONAL GUARD US32D, US28, US15 FINISH THRESHOLD	A13	IVES U696 PEEP HOLE	C5		E5		G5		H5		L5	FALCON T581 AVALON STOREROOM LOCKSET		
A6	NATIONAL GUARD MILL FINISH THRESHOLD	A14	CRL BRUSHED STAINLESS 48" EXTRA LENGTH LADDER STYLE BACK-TO-BACK PULL	C6		E6		G6		H6		L6	FALCON TM301S AVALON PRIVACY LATCH SET		
A7	NATIONAL GUARD CRL8010ADJ THRESHOLD	A15	DOOR CLOSERS USA - STOREFRONT DOOR ADA COMPLIANT OFFSET PULL HANDLE AND SINGLE BEND PUSH BAR SET, CLEAR ANODIZED FINISH	C7		E7		G7		H7		L7	SCHLAGE D70PD RHODES OFFICE LOCKSET		
A8	IVES SR-64 SILENCERS	A16	BEA 10PBS451 STAINLESS STEEL PUSH PLATE, 4.5 IN. SQUARE, BLUE HANDICAP LOGO AND TEXT	C8		E8		G8		H8		L8	FALCON 8242-AL AUTOMATIC DOOR OPENER		

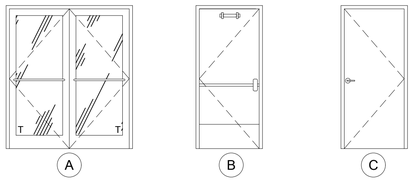

1 DOOR TYPES

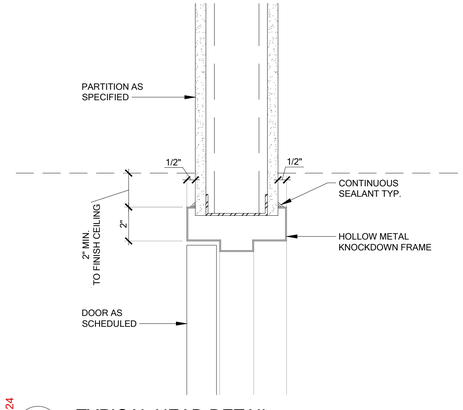

#24 2 TYPICAL HEAD DETAIL
3" = 1'-0"

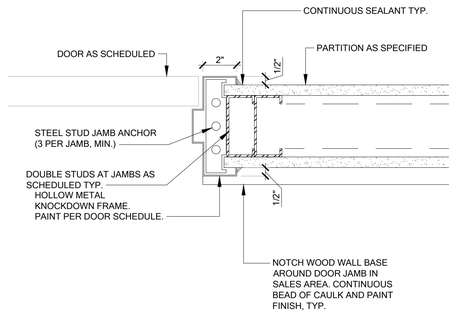

#23 3 TYPICAL JAMB DETAIL
3" = 1'-0"

DOOR NOTES LEGEND

1. SIGNAGE BY G.C.; PROVIDE SIGNAGE ABOVE DOOR(S), SEE SHEET G002.
2. POSTAL ADDRESS NUMBERS PER LANDLORD REQUIREMENTS.
3. ADA PANIC HARDWARE TO BE INSTALLED ON INSIDE WHEN REQUIRED BY LOCAL JURISDICTION.
4. LOCKS SHALL BE KEY-OPERATED WITH INDICATOR TO BE READILY DISTINGUISHABLE AS LOCKED.
5. WEATHER STRIPPING AND SWEEPS TO BE INSTALLED AS REQUIRED.
6. EXISTING DOOR - VERIFY EXISTING HARDWARE MEETS REQUIREMENTS OF, OR IS EQUAL TO SPECIFIED HARDWARE. REPLACE WITH SPECIFIED HARDWARE AS REQUIRED.
7. KICK PLATE TO BE PROVIDED ON PUSH SIDE. IF NOT, PROVIDE AND INSTALL NEW KICK PLATE ON PUSH SIDE OF DOOR: IVES 8400 10"X2" LDW630.
8. VERIFY ALL EXISTING DOOR HARDWARE TO COMPLY WITH CURRENT CODE.
9. HARDWARE PURCHASED AND INSTALLED BY G.C., DOOR PREP BY G.C..
10. PROVIDE NON REMOVABLE PINS (NRP), PIANO TYPE HINGE OR GEARED HINGE (ROTON) AS APPROVED BY CONSUMER CELLULAR ON IN-SWINGING DOOR.
11. ROLL DOWN SHUTTER SHALL BE OPERABLE FROM INSIDE WITHOUT THE USE OF A KEY OR SPECIAL KNOWLEDGE OR EFFORT WHILE THE SPACE IS OCCUPIED.
12. SHUTTER SHALL REMAIN SECURED IN THE FULL OPEN POSITION DURING THE PERIOD OF OCCUPANCY BY THE GENERAL PUBLIC.
13. MAX SHUTTER SIZE: 160 SF OR 150" HIGH.
14. PROVIDE RISER AS REQUIRED FOR CARPET INSTALLATION.
15. PROVIDE LATCH GUARD USE "BG" GUARD PLATE.
16. PROVIDE 5 1/2" THROAT.
17. VERTICALLY STIFFED HOLLOW METAL DOOR RECOMMENDED FOR SECURITY AND EASE OF INSTALLATION.
18. LOCK HARDWARE PURCHASED AND INSTALLED BY G.C. THROUGH APPROVED VENDOR, SECURITY SOURCE.
19. MOUNT AT UPPER CORNER OF DOOR AND JAMB.
20. PROVIDE APPROPRIATE RESTROOM SIGNAGE, SEE SHEET G002 & THE ENLARGED RESTROOMS PLANS.
21. LOCK HARDWARE PURCHASED AND INSTALLED BY SECURITY SOURCE (VENDOR), DOOR PREP BY G.C..
22. ORDER 6" BOTTOM BAR WITH 60° BEVEL (ALTERNATE OPTION: 10" BOTTOM BAR), 7-PIN KEYED CYLINDERS (CONSTRUCTION CORES) WITH THUMBTURNS ON INSIDE, AND PATCH HINGES WITH DOOR.
23. PROVIDE LOUVRE VENT IN DOOR U.O.N. SEE MECHANICAL SHEETS.
24. G.C. TO PAINT 4 INCH "NO STORAGE" ON DOOR.
25. PROVIDE IC-7PIN MORTISE HOUSING AND INSTAKEY CORE.
26. G.C. TO ADD HAGER 1756 PEEPHOLE TO REAR EXIT DOOR WHEN NONE IS EXISTING. VIEWER TO BE INSTALLED APPROXIMATELY 60" AFF, CENTERED HORIZONTALLY ON DOOR AND SUITABLE FOR METAL DOOR INSTALLATION WITH WIDE ANGLE LENS. SEAL AND SECURE VIEWER TIGHTLY TO MAINTAIN DOOR INTEGRITY. UL LISTED FOR 90 MINUTE FIRE DOOR (UL10B).
27. SELF-LATCHING LOCK HARDWARE PURCHASED AND INSTALLED THROUGH SECURITY SOURCE (VENDOR) BY G.C. DOOR PREP BY G.C.
28. SUPPLY COMPLETE EXIT DEVICE PART NUMBER BASED ON DOOR SIZE AS REQUIRED. 36" DOOR = 36, NARROW STILE = NS, DOUBLE DOOR = 94. FOR NARROW STILE, ADD NARROW STILE KIT #101879-1.
29. PROVIDE ADDITIONAL INTERMEDIATE PIVOT FOR DOORS 8'-0" AND TALLER.
30. DO NOT PROVIDE HOLD OPEN DEVICE ON DOOR IF TACTILE SIGNAGE IS MOUNTED TO DOOR.
31. G.C. TO FIELD VERIFY CONDITION OF EXISTING DOOR HARDWARE AND COORDINATE WITH OWNER IF REPLACEMENT IS REQUIRED.
32. G.C. TO CLEAN EXISTING DOORS TO LIKE NEW CONDITION. G.C. TO INSTALL BOTTOM RAIL ADAPTER (CRL #10AD, DOOR CLOSERS USA #SF-ADA-36KIT-A OR EQ) TO EXTEND BOTTOM RAIL TO 10" MIN. TO MEET CODE WHEN REQUIRED.
33. GC TO ADD ADDRESS/SUITE NUMBERS TO ENTRY/ EXIT DOORS WHEN NOT EXISTING. NUMBERS HAVE HIGH CONTRAST WITH DOOR SURFACE. NUMBER TO BE 4" IN HEIGHT AND INSTALLED 60" AFF CENTERED ON DOOR.
34. GC TO INSTALL BLANK PLATE TO EXTERIOR SIDE OF DOOR AT HARDWARE LOCATION, IF REQUIRED.

GENERAL NOTES

A. HARDWARE FINISHES SHALL BE SATIN CHROME 626 UNLESS NOTED OTHERWISE.
B. ALL LOCKSETS AND LATCH SETS SHALL BE LEVER HANDLES.
C. VERIFY ALL EXISTING DOOR HARDWARE TO COMPLY WITH CURRENT CODE. SHALL NOT REQUIRE TIGHT GRASPING, TIGHT PINCHING OR TWISTING OF THE WRIST TO OPERATE. VERIFY EXISTING DOOR HANDLES, PULLS, LATCHES, LOCKS AND OTHER OPERATING DEVICES ARE INSTALLED BETWEEN 34" - 48" AFF.
D. G.C. TO PURCHASE AND INSTALL CORES PER HARDWARE SCHEDULE FROM CONSUMER CELLULAR'S VENDOR AT TIME OF STORE TURNOVER.
E. AT EXISTING DOORS TO REMAIN, VERIFY THAT EXISTING DOOR AND HARDWARE MEETS OR EXCEEDS THE REQUIREMENTS OF THESE SPECIFICATIONS. REPLACE AS REQUIRED.
F. DOORS WITH CLOSERS SHALL COMPLY WITH THE FOLLOWING:
   1. 5LBF MAXIMUM FORCE FOR OPENING DOOR
   2. FROM AN OPEN POSITION OF 70°, DOOR SHALL TAKE AT LEAST 3 SECONDS TO MOVE TO A POINT 3 INCHES FROM THE LATCH, MEASURED TO THE LEADING EDGE OF THE DOOR.
G. DOORS/FRAMES SHALL BE "TIMELY" (OR EQUAL) FACTORY FINISH TO MATCH P1.
H. LEVER SETS TO BE FALCON GRADE 1 WITH INTERCHANGEABLE CORES. T-SERIES OR APPROVED EQUAL LEVER TO BE AVALON STYLE.
I. SECURITECH TRIDENT EXIT DEVICES SUPPLIED BY LP NETWORK INC., DBA SECURITY SOURCE (888) 836-2137
J. EXIT DOORS SHALL BE READILY OPENABLE FROM THE EGRESS SIDE, WITHOUT THE USE OF A KEY OR SPECIAL KNOWLEDGE OR EFFORT. THE UNLATCHING OF ANY EXIT DOOR SHALL NOT REQUIRE MORE THAN ONE OPERATION. INSTALL ALL PANIC HARDWARE PER PLANS.
K. ALL DOORS EXCEPT THE MAIN ENTRANCE DOORS SHALL COMPLY WITH ICC / ANSI A-117.1 2009 SECTION 309.4 AND 404 2.6, AND IBC SECTION 1008.1.9. THE OPERABLE PARTS OF THE DOOR HARDWARE SHALL HAVE A SHAPE THAT IS EASY TO GRASP WITH ONE HAND AND DOES NOT REQUIRE TIGHT GRASPING, PINCHING OR THE TWISTING OF THE WRIST. THE FORCE TO ACTIVATE THE DOOR HARDWARE SHALL BE 5.0 POUNDS MAXIMUM.

SARGENTI
5840 LEGACY CIR - STE D230, PLANO, TX 75024
T|201.316.5491 ■ WWW.SARGARCH.COM

SEAL:

STATE OF COLORADO ★ ROBERT J. SARGENTI 305929 ★ LICENSED ARCHITECT

DATE SIGNED: 10/15/2026

CONTRACTOR'S NOTES:

WRITTEN DIMENSIONS HOLD PREFERENCE OVER SCALED DIMENSIONS. DO NOT SCALE THE DRAWINGS. THE CONTRACTORS MUST VISIT JOB SITE TO VERIFY ALL EXISTING CONDITIONS AND DIMENSIONS BEFORE SUBMITTING BIDS. REPORT ANY DISCREPANCIES OF ANY CONDITIONS WHICH MAY INTERFERE WITH THE PROPER EXECUTION OF, THE CONTRACT TO THE TENANT'S REPRESENTATIVE. REPORT DISCREPANCIES DURING BIDDING PROCESS AND BEFORE START OF CONSTRUCTION. CHANGE ORDERS NEED TO BE APPROVED BY THE CONSTRUCTION MANAGER FOR ISSUES ARISING FROM THE FIELD CONDITIONS OR CONFLICTS BETWEEN THE PLANS AND THE EXISTING CONDITIONS PRIOR TO THE COMMENCEMENT OF WORK.

	DATE	ISSUE
△	DATE	REVISION

LOCATION:

Consumer Cellular®

8283 S. AKRON ST.
SUITE #110
CENTENNIAL, CO 80112

STORE NUMBER:

CO2

PROJECT INFORMATION:

DATE: 10/14/2026
PROJECT NUMBER: 15066 - 26
STORE TYPE: TIER 2
DRAWN BY: GV REVIEWED BY: AN

TITLE:

DOOR SCHEDULE AND DETAILS

SHEET NUMBER:

A600

FINISH SCHEDULE

	TAG	LOCATION USED	PRODUCT #/ NAME	DESCRIPTION	MANUFACTURER	COLOR/FINISH	SIZE	CONTACT		NOTES
PAINT	PT-1	SEE ELEVATIONS	SW 6070	PAINT	SHERWIN WILLIAMS	HERON PLUME / EGGSHELL		BRETT HUCKELBERRY	O | 214.553.3940 C | 214.728.6695	REFER TO ELEVATIONS
	PT-2	SEE ELEVATIONS	SW 7650	PAINT	SHERWIN WILLIAMS	ELLIE GRAY / EGGSHELL				REFER TO ELEVATIONS
	PT-3	SEE ELEVATIONS	SW 7674	PAINT	SHERWIN WILLIAMS	PEPPERCORN / EGGSHELL				REFER TO ELEVATIONS
	PT-4	SEE ELEVATIONS	SW 6885	PAINT	SHERWIN WILLIAMS	KNOCKOUT ORANGE / EGGSHELL				REFER TO ELEVATIONS
FLOORING/ SURFACES	FLR-1	SALES FLOOR & HALLWAY	EARTHEN I834V	LVT	PATCRAFT	DUSK 00520	12"X24"	BRAD TORNABENE	O | 800-241-4014 C | 480.276.8355 brad.tornabene@patcraft.com	4MM 20 MIL
	FLR-2	RESTROOMS	STONES 2.5 C2119	LVT	MOHAWK GROUP	989 VALLE DE BOVE	12"X24"	SHANAN KOPLAN	C | 561.866.5973 shanan_koplan@mohawkind.com	HALF LAP INSTALLATION
	FLR-3	BOH	CHALK 930 IND	VINYL TILE	EMSER	CHALK 930 IND	18" X 18"	MICHELLE OSBORNE	O | 480-443-8453 C | 480.285.9716 michelleosborne@emser.com	GC TO SUBSTITUTE WITH SLAB 921 IF CHALK 930 IND IS NOT IN STOCK.
	T-6	SALES, BOH	243150 / DEKTON NATURA	SOLID SURFACE COUNTERTOP	COSENTINO	NATURA 18		213.265.0756	213.265.0756	
LAMINATE	LAM-1	SEE ELEVATIONS	7197-58	LAMINATE	FORMICA	DOVER WHITE/ MATTE		SCOTT PETRO	623.225.8941	
	LAM-3	SEE ELEVATIONS	2297-PX	LAMINATE	FORMICA	TERRIL / PLEX		SCOTT PETRO	623.225.8943	
	LAM-4	SEE ELEVATIONS	8208K-16	LAMINATE	WILSONART	FAWN CYPRESS / MATTE		JOSEPH KLUGER	469.616.4958	
	LAM-6	SEE ELEVATIONS	1573-60	LAMINATE	WILSONART	FROSTY WHITE MATTE				
BASE & TRIM	B-1	SALES	MANDALAY MW-40-H6	VINYL BASE	TARKETT	BLACK	6"			
	B-2	BOH	700 SERIES WALL BASE	RUBBER COVE BASE	ROPPE	193 BLACK BROWN	4"			
	B-3	RESTROOMS	WALL BASE MOLDING - 820NA1 / 76174	THERMOPLASTIC COVE BASE	GRAINGER	SNOW WHITE	6"			GC TO SUBSTITUTE BLACK 6" TRIM IF WHITE IS OUT OF STOCK
	FRP	MOP SINK AREA / RESTROOMS	P100	PEBBLED FRP	MARLITE	WHITE				FRP TRIM TO BE: EDGE M370, OUTSIDE CORNER M360 AND INSIDE CORNER M350
CEILING	C-1	SEE PLANS		GYP BOARD CEILING						
	C-2	SEE PLANS	GRID: 15/16" STANDARD / TILE: CANYON 1492	ACT CEILING TILE	ARMSTRONG	WHITE / SMOOTHE	24"		1.877.276.7876	BEVELED TEGULAR EDGE

FURNITURE, FIXTURES AND EQUIPMENT SCHEDULE

	TAG	LOCATION USED	PRODUCT #/ NAME	DESCRIPTION	MANUFACTURER	COLOR/FINISH	SIZE	CONTACT		NOTES
FURNITURE	F-1	SALES AREA	SF0726	ELEMENT SOFA	ANDREU WORLD	FAB-3	67.32W" X 31.10" D X 32.28" H	MARY BLANCHARD	602.515.2736	
	F-2	SALES AREA	783	LOUNGE CHAIR	ACCERAY	FAB-1	31'' H x 27.5'' W x 27.5'' D	MELANINE VINDIVICH	MELANIE@SALESWESTGROUP.COM	
	F-3	SALES AREA	SOLO N CHAIR	LOUNGE CHAIR	ACCERAY	SEE NOTES	29"W x 31" D x 34" H	MELANINE VINDIVICH	MELANIE@SALESWESTGROUP.COM	
	F-4	SALES AREA	109592	COUNTER STOOL	ZUO	VINTAGE BLACK	18.9" W x 22.4" D x 36.2" H			
	F-5	SALES AREA	109590	BARSTOOL	ZUO	VINTAGE BLACK	18.9" W x 22.4" D x 40.2" H			
	F-6	SALES AREA	GTAB1025MTB	RECTANGULAR COFFEE TABLE	NOIR	BLACK STEEL WITH WHITE MARBLE TOP	64" W x 32"D x18" H	PEGGY HICKLIN	PEGGYH@BASSMANBAINE.COM	
	F-7	SALES AREA	11537/11269-CTB	ROUND COFFEE TABLE	MITCHELL GOLD + BOBBY WILLIAMS	VIENNA ROUND WHITE MARBLE PEWTER BASE	38" W x 38" D x 12" H			
	F-8	BOH AREA	TACHIC PARSONS CHAIR	BREAK ROOM CHAIRS	LATITUDE RUN	BLACK	21.1"D x 20.1" x 30.1 H			
	F-9	BOH AREA	PEDESTAL DINING TABLE	BREAK ROOM TABLE	ORREN ELLIS	WHITE	29.75" H x 41.38" D x 41.38" L			
	F-10	SALES AREA	SF2067	RAGLAN SOFA	ANDREU WORLD	FAB-3	76.77" W x 29.53" D x 28.35" H	MARY BLANCHARD	602.515.2736	
	F-11	SALES AREA	SPEC TBD BY OWNER	TABLE	SPEC TBD BY OWNER	SPEC TBD BY OWNER	SPEC TBD BY OWNER			
FABRICS	FAB-1	LOUNGE CHAIR	PATTERN: VECTOR	FABRIC	CONCERTEX	CHARCOAL / GRAFFITI-FREE	54"W	KRISTEN BENKO		
	FAB-3	SOFA	PATTERN: LYON	FABRIC	CONCERTEX	SADDLE	54"W	KRISTEN BENKO		
B.O.H FIXTURES	SHELVES	BOH AREA	H-3913	HEAVY-DUTY STEEL SHELVING	ULINE	TOUGH-POWDER COAT FINISH	48" X 24" X 72"			SHELVING ABOVE MOP SINK IS ON DETAIL 6/A500
	CABINET	BOH AREA	H-1871GR	JUMBO HEAVY DUTY STORAGE CABINET	ULINE	GRAY	48" X 24" X 78"			
	LOCKERS	BOH AREA	H-4808GR	DOUBLE TIER LOCKERS- 3 WIDE	ULINE	GRAY	36" x 12" x 72"			
	IT RACK	BOH AREA	SR18UB	SMARTRACK 18U MID-DEPTH HALF-HEIGHT RACK ENCLOSURE	TRIPP.LITE	BLACK				
	CAGE	BOH AREA	H-8297-4	WIRE SECURITY ROOM WITH ROOF (4 SIDED)	ULINE		8'X8', 4 SIDED			BUILT IN CYLINDER LOCK WITH KEYS INCLUDED. GC TO INSTALL SPACERS DOWN THE CENTER OF THE CAGE ON THE ROOF AND BACK WALL OF THE CAGE TO ACCOMMODATE A 1" GAP FROM THE DOOR TO THE DOOR JAMB TO ALLOW FOR THE ELECTRONIC STRIKE.
RUGS	RUG-1	SALES FLOOR	CT47977 / PATINA	AREA RUG WITH ADA EDGING	PATCRAFT	COLORWAY : CUSTOM	8' X 10'	CHANTEL WOLTERS	702.888.2071	Colors: ZF1507, 57900, C1726, CJ553, C1752
	RUG-2	SALES FLOOR	YF83331 1095388	AREA RUG WITH ADA EDGING	PATCRAFT	COLORWAY : CUSTOM	8' X 10'	CHANTEL WOLTERS	702.888.2071	
	RUG-3	SALES FLOOR	CUBE AND COLOUR	ROUND AREA RUG WITH ADA EDGING	PATCRAFT	TANGERINE 00650	10' DIAMETER	CHANTEL WOLTERS	702.888.2071	INSTALL: HERRINBONE PATTERN
	RUG-4	SALES FLOOR	YF83331 1095388	AREA RUG WITH ADA EDGING	PATCRAFT	COLORWAY : CUSTOM	10' X 16'	CHANTEL WOLTERS	702.888.2071	Colors: A:CI752, B:CJ553, C:CB216, D:CI726
	MAT-1	SALES FLOOR		WALK OFF MAT	MAD MATTER INC.	291 RICH CHARCOAL-BACKGROUND/ 233 MANDARIN ORANGE-LETTERS	5'X6'	BEN STORZ	benjamin@madmatter.com	
RESTROOM FIXTURES	P-1	RESTROOM	0356.421 / LUCERNE WALL-HUNG LAVATOTY	WALL MOUNTED SINK	AMERICAN STANDARD	WHITE				
	P-2	RESTROOM	K-97282-4-CP	LAVATORY FAUCET	KOHLER	SINGLE HOLE COMMERCIAL FAUCET	POLISHED CHROME			
	P-4	RESTROOM	B-2013	SOAP DISPENSER	BOBRICK	STAINLESS STEEL / SATIN	10" X 4-1/4"			
	P-5	RESTROOM	0600 / INTEROLOK STAINLESS STEEL FRAMED MIRROR	MIRROR	ASI	STAINLESS STEEL				
	P-6	RESTROOM	K-3505-0 / WELLWORTH CLASSIC	TOILET	KOHLER	WHITE		DANNY HOWE	DANNY.HOWE@KOHLER.COM	
	P-7	RESTROOM	VERDEDRI Q-973A2	SURFACE MOUNTED ADA COMPLIANT HAND DRYER	WORLD DRYER	BRUSHED STAINLESS STEEL				
	P-8	RESTROOM	780929	8 GALLON HALF ROUND TRASH CAN	COMMERCIAL ZONE	STAINLESS STEEL				
HARDWARE	LOCK-1	SEE ELEVATIONS	C8053 SERIES / C SERIES	CAM LOCK	HAFELE	NICKEL	30MM		800.423.3531	PROVIDE KEYED FLUSH MOUNT LOCKS
	PULL-1	SALES AREA	BP98988030	CABINET PULLS	RICHELIEU	WHITE			1.800.619.5446	

LIGHTING SCHEDULE

	TAG	LOCATION USED	MFG	PRODUCT #/ NAME	DESCRIPTION	COLOR/FINISH	SIZE	CONTACT		NOTES
LIGHTING SCHEDULE	L-1	SALES / REF. TO PLANS	LOTUS	LD4R-30K-HO-4R-WR-WT / LLL-LD2050TR / FRP4	4" RECESSED DOWNLIGHT	WHITE	4" DIA	CS ILLUMINATION	O | 760-477-1244x2230 D | 860.968.3879 alewis@csillumination.com	ADD ELV DIMMER
	L-2A	SALES / REF. TO PLANS	WAC LIGHTING	PD-22754-AL	LED LINEAR PENDANT	BRUSHED ALUMINUM	54"	CS ILLUMINATION	O | 760-477-1244x2230 D | 860.968.3879 alewis@csillumination.com	6'-6" A.F.F
	L-2B	SALES / REF. TO PLANS	WAC LIGHTING	PD-22754-AL	LED LINEAR PENDANT	BRUSHED ALUMINUM	54"	CS ILLUMINATION	O | 760-477-1244x2230 D | 860.968.3879 alewis@csillumination.com	FLUSH WITH TRELLIS
	L-3A	SALES / REF. TO PLANS	Y-LIGHTING	HERE COMES THE SUN MEDIUM PENDANT LIGHT/SIZE LARGE	PENDANT LIGHT	WHITE/COPPER				
	L-3B	SALES / REF. TO PLANS	Y-LIGHTING	HERE COMES THE SUN MEDIUM PENDANT LIGHT/SIZE MEDIUM	PENDANT LIGHT	WHITE/COPPER				
	L-3C	SALES / REF. TO PLANS	Y-LIGHTING	HERE COMES THE SUN MEDIUM PENDANT LIGHT/SIZE SMALL	PENDANT LIGHT	WHITE/COPPER	6.88", 9.84", 13.77"	CS ILLUMINATION	O | 760-477-1244x2230 D | 860.968.3879 alewis@csillumination.com	
	L-4	SALES / REF. TO PLANS	ET2 LIGHTING	E23111-18 / LARMES LINEAR	PENDANT LIGHT	POLISHED CHROME	5"W X 8"H	CS ILLUMINATION	O | 760-477-1244x2230 D | 860.968.3879 alewis@csillumination.com	
	L-5	SALES / REF. TO PLANS	DIODE	D1-24V-BLBSC2-30 / LED TAPE LIGHT	LED STRIP		CUTTING SIZE: EVERY 2.8"	CS ILLUMINATION	O | 760-477-1244x2230 D | 860.968.3879 alewis@csillumination.com	
	L-6	SALES / REF. TO PLANS	VALRIYA	VA-BPL-22-30-3000K	RECESSED 2'X2' AREA LIGHT GRID			CS ILLUMINATION	O | 760-477-1244x2230 D | 860.968.3879 alewis@csillumination.com	
	L-6 EM	SALES / REF. TO PLANS	VALRIYA	VA-BPL-22-30-3000K / VA EDA-LI15-50	RECESSED 2'X2' AREA LIGHT GRID 90 MINUTE BATTERY BACKUP			CS ILLUMINATION	O | 760-477-1244x2230 D | 860.968.3879 alewis@csillumination.com	
	L-6A	SALES / REF. TO PLANS	VALRIYA	VA-TTR-24-40-3000K	RECESSED 2'X4' AREA LIGHT GRID			CS ILLUMINATION	O | 760-477-1244x2230 D | 860.968.3879 alewis@csillumination.com	
	L-6A EM	SALES / REF. TO PLANS	VALRIYA	VA-TTR-24-40-3000K-VA-EDA-L115-50	RECESSED 2'X4' AREA LIGHT GRID 90 MINUTE BATTERY BACKUP			CS ILLUMINATION	O | 760-477-1244x2230 D | 860.968.3879 alewis@csillumination.com	
	L-7	SALES / REF. TO PLANS	LUMENTURE	RWW160-30H-W-W	RECESSED WALL WASHER		3-1/8" X 7-3/8"	CS ILLUMINATION	O | 760-477-1244x2230 D | 860.968.3879 alewis@csillumination.com	
	L-8	RESTROOM / REF. TO PLANS	MAXIM LIGHTING	52000	WALL SCONCE	SATIN NICKEL	18"W x 1.75"H x 2.25"	CS ILLUMINATION	O | 760-477-1244x2230 D | 860.968.3879 alewis@csillumination.com	
	L-9	SALES / REF. TO PLANS	DUAL LITE	LZ-2-03L	SURFACE MOUNT EM FIXTURE	WHITE		CS ILLUMINATION	O | 760-477-1244x2230 D | 860.968.3879 alewis@csillumination.com	
	EX	EXTERIOR/ REF. TO PLANS	BEST	2RL52-WH	DUAL LED REMOTE HEAD	WHITE		CS ILLUMINATION	O | 760-477-1244x2230 D | 860.968.3879 alewis@csillumination.com	90 MIN. EMERGENCY BATTERY BACKUP
	EX1	SALES / REF. TO PLANS	EXITRONIX	S900C-SM-G-WH-R	LED EXIT SIGN	GREEN LETTERS, WHITE HOUSING		CS ILLUMINATION	O | 760-477-1244x2230 D | 860.968.3879 alewis@csillumination.com	90 MIN. EMERGENCY BATTERY BACKUP

NOTE:
NOT ALL ITEMS LISTED ARE USED AT THIS LOCATION. PLEASE REFER TO SHEETS A101, A102 & THE INTERIOR ELEVATIONS FOR SITE SPECIFIC FINISHES.

SARGENTI

5840 LEGACY CIR - STE D230, PLANO, TX 75024
T|201.316.5491 ■ WWW.SARGARCH.COM

SEAL:

STATE OF COLORADO
ROBERT J. SARGENTI
305929
LICENSED ARCHITECT

DATE SIGNED: 10/15/2026

CONTRACTOR'S NOTES:

WRITTEN DIMENSIONS HOLD PREFERENCE OVER SCALED DIMENSIONS. DO NOT SCALE THE DRAWINGS. THE CONTRACTORS MUST VISIT JOB SITE TO VERIFY ALL EXISTING CONDITIONS AND DIMENSIONS BEFORE SUBMITTING BIDS. REPORT ANY DISCREPANCIES OF ANY CONDITIONS WHICH MAY INTERFERE WITH THE PROPER EXECUTION OF, THE CONTRACT TO THE TENANT'S REPRESENTATIVE. REPORT DISCREPANCIES DURING BIDDING PROCESS AND BEFORE START OF CONSTRUCTION. CHANGE ORDERS NEED TO BE APPROVED BY THE CONSTRUCTION MANAGER FOR ISSUES ARISING FROM THE FIELD CONDITIONS OR CONFLICTS BETWEEN THE PLANS AND THE EXISTING CONDITIONS PRIOR TO THE COMMENCEMENT OF WORK.

	DATE	ISSUE
△	DATE	REVISION

LOCATION:

Consumer Cellular

8283 S. AKRON ST.
SUITE #110
CENTENNIAL, CO 80112

STORE NUMBER:

CO2

PROJECT INFORMATION:

DATE: 10/14/2026
PROJECT NUMBER: 15066 - 26
STORE TYPE: TIER 2
DRAWN BY: GV REVIEWED BY: AN

TITLE:

ARCHITECTURAL SPECIFICATIONS

SHEET NUMBER:

A700