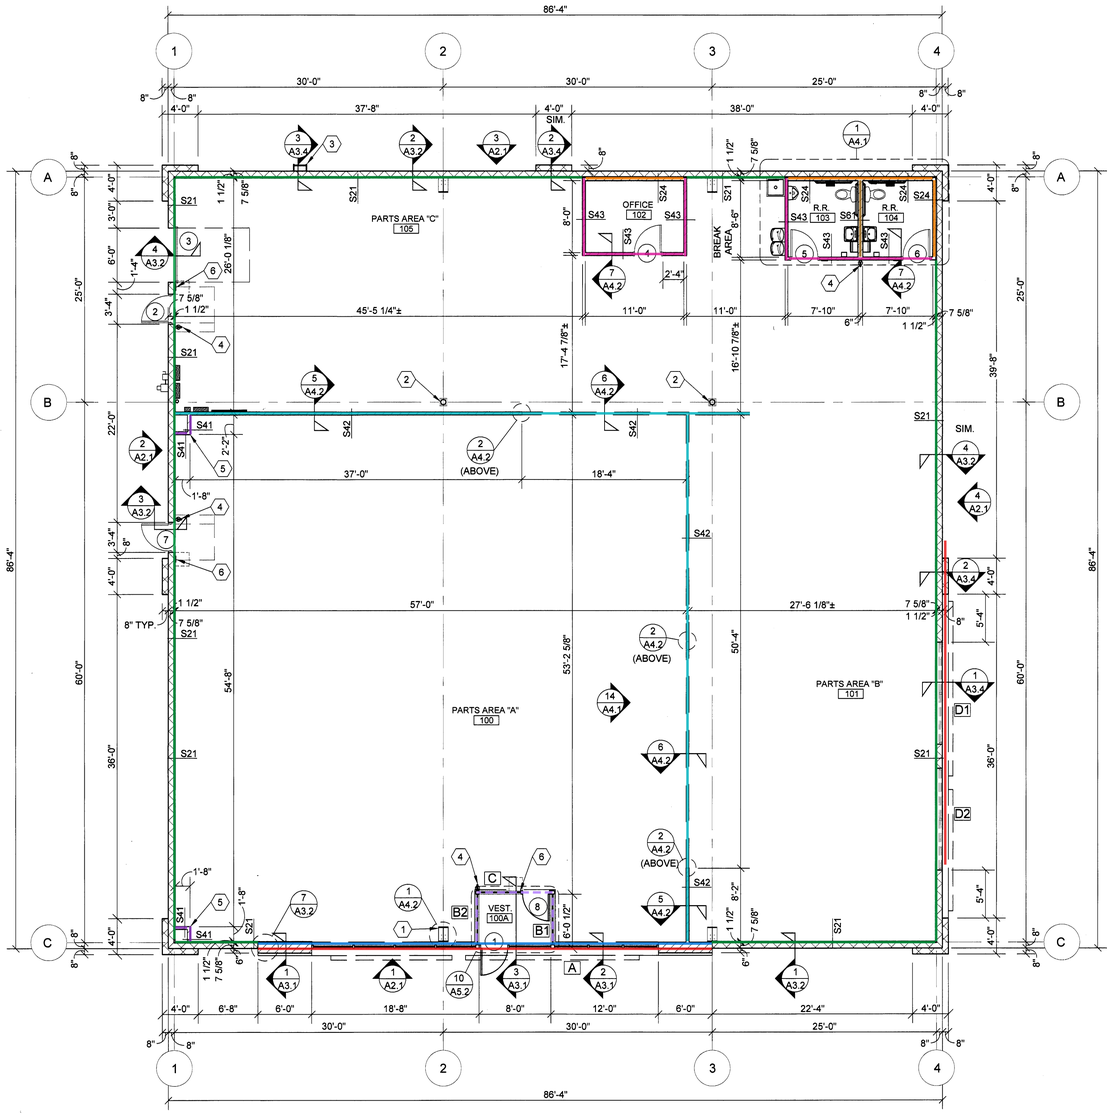


1 FLOOR PLAN
A1.1 SCALE: 1/8" = 1'-0"

N

GENERAL NOTES

A. REFER TO PROJECT MANUAL FOR ADDITIONAL REQUIREMENTS.

B. ALL DIMENSIONS TO ROUGH FACE OF ROUGH FRAMING, CONCRETE, MASONRY OR CENTERLINE OF STRUCTURE, UNLESS OTHERWISE NOTED. COLD FORM METAL STUD INTERIOR PARTITION DIMENSIONS 3-5/8" UNLESS OTHERWISE INDICATED AND NOT SHOWN FOR CLARITY.

C. REFER TO EXTERIOR AND INTERIOR FINISH SCHEDULES FOR ADDITIONAL REQUIREMENTS.

D. REFER TO PRE-ENGINEERED METAL BUILDING SHOP DRAWINGS FOR ADDITIONAL REQUIREMENTS. NOTIFY ARCHITECT IF FINAL DESIGN CONDITIONS DEVIATE SUBSTANTIALLY FROM THOSE INDICATED HEREIN.

KEY NOTES

1. CONCEALED STEEL COLUMN. REFER TO PRE-ENGINEERED METAL BUILDING SHOP DRAWINGS. PROVIDE SHEET METAL COVER WITH NO EXPOSED HORIZONTAL SEAMS. FINISH TO MATCH WINDOW FRAMING.
2. EXPOSED STEEL COLUMN, REFER TO PRE-ENGINEERED METAL BUILDING SHOP DRAWINGS, (PAINT W-3, REFER INTERIOR FINISH SCHEDULE).
3. ROOF ACCESS LADDER. REFER TO EXTERIOR FINISH SCHEDULE.
4. SURFACE MOUNTED PORTABLE FIRE EXTINGUISHER, REFER TO DETAIL 10/A4.2.
5. SHOWROOM CORNER WALL BOX OUT. INSTALL 5/8" FIRE TREATED PLYWOOD BACKING TO BACK SIDE OF STUD INTERIOR FLANGE ON EACH EXPOSED WALL FACE FROM 8'-0" TO 10'-0" A.F.F. FOR INSTALLATION OF SECURITY MIRRORS. REFER TO 4/A4.2 (TYPICAL).
6. TACTILE EXIT SIGN AT EXIT DISCHARGE DOOR STATING "EXIT" WITH BRAILLE (GRADE 2 CONTRACTED) LETTERING. SIGN CONSTRUCTION AND LOCATION TO COMPLY WITH ANSI A117.1. MOUNT 48" MINIMUM ABOVE FINISH FLOOR TO BOTTOM OF LOWEST TACTILE CHARACTER AND 60" MAXIMUM ABOVE FINISH FLOOR TO BOTTOM OF HIGHEST TACTILE CHARACTER.

INTERIOR WALL & CEILING NOTES

1. GENERAL:
A. REFER TO FINISH SCHEDULES FOR ADDITIONAL WALL FINISH MATERIAL APPLICATIONS.

B. REFER TO WALL SECTIONS AND DETAILS FOR ADDITIONAL CONDITIONS.

2. FRAMING:
A. PROVIDE FIRE TREATED 2X BLOCKING AS REQUIRED FOR INSTALLATION OF ACCESSORIES PER MANUFACTURER'S RECOMMENDATIONS.

B. PROVIDE DIAGONAL WALL BRACING (3" X 16 GA. FLAT STRIP) AT CORNER FACES OF FREE STANDING PARTITION SYSTEMS.

C. WHERE WALL FRAMING EXTENDS TO BOTTOM OF ROOF DECK OR STRUCTURE, PROVIDE DEFLECTION CHANNELS AT TOP TRACK FOR 1 1/2" MINIMUM DEFLECTION.

D. REFER TO STRUCTURAL DRAWINGS FOR STRUCTURAL STUD REQUIREMENTS.

E. REFER TO WINDOW AND DOOR HEAD, JAMB AND SILL DETAILS FOR ADDITIONAL FRAMING REQUIREMENTS.

F. PROVIDE HORIZONTAL STUD BRIDGING AT 4'-0" O.C. VERTICAL.

3. GYPSUM AND BACKING BOARD:
A. EXPANSION/CONTROL JOINTS: INSTALL EXPANSION/CONTROL JOINTS IN CEILINGS EXCEEDING 2500 SQ. FT. IN AREA AND IN PARTITION WALL LENGTHS EXCEEDING 30 FEET. LOCATE JOINTS AT LOCATIONS OF MASONRY CONTROL JOINTS SHOWN ON EXTERIOR ELEVATIONS. DO NOT EXCEED A DISTANCE OF 50 FEET IN ANY DIRECTION BETWEEN CEILING JOINTS. INSTALL CONTROL JOINTS WHERE FRAMING OR FURRING CHANGES DIRECTION.

B. PROVIDE MOISTURE RESISTANT TYPE "X" GYPSUM BOARD AT ALL WET LOCATIONS (RESTROOMS, WET WALLS, AND JANITOR'S SINK AREAS).


C. PROVIDE "J" MOLDING, REGLETS, OR CORNER BEAD AT GYPSUM BOARD PERIMETER CONDITIONS TRANSITIONING TO DISSIMILAR EXPOSED FINISH MATERIALS.

4. INSULATION:
A. INSULATION SHALL HAVE A FLAME SPREAD RATING OF 0-25 AND A SMOKE DEVELOPMENT RATING OF 0- 450.

B. PROVIDE SEALANT ON BOTH SIDES OF STUD BOTTOM TRACKS AT ACOUSTICAL INSULATED WALL LOCATIONS.

INTERIOR WALL TYPES

(SCALE 1 1/2" = 1'-0")

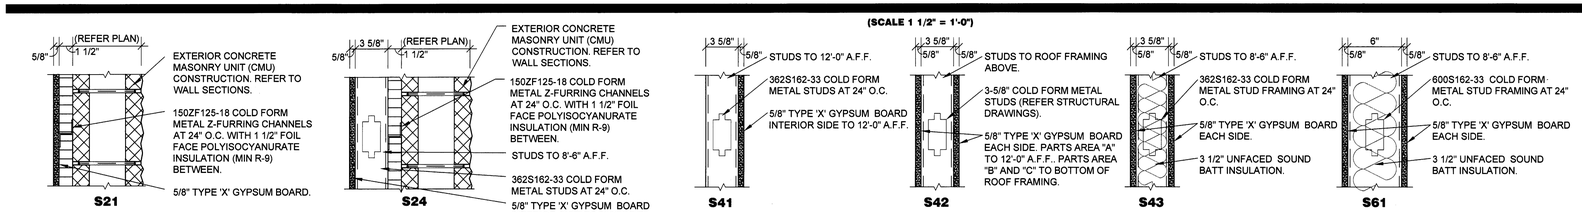

TIMOTHY M. GUILLOT
ARCHITECT
1736 East Sunshine, Suite 417
Springfield, Missouri 65804
417.862.9558
Fax: 417.862.3265
e-mail: architect@estesflyschneider.com

STATE OF COLORADO — REGISTERED ARCHITECT — Timothy Michael Guillot — 40872 — LICENSED — 4-18-25

PROJECT:
NEW O'REILLY AUTO PARTS STORE
23RD AVE.
EVANS, CO #1

FLOOR PLAN

O'Reilly AUTO PARTS
CORPORATE OFFICES
233 SOUTH PATTERSON
SPRINGFIELD, MISSOURI 65802
(417) 862-2674 TELEPHONE

COMM #	4838
DATE:	7-19-24
REVISION DATE:	4-18-25

A1.1

TAKE-OFF MARKUPS - LEGEND

Source: the take-off Excel (Partition Takeoff) · one PDF annotation (Line / PolyLine) per wall on the plan sheet where it was measured · Subject = type · Contents = TYPE · LF · H · SF · DETAIL · id

Sample	Type	Walls	LF	Marked	No geometry	Walls without geometry (not marked): 0
	EXT-6CFMF	4	86.67	4	0	
	EXT-8CFMF	3	50.67	3	0	
	S21	6	250.71	6	0	
	S24	3	35.67	3	0	
	S41	4	6.46	4	0	
	S42	4	122.61	4	0	
	S43	5	53.58	5	0	
	S61	1	8.50	1	0	
	OTHER FRAMING	3	20.57	3	0	
	TOTAL	**33**	**635.43**	**33**	**0**	