PROJECT TEAM

OWNER
WHITE DEVELOPMENT, LLC
PO BOX 178
DENVER COLORADO 80201
VOICE: 303.506.5995
CONTACT: DEVIN VISCIANO

ARCHITECT
MERIDIAN 105 ARCHITECTURE
6030 EAST SMITH
DENVER COLORADO 80216
VOICE: 303.550.2231
CONTACT: CHAD MITCHELL

INTERIORS
HELTSHE DESIGN
6030 EAST SMITH
DENVER COLORADO 80216
VOICE: 720.235.7372
CONTACT: BRIAN HELTSHE

STRUCTURAL
DISALVO ENGINEERING GROUP
405 S. WILCOX, SUITE 210
CASTLE ROCK COLORADO 80104
VOICE: 720.667.3388 X231
CONTACT: STEPHEN LEHIGH, P.E.

MEP
RAMIREZ, JOHNSON, AND ASSOCIATES
3301 LAWRENCE ST, SUITE 2
DENVER COLORADO 80205
VOICE: 720.598.0774
CONTACT: CHRIS WOOD; THERESA GRAY

CIVIL
PERSONALIZED ENGINEERING SOLUTIONS
9249 S. BROADWAY #200-388
HIGHLANDS RANCH, COLORADO 80129
VOICE: 720.388.8126
CONTACT: STEPHEN DOUGLAS, P.E.

SURVEY
R&R ENGINEERS-SURVEYORS, INC
1635 W. 13TH AVENUE, SUITE 310
DENVER, COLORADO 80204
VOICE: 303.753.673

GEOTECH
KUMAR & ASSOCIATES, INC
2390 SOUTH LIPAN STREET
DENVER COLORADO 80223
VOICE: 303.742.9700
CONTACT: KAMAL HASAN

415 PERRY STREET
ISSUED FOR PERMIT
1 **04.22.2026**

CITY HOTEL

HELTSHE

M1A | MERIDIAN 105 ARCHITECTURE

CITY HOTEL
415 PERRY STREET, CASTLE ROCK, CO.

DATE: 4.22.2026
PROJ. NO. 2023.002
ISSUED FOR: PERMIT
SHEET TITLE: COVER

Digitally signed by Chad Mitchell
Date: 2026.04.23 09:46:30 -06'00'

SHEET NUMBER T0.00

C:\Users\daniel\Documents\City Hotel-2024_1_dlipscomb74CJ8.rvt
4/22/2026 1:04:57 PM

ABBREVIATIONS

#	POUND(S) or NUMBER	CDOT	COLORADO DEPARTMENT OF TRANSPORTATION	DWG	DRAWING	FOM	FACE OF MASONRY	ID	INSIDE DIAMETER	MIRR	MIRROR	PROJ	PROJECT	SD	SOAP DISPENSER	TPTN	TOILET PARTITION
(E)	EXISTING	CEM	CEMENTITIOUS	DWR	DRAWER	FOS	FACE OF STUD	IN	INCH(ES)	MISC	MISCELLANEOUS	PSF	POUNDS PER SQUARE FOOT	SEC	SECTION	TS	TUBE STEEL
(N)	NEW	CFL	COUNTERFLASHING	E	EAST	FR	FIRE RESISTIVE or FIRE RATED	INCAND	INCANDESCENT	MM	MILLIMETERS	PSI	POUNDS PER SQUARE INCH	SF	SQUARE FEET	TV	TELEVISION
(R)	REMOVE	CG	CORNER GUARD	EA	EACH	FRP	FIBERGLASS REINFORCED PANEL(ING)	INCL	INCLUD(ED)	MO	MASONRY OPENING	PT	POST TENSIONED or PORCELAIN TILE	SHT	SHEET	TYP	TYPICAL
@	AT	CIP	CAST IN PLACE	EB	EXPANSION BOLT	FRT	FIRE RETARDANT TREATED	INFO	INFORMATION	MTD	MOUNT(ED)	PT	POINT OF TANGENCY	SHTG	SHEATHING	UL	UNDERWRITER'S LABORATORY
A/V	AUDIO/VISUAL	CIRC	CIRCUMFERENCE	ED	EXHAUST DUCT	FST	FIRE SEPARATION DISTANCE	INSUL	INSULATION or INSULATED	MTL	METAL	PTD	PAPER TOWEL DISPENSER	SHWR	SHOWER	UNFIN	UNFINISHED
AB	ANCHOR BOLT	CJ	CONTROL JOINT	EF	EXHAUST FAN or EACH FACE	FT	FOOT (FEET)	INT	INTERIOR	MUL	MULLION	PTDR	PAPER TOWEL DISPENSER & RECEPTACLE	SIM	SIMILAR	UON	UNLESS OTHERWISE NOTED
ABV	ABOVE	CK	CORK TILE	EJ	EXPANSION JOINT	FTG	FOOTING	INTMED	INTERMEDIATE	N	NORTH	PTN	PARTITION	SNC	SANITARY NAPKIN CABINET	UOS	UNLESS OTHERWISE SPECIFIED
ACOUS	ACOUSTICAL	CL	COLUMN LINE	EL	ELEVATION	FURN	FURNISH(ED)	INV	INVERT	NIC	NOT IN CONTRACT	PTR	PAPER TOWEL RECEPTACLE	SND	SANITARY NAPKIN DISPENSER	USGS	U.S. GEOLOGICAL SURVEY
ACT	ACOUSTICAL CEILING TILE	CLG	CEILING	ELEC	ELECTRICAL	FURR	FURRED or FURRING	JC	JANITOR CLOSET	NO	NUMBER	PVC	POLYVINYL CHLORIDE	SNR	SANITARY NAPKIN RECEPTACLE	V	VOLT
AD	AREA DRAIN or ACCESS DOOR	CLOS	CLOSET	ELEV	ELEVATOR	FUT	FUTURE	JST	JOIST	NOM	NOMINAL	PVMT	PAVEMENT	SOFF	SOFFIT	VAR	VARY or VARIES
ADD	ADDENDUM	CLR	CLEAR	EMER	EMERGENCY	FVC	FIRE VALVE CABINET	JT	JOINT	NRC	NOISE REDUCTION COEFFICIENT	QTY	QUANTITY	SPECS	SPECIFICATION(S)	VB	VAPOR BARRIER
ADJ	ADJACENT or ADJUSTABLE	CM	CENTIMETERS	ENGR	ENGINEER	GA	GAUGE	KD	KNOCKDOWN	NTS	NOT TO SCALE	R	RISER	SPR	SPRINKLER	VCT	VINYL COMPOSITION TILE
AFF	ABOVE FINISHED FLOOR	CMU	CONCRETE MASONRY UNIT	EOS	EDGE OF SLAB	GALV	GALVANIZED	KIT	KITCHEN	OA	OVERALL	RAD	RADIUS	SPKR	SPEAKER	VENT	VENTILATION
AGG	AGGREGATE	CO	CHANGE ORDER or CLEANOUT	EQ	EQUAL	GB	GRAB BAR	KO	KNOCKOUT	OC	ON CENTER	RB	RUBBER BASE	SPRT	SUPPORT	VER	VERIFY
AHU	AIR HANDLING UNIT	COL	COLUMN	EQUIP	EQUIPMENT	GC	GENERAL CONTRACTOR	KP	KICK PLATE	OD	OUTSIDE DIAMETER	RBC	RUBBER BASE COVE	SQ	SQUARE	VERT	VERTICAL
ALT	ALTERNATE	CONC	CONCRETE	ES	EACH SIDE	GCMU	GLAZED CONCRETE MASONRY UNIT(S)	LAB	LABORATORY	OF	OUTSIDE FACE	RBS	RUBBER BASE STRAIGHT	SR	SINK RECEPTACLE	VEST	VESTIBULE
ALUM	ALUMINUM	CONF	CONFERENCE	EST	ESTIMATE	GI	GALVANIZED IRON	LAM	LAMINATE	OFF	OFFICE	RBT	RUBBER TILE	SS	STAINLESS STEEL	VIF	VERIFY IN FIELD
ANOD	ANODIZED	CONN	CONNECTION	EW	EACH WAY	GL	GLASS or GLAZING	LAV	LAVATORY	OH	OPPOSITE HAND	RD	ROOF DRAIN or ROAD	SSK	SERVICE SINK	VIN	VINYL or SHEET VINYL
APPROX	APPROXIMATE	CONSTR	CONSTRUCTION	EWC	ELECTRIC WATER COOLER	GND	GROUND	LBL	LABEL	OPNG	OPENING	RE	REFER TO or REFERENCE	STA	STATION	VOL	VOLUME
ARCH	ARCHITECTURAL	CONT	CONTINUOUS	EWH	ELECTRIC WATER HEATER	GR	GRADE	LDR	LEADER	OPP	OPPOSITE	RECC	RECESS(ED)	STD	STANDARD	VTR	VENT THROUGH ROOF
ASI	ARCHITECT'S SUPPLEMENTAL INSTRUCTIONS	CONTR	CONTRACTOR	EXT	EXTERIOR	GRT	GROUT	LH	LEFT HAND	OTO	OUTSIDE-TO-OUTSIDE	RECPT	RECEPTACLE	STL	STEEL	VWC	VINYL WALL COVERING
ASPH	ASPHALT	CORR	CORRIDOR or CORRUGATED	F	FARENHEIT	GT	GLASS TILE	LKR	LOCKER	P	PAINT(ED)	REF	REFRIGERATOR or REFRIGERATED	STOR	STORAGE	W	WEST or WIDE
AUTO	AUTOMATIC	CPT	CARPET	FA	FIRE ALARM	GWB	GYPSUM WALLBOARD	LLH	LONG LEG HORIZONTAL	P/L	PROPERTY LINE	REINF	REINFORCED	STRUCT	STRUCTURE or STRUCTURAL	W.O.	WHERE OCCURS
AVG	AVERAGE	CT	CERAMIC TILE	FAC	FIRE ALARM CABINET	GYP	GYPSUM	LLV	LONG LEG VERTICAL	PAC	PREVIOUSLY AWARDED CONTRACT	REQD	REQUIRED	SUSP	SUSPENDED)	W/	WITH
AWP	ACOUSTICAL WALL PANEL	CTR	COUNTER	FACP	FIRE ALARM CONTROL PANEL	GYP. BD.	GYPSUM BOARD	LP	LIGHTING PANEL or LIGHT PROOF	PAR	PARALLEL	RESIL	RESILIENT	SYM	SYMMETRICAL	W/C	WATER CLOSET
B	BASE	CU	CUBIC	FBO	FURNISHED BY OTHER(S)	HAS	HEADED ANCHOR STUD	LT	LIGHT	PBO	PROVIDED BY OTHERS	REV	REVISE, REVISED or REVISION(S)	SYS	SYSTEM	W/O	WITHOUT
B.O.	BY OWNER	CY	CUBIC YARD	FD	FLOOR DRAIN or FIRE DAMPER	HB	HOSE BIB	LTL	LINTEL	PC	PRECAST	RF	RESILIENT FLOORING	T	TREAD	W/R	WATER RESISTANT
B.O.F.	BY OWNER, FUTURE	DAMP	DAMPROOFING	FDN	FOUNDATION	HC	HOLLOW CORE or HANDICAPPED	LVR	LOUVER	PERF	PERFORATED	RFG	ROOFING	T&B	TOP AND BOTTOM	WC	WALL COVERING
BD	BOARD	DBL	DOUBLE	FE	FIRE EXTINGUISHER	HDAS	HEADED DEFORMED ANCHOR STUD	MACH	MACHINERY	PERIM	PERIMETER	RFL	REFLECTED	T&G	TONGUE AND GROOVE	WD	WOOD
BIT	BITUMINOUS	DEG	DEGREE	FEC	FIRE EXTINGUISHER CABINET	HDR	HEADER	MAG	MAGNETIC	PKG	PARKING	RH	RIGHT HAND	TB	TOWEL BAR	WDO	WINDOW
BLDG	BUILDING	DEMO	DEMOLISH or DEMOLITION	FF	FINISHED FLOOR	HDWR	HARDWARE	MAS	MASONRY	PL	PLATE	RL	RAIN LEADER	TBC	TOP OF BACK OF CURB	WF.	WIDE FLANGE or WOOD FLOORING
BLKG	BLOCKING	DEPT	DEPARTMENT	FFL	FINISHED FLOOR LINE	HM	HOLLOW METAL	MATL	MATERIAL	PLAM	PLASTIC LAMINATE	RM	ROOM	TELE	TELEPHONE	WGL	WIRE GLASS
BM	BEAM or BENCH MARK	DF	DRINKING FOUNTAIN	FH	FIRE HYDRANT	HORIZ	HORIZONTAL	MAX	MAXIMUM	PLAS	PLASTER	RO	ROUGH OPENING	TEMP	TEMPORARY or TEMPERATURE	WP	WATERPROOF(ING)
BOT	BOTTOM	DIA	DIAMETER	FHMS	FLAT HEAD MACHINE SCREW	HR	HOUR	MB	MOISTURE BARRIER	PLBG	PLUMBING	ROD	ROOF OVERFLOW DRAIN	TG	TEMPERED GLASS	WPT	WORKING POINT
BRG	BEARNING	DIAG	DIAGONAL	FHV	FIRE HOSE VALVE	HT	HEIGHT	MECH	MECHANICAL	PLYWD	PLYWOOD	ROW	RIGHT OF WAY	THERM	THERMOSTAT	WSCT	WAINSCOT
BSMT	BASEMENT	DIM	DIMENSION	FHWS	FLAT HEAD WOOD SCREW	HTR	HEATER	MED	MEDIUM	PNL	PANEL	RPM	REVOLUTIONS PER MINUTE	THK	THICK or THICKNESS	WT	WEIGHT
C	CAULKING	DISP	DISPENSER	FIN	FINISH(ED)	HVAC	HEATING, VENTILATION and AIR CONDITIONING	MEMB	MEMBRANE	POL	POLISHED	RVS	REVERSE (SIDE)	THLD	THRESHOLD	WWF	WELDED WIRE FABRIC
C.L.	CENTERLINE	DIV	DIVISION	FIXT	FIXTURE	HW	HOT WATER	MEP	MECHANICAL, ELECTRICAL & PLUMBING	PR	PAIR or PROPOSAL REQUEST	RWC	RAIN WATER CONDUCTOR	TO	TOP OF		
CAB	CABINET	DN	DOWN	FLR	FLOOR(ING)	HWH	HOT WATER HEATER	MEZZ	MEZZANINE	PREFAB	PREFABRICATED	S	SOUTH or SEALED	TOC	TOP OF CONCRETE		
CATV	CABLE TELEVISION	DR	DOOR	FLUOR	FLUORESCENT	HWY	HIGHWAY	MFR	MANUFACTURER	PREFIN	PREFINISHED	SC	SOLID CORE	TOS	TOP OF STEEL		
CCD	CONSTRUCTION CHANGE DIRECTIVE	DS	DOWNSPOUT	FOC	FACE OF CONCRETE	IBC	INTERNATIONAL BUILDING CODE or INSTALLED BY CONTRACTOR	MH	MANHOLE	PRESTR	PRESTRESSED	SCD	SEAT COVER DISPENSER	TOW	TOP OF WALL		
CCTV	CLOSED CIRCUIT TELEVISION	DTL	DETAIL	FOF	FACE OF FINISH			MIN	MINIMUM	PRIM	PRIMARY	SCHED	SCHEDULE	TPD	TOILET PAPER DISPENSER		

GRAPHIC STANDARDS

EXTERIOR ELEVATION IDENTIFICATION

X
A4.1

INTERIOR ELEVATION IDENTIFICATION

X — DRAWING NUMBER
A6.X — SHEET NUMBER

DETAIL IDENTIFICATION

X — DRAWING NUMBER
A9.X — SHEET NUMBER

WALL SECTION IDENTIFICATION

2 — DRAWING NUMBER
A4.01 — SHEET NUMBER

BUILDING SECTION IDENTIFICATION

X — DRAWING NUMBER
A5.1 — SHEET NUMBER

ENLARGED DETAIL IDENTIFICATION

AREA OF DRAWING TO BE ENLARGED

X — DRAWING NUMBER
A9.X — SHEET NUMBER

STRUCTURAL GRID

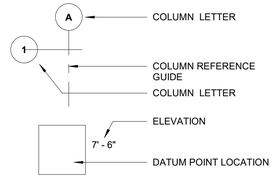

DOOR IDENTIFICATION

ROOM/SPACE/AREA IDENTIFICATION

ROOM NAME — ROOM NAME
314 — ROOM NUMBER
876 SF — ROOM AREA

PARTITION TYPE IDENTIFICATION

W.6 | 1 — PARTITION TYPE; RE: PARTITION TYPE SCHEDULE

ACOUSTICAL PARTITION TYPE IDENTIFICATION

W.6 | 1 — PARTITION TYPE; RE: PARTITION TYPE SCHEDULE

SECTION MATERIAL GRAPHICS

- CONCRETE
- UNDISTURBED OR COMPACTED EARTH
- POROUS FILL (GRAVEL)
- STEEL
- ALUMINUM
- MASONRY - BRICK
- MASONRY - CONCRETE BLOCK
- RIDGID INSULATION
- BATT INSULATION
- GYPSUM PLASTER
- PLYWOOD
- FINISH WOOD

1

DESIGN DEVELOPMENT 12.20.2024
ISSUED FOR PERMIT 4.25.2025
PERMIT RESUBMITTAL #1 ARCH / STRUCTURAL 04.22.2026
ISSUED FOR BID X.XX.XX
ISSUED FOR CONST. X.XX.XX

SHEET #	SHEET DESCRIPTION			
00 - COVER				
T0.00	COVER	X	X	X
T0.01	INDEX AND STANDARDS	X	X	X
01 - CIVIL				
C0.00	DEMOLITION PLAN	X		
C0.01	SITE PLAN	X		
C0.02	UTILITY PLAN	X		
C0.03	GRADING PLAN	X		
C0.04	DETAILED GRADING PLAN	X		
02 - ARCHITECTURE				
A0.00	CODE SUMMARY	X	X	X
A0.01	CODE PLANS	X	X	X
A0.02	CODE PLANS	X	X	X
A0.03	CODE SECTIONS AND COURTYARD ELEVATIONS	X	X	X
A0.03 B	CODE ELEVATIONS, PRIMARY NORTH, SOUTH, EAST, WEST			X
A0.04	ENERGY CODE COMPLIANCE	X	X	X
A0.05	ACCESSIBILITY STANDARDS	X	X	X
A0.06	INTERIOR WALL ASSEMBLIES	X	X	X
A0.07	EXTERIOR WALL ASSEMBLIES	X	X	X
A0.08	HORIZONTAL ASSEMBLIES	X	X	X
A0.09	FIRE RATED INTERSECTIONS	X	X	X
A0.10	ASSEMBLY INTERSECTIONS		X	X
A0.11	FIRE RATED INTERSECTIONS	X	X	X
A1.01	ENLARGED SITE PLANS		X	X
A2.01	LVL 1	X	X	X
A2.02	LVL 2	X	X	X
A2.03	LVL 3	X	X	X
A2.04	LVL 4	X	X	X
A2.05	ROOF PLAN	X	X	X
A3.01	OVERALL RCP - LVL 1		X	X
A3.02	OVERALL RCP - LVL 2	X	X	X
A3.03	OVERALL RCP - LVL 3	X	X	X
A3.04	OVERALL RCP - LVL 4	X	X	X
A4.00	ELEVATIONS	X	X	X
A4.01	ELEVATIONS	X	X	X
A4.02	ELEVATIONS	X	X	X
A4.03	BUILDING SECTIONS	X	X	X
A4.04	BUILDING SECTIONS	X	X	X
A4.05	BUILDING SECTIONS		X	X
A5.00	ENLARGED WALL SECTIONS & ELEVATIONS	X	X	X
A5.01	ENLARGED WALL SECTIONS & ELEVATIONS	X	X	X
A5.02	ENLARGED WALL SECTIONS & ELEVATIONS	X	X	X
A5.03	ENLARGED WALL SECTIONS & ELEVATIONS	X	X	X
A5.04	ENLARGED WALL SECTIONS & ELEVATIONS	X	X	X
A5.05	ENLARGED WALL SECTIONS & ELEVATIONS	X	X	X
A5.06	ENLARGED WALL SECTIONS & ELEVATIONS	X	X	X
A5.07	ENLARGED WALL SECTIONS		X	X
A5.08	ENLARGED WALL SECTIONS		X	X
A6.00	ELEVATOR PLANS & SECTIONS	X	X	X
A6.01	LOBBY STAIR PLANS & SECTIONS	X	X	X
A6.02	SOUTHEAST STAIR PLANS & SECTIONS	X	X	X
A7.00	ENLARGED PLAN & RCP - UNIT TYPE 1, 2, 3	X	X	X
A7.01	ENLARGED PLAN, UNIT TYPE 1 ROOM ELEVATIONS	X	X	X
A7.02	ENLARGED PLAN, UNIT TYPE 1, BATH DESIGN	X	X	X
A7.03	ENLARGED PLAN, UNIT TYPE 2, ROOM ELEVATIONS	X	X	X
A7.04	ENLARGED PLAN, UNIT TYPE 3, ROOM ELEVATIONS	X	X	X
A7.05	ENLARGED PLAN & RCP - UNIT TYPE 4, 5, 6	X	X	X
A7.06	ENLARGED PLAN, UNIT TYPE 4, ROOM ELEVATIONS	X	X	X
A7.07	ENLARGED PLAN, UNIT TYPE 5, UNIT ELEVATIONS	X	X	X
A7.08	ENLARGED PLAN, UNIT TYPE 6, ROOM ELEVATIONS	X	X	X
A7.09	ENLARGED PLAN & RCP - UNIT TYPE 7, 8, 9	X	X	X
A7.10	ENLARGED PLAN, UNIT TYPE 7, ROOM ELEVATIONS	X	X	X
A7.11	ENLARGED PLAN, UNIT TYPE 8, ROOM ELEVATIONS	X	X	X
A7.12	ENLARGED PLAN, UNIT TYPE 9, ROOM ELEVATIONS	X	X	X
A7.13	ENLARGED PLAN & RCP - UNIT TYPE 10, 11	X	X	X
A7.14	ENARGED PLAN, UNIT TYPE 10, ROOM ELEVATIONS	X	X	X
A7.15	ENLARGED PLAN, UNIT TYPE 11, ROOM ELEVATIONS		X	X

DESIGN DEVELOPMENT 12.20.2024
ISSUED FOR PERMIT 4.25.2025
PERMIT RESUBMITTAL #1 ARCH / STRUCTURAL 04.22.2026
ISSUED FOR BID X.XX.XX
ISSUED FOR CONST. X.XX.XX

SHEET #	SHEET DESCRIPTION			
A7.16	ENLARGED PLAN & RCP - UNIT TYPE 12,13	X	X	X
A7.17	ENLARGED PLAN, UNIT TYPE 12, ROOM ELEVATIONS		X	X
A7.18	ENLARGED PLAN, UNIT TYPE 13, ROOM ELEVATIONS		X	X
A7.19	INTERIOR FINISH SCHEDULES		X	X
A7.20	CORRIDOR ELEVATIONS	X	X	X
A7.21	CORRIDOR ELEVATIONS		X	X
A7.22	CORRIDOR ELEVATIONS		X	X
A7.23	CORRIDOR REFLECTED CEILING PLANS, AND DETAILS		X	X
A7.24	CORRIDOR REFLECTED CEILING PLANS, AND DETAILS		X	X
A7.30	LOBBY - ENLARGED PLANS		X	X
A7.31	LOBBY - ENLARGED REFLECTED CEILING PLAN		X	X
A7.32	LOBBY - VESTIBULE ELEVATIONS AND DETAILS		X	X
A7.33	LOBBY - PARTITION ELEVATIONS AND DETAILS		X	X
A7.34	ENLARGED LOBBY FINISH PLAN		X	X
A7.35	LOBBY INTERIOR ELEVATIONS		X	X
A7.45	KITCHEN, UTILITY, TRASH AREAS - ENLARGED PLANS AND RCPS		X	X
A7.50	LEVEL 4 RESTROOM, LEVEL 1 STAFF AREAS, PLANS AND RCPS		X	X
A7.55	LEVEL 4 FOOD AND BEVERAGE SPACES - ENLARGED PLAN AND RCP		X	X
A8.00	DOOR SCHEDULES	X	X	X
A8.01	WINDOW SCHEDULE	X	X	X
A8.02	FENESTRATION DETAILS		X	X
A9.01	FOUNDATION DETAILS		X	X
A9.02	WALL DETAILS		X	X
A9.03	WALL DETAILS	X	X	X
A9.04	ROOF DETAILS - ROOFS		X	X
A9.05	ROOF DETAILS	X	X	X
A9.06	ROOF DETAILS		X	X
04 - STRUCTURAL				
S0.00	GENERAL NOTES AND SPECIFICATIONS	X	X	X
S0.01	GENERAL NOTES AND MATERIAL SPECIFICATIONS		X	X
S1.01	FOUNDATION AND FIRST FLOOR SLAB-ON-GRADE PLAN	X	X	X
S1.02	LEVEL 2 FRAMING PLAN	X	X	X
S1.03	LEVEL 3 FRAMING PLAN	X		X
S1.04	LEVEL 4 FRAMING PLAN	X	X	X
S1.05	ROOF FRAMING PLAN	X		X
S2.01	FOUNDATION SCHEDULES AND TYPICAL DETAILS	X	X	X
S2.02	FOUNDATION SCHEDULES AND TYPICAL DETAILS	X	X	X
S2.03	FOUNDATION SECTIONS	X	X	X
S2.04	FOUNDATION SECTIONS		X	X
S2.05	FOUNDATION SECTIONS		X	X
S3.02	FRAMING SECTIONS		X	X
S3.03	FRAMING SECTIONS	X	X	X
S3.04	FRAMING SECTIONS	X	X	X
S3.05	FRAMING SECTIONS	X	X	X
S3.06	FRAMING SECTIONS		X	X
S3.07	FRAMING SECTIONS		X	X
S3.08	FRAMING SECTIONS		X	X
S3.09	FRAMING SECTIONS		X	X
S3.10	FRAMING SECTIONS		X	X
S3.11	STEEL COLUMN SCHEDULE	X	X	X
S4.01	MASONRY SCHEDULE AND TYPICAL DETAILS	X	X	X
S4.02	MASONRY TYPICAL DETAILS	X	X	X
S5.01	TYPICAL WOOD FRAMING DETAILS	X	X	X
S5.02	TYPICAL WOOD FRAMING DETAILS	X	X	X
05 - MECHANICAL				
M0.00	MECHANICAL LEGEND	X	X	
M0.01	MECHANICAL COMCHECK	X	X	
M0.02	MECHANICAL COMCHECK	X	X	
M0.03	MECHANICAL DETAILS		X	
M0.04	MECHANICAL DETAILS		X	
M0.05	MECHANICAL DETAILS		X	

DESIGN DEVELOPMENT 12.20.2024
ISSUED FOR PERMIT 4.25.2025
PERMIT RESUBMITTAL #1 ARCH / STRUCTURAL 04.22.2026
ISSUED FOR BID X.XX.XX
ISSUED FOR CONST. X.XX.XX

SHEET #	SHEET DESCRIPTION			
M0.06	MECHANICAL SCHEDULES		X	
M0.07	MECHANICAL SCHEDULES		X	
M0.08	MECHANICAL SCHEDULES		X	
M1.01	MECHANICAL PLAN - LEVEL 1	X	X	
M1.02	MECHANICAL PLAN - LEVEL 2	X	X	
M1.03	MECHANICAL PLAN - LEVEL 3	X	X	
M1.04	MECHANICAL PLAN - LEVEL 4	X	X	
M1.05	MECHANICAL PLAN - ROOF	X	X	
M2.01	MECHANICAL PIPING PLAN - LEVEL 1	X	X	
M2.02	MECHANICAL PIPING PLAN - LEVEL 2	X	X	
M2.03	MECHANICAL PIPING PLAN - LEVEL 3	X	X	
M2.04	MECHANICAL PIPING PLAN - LEVEL 4	X	X	
M3.00	MECHANICAL UNIT PLANS	X	X	
M3.01	MECHANICAL UNIT PLANS		X	
M3.02	ENLARGED MECHANICAL PLANS		X	
06 - PLUMBING				
P0.00	PLUMBING LEGEND AND DETAILS	X	X	
P0.01	PLUMBING DETAILS AND DIAGRAMS	X	X	
P0.02	PLUMBING SCHEDULES AND DIAGRAMS	X	X	
P1.00	UNDERGROUND SANITAR WASTE PLANS	X	X	
P1.01	SANITARY WASTE AND VENT PLAN - LEVEL 1	X	X	
P1.02	SANITARY WASTE AND VENTY PLAN - LEVEL 2	X	X	
P1.03	SANITARY WASTE AND VENT PLAN - LEVEL 3	X	X	
P1.04	SANITARY WASTE AND VENT PLAN - LEVEL 4	X	X	
P1.05	SANITARY WASTE AND VENT PLAN - ROOF	X	X	
P2.01	WATER AND GAS PLAN - LEVEL 1	X	X	
P2.02	WATER AND GAS PLAN - LEVEL 2	X	X	
P2.03	WATER AND GAS PLAN - LEVEL 3	X	X	
P2.04	WATER AND GAS PLAN - LEVEL 4	X	X	
P3.00	SANITARY WASTET AND VENT UNIT PLANS	X	X	
P3.01	SANITARY WASTE AND VENT UNIT PLANS		X	
P4.00	DOMESTIC WATER UNIT PLANS	X	X	
P4.01	DOMESTIC WATER UNIT PLANS		X	
P5.00	SANITARY WASTE AND VENT SCHEDULE		X	
07 - ELECTRICAL				
E0.00	ELECTRICAL LEGEND	X	X	
E0.01	ELECTRICAL ONE-LINE DIAGRAMS	X	X	
E0.02	ELECTRICAL PANEL SCHEDULES	X	X	
E0.03	ELECTRICAL PANEL SCHEDULES		X	
E0.04	ELECTRICAL PANEL SCHEDULES	X	X	
E0.05	ELECTRICAL PANEL SCHEDULES	X	X	
E0.06	ELECTRICAL PANEL SCHEDULES	X	X	
E0.07	ELECTRICAL SCHEDULES	X	X	
E0.08	ELECTRICAL COMCHECK		X	
E0.09	ELECTRICAL COMCHECK		X	
E0.10	Unnamed			
E1.01	ELECTRICAL POWER PLAN - LEVEL 1	X	X	
E1.02	ELECTRICAL POWER PLAN - LEVEL 2	X	X	
E1.03	ELECTRICAL POWER PLAN - LEVEL 3	X	X	
E1.04	ELECTRICAL POWER PLAN - LEVEL 4	X	X	
E1.05	ELECTRICAL POWER PLAN - ROOF LEVEL	X	X	
E2.01	ELECTRICAL LIGHTING PLAN - LEVEL 1	X	X	
E2.02	ELECTRICAL LIGHTING PLAN - LEVEL 2	X	X	
E2.03	ELECTRICAL LIGHTING PLAN - LEVEL 3	X	X	
E2.04	ELECTRICAL LIGHTING PLAN - LEVEL 4	X	X	
E3.00	ELECTRICAL ENLARGED UNIT PLANS	X	X	
E3.01	ELECTRICAL ENLARGED UNIT PLANS	X	X	

DESIGN DEVELOPMENT 12.20.2024
ISSUED FOR PERMIT 4.25.2025
PERMIT RESUBMITTAL #1 ARCH / STRUCTURAL 04.22.2026
ISSUED FOR BID X.XX.XX
ISSUED FOR CONST. X.XX.XX

SHEET # SHEET DESCRIPTION

HELTSHE

M1A MERIDIAN 105 ARCHITECTURE

CITY HOTEL
415 PERRY STREET, CASTLE ROCK, CO.

DATE: 4.22.2026
PROJ. NO. 2023.002

ISSUED FOR: PERMIT

SHEET TITLE: INDEX AND STANDARDS

SHEET NUMBER T0.01

C:\Users\daniel\Documents\City Hotel-2024_1_dlhjxscmb74CJ8.rvt

4/22/2026 1:05:01 PM

BUILDING CODE SUMMARY

AUTHORITY HAVING JURISDICTION:
TOWN OF CASTLE ROCK
TOWN OF CASTLE ROCK BUILDING CODES:
2018 INTERNATIONAL BUILDING CODE
2018 INTERNATIONAL FIRE CODE
2018 INTERNATIONAL MECHANICAL CODE
2018 INTERNATIONAL PLUMBING CODE
2018 INTERNATIONAL FUEL GAS CODE
2018 ENERGY CONSERVATION CODE
2023 NATIONAL ELECTRIC CODE
ASME A17.1 2019 ELEVATOR CODE
A117.1-2009 - ACCESSIBLE AND USABLE BUILDING AND FACILITIES

LOCAL AMENDMENTS:
TITLE 15 OF LOCAL MUNICIPAL CODE

PROJECT DESCRIPTION/SCOPE OF WORK
THE PROJECT INCLUDES CONSTRUCTION OF A NEW 4-STORY HOTEL THAT SITS ADJACENT, AND ABUTS AN EXISTING HISTORIC STRUCTURE. THE NEW HOTEL WILL BE SEPARATED FROM THE EXISTING HISTORIC BUILDING BY A 3 HOUR FIRE WALL. THE PROJECT WILL BE TYPE IIIB CONSTRUCTION. THE ADJACENT, EXISTING HISTORIC BUILDING IS TYPE VB. THE EXISTING HISTORIC BUILDING IS BEING PERMITTED SEPARATELY.

THE NEW STRUCTURE INCLUDES PARKING AT GRADE ALONG THE REAR ALLEY, A RETAIL SPACE, A DINING ESTABLISHMENT AND BAR ON THE TOP FLOOR, AND A HOTEL LOBBY WITH A BAR AND SERVICE KITCHEN ON LEVEL 1. THE BAR, DINING, AND KITCHEN AREAS ARE BEING PERMITTED AS CORE AND SHELL SPACES FOR PURPOSES OF THIS PERMIT. THE LAYOUT AND DESIGN OF THOSE SPACES WILL BE SUBMITTED UNDER A SEPARATE PERMIT.

PROJECT WILL BE FULLY SPRINKLERED. THE PROJECT IS A MULTI-STORY MIXED OCCUPANCY BUILDING THAT IS PERMITTED WITH SEPARATED OCCUPANCIES PER IBC SECTION 508.4. A PORTION LEVEL 1 IS PERMITTED AS NON-SEPARATED OCCUPANCIES.

DEFERRED SUBMITTALS:
FIRE SPRINKLER DESIGN
FIRE ALARM
PREFABRICATED STEEL STAIRS
PREFAB FLOOR & ROOF TRUSSES
TENANT INTERIOR FOR KITCHEN/FOOD SERVICE
TENANT INTERIOR FOR LEVEL 4 FOOD AND BEVERAGE SPACES

1. USE AND OCCUPANCY CLASSIFICATION:

PRIMARY OCCUPANCIES (IBC 302):
R-1 HOTEL
M - MERCANTILE
U - PRIVATE GARAGE
A-2 - ASSEMBLY

INCIDENTIAL USE AREAS (TABLE 509):
TRASH ROOMS GREATER THAN 100 SQ FT
ELECTRICAL ROOMS

ACCESSORY AREAS:
KITCHEN < 10% (IBC 508.2)
LEVEL 4 FOOD AND BEVERAGE (303.1.2)

2. ALLOWABLE HEIGHT & AREA:

ALLOWABLE BUILDING AREA PER STORY:
TYPE IIIB CONSTRUCTION - SPRINKLERED, MULTISTORY

	U	A-2	M	R-1
FULLY SPRINKLERED	YES	YES	YES	YES
FRONTAGE INCREASE	NO	NO	NO	NO
TABLE 506.2	25,500 SF	28,500 SF	37,500 SF	48,000 SF

PROPOSED BUILDING AREAS:

	U	A-2	R-1	M	TOTAL GROSS	ACCESSORY <10%	
LEVEL 1	1,788 SF	2,178 SF	3,858 SF	2,376 SF	10,200 SF	857 SF	(KITCHEN)
LEVEL 2	0 SF	0 SF	8,587 SF	0 SF	8,587 SF	152 SF	(CLEANING/LINEN)
LEVEL 3	0 SF	0 SF	8,587 SF	0 SF	8,587 SF	152 SF	(CLEANING/LINEN)
LEVEL 4	0 SF	0 SF	8,302 SF	0 SF	8,302 SF	526 SF	(BATHROOM/ CLEANING ELECTRIC)
					TOTAL 35,676		

NOTE: THE BUILDING IS COMPLIANT WITH IBC SECTION 508.4 FOR SEPARATED OCCUPANCIES. FOR LEVEL 1, THE RETAIL SPACE (M), HOTEL SPACES (R-1), AND HOTEL LOBBY (A-2) ARE BEING PERMITTED AS NON-SEPARATED.

IBC SECTION 506.2.4 MIXED OCCUPANCY, MULTISTORY BUILDINGS - EQUATION 5-3

FIRST STORY:
GROUP A-2 OCCUPANCY = 2,178 SF
GROUP M OCCUPANCY = 2,376 SF
GROUP R-1 OCCUPANCY = 3,858 SF
GROUP U OCCUPANCY = 1,788 SF
RATIO = (8,412/28,500) + (1,788/25,500)
.29 + .07 = .36
(.36 < 1 THEREFORE COMPLIES)

NONSEPARATED OCCUPANCIES. FOR THIS PORTION OF THE BUILDING, THE MOST RESTRICTIVE OCCUPANCY IS A-2, THEREFORE EQUATION 5-3 EMPLOYS THE AREA LIMITS OF THAT OCCUPANCY.

SECOND STORY:
GROUP R-1 OCCUPANCY = 8,587 SF
RATIO = 8,587/48,000 = .178

THIRD STORY:
GROUP R-1 OCCUPANCY = 8,587 SF
RATIO = 8,587/48,000 = .178

FOURTH STORY:
GROUP R-1 OCCUPANCY - 8,302 SF
RATIO = 8,302/48,000 = .172

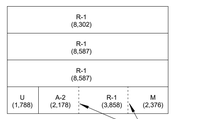

NOTE: PER IBC 506.2.4 THE SUM OF THE RATIOS OF SHALL BE LESS THAN 4. THE SUM OF THE RATIOS OF EACH FLOOR EQUALS .88, THEREFORE THE BUILDING IS COMPLIANT WITH IBC 506.2.4 FOR MIXED OCCUPANCY, MULTISTORY BUILDINGS
.36 + .178 + .178 + .172 = .88
.88 < 4

ALLOWABLE BUILDING HEIGHT:
TYPE IIIB CONSTRUCTION

	U	A-2	R-1	M
FULLY SPRINKLERED	YES	YES	YES	YES
STORIES (504.4)	3	3	5	3
FEET (TABLE 504.3)	75'	75'	75'	75'

PROPOSED BUILDING HEIGHT: 4-STORIES, LESS THAN 75'- 0"

3. TYPE OF CONSTRUCTION/ FIRE-RESISTIVE REQUIREMENTS:

PER TABLE 601	TYPE IIIB
PRIMARY STRUCTURAL FRAME	0 HR
BEARING WALLS EXTERIOR	2 HR
BEARING WALLS INTERIOR	0 HR
NONBEARING EXTERIOR WALLS	TABLE 705.5
NONBEARING INTERIOR WALL	0 HR
FLOOR CONSTRUCTION	0 HR
ROOF CONSTRUCTION	0 HR

SEPARATED OCCUPANCIES TABLE 508.4

	A	R	U	M
A	-	1 HR	0 HR	1 HR
R		-	1 HR	1 HR
U			-	1 HR
M				-

CONSTRUCTION CLASSIFICATION PER SECTION 602:
TYPE III: EXTERIOR WALLS ARE OF NONCOMBUSTIBLE MATERIALS AND THE INTERIOR BUILDING ELEMENTS ARE OF ANY MATERIAL PERMITTED BY THIS CODE.

SUPPORTING CONSTRUCTION PER IBC 704.1:
- PER 704.1 STRUCTURAL MEMBERS TO HAVE THE SAME FIRE RESISTANCE RATING, OR MORE, THAN THE ASSEMBLY BEING SUPPORTED, WITH EXCEPTIONS NOTED IN 707.5, 708.4, 709.4, 711.2.
  1. PER 711.2.3, EXCEPTION 2, SUPPORTING CONSTRUCTION OF HORIZONTAL ASSEMBLIES DOES NOT REQUIRE FRR FOR THIS PROJECT.
  2. PER 707.5.1, EXCEPTION 2, SUPPORTING CONSTRUCTION OF FIRE BARRIERS OF INDICENTAL USE AREAS NOTED IN TABLE 509 IS DOES NOT REQUIRE FRR FOR THIS PROJECT.
  3. PER 708.4.1, EXCEPTION, SUPPORTING CONSTRUCTION OF FIRE PARTITIONS SEPARATING SLEEPING UNITS AND SERVING AS CORRIDOR WALLS IS NOT REQUIRED TO BE FRR FOR THIS PROJECT.
  4. PER 709.4.2, SUPPORTING CONSTRUCTION OF ELEVATOR LOBBY SMOKE BARRIERS NEED NOT BE FRR FOR THIS PROJECT.

EXTERIOR STRUCTURAL MEMBERS PER IBC 704.10:
1. LOAD BEARING STRUCTURAL MEMBERS LOCATED WITHIN EXTERIOR WALLS OR ON THE OUTSIDE OF THE BUILDING SHALL BE RATED 2-HR PER TABLE 601 BASED ON IIIB CONSTRUCTION.

PROPOSED FIRE PROTECTION OF STRUCTURAL STEEL:

STRUCTURAL STEEL MEMBERS SHALL BE INDIVIDUALLY ENCASED WITH SFRM OR INTUMESCENT PAINT IN THE FOLLOWING LOCATIONS:

- STRUCTURAL STEEL MEMBERS THAT ARE LOCATED WITHIN EXTERIOR WALLS
- STRUCTURAL STEEL MEMBERS SUPPORTING VERTICAL SHAFTS
- SUPPORTING CONSTRUCTION OF RATED ASSEMBLIES
- EXTERIOR STRUCTURAL MEMBERS

704.3, EXCEPTION - INDIVIDUAL ENCASEMENT OF MEMBERS OTHER THAN COLUMNS SHALL BE PERMITTED ON ALL EXPOSED SIDES PROVIDED THAT THE EXTENT OF PROTECTION IS IN ACCORDANCE WITH THE REQUIRED FIRE-RESISTANCE RATING, AS DETERMINED IN SECTION 703.

REFER TO A0.01 FOR PROPOSED LOCATIONS

EXTERIOR WALL REQUIREMENTS BASED ON FIRE SEPARATION DISTANCE:

PER TABLE 602	TYPE	A, R, U	M
LESS THAN 5'	ALL	1 HR	2 HR
BETWEEN 5' AND 10'	IIIB	1 HR	1 HR
BETWEEN 10' AND 30'	IIIB	1 HR	1 HR
GREATER THAN 30'	IIIB	0 HR	0 HR

PROPOSED FIRE SEPARATION DISTANCE:

	PRIMARY NORTH (PROPERTY LINE)	PRIMARY SOUTH (PROPERTY LINE)	PRIMARY WEST (CENTERLINE OF ALLEY)	PRIMARY EAST (CENTERLINE OF PERRY)	COURTYARD (RE: PLAN)
LEVEL 1	0'	0'	11'- 4 3/4" (RE: PLAN) 21'- 8 1/2" (RE: PLAN)	> 30'	VARIES RE: CODE PLAN
LEVEL 2	5'- 0 1/2" (RE: PLAN) 10'- 9 1/2" (RE: PLAN)	0'	11'- 2 1/2"	> 30'	VARIES RE: CODE PLAN
LEVEL 3	5'- 0 1/2"	0'	11'- 2 1/2"	> 30'	VARIES RE: CODE PLAN
LEVEL 4	5'- 4 1/2"	0'	11'- 6 1/2"	> 30'	VARIES RE: CODE PLAN

ALLOWABLE AREA OF OPENINGS PER TABLE 705.8, FOR UNPROTECTED, SPRINKLERED BUILDING

FSD	ALLOWABLE AREA	APPLICABLE LOCATION
0' TO 3'	NOT PERMITTED	NORTH AND SOUTH BUILDING FACADES
3' TO 5'	15%	NA
5' TO 10'	25%	NORTH BUILDING FACADES, LEVELS 2 AND HIGHER; PORTION OF INTERIOR NORTH-FACING COURTYARD FACADE ON LEVEL 1 WHICH IS ACROSS FROM EXISTING BUILDING
10' TO 15'	45%	WEST BUILDING FACES; PORTION OF INTERIOR NORTH-FACING COURTYARD FACADES LEVEL 2-5 WHICH ARE ACROSS FROM EXISTING BUILDING
15' TO 20'	75%	N/A
GREATER THAN 20'	UNLIMITED	ALL EAST-FACING FACADES

PARAPETS:

EAST FACADES - NOT REQUIRED, PER 705.11, EXCEPTION 6
WEST FACADES - NOT REQUIRED, PER 705.11, EXCEPTION 6
NORTH FACADE, LEVEL 1 - PROVIDED
NORTH FACADE, UPPER ROOF - NOT REQUIRED, PER 705.11, EXCEPTION 6
SOUTH FACADES - PROVIDED

COMPONENT:	RATING:	CODE SECTION:
FIRE WALLS	3 HR	IBC 706
FIRE BARRIERS	2 HR	IBC 713.4
SHAFTS - 4 STORIES OR MORE	2 HR	IBC 713.4
SHAFTS - 3 STORIES OR LESS	1HR (NOT USED)	IBC 713.4
SHAFTS - SPECIAL PROVISIONS	IBC 510.2-3 (NOT USED) 2 HR ABOVE PODIUM WHEN 2 HR BELOW PODIUM OR 1 HR ABOVE PODIUM WHEN 3 HR BELOW PODIUM (NOT USED)	
ELEVATOR CONTROL ROOM	2 HR - PER 3005.4, EXCEPTION 1	
TRASH ROOM	1 HR - PER TABLE 509	
ELECTRICAL AND IT ROOMS	2 HR	
FIRE PARTITIONS		
ENCLOSED ELEVATOR LOBBY	1 HR	IBC 708.1 (NOT USED)
CORRIDOR WALLS	1/2 HR	IBC 708.3, TABLE 1020.2, & 711.2.3
SLEEPING ROOM SEPARATION	1/2 HR	IBC 708.3
SLEEPING ROOM SEPARATION FROM OTHER OCCUPANCIES	1 HR	IBC 420.2 & 708.1
HORIZONTAL ASSEMBLIES		
DWELLING & SLEEPING UNITS	1/2 HR	IBC 711.2.4.3, EXCEPTION
PARKING BENEATH GROUP R	3 HR	IBC 510.2 (NOT USED)
ROOF	0 HR	IBC TABLE 601
FLOORS	0 HR	IBC TABLE 601
INCIDENTAL USE AREAS		
ROOMS WITH BOILERS WHERE THE LARGEST PIECE OF EQUIPMENT IS OVER 15 PSI AND 10 HORSEPOWER	1 HR	TABLE 509
WASTE AND LINEN COLLECTION ROOMS OVER 100 SQ FT	1 HR	TABLE 509
SMOKE BARRIER		
ENCLOSED ELEVATOR LOBBY	1 HR	3007.6; 3007.6.2

NOTE: CORRIDOR AND UNIT DEMISING WALLS CONSTRUCTED AS 1HR FIRE PARTITIONS, EXCEEDING 1/2 CODE REQUIREMENT

4. FIRE PROTECTION SYSTEMS:

1. **AUTOMATIC SPRINKLER SYSTEM** REQUIRED BY OCCUPANCY (SECTION 903.2): YES
2. **AUTOMATIC SPRINKLER SYSTEM** REQUIRED BASED ON SPECIAL CONDITION (SECTION 903.2): YES
3. **AUTOMATIC SPRINKLER SYSTEM** INSTALLATION REQUIREMENT: NFPA 13 IN ACCORDANCE WITH IBC 903.3.1.1
   a. AUTOMATIC SPRINKLER SYSTEM SHALL BE INSTALLED AT BALCONIES AND DECKS AS REQUIRED BY IBC 903.3.1.2.1.
   b. QUICK RESPONSE SPRINKLERS SHALL BE INSTALLED IN ACCORDANCE WITH IBC 903.3.2, WHICH INCLUDES GROUP R DWELLING UNITS AND LIGHT HAZARD OCCUPANCIES AS DEFINED BY NFPA 13.
4. **STANDPIPES** AS REQUIRED BY IBC SECTION 905. PER THIS SECTION, STANDPIPES ARE REQUIRED WHEN HIGHEST FLOOR LEVEL IS MORE THAN 30' ABOVE FIRE DEPARTMENT VEHICLE ACCESS. UPPER LEVEL IS GREATER THAN 30' ABOVE THE LOWEST GRADE IN EACH ADJACENT STREET.
5. **PORTABLE FIRE EXTINGUISHERS** SHALL BE PROVIDED AND INSTALLED IN ACCORDANCE WITH IBC SECTION 906.
6. **FIRE ALARM AND DETECTION SYSTEMS** SHALL BE PROVIDED. (IBC SECTION 907)

NOTE: ALL GUEST AREAS, INCLUDING LOBBY, CORRIDORS, HOTEL ROOMS, BAR, AND OTHER SUCH SPACES ACCESSIBLE TO GUESTS SHALL BE OUTFITTE WITH CONCEALED POP-OUT STYLE SPRINKLER HEADS.

5. EXIT REQUIREMENTS:

	U	A	R	M
MAXIMUM EXIT ACCESS TRAVEL DISTANCE PER TABLE 1017.2 (SPRINKLERED)	400'	250'	250'	250'
MAXIMUM COMMON PATH OF EGRESS TRAVEL PER TABLE 1006.2.1 (SPRINKLERED):	75'	75'	75'	75'

CODE NOTES:
1. TABLE 1020.2 GOVERNS THE WIDTH OF CORRIDORS THROUGHOUT THIS BUILDING DESIGN, AS THE OCCUPANT LOAD AS CALCULATED BY SECTION 1005.3.2 DOES NOT NECESSITATE AN EGRESS WIDTH EXCEEDING THE VALUES AS DETERMINED
2. PER 1009.3.2 EXCEPTION 2 - CLEAR WIDTH OF 48" BETWEEN RAILS IS NOT REQUIRED.
3. PER 1009.3.3 EXCEPTION 2 - AREAS OF REFUGE ARE NOT REQUIRED AT STAIRWAYS.

EXIT ACCESS CONFIGURATION PER 1007.1.1, EXCEPTION #2
WHERE A BUILDING IS EQUIPPED THROUGHOUT WITH AN AUTOMATIC SPRINKLER SYSTEM IN ACCORDANCE WITH SECTION 903.3.1.1 OR 903.3.1.2, THE SEPARATION DISTANCE SHALL BE NOT LESS THAN ONE-THRID OF THE LENGTH OF THE MAXIMUM OVERALL DIAGONAL DIMENSION OF THE AREA SERVED.

DEAD ENDS:
PER SECTION 1020.5, EXCEPTION 2 - DEAD END CORRIDORS SHALL NOT EXCEED 50' IN LENGTH. REFER TO PLAN FOR MEASUREMENT.

LEVEL 1 SUMMARY:
- AREA: 10,200 SQ FEET GROSS
- NUMBER OF OCCUPANTS: 153
- NUMBER OF EXITS REQUIRED/PROVIDED: REFER TO PLAN

LEVEL 2 SUMMARY:
- AREA: 8,587 SQ FEET GROSS FLOOR AREA
- NUMBER OF OCCUPANS: 43
- NUMBER OF EXITS REQUIRED/PROVIDED: 2

LEVEL 3 SUMMARY:
- AREA: 8,587 SQ FEET GROSS FLOOR AREA
- NUMBER OF OCCUPANTS: 43
- NUMBER OF EXITS REQUIRED/PROVIDED: 2

LEVEL 4 SUMMARY:
- AREA: 8,302 SQ FEET GROSS FLOOR AREA
- NUMBER OF OCCUPANTS: 130
- NUMBER OF EXITS REQUIRED/PROVIDED: 2

6. ACCESSIBILITY:

PER TABLE 1107.6.1.1
THERE SHALL BE 2 ACCESSIBLE UNITS. THE ACCESSIBLE UNITS DO NOT REQUIRE ROLL-IN SHOWERS.

PER TABLE 1106.1
THERE ARE 45 TOTAL PARKING SPACES BEING PROVIDED, INCLUDING 6 ONSITE AND 39 OFFSITE. THE ACCESSIBLE PARKING REQUIREMENT IS BASED ON 45 SPACES PROVIDED, THEREFORE PER TABLE 1106.1, 2 ACCESSIBLE PARKING SPACES SHALL BE PROVIDED.

PER 1106.5, ONE SPACE SHALL BE A VAN ACCESSIBLE PARKING SPACE.

7. INTERIOR ENVIRONMENT:

VENTILATION
PROVIDED BY MECHANICAL MEANS

NATURAL LIGHT
REQUIREMENT: THE MINIMUM NET GLAZED AREA SHALL NOT BE LESS THAN 8% OF THE FLOOR AREA OF THE ROOM SERVED.
PROVIDED: GLAZED WINDOWS ARE PROPOSED IN EACH UNIT.

COURTS
PER IBC 1205.3, COURTS SHALL NOT BE LESS THAN 3 FEET IN WIDTH. COURTS HAVING WINDOWS OPENING ON OPPOSITE SIDES SHALL BE NOT LESS THAN 6 FEET IN WIDTH. COURTS SHALL NOT BE LESS THAN 10 FEET IN LENGTH UNLESS BOUNDED ON ONE END BY A PUBLIC WAY YARD. FOR BUILDINGS MORE THAN TWO STORIES ABOVE GRADE PLANE, THE COURT SHALL BE INCREASED 1 FOOT IN WIDTH AND 2 FEET IN LENGTH FOR EACH ADDITIONAL STORY.

THE PROJECT INCLUDES A COURT AT GRADE THAT IS COMPLIANT WITH THESE REQUIREMENTS.

ROOF ACCESS

PER 1011.12, EXCEPTION, BUILDINGS WITHOUT AN OCCUPIED ROOF ACCESS TO THE ROOF FROM THE TOP STORY SHALL BE PERMITTED TO BE BY AN ALTERNATING TREAD DEVICE, A SHIP'S LADDER OR A PERMANENT LADDER. ONE STAIRWAY SHALL EXTEND TO THE ROOF.

8. ELEVATORS:

	REQUIRED	PROVIDED
HOISTWAY PROTECTION	YES, PER 3006.2.1	• WHERE CORRIDORS ARE REQUIRED TO BE FIRE-RESISTANCE RATED IN ACCORDANCE WITH SECTION 1020.1, ELEVATOR HOISTWAY OPENINGS SHALL BE PROTECTED IN ACCORDANCE WITH SECTION 3006.3.
FIRE SERVICE ACCESS ELEVATOR	NO, PER 403.6.1	• FIRE SERVICE ACCESS ELEVATOR NOT REQUIRED. • FIRE SERVICE ACCESS ELEVATOR LOBBY IS NOT REQUIRED.
STRETCHER REQUIREMENT	YES, PER 3002.4	#2500 IBC COMPLIANT

NOTE: AUTOMATIC SMOKE CURTAINS ARE PROVIDED ON BOTH ELEVATORS AT FLOOR LEVELS 2, 3, & 4.

9. PLUMBING SYSTEMS:

LEVEL 1 PLUMBING FACILITIES:

LOBBY FACILITIES SERVE OCCUPANTS FROM THE HISTORIC STRUCTURE, WHICH WILL BE USED AS DINING AND BE PART OF A SEPARATE PERMIT. APPROXIMATE OCCUPANT LOAD: 80 OCC

THE LEVEL 1 OCCUPANT LOAD FOR PURPOSES OF CALCULATING PLUMBING FACILITIES SHALL EXCLUDE THE CORE AND SHELL RETAIL SPACE WHICH IS ASSUMED TO HAVE ITS OWN FACILITIES PROVIDED BY FUTURE TENANT.

TOTAL OCC: 191

OCCUPANTS BY USE:
ASSEMBLY, RESTAURANT: 172
BUSINESS AREAS: 19

ASSEMBLY, RESTAURANT (86 MALE; 86 FEMALE)
WATER CLOSETS AT 1 PER 75: 75/86 = 1.15 WC MALE & 1.15 WC FEMALE

BUSINESS (10 MALE; 10 FEMALE)
WATER CLOSETS AT 1 PER 25: 25/10 = .4 WC MALE & .4 WC FEMALE

TOTAL WATER CLOSETS REQUIRED ON LEVEL 1:
2 MALE
2 FEMALE

TOTAL PROVIDED:
5 TOTAL, ALL UNISEX (2 ADA TOILET ROOMS)

LEVEL 4 PLUMBING FACILITIES:

THE LEVEL 1 OCCUPANT LOAD FOR PURPOSES OF CALCULATING PLUMBING FACILITIES SHALL EXCLUDE THE CORE AND SHELL FOOD AND BEVERAGE SPACES, BUT EXCLUDE THE HOTEL ROOMS.

TOTAL OCC: 98

OCCUPANTS BY USE:
ASSEMBLY, RESTAURANT: 98

ASSEMBLY, RESTAURANT (49 MALE; 49 FEMALE)
WATER CLOSETS AT 1 PER 75: 75/86 = .57 WC MALE & .57 WC FEMALE

TOTAL WATER CLOSETS REQUIRED ON LEVEL 4:
1 MALE
1 FEMALE

TOTAL PROVIDED:
4 TOTAL
MENS: 1 WC, 1 URINAL (1 ADA TOILET)
WOMENS: 2 WC (1 ADA TOILET)

C:\Users\daniel\Documents\City Hotel-2024_1_dlipscomb74CJ8.rvt
4/22/2026 1:05:04 PM

HELTSHE
M1A MERIDIAN 105 ARCHITECTURE

CITY HOTEL
415 PERRY STREET, CASTLE ROCK, CO.

DATE: 4.22.2026
PROJ. NO. 2023.002
ISSUED FOR: PERMIT
SHEET TITLE: CODE SUMMARY

SHEET NUMBER
A0.00

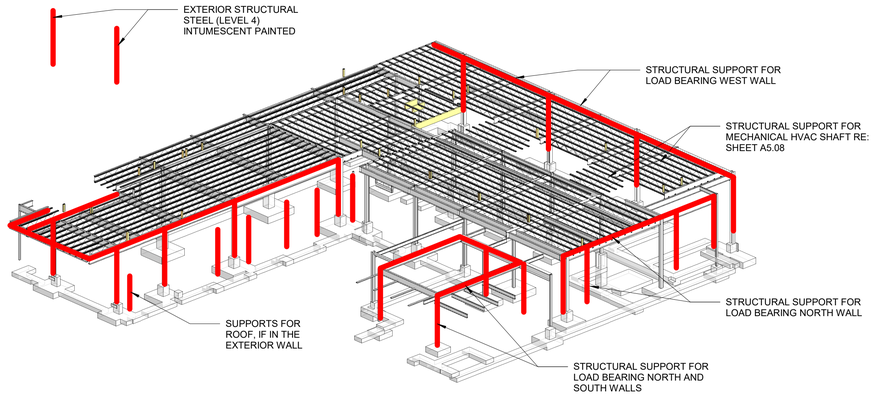

1 STRUCTURAL FIREPROOFING DIAGRAM

CODE LEGEND

- 1 HR RATED FIRE BARRIER
- 1 HR RATED FIRE PARTITION
- 2 HR RATED FIRE BARRIER
- 2 HR RATED SHAFT ENCLOSURE (CONSTRUCTED AS A FIRE BARRIER)
- 2 HR RATED EXTERIOR WALL
- 1/2 HR FIRE PARTITION
- 1 HR RATED EXTERIOR WALL
- 3 HR RATED BEARING WALL
- 1/2 HR HORIZONTAL ASSEMBLY
- 2 HR RATED HORIZONTAL ASSEMBLY
- 1 HR RATED HORIZONTAL ASSEMBLY
- 3 HR RATED HORIZONTAL ASSEMBLY
- LONGEST TRAVEL DISTANCE AND/OR COMMON PATH OF TRAVEL, AS NOTED
- ACCESSIBLE ROUTE
- EGRESS EXIT
- EGRESS PATH
- EXT - FIRE EXTINGUISHER

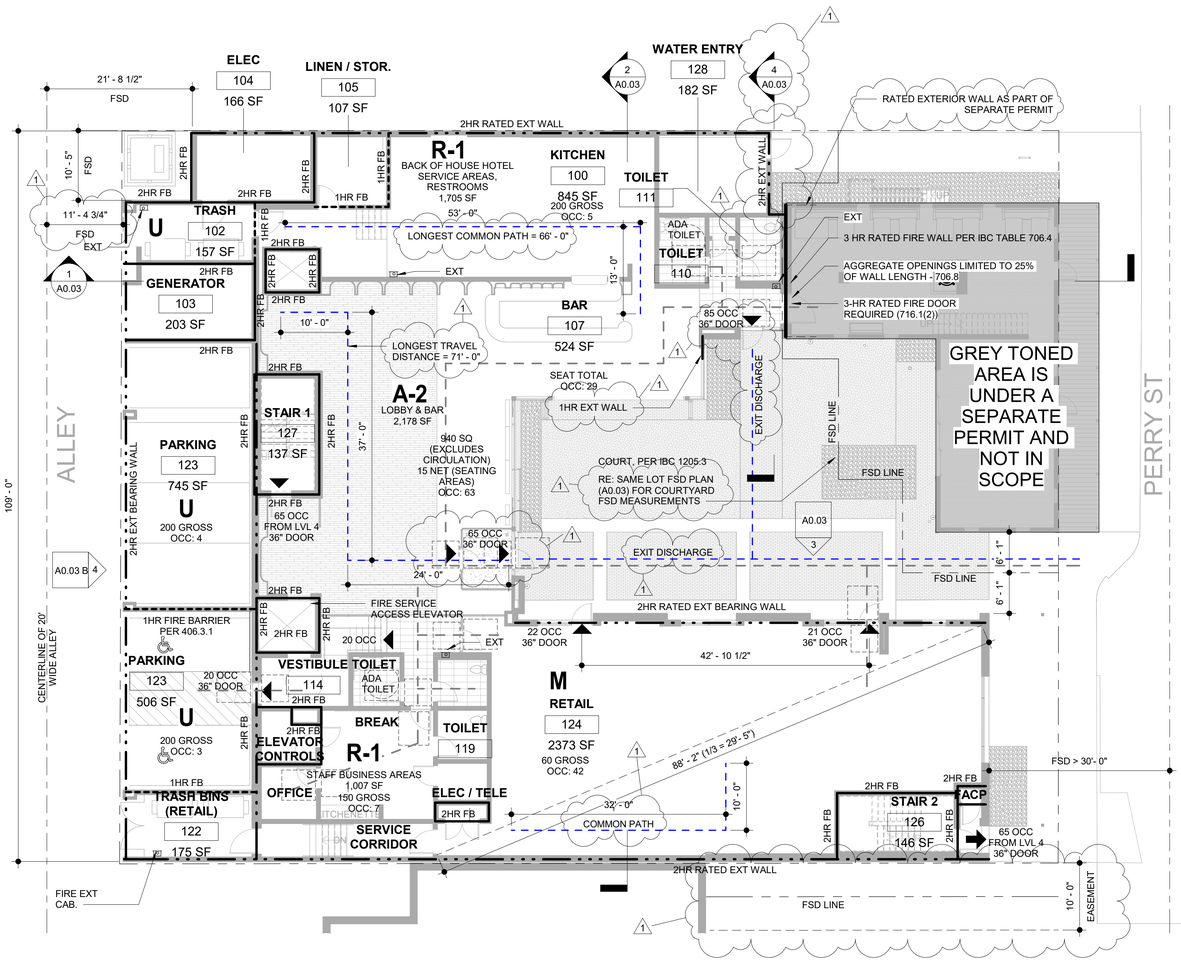

2 LEVEL 1 CODE PLAN
3/32" = 1'-0"

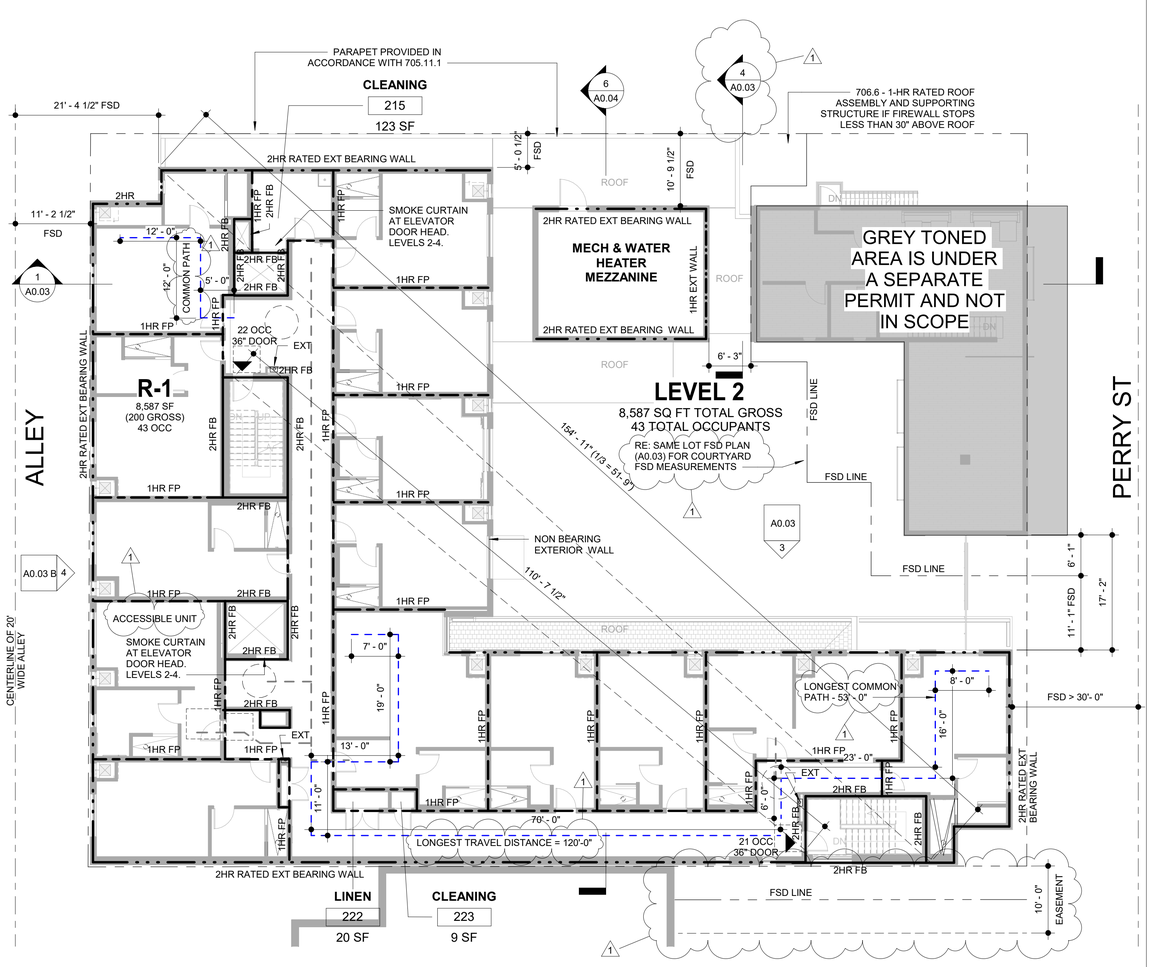

3 LEVEL 2 CODE PLAN
3/32" = 1'-0"

C:\Users\daniel\Documents\City Hotel-2024_1_dlipscomb74CJ8.rvt

4/22/2026 1:05:13 PM

HELTSHE

M1A | MERIDIAN 105 ARCHITECTURE

CITY HOTEL

415 PERRY STREET, CASTLE ROCK, CO.

DATE: 4.22.2026	ISSUED FOR: PERMIT	SHEET TITLE: CODE PLANS
PROJ. NO. 2023.002		

SHEET NUMBER
A0.01

CODE LEGEND

- 1 HR RATED FIRE BARRIER
- 1 HR RATED FIRE PARTITION
- 2 HR RATED FIRE BARRIER
- 2 HR RATED SHAFT ENCLOSURE (CONSTRUCTED AS A FIRE BARRIER)
- 2 HR RATED EXTERIOR WALL
- 1/2 HR FIRE PARTITION
- 1 HR RATED EXTERIOR WALL
- 3 HR RATED BEARING WALL
- 1/2 HR HORIZONTAL ASSEMBLY
- 2 HR RATED HORIZONTAL ASSEMBLY
- 1 HR RATED HORIZONTAL ASSEMBLY
- 3 HR RATED HORIZONTAL ASSEMBLY
- LONGEST TRAVEL DISTANCE AND/OR COMMON PATH OF TRAVEL, AS NOTED
- ACCESSIBLE ROUTE
- EGRESS EXIT
- EGRESS PATH
- EXT - FIRE EXTINGUISHER

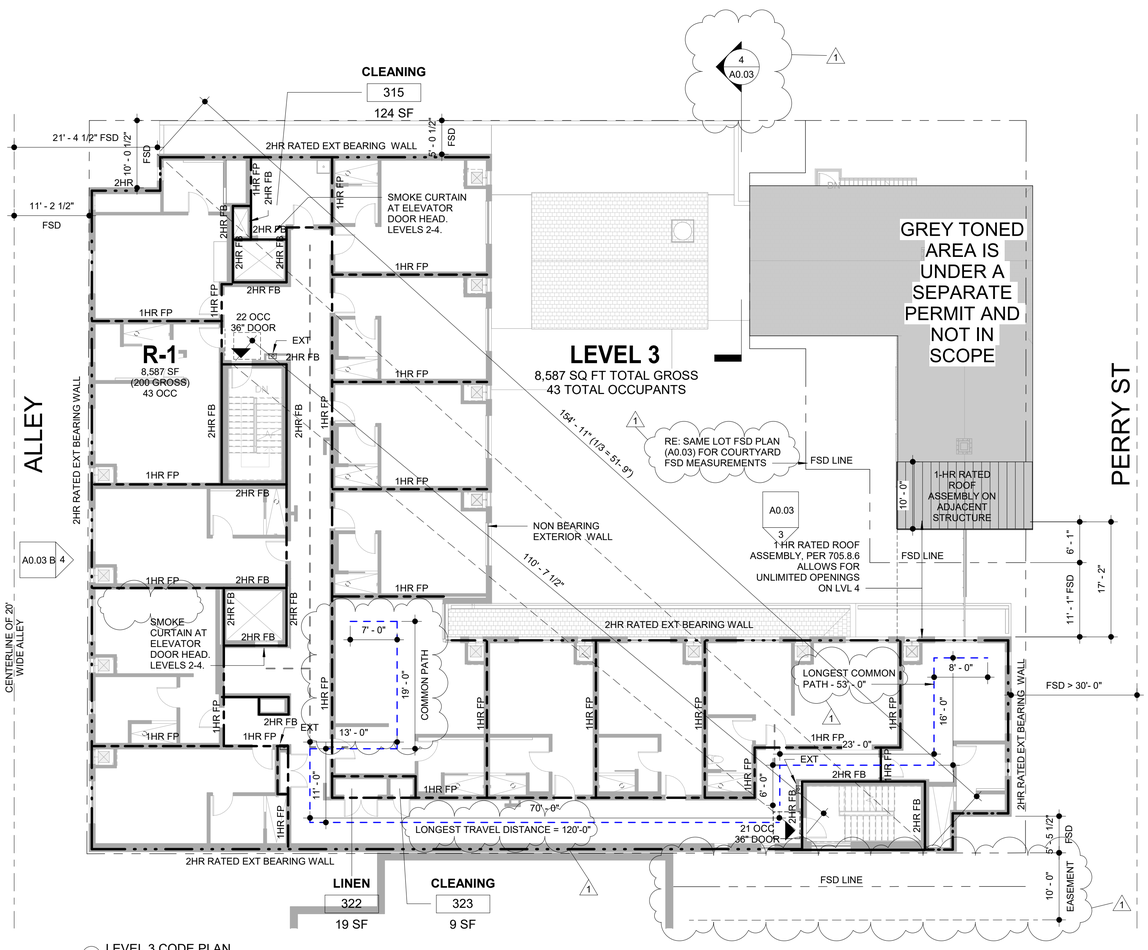

1 LEVEL 3 CODE PLAN
3/32" = 1'-0"

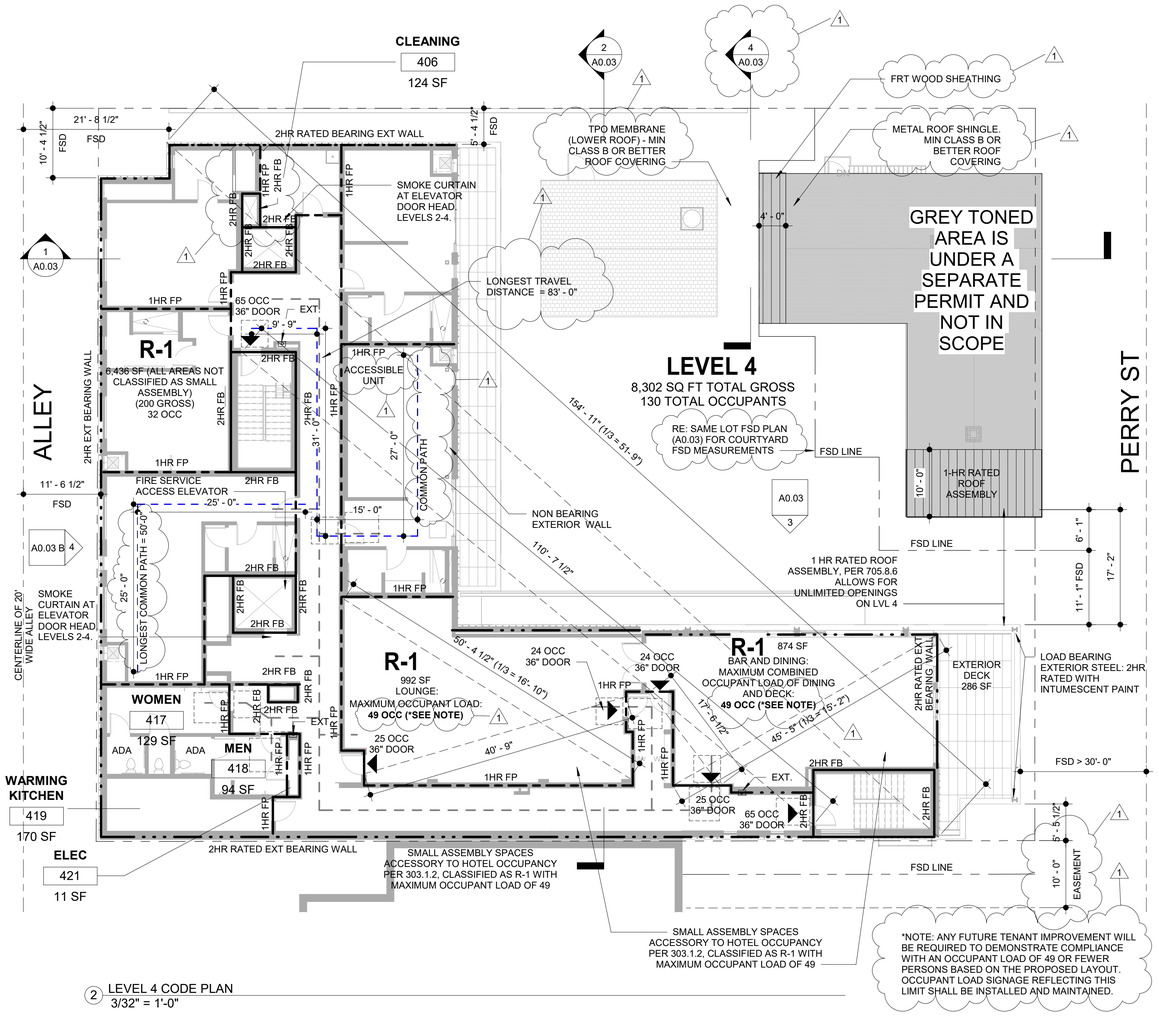

2 LEVEL 4 CODE PLAN
3/32" = 1'-0"

HELTSHE

M1A | MERIDIAN 105 ARCHITECTURE

CITY HOTEL
415 PERRY STREET, CASTLE ROCK, CO.

DATE: 4.22.2026	ISSUED FOR: PERMIT	SHEET TITLE: CODE PLANS	SHEET NUMBER A0.02
PROJ. NO. 2023.002			

C:\Users\daniel\Documents\City Hotel-2024_1_dlpscomb74Cq8.rvt

4/22/2026 1:05:19 PM

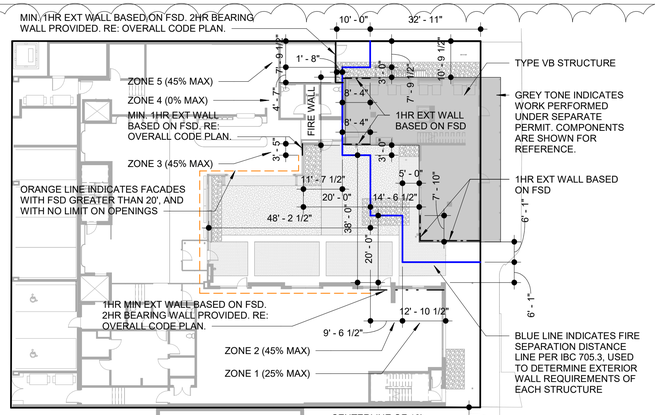

5 LEVEL 1 - COURTYARD FSD PLAN
3/64" = 1'-0"

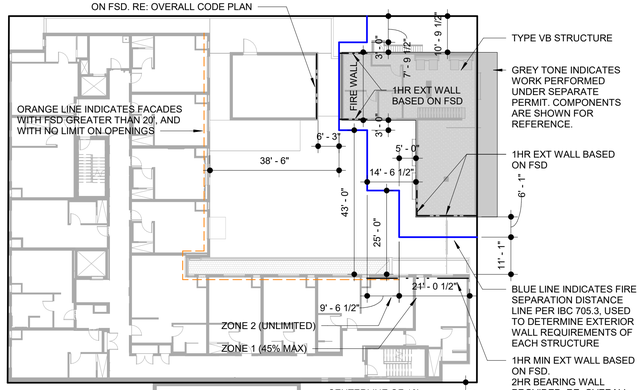

6 LEVEL 2-3 - COURTYARD FSD PLAN
3/64" = 1'-0"

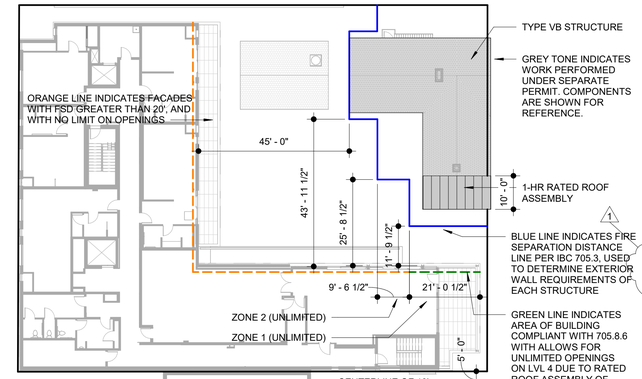

7 LEVEL 4 - COURTYARD FSD PLAN
3/64" = 1'-0"

CODE LEGEND

- 1 HR RATED FIRE BARRIER
- 1 HR RATED FIRE PARTITION
- 2 HR RATED FIRE BARRIER
- 2 HR RATED SHAFT ENCLOSURE (CONSTRUCTED AS A FIRE BARRIER)
- 2 HR RATED EXTERIOR WALL
- 1/2 HR FIRE PARTITION
- 1 HR RATED EXTERIOR WALL
- 3 HR RATED BEARING WALL
- 1/2 HR HORIZONTAL ASSEMBLY
- 2 HR RATED HORIZONTAL ASSEMBLY
- 1 HR RATED HORIZONTAL ASSEMBLY
- 3 HR RATED HORIZONTAL ASSEMBLY
- LONGEST TRAVEL DISTANCE AND/OR COMMON PATH OF TRAVEL, AS NOTED
- ACCESSIBLE ROUTE
- EGRESS EXIT
- EGRESS PATH
- EXT - FIRE EXTINGUISHER

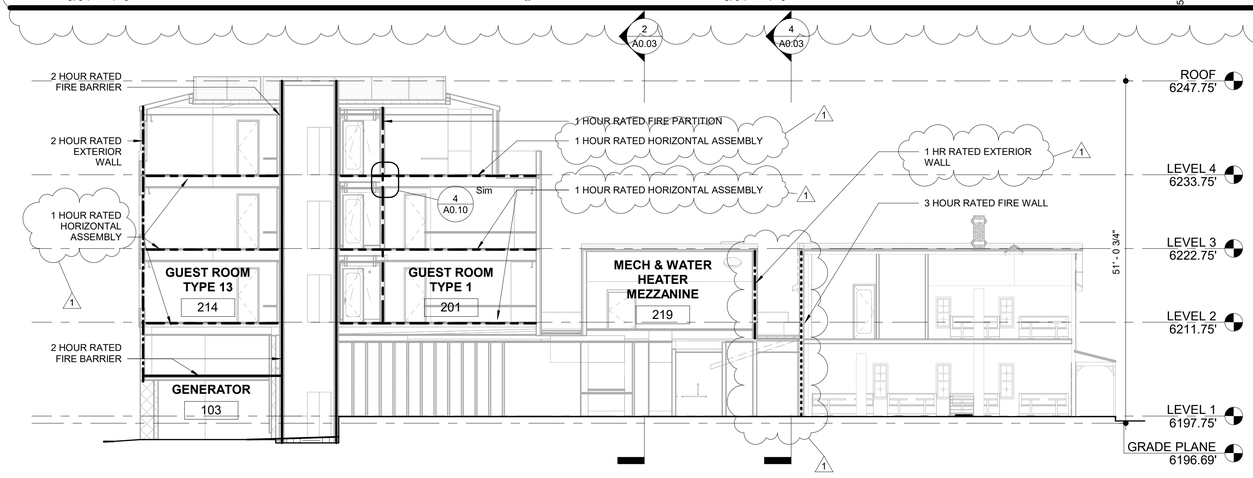

1 CODE SECTION - EAST/WEST
3/32" = 1'-0"

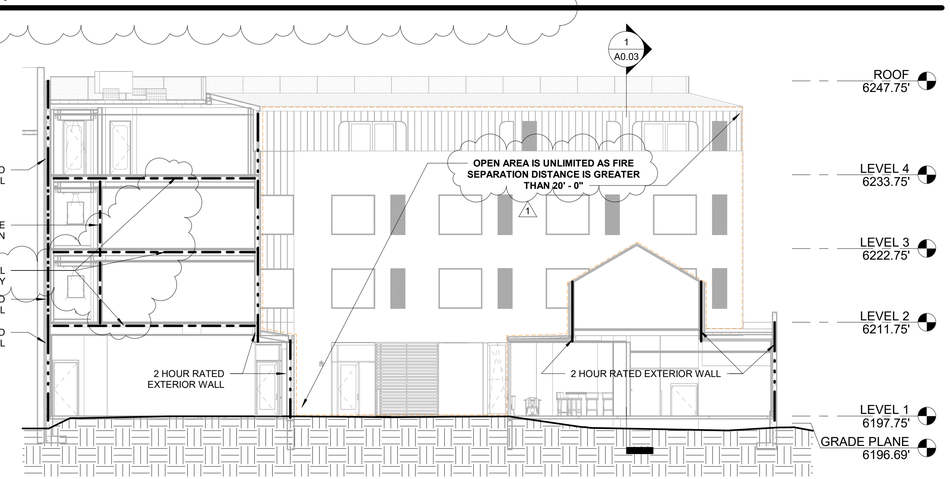

2 CODE SECTION - NORTH/SOUTH (& COURTYARD, EAST-FACING ELEVATION)
3/32" = 1'-0"

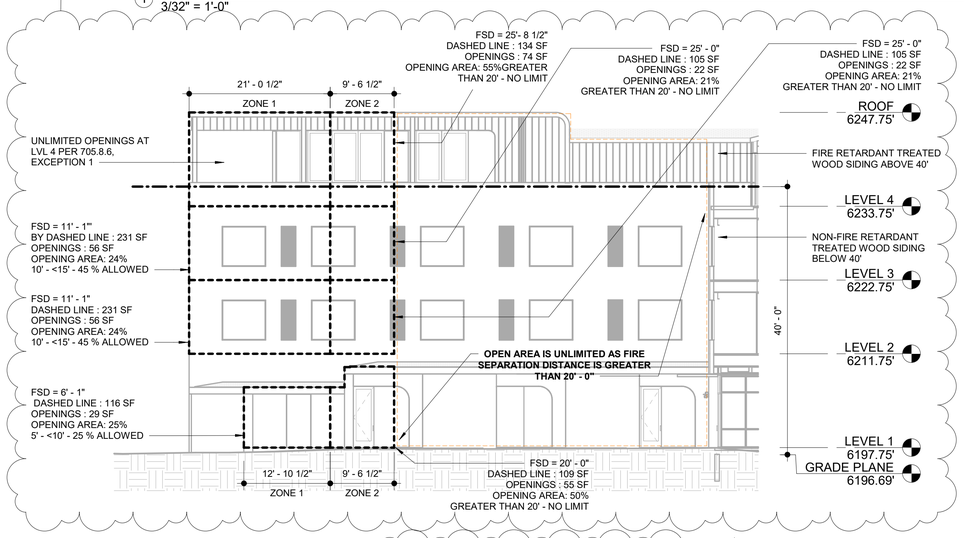

3 CODE ELEVATION - COURTYARD NORTH (& COURTYARD NORTH-FACING ELEVATION)
3/32" = 1'-0"

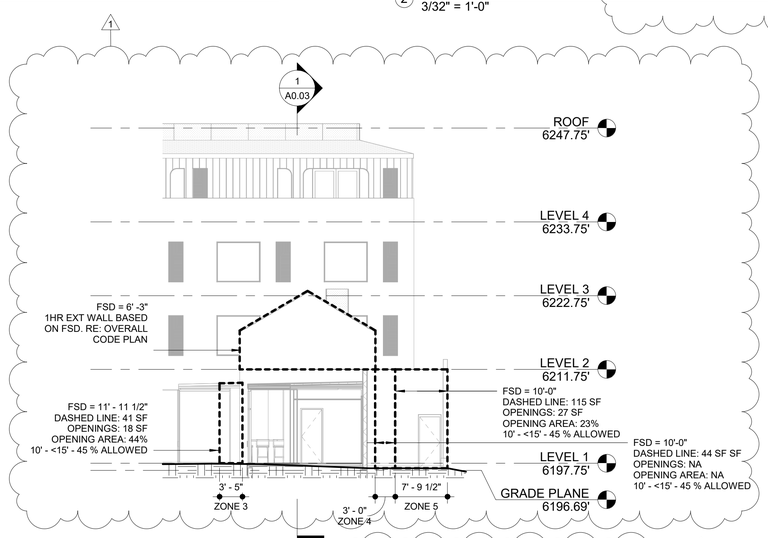

4 CODE SECTION - NORTH/SOUTH 2 (& BUILDING EXTENSION, EAST-FACING ELEVATION)
3/32" = 1'-0"

HELTSHE

M1A | MERIDIAN 105 ARCHITECTURE

CITY HOTEL

415 PERRY STREET, CASTLE ROCK, CO.

DATE: 4.22.2026
PROJ. NO. 2023.002
ISSUED FOR: PERMIT

SHEET TITLE: CODE SECTIONS AND COURTYARD ELEVATIONS

SHEET NUMBER A0.03

C:\Users\daniel\Documents\City Hotel-2024_1_dljpscomb74CJ8.rvt

4/22/2026 1:05:31 PM

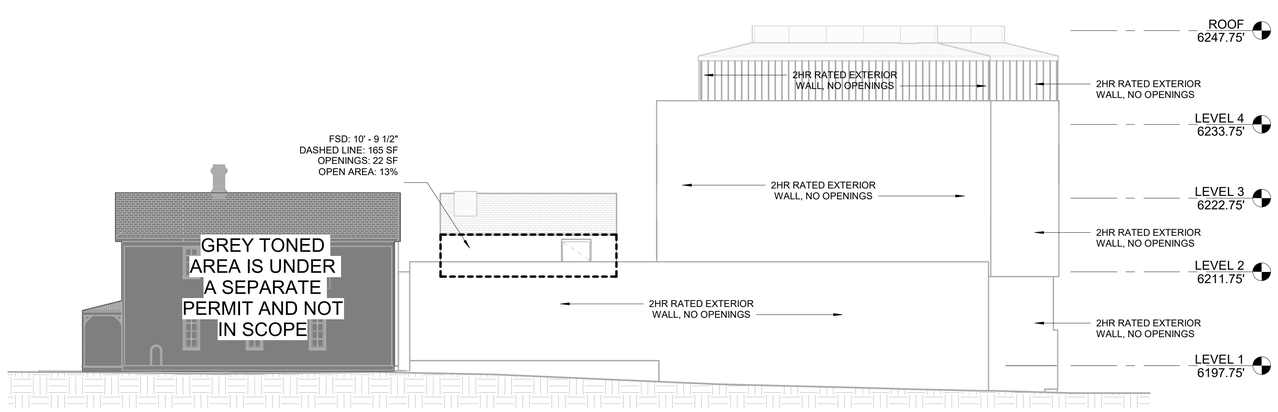

2 CODE ELEVATION - PRIMARY NORTH ELEVATION
3/32" = 1'-0"

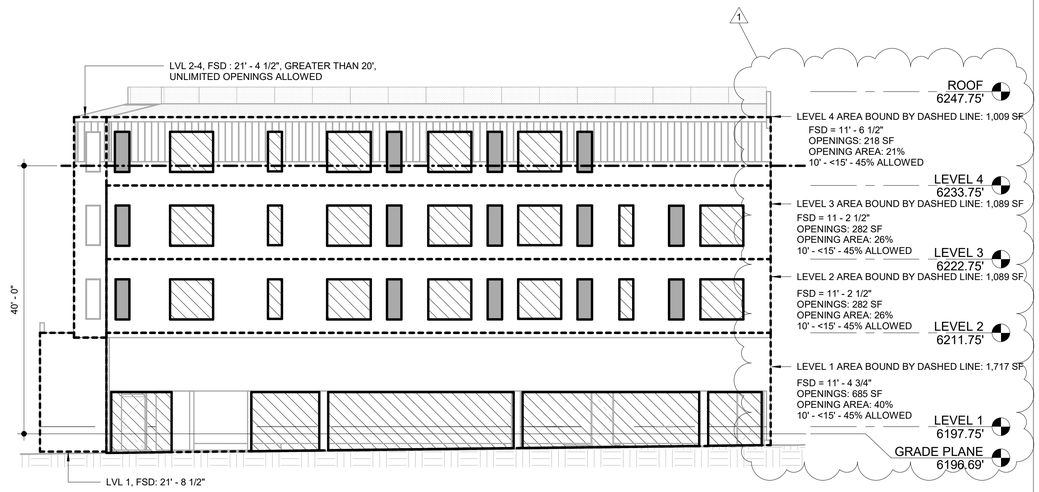

4 CODE ELEVATION - PRIMARY WEST ELEVATION
3/32" = 1'-0"

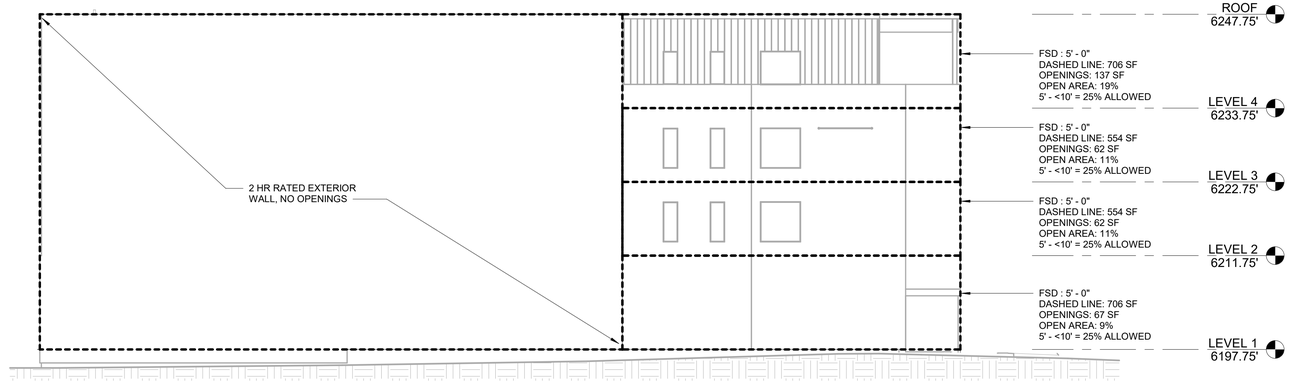

1 CODE ELEVATION - PRIMARY SOUTH ELEVATION
3/32" = 1'-0"

3 CODE ELEVATION - PRIMARY EAST ELEVATION
3/32" = 1'-0"

HELTSHE

M1A | MERIDIAN 105 ARCHITECTURE

CITY HOTEL

415 PERRY STREET, CASTLE ROCK, CO.

DATE: 4.22.2026	ISSUED FOR: PERMIT	SHEET TITLE: CODE ELEVATIONS, PRIMARY NORTH, SOUTH, EAST, WEST	SHEET NUMBER A0.03 B
PROJ. NO. 2023.002			

C:\Users\daniel\Documents\City Hotel-2024_1_dlipscomb74CJB.rvt

4/22/2026 1:05:39 PM

BUILDING CODE SUMMARY CONT'D

10. ENERY EFFICIENCY:

PROJECT REQUIREMENTS PER 2018 IECC
CLIMATE ZONE 5B

COMPLIANCE METHOD

TYPE OF USE	LOCATIONS	METHOD OF COMPLIANCE
COMMERCIAL	ENTIRE BUILDING	PERSCRIPTIVE PER IECC SECTIONS C402-C406

COMMERCIAL BUILDING ENVELOPE REQUIREMENTS TABLE C402.1.3

		ROOFS			WALLS, ABOVE GRADE				WALLS, BELOW GRADE	FLOORS		SLAB-ON-GRADE FLOORS		OPAQUE DOORS
	MAX VERTICAL FENESTRATION AREA	INSULATION ABOVE ROOF DECK	METAL BUILDINGS	ATTIC & OTHER	MASS	METAL BUILDING	METAL FRAMED	WOOD FRAMED & OTHER	BELOW GRADE WALL	MASS	JOIST/ FRAMING	UNHEATED	HEATED	NON-SWINGING
REQUIRED	30%	R-30ci	R-19+ R-11LS	R-38	R-11.4ci	R-13+ R-13ci	R-13+ R-7.5ci	R-13+ R-3.8ci or R-20	R-7.5ci	R-10ci	R-30	R-10 for 24"	R-15 for 36"	R-4.75
PROPOSED	<30%	R-30ci (where shown)	NA	R-20ci +R-30 (where shown)	R-11.4ci	NA	NA	R-20 CAVITY	NA	NA	NA	R-10 for 24"	NA	NA

PROPOSED VERTICAL FENESTRATION:

30% MAXIMUM PER 402.4.1
PROPOSED = <30%

PROPOSED SKYLIGHT AREA:

3% MAXIMUM PER 402.4.1
TOTAL ROOF AREA = 10,200 SF
SKYLIGHT ROOF AREA = 168 SF
168/10,200 = 1.6% PROPOSED

COMMERCIAL BUILDING ENVELOPE FENESTRATION MAXIMUM U-FACTOR AND SHGC REQUIREMENTS TABLE C402.4

	VERTICAL FENESTRATION U-FACTOR			VERTICAL FENESTRATION SHGC						SKYLIGHTS	
	FIXED FENESTRATION	OPERABLE FENESTRATION	ENTRANCE DOORS	PF<0.2 (NORTH)	PF<0.2 (S,E,W)	PF BETWEEN 0.2 AND 0.5 (NORTH)	PF BETWEEN 0.2 AND 0.5 (S,E,W)	PF 0.5 & GREATER (NORTH)	PF 0.5 & GREATER (S,E,W)	U-FACTOR	SHGC
REQUIRED	.38	.45	.77	.51	.38	.56	.46	.61	.61	.50	.40
PROPOSED	SEE NOTE #1			SEE NOTE #1						N/A	

NOTE #1: PRODUCTS SPECIFIED AS BASIS OF DESIGN IN PROJECT MANUAL COMPLY WITH MINIMUM REQUIREMENTS NOTED. IF GENERAL CONTRACTOR CHOOSES TO SUBMIT AN EQUAL ALTERNATE, THE PROPOSED SUBSTITUTE PRODUCTS SHALL COMPLY WITH THE MINIMUM STANDARDS NOTED. INSULATION VALUES SHALL BE SUBMITTED WITH THE SUBSTITUTION REQUEST DATA.

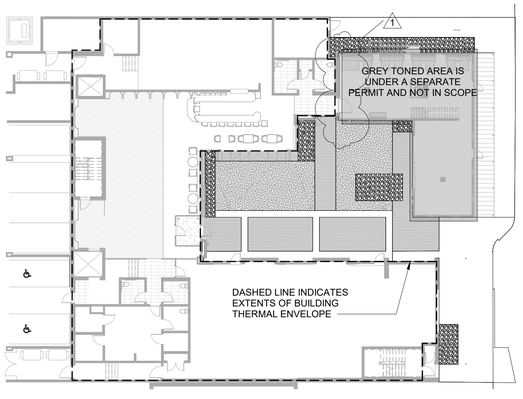

1 LEVEL 1 ENERGY CODE PLAN
3/64" = 1'-0"

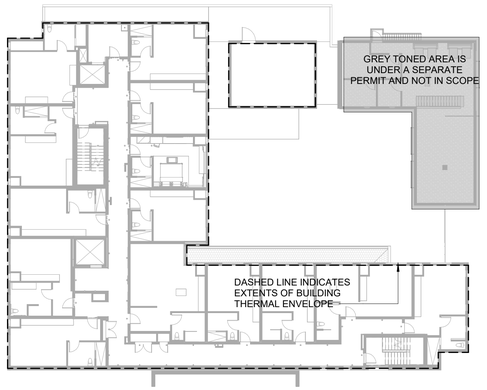

2 LEVEL 2 ENERGY CODE PLAN
3/64" = 1'-0"

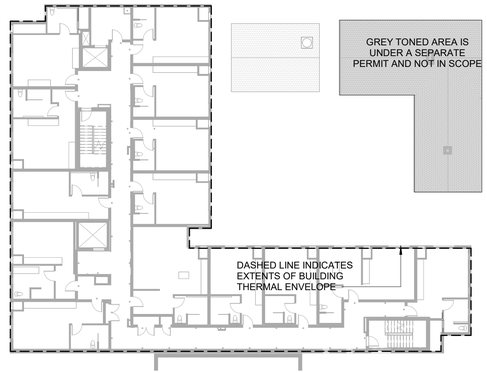

3 LEVEL 3 ENERGY CODE PLAN
3/64" = 1'-0"

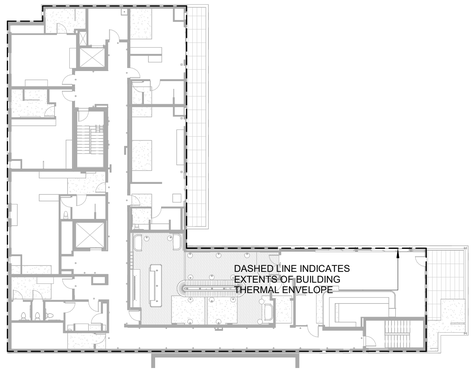

4 LEVEL 4 ENERGY CODE PLAN
3/64" = 1'-0"

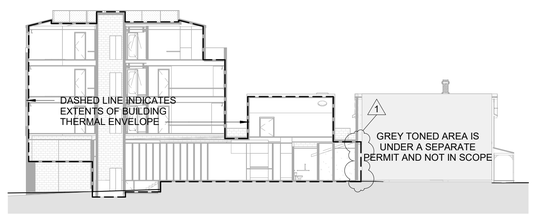

5 ENERGY CODE SECTION - EAST/WEST
3/64" = 1'-0"

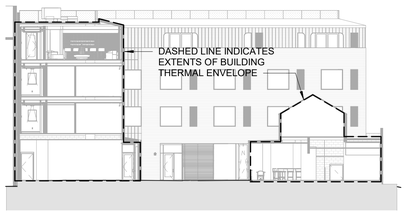

6 ENERGY CODE SECTION - NORTH/SOUTH
3/64" = 1'-0"

C:\Users\daniel\Documents\City Hotel-2024_1_dlipscomb74CJ8.rvt

4/22/2026 1:05:51 PM

HELTSHE

M1A | MERIDIAN 105 ARCHITECTURE

CITY HOTEL
415 PERRY STREET, CASTLE ROCK, CO.

DATE: 4.22.2026
PROJ. NO. 2023.002
ISSUED FOR: PERMIT
SHEET TITLE: ENERGY CODE COMPLIANCE

SHEET NUMBER
A0.04

BUILDING BLOCKS: CLEAR FLOOR SPACE

FIG. 304.3
SIZE OF WHEELCHAIR TURNING SPACE

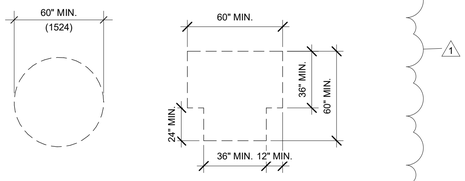

CIRCULAR T-SHAPED

FIG. 305.5
POSITION OF CLEAR FLOOR OR GROUND SPACE

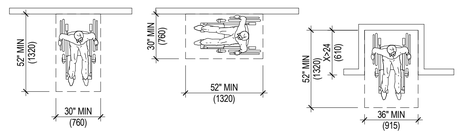

(A) FORWARD (B) PARALLEL (A) FORWARD APPROACH (B) PARALLEL APPROACH

FIG. 305.7
MANEUVERING CLEARANCE IN AN ALCOVE

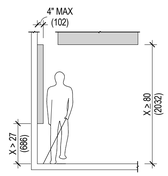

LIMITS OF PROTRUDING OBJECTS
NOTE: HANDRAILS SHALL BE PERMITTED TO PROTRUDE 4-1/2 INCHES (114 MM) MAX.

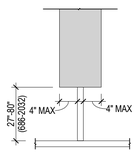

POST-MOUNTED PROTRUDING OBJECTS

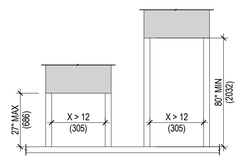

POST-MOUNTED PROTRUDING OBJECTS

REACH RANGES

FIG. 308.2.2
UNOBSTRUCTED FORWARD REACH

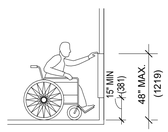

FIG. 308.2.2
OBSTRUCTED HIGH FORWARD REACH

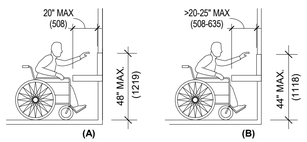

(A) (B)

FIG. 308.3.1
UNOBSTRUCTED SIDE REACH

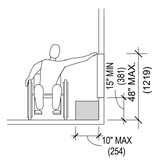

FIG. 308.3.2
OBSTRUCTED HIGH SIDE REACH

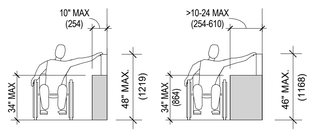

FIG. 404.2.3.3
MANEUVERING CLEARANCE AT SLIDING AND FOLDING DOORS

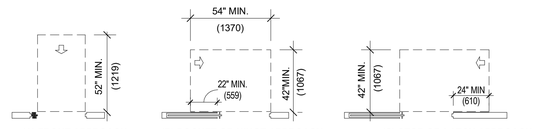

(A) FRONT APPROACH (B) POCKET OR HINGE APPROACH (C) STOP OR LATCH APPROACH

ACCESSIBLE ROUTES: DOORS AND DOORWAYS

FIG. 404.2.3.2
MANEUVERING CLEARANCE AT SWINGING DOORS

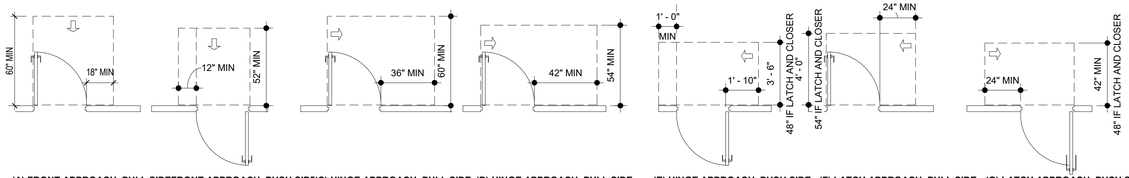

(A) FRONT APPROACH, PULL SIDEFRONT APPROACH, PUSH SIDE(C) HINGE APPROACH, PULL SIDE (D) HINGE APPROACH, PULL SIDE (E) HINGE APPROACH, PUSH SIDE (F) LATCH APPROACH, PULL SIDE (G) LATCH APPROACH, PUSH SIDE

FIG. 404.2.6
TWO DOORS IN A SERIES

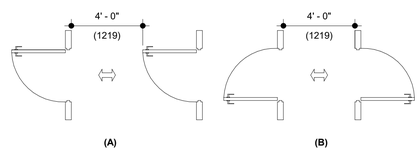

(A) (B)

PLUMBING ELEMENTS AND FACILITIES

WATER CLOSET LOCATION/ SIZE CLEARANCE

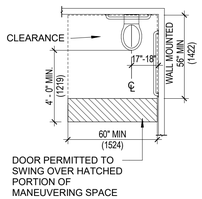

WHEELCHAIR ACCESSIBLE TOILET COMPARTMENTS

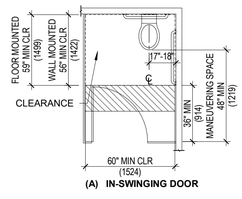

(A) IN-SWINGING DOOR

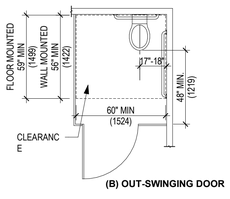

(B) OUT-SWINGING DOOR

FIG. 609.3
SPACING OF GRAB BARS

FIG. 602.3.3
DRINKING FOUNTAIN SPOUT LOCATION

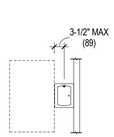

(A) PARALLEL APPROACH

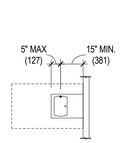

(B) FORWARD APPROACH

FIG. 606.3
HEIGHT OF LAVATORIES & SINKS

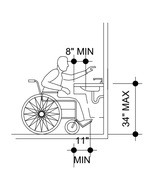

ACCESSIBLE LAVATORIES AND SINKS

- FLOOR FINISHES TO EXTEND TO REAR WALL
- CABINETRY SHALL ALLOW FOR REMOVAL WITHOUT REMOVAL OR REPLACEMENT OF THE LAVATORY
- WALLS AT BACK OF CABINETRY AND SURROUNDING WALLS SHALL BE FINISHED
- KNEE & TOE CLEARANCE PER 306.2 & 306.3

FIG. 607.4.2
GRAB BARS FOR BATHTUBS WITH REMOVEABLE SEATS

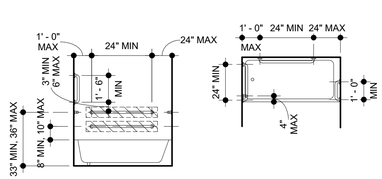

FIG. 608.3.1
GRAB BARS IN TRANSFER-TYPE SHOWER

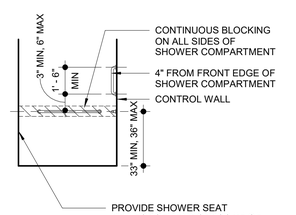

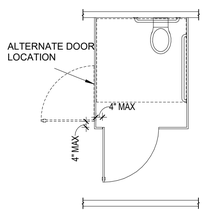

TOILET COMPARTMENT DOORS

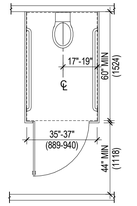

FIG. 604.5.1
SIDE WALL GRAB BAR FOR WATER CLOSET

FIG. 604.4
SIDE WALL GRAB BAR FOR WATER CLOSET

FIG. 604.5.2
REAR WALL GRAB BAR FOR WATER CLOSET

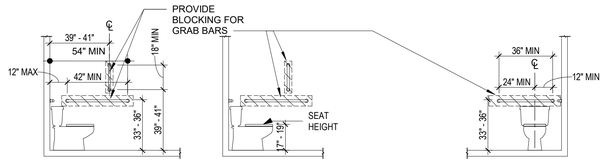

TOILET GRAB BAR REINFORCEMENT TO BE PROVIDED IN ALL TYPE A AND TYPE B UNITS

1004.11.1.1 - SWING-UP GRAB BARS

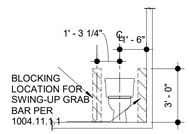

C:\Users\daniel\Documents\City Hotel-2024_1_dlipscomb74Cd8.rvt
4/22/2026 1:05:53 PM

HELTSHE

M1A MERIDIAN 105 ARCHITECTURE

CITY HOTEL
415 PERRY STREET, CASTLE ROCK, CO.

DATE: 4.22.2026	ISSUED FOR: PERMIT	SHEET TITLE: ACCESSIBILITY STANDARDS
PROJ. NO. 2023.002		

SHEET NUMBER
A0.05

WOOD

HEAD

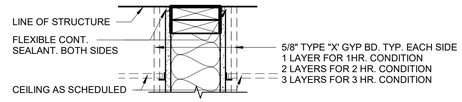

SECTION

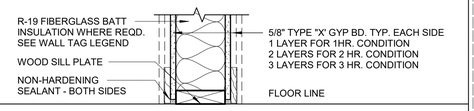

PLAN

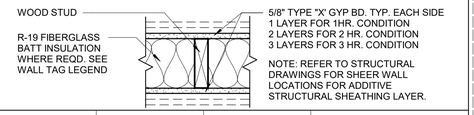

TYPE - W	STUD	RATING	U.L. NO.	EST. STC.
W.4 0	2 x 4	--		
W.6 0	2 X 6	--		
W.6 1	2 X 6	1 HOUR	U.L. U379	
W.6 2	2 X 6	2 HOUR	U.L. U301	
W.62 1	2 X 6	1 HOUR (2 LAYERS GYP EACH SIDE)	U.L. U379	

RE: STRUCTURAL DRAWINGS FOR LOAD BEARING REQUIREMENTS

FURRED WOOD

HEAD

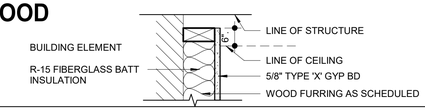

SECTION

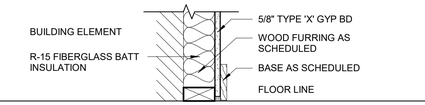

PLAN

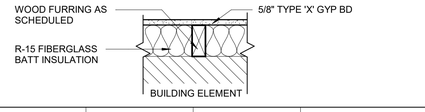

TYPE - FW	STUD	RATING	U.L. NO.	EST. STC.
FW.1 0	3/4" FURRING	--	--	--
FW.2 0	2 x 2	--	--	--
FW.4 0	2 x 4	--	--	--
FW.6 0	2 X 6	--	--	--

DBL. WOOD

HEAD

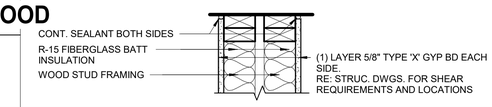

SECTION

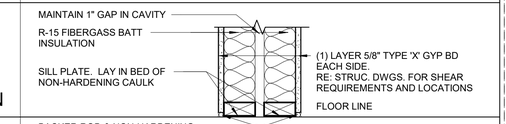

PLAN

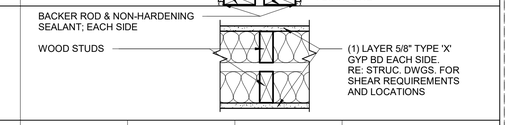

TYPE - DW	STUD	RATING	U.L. NO.	EST. STC.
DW.4 0	2 x 4	--		
DW.4 1	2 X 4	1 HOUR	U.L. U341	60 (FSTC - 55)

WALLS INDICATED AS 1/2 HR. ON THE CODE PLAN ARE TO BE BUILT AS 1 HR. DUE TO STANDARD AVAILABLE MATERIALS

RE: STRUCTURAL DRAWINGS FOR LOAD BEARING AND SHEAR REQUIREMENTS

FURRED INSULATION

HEAD

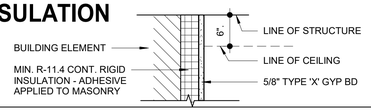

SECTION

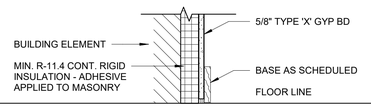

PLAN

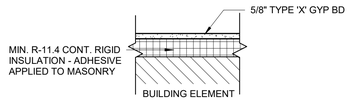

TYPE - FW	STUD	RATING	U.L. NO.	EST. STC.
FI.2 0	--	--	--	--

FURRED INSULATION

HEAD

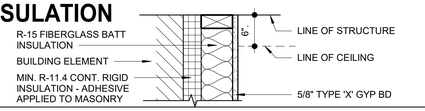

SECTION

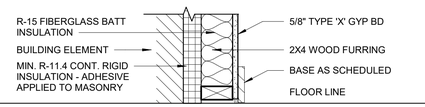

PLAN

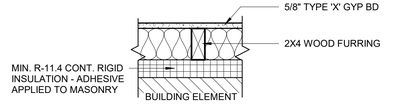

TYPE - FW	STUD	RATING	U.L. NO.	EST. STC.
FI.6 0	--	--	--	--

SFRM

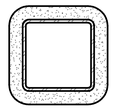

TYPE - FW	STUD	RATING	U.L. NO.	EST. STC.
-	--	--	X790	--

CIP CONC.

HEAD

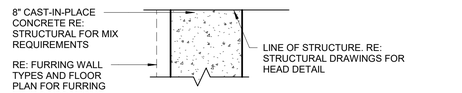

SECTION

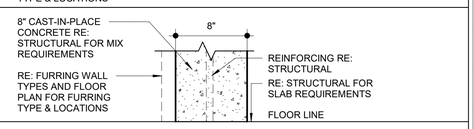

PLAN

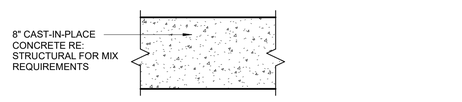

TYPE - C	CONCRETE WIDTH	RATING	U.L. NO.
C.8 0	8"	--	
C.8 1	8"	1 HOUR	* MIN. 3.5" FOR 1 HR. RATING
C.8 2	8"	2 HOUR	* MIN. 5" FOR 2 HR. RATING
C.8 3	8"	3 HOUR	* MIN. 6.2" FOR 3 HR. RATING

*MIN. EQUIVALENT THICKNESS OF C.I.P OR PRE-CAST CONC. (LOAD OR NON-LOAD BEARING) PER TABLE 721.2.1.1

CMU

HEAD

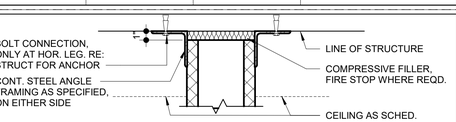

SECTION

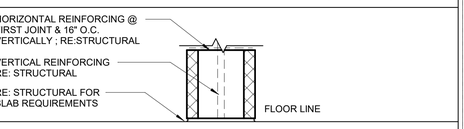

PLAN

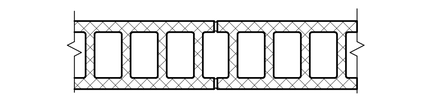

TYPE - CM	CMU WIDTH	RATING	U.L. NO.
CM.4 0	3 5/8" (8" NOM.)	--	
CM.8 0	7 5/8" (8" NOM.)	--	
CM.8 1	7 5/8" (8" NOM.)	1 HOUR	* MIN. 2.8" FOR 1-HR RATING
CM.8 2	7 5/8" (8" NOM.)	2 HOUR	* MIN. 4.2" FOR 2-HR RATING
CM.8 3	7 5/8" (8" NOM.)	3 HOUR	* MIN. 5.3" FOR 3-HR RATING

* SILICEOUS GRAVEL MEASUREMENT WITH MINIMUM EQUIVALENT THICKNESS PER TABLE 722.3.2

C-H METAL

HEAD

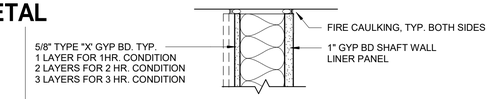

SECTION

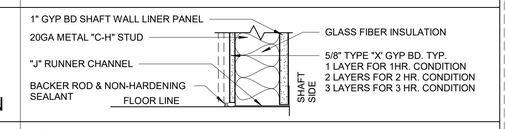

PLAN

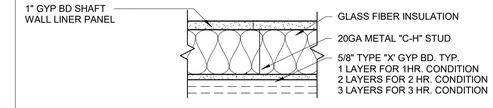

TYPE - CH	STUD	RATING	U.L. NO.	EST. STC.
CH.2 1	2 1/2"	1 HOUR	U.L. U415	
CH.4 1	4"	1 HOUR	U.L. U415	
CH.6 1	6"	1 HOUR	U.L. U415	
CH.6 2	6"	2 HOUR	U.L. U415	

STUD SCHEDULE

STUD SUFFIX	STUD DEPTH	MIN. GAUGE	HEIGHT LIMIT
1	1 5/8"	25	8'-4"
2	2 1/2"	25	11'-3"
3	3 5/8"	25	14'-4"
6	6"	25	19'-9"
8	8"	25	
C H STUD			
6	6"	20	28'

NOTE:

1. STUD SECTIONS AND HEIGHT LIMITS ARE BASED ON US GYPSUM DATA.
2. HEIGHT LIMIT IS FOR A TYPICAL CASE WITH STUDS 16" ON CENTER, 1 LAYER OF GYPSUM BOARD EACH SIDE.
3. A 5PSF LIVE LOAD ACTING NORMAL TO THE FACE OF THE PARTITION.
4. MAXIMUM ALLOWABLE DEFLECTION SHALL BE L/240 OF THE UNBRACED HEIGHT.
5. INCREASED STUD GAGE OR SPACING MAY BE REQUIRED DUE TO HEIGHT OR PARTITION. REFER TO US GYPSUM PRODUCT DATA FOR OTHER CONDITIONS.

INTERIOR WALL ASSEMBLIES - LEGEND

1. REFERENCE LEGEND, RE: FLOOR PLANS

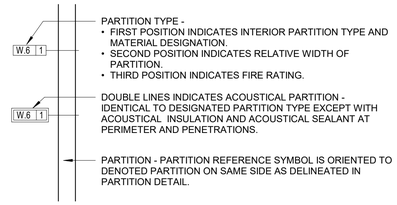

PARTITION TYPES - GENERAL NOTES

1. REFER TO TITLE SHEET(S) AND PROJECT MANUAL FOR GENERAL PROJECT NOTES, SYMBOLS, AND ABBREVIATIONS.
2. NOT ALL PARTITION TYPES DELINEATED MAY BE USED.
3. REFER TO PLANS FOR DESIGNATION OF PARTITION TYPES AND RATINGS.
4. ALL METAL STUD AND C.M.U. PARTITIONS ARE TO EXTEND TO UNDERSIDE OF STRUCTURE UNLESS NOTED OTHERWISE.
5. WHERE TWO DIFFERING PARTITION TYPES ABUT IN A LINE AND ALONG A CONTINUOUS LENGTH OF PARTITIONS, THE CONTINUOUS FINISHED SURFACES OF THESE PARTITIONS SHALL ALIGN UNLESS NOTED OTHERWISE.
6. ALL METAL STUDS TO BE SPACED @ 16" O.C. UNLESS NOTED OTHERWISE. REFER TO STRUCTURAL DRAWINGS.
7. PROVIDE FOR 1" DEFLECTION AT ALL PARTITION HEADS UNLESS NOTED OTHERWISE. PROVIDE MINIMUM 3" DEEP-LEG TRACKS.
8. PROVIDE MINIMUM DOUBLE STUD AT EACH DOOR JAMB.
9. DO NOT PLACE GYPSUM BOARD JOINT AT CORNER OF DOOR FRAME.
10. USE 5/8" TYPE "X" GYPSUM BOARD AT RATED PARTITIONS. USE 5/8" GYPSUM BOARD AT ALL OTHER LOCATIONS UNLESS NOTED OTHERWISE.
11. USE WATER-RESISTANT GYPSUM BOARD FOR WALLS IN ALL TOILET ROOMS, JANITOR'S CLOSETS, SHOWER ROOMS, EXTERIOR LOCATIONS, PARKING GARAGE AREAS, AND AS NOTED OTHERWISE.
12. USE WATER-RESISTANT GYPSUM BOARD FOR CEILINGS IN SHOWER ROOMS. MINIMUM FRAMING TO BE IN ACCORDANCE WITH IBC 2509.3.
13. USE CEMENTITIOUS BACKER UNITS AND SPACE STUDS AT 16" O.C. AT PARTITIONS TO RECEIVE CERAMIC TILE OR STONE.
14. PARTITIONS WHICH DO NOT GO TO STRUCTURE ABOVE SHALL HAVE INTERSECTING PARTITION OR BE BRACED TO STRUCTURE @ 12' O.C.
15. PROVIDE CONTROL JOINTS IN CEILINGS EXCEEDING 2500 S.F. AND IN PARTITIONS, WALLS, AND FURRING RUNS EXCEEDING 30 FT. VERIFY EXACT LOCATIONS WITH ARCHITECT. ***SEE DETAILS.***
16. THROUGH-PENETRATIONS IN RATED PARTITIONS SHALL BE FIRESTOPPED IN ACCORDANCE WITH 2018 IBC, SECTION 714.4.1.
17. MEMBRANE-PENETRATIONS IN RATED PARTITIONS SHALL BE IN ACCORDANCE WITH 2018 IBC, SECTION 714.4.2
18. PROVIDE ACOUSTICAL SEALANT AT ALL PENETRATIONS IN ACOUSTICAL PARTITIONS.
19. ACOUSTICAL BATT INSULATION TO TERMINATE AT THE STRUCTURE UNLESS NOTED OTHERWISE.
20. WHERE WALLS OR PARTITIONS ARE REQUIRED TO HAVE A FIRE-RESISTANCE RATING, RECESSED FIXTURES SHALL BE INSTALLED SUCH THAT THE REQUIRED WILL NOT BE REDUCED.
21. **2018 IBC, SECTION 708.4 CONTINUITY.** FIRE PARTITIONS SHALL EXTEND FROM THE TOP OF THE FOUNDATION OR FLOOR/ CEILING ASSEMBLY BELOW TO THE UNDERSIDE OF THE FLOOR OR ROOF SHEATHING, SLAB OR DECK ABOVE OR TO THE FIRE-RESISTANCE RATED FLOOR/ CEILING OR ROOF CEILING ASSEMBLY. WHERE PARTITIONS ARE NOT CONTINUOUS THEY SHALL BE FIREBLOCKED OR DRAFTSTOPPED PER IBC 718.2 AND 718.3 AT THE PARTITION LINE.
22. IN INTERIOR WALLS WHERE ACOUSTIC INSULATION IS REQUIRED, R-13 FIBERGLASS BATT IS TO BE USED W/ 2 1/2" MTL STUDS. R-15 FIBERGLASS BATT IS TO BE USED W/ 3 5/8" MTL STUDS, AND R-19 FIBERGLASS BATT INSULATION IS TO BE USED W/ 6" MTL STUDS UNLESS OTHERWISE NOTED.
23. ***SHAFT WALLS***
24. ***HORIZONTAL ASSEMBLIES***
25. ALL FIRE-RESISTIVE PARTITIONS SHALL BE CONSTRUCTED IN FULL COMPLIANCE WITH TESTING REQUIREMENTS AND MANUFACTURER'S RECOMMENDATIONS FOR CONDITIONS AS REQUIRED. CONSTRUCTION OF ALL SYSTEMS SHALL EQUAL THAT OF THE TESTED ASSEMBLY. CONTRACTOR MAY SUBSTITUTE ANOTHER LISTED ASSEMBLY FOR THAT INDICATED WITH PRIOR APPROVAL OF THE ARCHITECT AND THE BUILDING DEPARTMENT. TESTING FACILITIES ARE ABBREVIATED AS FOLLOWS:
UL - UNDERWRITERS LABORATORIES INC. (www.ul.com/database/index.htm)
GA - GYPSUM ASSOCIATION
NER - NATIONAL EVALUATION REPORT
WHI- WARNOCK HERSEY INTERNATIONAL

HELTSHE

M1A | MERIDIAN 105 ARCHITECTURE

CITY HOTEL

415 PERRY STREET, CASTLE ROCK, CO.

DATE: 4.22.2026
PROJ. NO. 2023.002

ISSUED FOR: PERMIT

SHEET TITLE: INTERIOR WALL ASSEMBLIES

SHEET NUMBER A0.06

C:\Users\daniel\Documents\City Hotel-2024_1_dlipscomb74Cdl.rvt

4/22/2026 1:05:55 PM

EXTERIOR CMU - NO FINISH - LVL 1

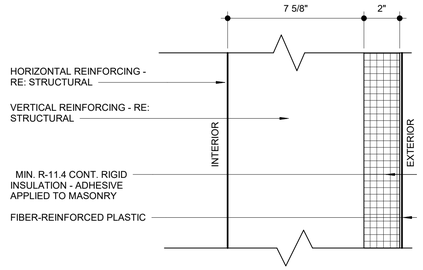

TYPE - XFA	STUD	FINISH MAT.	RATING	UL #
XI.2.7 0	NONE	FRP		

EXTERIOR WOOD - BRICK FINISH - LVL 1 (NON-BEARING)

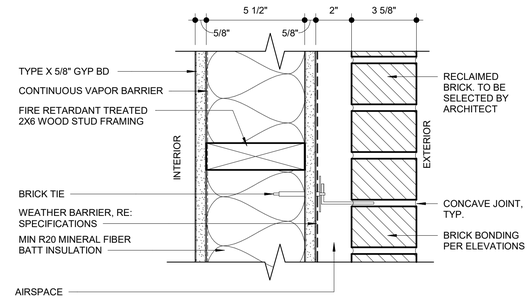

TYPE - XW	STUD	FINISH MAT.	RATING	UL #
XW.6.2 0	2 x 6 NOM.	MASONRY, THKNESS. PER SPEC.	-	

EXTERIOR WOOD - BRICK FINISH - LVL 1

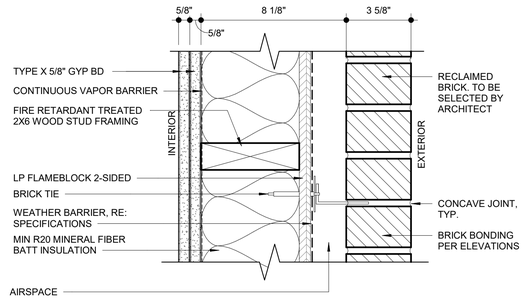

TYPE - XW	STUD	FINISH MAT.	RATING	UL #
XW.6.2 2	2 x 6 NOM.	MASONRY, THKNESS. PER SPEC.	-	V337

EXTERIOR WALL ASSEMBLIES - LEGEND

1. REFERENCE LEGEND, RE: FLOOR PLANS

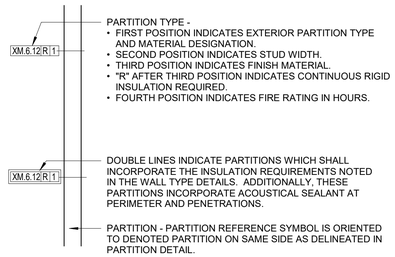

2. FINISH MATERIALS

.1 NO FINISH
.2 BRICK
.3 WOOD - GREY
.4 WOOD - BLACK
.5 WOOD W/VERTICAL BATTENS - BLACK
.6 FRT WOOD W/VERTICAL BATTENS - BLACK
.7 FRP (FIBER-REINFORCED PLASTIC)
.8 WOOD - WHITE

EXTERIOR SIDING FINISH ON CMU/CONC. - LVL 1,2,3

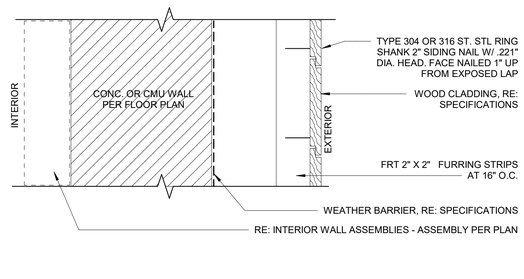

TYPE - XFW	STUD	FINISH MAT.	RATING	UL #
X.6.3 0				

EXTERIOR WOOD - SIDING - LVL 1,2,3 (NON-BEARING)

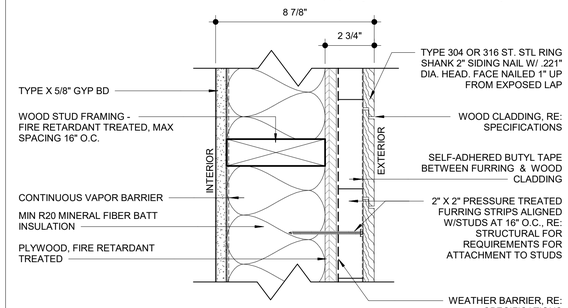

TYPE - XW	STUD	FINISH MAT.	RATING	UL #
XW.6.3 0	2 x 6 NOM.	SHIP LAP	0	
XW.6.4 0	2 x 6 NOM.	SHIP LAP	0	

EXTERIOR WOOD - SIDING - LVL 1,2,3

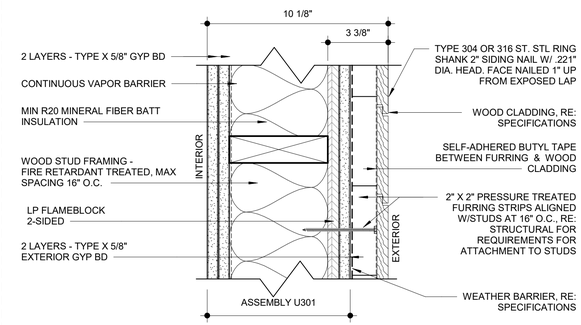

TYPE - XW	STUD	FINISH MAT.	RATING	UL #
XW.6.3 2	2 x 6 NOM.	SHIP LAP - GREY	2 HR	V337
XW.6.4 2	2 x 6 NOM.	SHIP LAP - BLACK	2 HR	V337

EXTERIOR SIDING FINISH ON CMU/CONC. - LVL 4

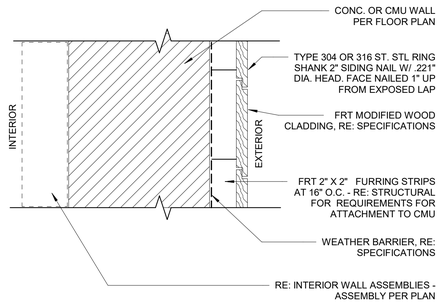

TYPE - XFW	STUD	FINISH MAT.	RATING	UL #
X.2.6 0	-	FRT SHIP LAP W/ VERTICAL BATTENS	-	

EXTERIOR WOOD - FRT SIDING - (NON-BEARING)

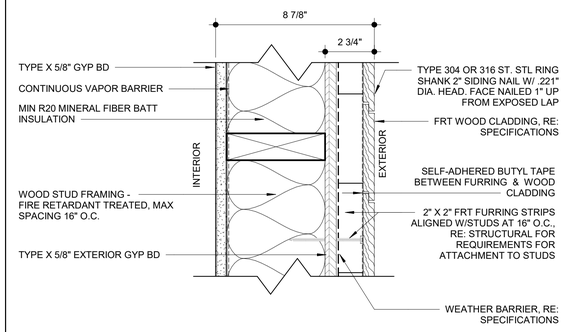

TYPE - XW	STUD	FINISH MAT.	RATING	UL #
XW.6.6 1	2 x 6 NOM.	FRT SHIP LAP W/ VERTICAL BATTENS	1 HR	U 305

EXTERIOR WOOD - FRT SIDING - LVL 4

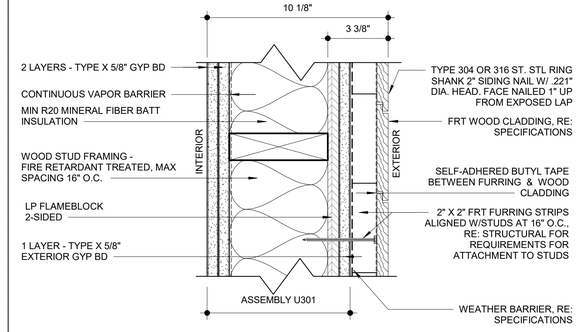

TYPE - XW	STUD	FINISH MAT.	RATING	UL #
XW.6.6 2	2 x 6 NOM.	FRT SHIP LAP W/ VERTICAL BATTENS	2 HR	V337

HELTSHE

M1A | MERIDIAN 105 ARCHITECTURE

CITY HOTEL
415 PERRY STREET, CASTLE ROCK, CO.

DATE: 4.22.2026
PROJ. NO. 2023.002
ISSUED FOR: PERMIT
SHEET TITLE: EXTERIOR WALL ASSEMBLIES
SHEET NUMBER A0.07

C:\Users\daniel\Documents\City Hotel-2024_1_dlipscomb74CJ8.rvt
4/22/2026 1:05:57 PM

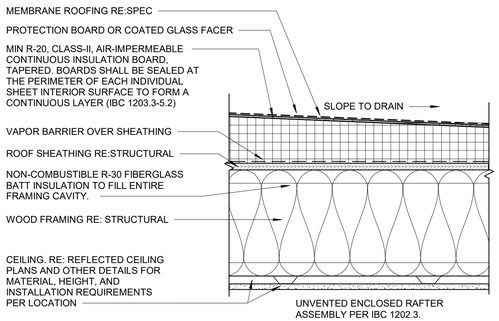

TYPE	LEVEL	LOCATION	RATING	UL #
RS-1	ROOF	RE: A2.05		

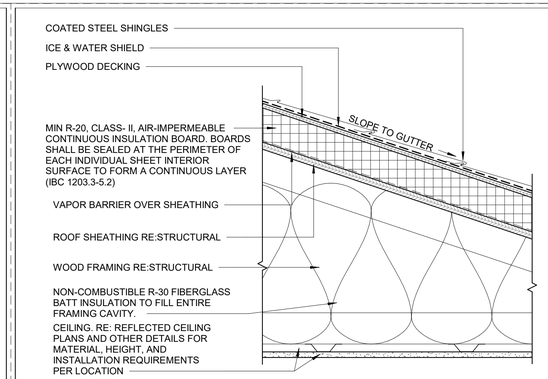

TYPE	LEVEL	LOCATION	RATING	UL #
RS-2	ROOF	RE: A2.05	-	-

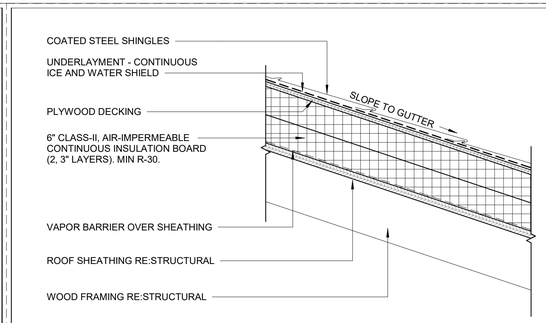

TYPE	LEVEL	LOCATION	RATING	UL #
RS-3	ROOF	RE: A2.05	-	-

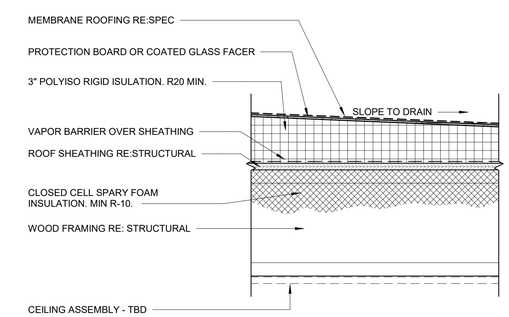

TYPE	LEVEL	LOCATION	RATING	UL #
RS-4	ROOF	RE: A2.05	-	-

TYPE	LEVEL	LOCATION	RATING	UL #
RS-5	ROOF	RE: A2.05	-	-

TYPE	LEVEL	LOCATION	RATING	UL #
RS-6	ROOF	RE: A2.05	-	

TYPE	LEVEL	LOCATION	RATING	UL #
RS-7	ROOF	RE: A2.05	-	-

TYPE	LEVEL	LOCATION	RATING	UL #
MB-1	LEVEL 1	GENERATOR ROOM	2 HR	BXUV.1516

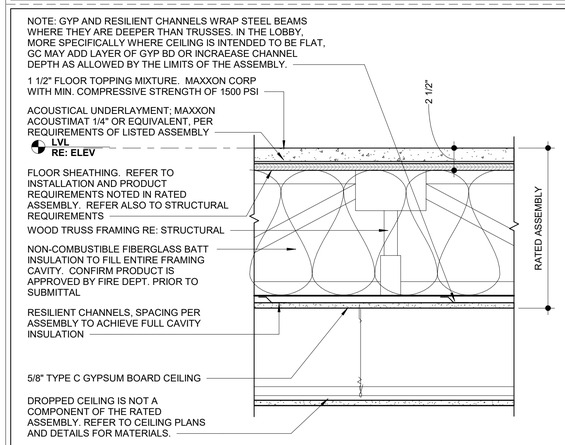

TYPE	LEVEL	LOCATION	RATING	UL #
FS-1	LEVEL 2, 3, 4	THROUGHOUT	1 HOUR (1/2 HR REQD.)	L546

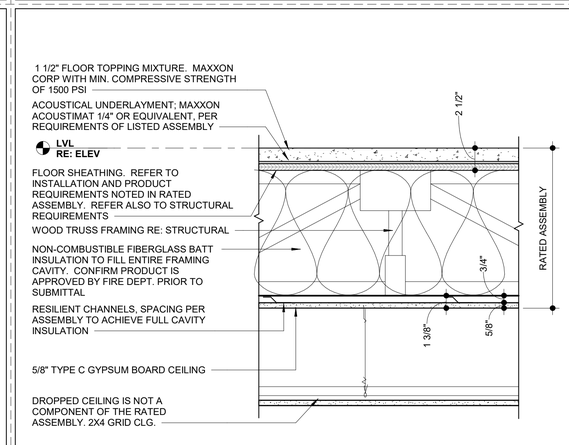

TYPE	LEVEL	LOCATION	RATING	UL #
FS-1	LEVEL 2	ABOVE PARKING AT ALLEY	1 HOUR (1/2 HR REQD.)	L546

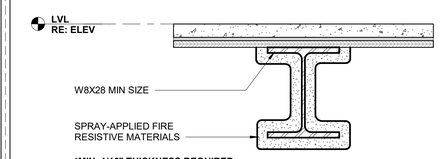

TYPE	LEVEL	LOCATION	RATING	UL #
-	-	PER PLAN	2 HOUR	N743

HELTSHE

M1A MERIDIAN 105 ARCHITECTURE

CITY HOTEL

415 PERRY STREET, CASTLE ROCK, CO.

DATE: 4.22.2026
PROJ. NO. 2023.002

ISSUED FOR: PERMIT

SHEET TITLE: HORIZONTAL ASSEMBLIES

SHEET NUMBER A0.08

C:\Users\daniel\Documents\City Hotel-2024_1_dlpscomb74Cdll.rvt

4/22/2026 1:05:59 PM

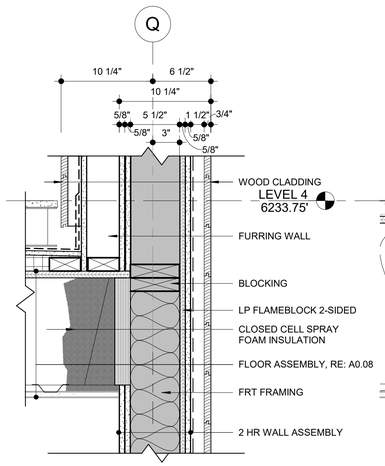

1 SECTION DETAIL - EAST WALL GRID H - LVL 4
1 1/2" = 1'-0"

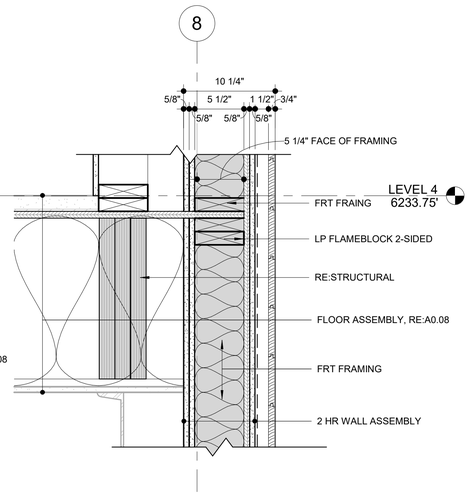

2 SECTION DETAIL - EXTERIOR WALL GRID 8 - LVL 4
1 1/2" = 1'-0"

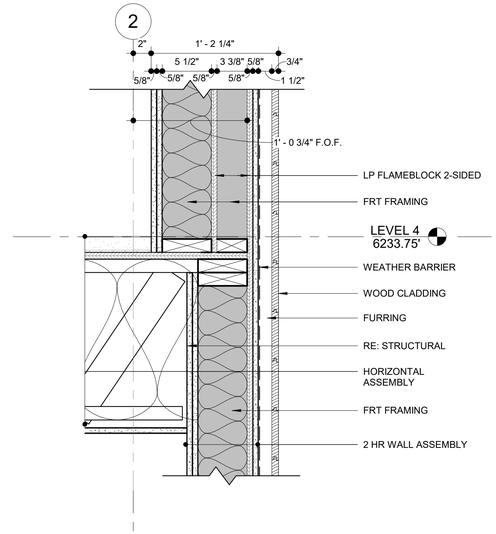

3 SECTION DETAIL - EXTERIOR WALL GRID 2 - LVL 4
1 1/2" = 1'-0"

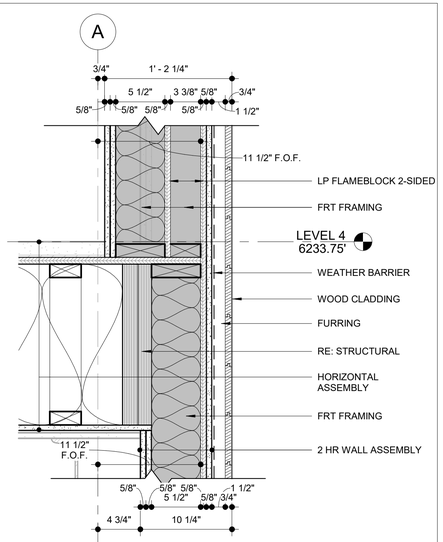

4 SECTION DETAIL - WEST ALLEY 2
1 1/2" = 1'-0"

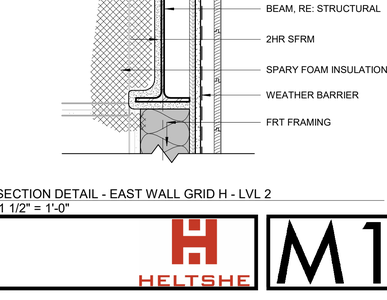

5 SECTION DETAIL - EAST WALL GRID H - LVL 3
1 1/2" = 1'-0"

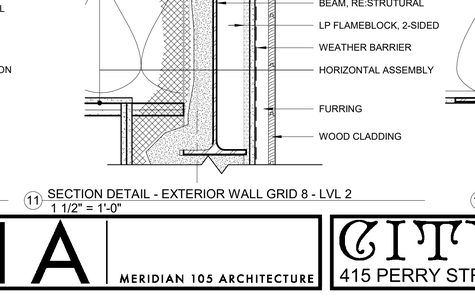

6 SECTION DETAIL - EXTERIOR WALL GRID 8 - LVL 3
1 1/2" = 1'-0"

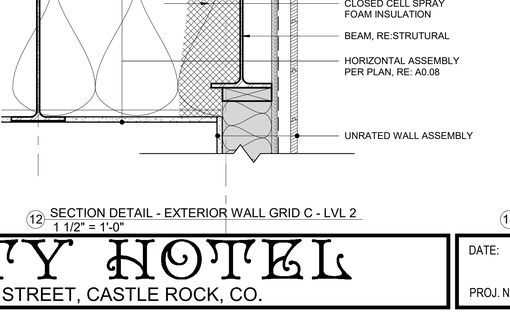

7 SECTION DETAIL - EXTERIOR WALL GRID C - LVL 3
1 1/2" = 1'-0"

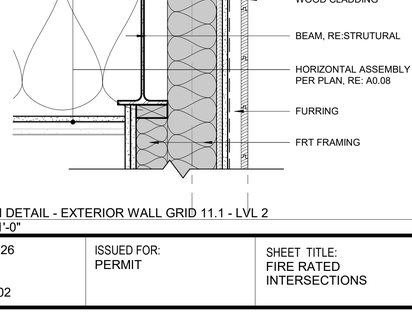

8 SECTION DETAIL - EXTERIOR WALL INTERSECTION
1 1/2" = 1'-0"

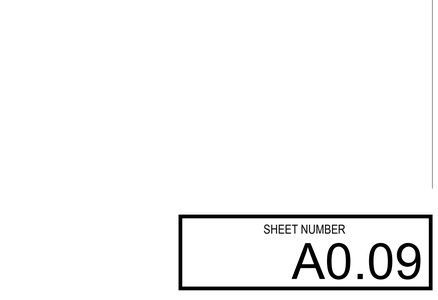

9 SECTION DETAIL - WEST ALLEY
1 1/2" = 1'-0"

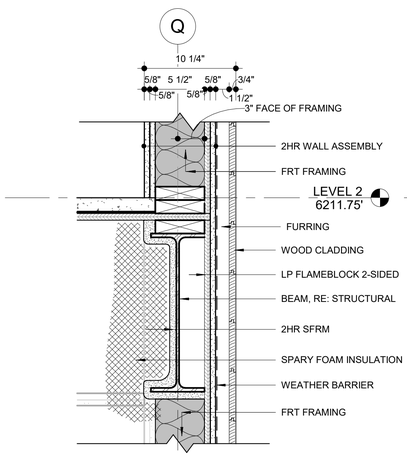

10 SECTION DETAIL - EAST WALL GRID H - LVL 2
1 1/2" = 1'-0"

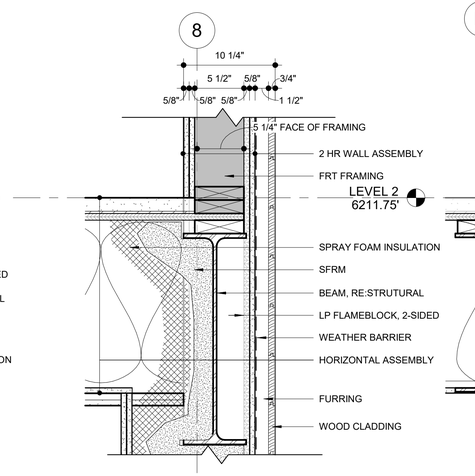

11 SECTION DETAIL - EXTERIOR WALL GRID 8 - LVL 2
1 1/2" = 1'-0"

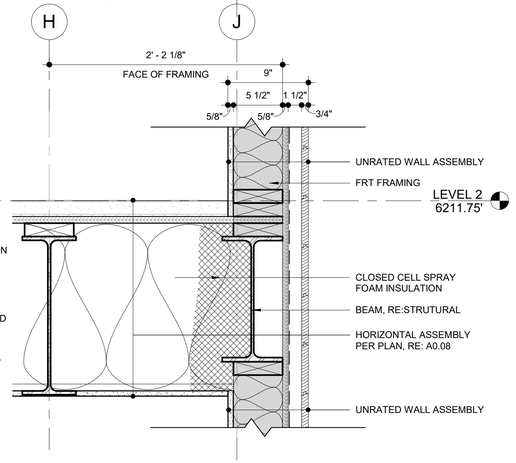

12 SECTION DETAIL - EXTERIOR WALL GRID C - LVL 2
1 1/2" = 1'-0"

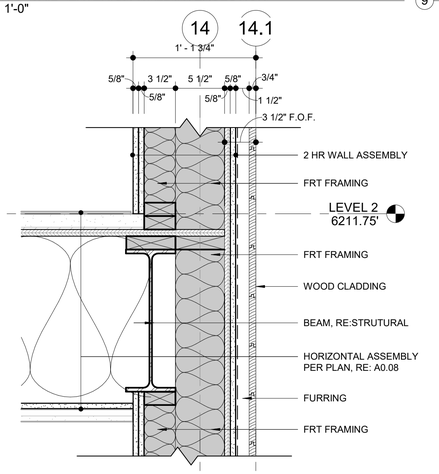

13 SECTION DETAIL - EXTERIOR WALL GRID 11.1 - LVL 2
1 1/2" = 1'-0"

HELTSHE

M1A | MERIDIAN 105 ARCHITECTURE

CITY HOTEL
415 PERRY STREET, CASTLE ROCK, CO.

DATE: 4.22.2026	ISSUED FOR: PERMIT	SHEET TITLE: FIRE RATED INTERSECTIONS	SHEET NUMBER A0.09
PROJ. NO. 2023.002			

C:\Users\daniel\Documents\City Hotel-2024_1_dlpscomb7AC4B.rvt

4/22/2026 1:06:04 PM

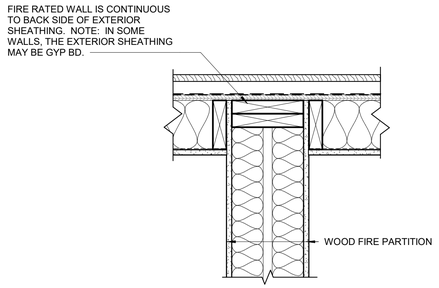

1 PLAN DETAIL - WOOD UNIT DEMISING WALL AT EXTERIOR WALL
1 1/2" = 1'-0"

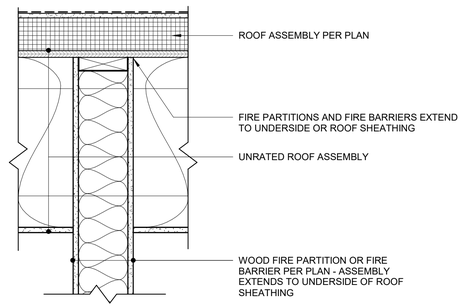

2 SECTION DETAIL - FIRE BARRIER & FIRE PARTITION HEADS AT UNRATED ROOF ASSEMBLY
1 1/2" = 1'-0"

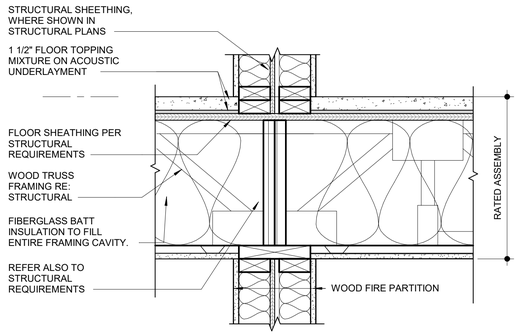

3 SECTION DETAIL - FIRE PARTITION AT FLOOR ASSEMBLY
1 1/2" = 1'-0"

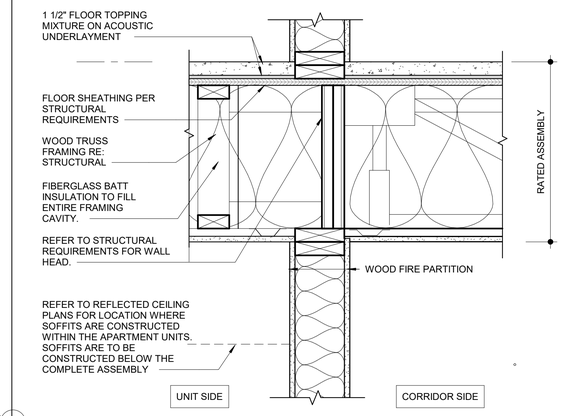

4 SECTION DETAIL - CORRIDOR WALL AT FLOOR ASSEMBLY
1 1/2" = 1'-0"

C:\Users\daniel\Documents\City Hotel-2024_1_dlipscomb74CJ8.rvt
4/22/2026 1:06:05 PM

HELTSHE

M1A MERIDIAN 105 ARCHITECTURE

CITY HOTEL
415 PERRY STREET, CASTLE ROCK, CO.

DATE: 4.22.2026	ISSUED FOR: PERMIT	SHEET TITLE: ASSEMBLY INTERSECTIONS	SHEET NUMBER A0.10
PROJ. NO. 2023.002			

ANNULAR SPACE PROTECTION

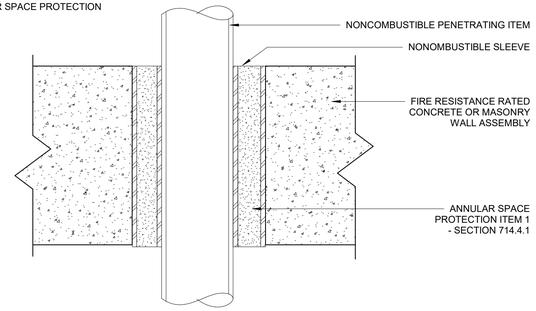

ANNULAR SPACE PROTECTION
-SECTION 714.5.1, EXCEPTION 1

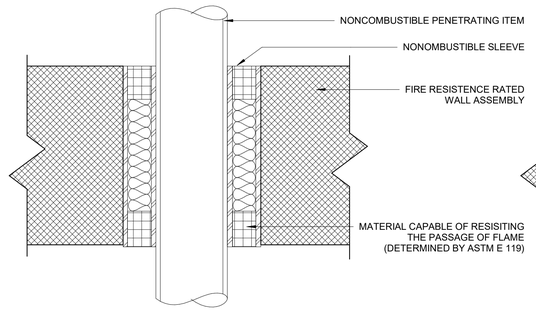

ANNULAR SPACE PROTECTION
-SECTION 714.5.1, EXCEPTION 2

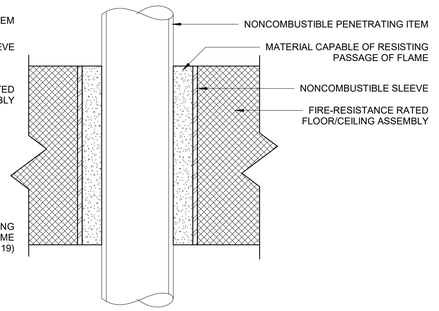

ANNULAR SPACE PROTECTION
-SECTION 714.5.1, EXCEPTION 1

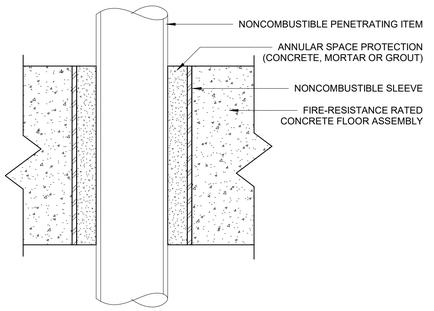

ANNULAR SPACE PROTECTION
-SECTION 714.5.1, EXCEPTION 2

COMBUSTIBLE PENETRATION DETAIL

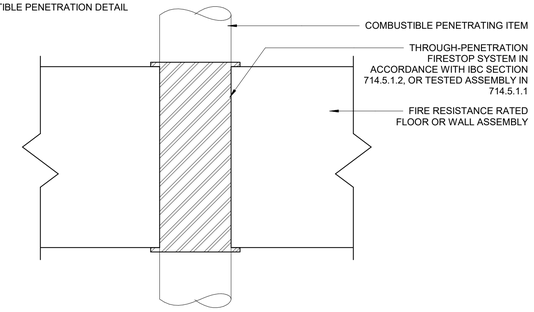

THROUGH-PENETRATION COMPLIANT
WITH IBC 714.5.1

COMBUSTIBLE PENETRATION DETAIL

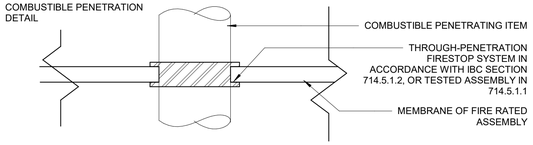

MEMBRANE-PENETRATION COMPLIANT
WITH IBC 714.4.2

1 SECTION DETAILS - ANNULAR SPACE PROTECTION
3" = 1'-0"

NOTE: THE FOLLOWING PENETRATION ASSEMBLIES ARE THE BASIS OF DESIGN INTENDED TO CONVEY A CODE-COMPLIANT SOLUTION. ALTERNATE ASSEMBLIES EMPLOYING PRODUCTS BY ALTERNATE MANUFACTURERS MAY BE FOUND ACCEPTABLE PROVIDED CODE COMPLIANCE CAN BE DEMONSTRATED IN BOTH THE SUBMITTAL PROCESS AND TO THE TOWN OF CASTLE ROCK.

ASSEMBLY	METAL DUCT/VENT	METAL DUCT/VENT WITH INSULATION	PVC VENT	CPVC	PEX/HDPE	PVC TUBING	PVC CONDUIT	ELECTRICAL WIRING	METALLIC CONDUIT
FLOOR/CEILING			F-C-2348 (3" OR 4" DIAMETER) F-C-2156 (4" DIAMETER MAX) F-C-2036 (1 1/2" DIAMETER MAX) C-AJ-2297 (3HR FIRE RATING 4" DIAMETER MAX)	F-C-2348 (3" OR 4" DIAMETER) F-C-2156 (4" DIAMETER MAX) C-AJ-2297 (3HR FIRE RATING 4" DIAMETER MAX)	F-C-2032 (2" DIAMETER MAX) HIGH DENSITY POLYETHYLENE PIPE (HDPE) C-AJ-2297 (3HR FIRE RATING)	F-C-2348 (3" OR 4" DIAMETER) F-C-2156 (4" DIAMETER MAX) F-C-2036 (1 1/2" DIAMETER MAX) C-AJ-2297 (3HR FIRE RATING)	F-C-2348 (3" OR 4" DIAMETER) F-C-8021 (1 1/4" DIAMETER MAX)	F-C-8021 C-AJ-3214 (3HR FIRE RATING)	F-C-1074 (4" DIAMETER MAX) F-C-8021 (3/4" DIAMETER MAX) C-AJ-1213 (3HR FIRE RATING; EMT 4" DIAM MAX, FLEXIBLE CONDUIT 1" DIAM MAX)
1HR RATED WALLS 2HR RATED WALLS	W-L-7060 (RECTANGLE) W-L-7026 (CIRCLE)	W-L-7028 (RECTANGLE) MAX 24" X 30"	W-L-2288 (12" DIAMETER MAX) W-L-2243 (6" DIAMETER MAX) W-L-2237 (4" DIAMETER MAX)	W-L-2243 (6" DIAMETER MAX) W-L-2241 (2" DIAMETER MAX)	W-L-2423 (2" DIAMETER MAX)	W-L-2288 (12" DIAMETER MAX) W-L-2243 (6" DIAMETER MAX) W-L-2237 (4" DIAMETER MAX)	W-L-2288 (12" DIAMETER MAX) W-L-2243 (6" DIAMETER MAX)	W-L-3024 W-L-3210	W-L-1049 (6" DIAMETER MAX) W-L-1222 (6" DIAMETER MAX)
NON-RATED WALLS					W-L-2242 (1" DIAMETER MAX)			W-L-3024	W-L-1049 (1" DIAMETER MAX FLEXIBLE CONDUIT)

FIRE PENETRATIONS SCHEDULE
12" = 1'-0"

C:\Users\daniel\Documents\City Hotel-2024_1_dlipscomb74Cdl.rvt

4/22/2026 1:06:06 PM

HELTSHE

M1A MERIDIAN 105 ARCHITECTURE

CITY HOTEL
415 PERRY STREET, CASTLE ROCK, CO.

DATE: 4.22.2026 PROJ. NO. 2023.002	ISSUED FOR: PERMIT	SHEET TITLE: FIRE RATED INTERSECTIONS	SHEET NUMBER A0.11

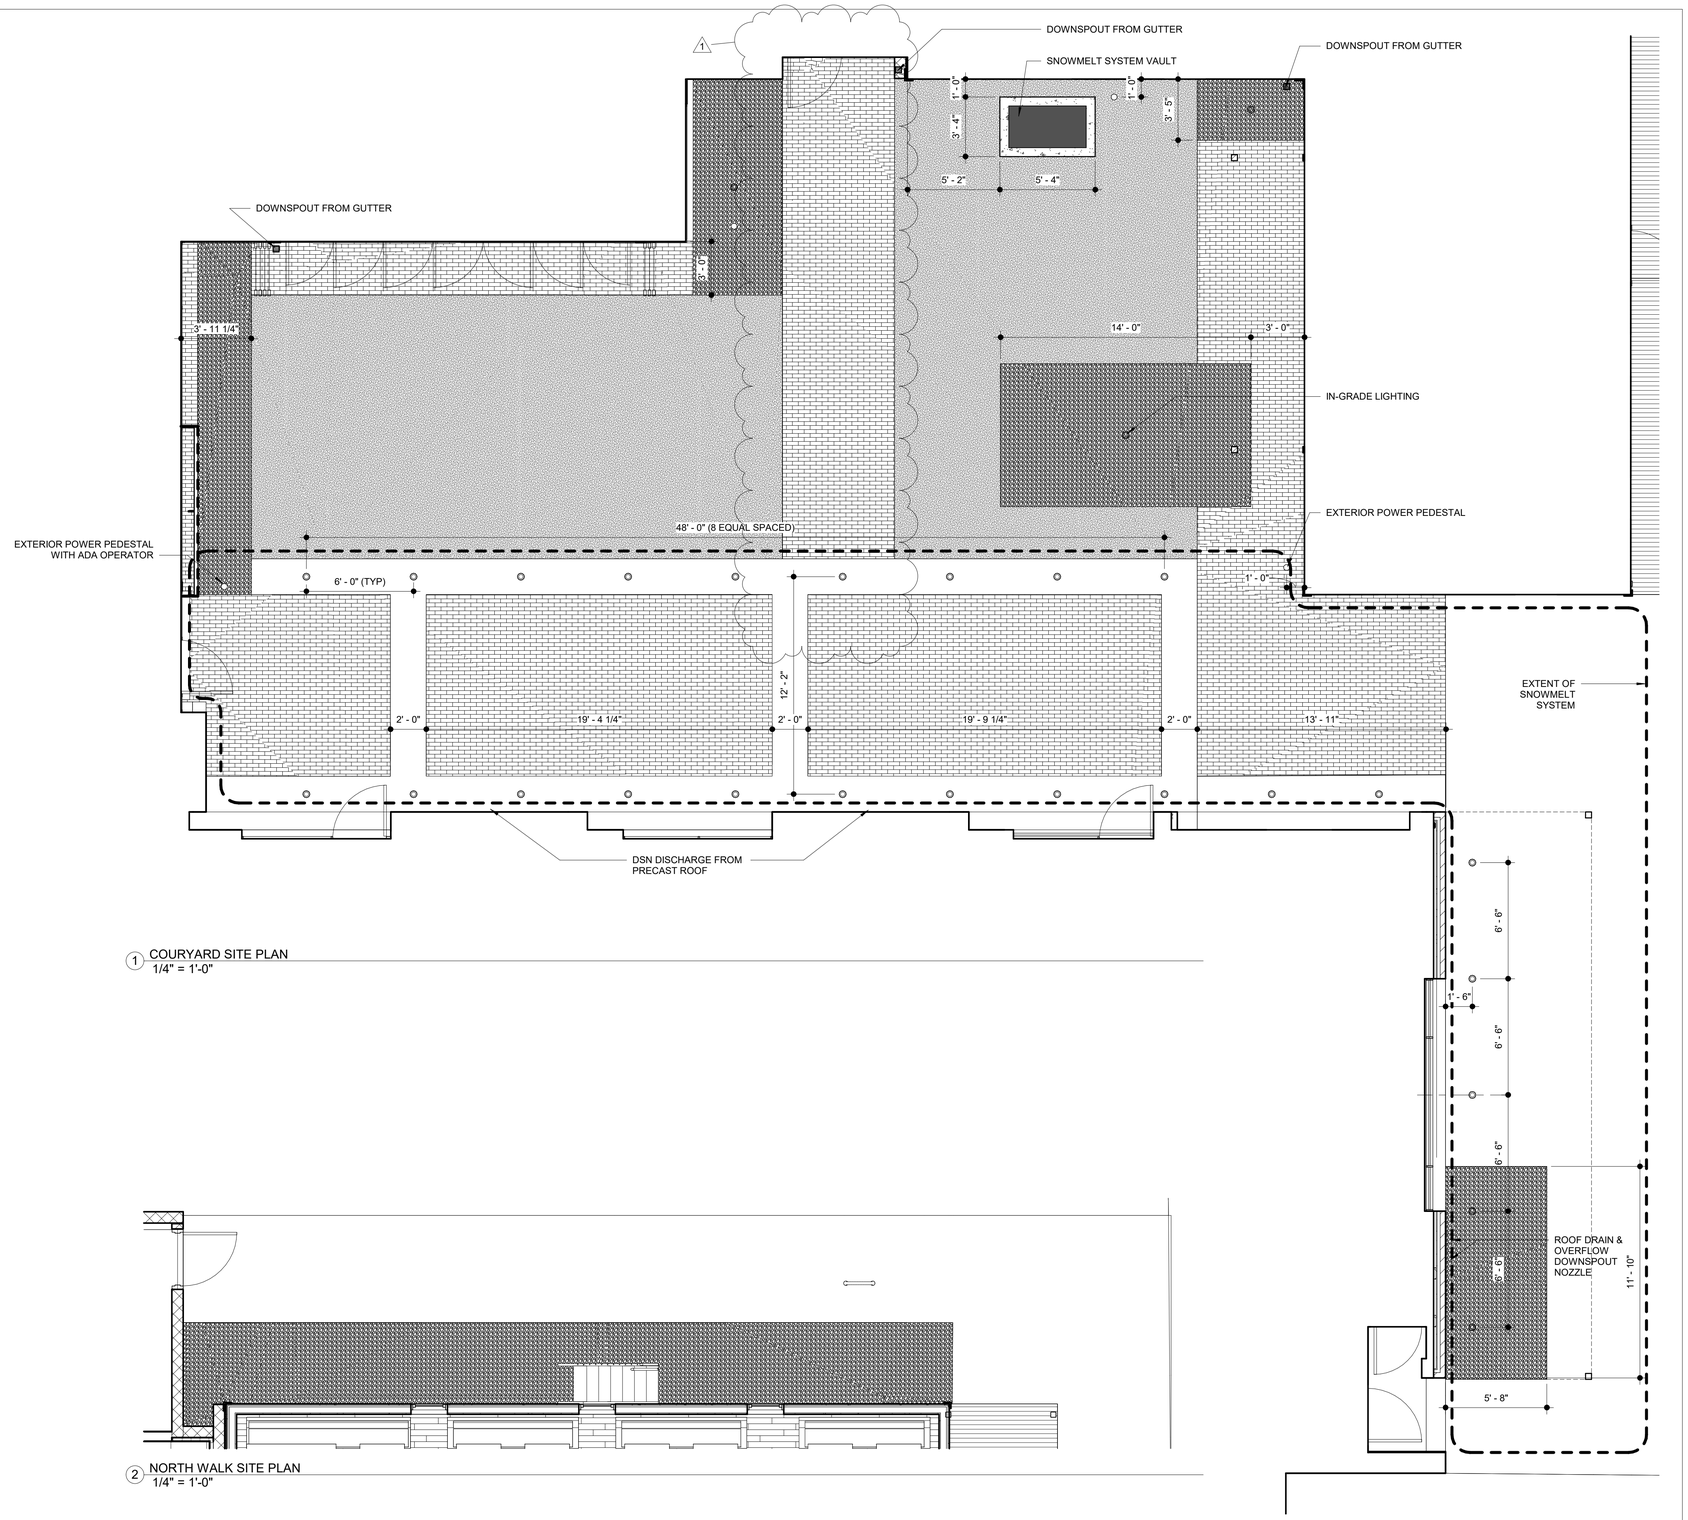

1 COURYARD SITE PLAN
1/4" = 1'-0"

2 NORTH WALK SITE PLAN
1/4" = 1'-0"

C:\Users\daniel\Documents\City Hotel-2024_1_dljpscomb74Cdl.rvt

4/22/2026 1:06:14 PM

HELTSHE

M1A MERIDIAN 105 ARCHITECTURE

CITY HOTEL
415 PERRY STREET, CASTLE ROCK, CO.

DATE: 4.22.2026	ISSUED FOR: PERMIT	SHEET TITLE: ENLARGED SITE PLANS	SHEET NUMBER A1.01
PROJ. NO. 2023.002			

TAKE-OFF LEGEND - A2.01 (partition schedule order)

- FI.2-0 - BOARD ONLY (WOOD FRAMING EXCLUDED) - 1 wall(s) - 40.03 LF
- XW.6.2-0 - BOARD ONLY (WOOD FRAMING EXCLUDED) - 1 wall(s) - 9.33 LF
- XW.6.2-2 - BOARD ONLY (WOOD FRAMING EXCLUDED) - 2 wall(s) - 19.82 LF
- XW.6.3-0 - BOARD ONLY (WOOD FRAMING EXCLUDED) - 2 wall(s) - 7.30 LF
- XW.6.3-2 - BOARD ONLY (WOOD FRAMING EXCLUDED) - 2 wall(s) - 38.48 LF
- XW.6.4-0 - BOARD ONLY (WOOD FRAMING EXCLUDED) - 1 wall(s) - 1.00 LF
- XW.6.4-2 - BOARD ONLY (WOOD FRAMING EXCLUDED) - 6 wall(s) - 13.88 LF

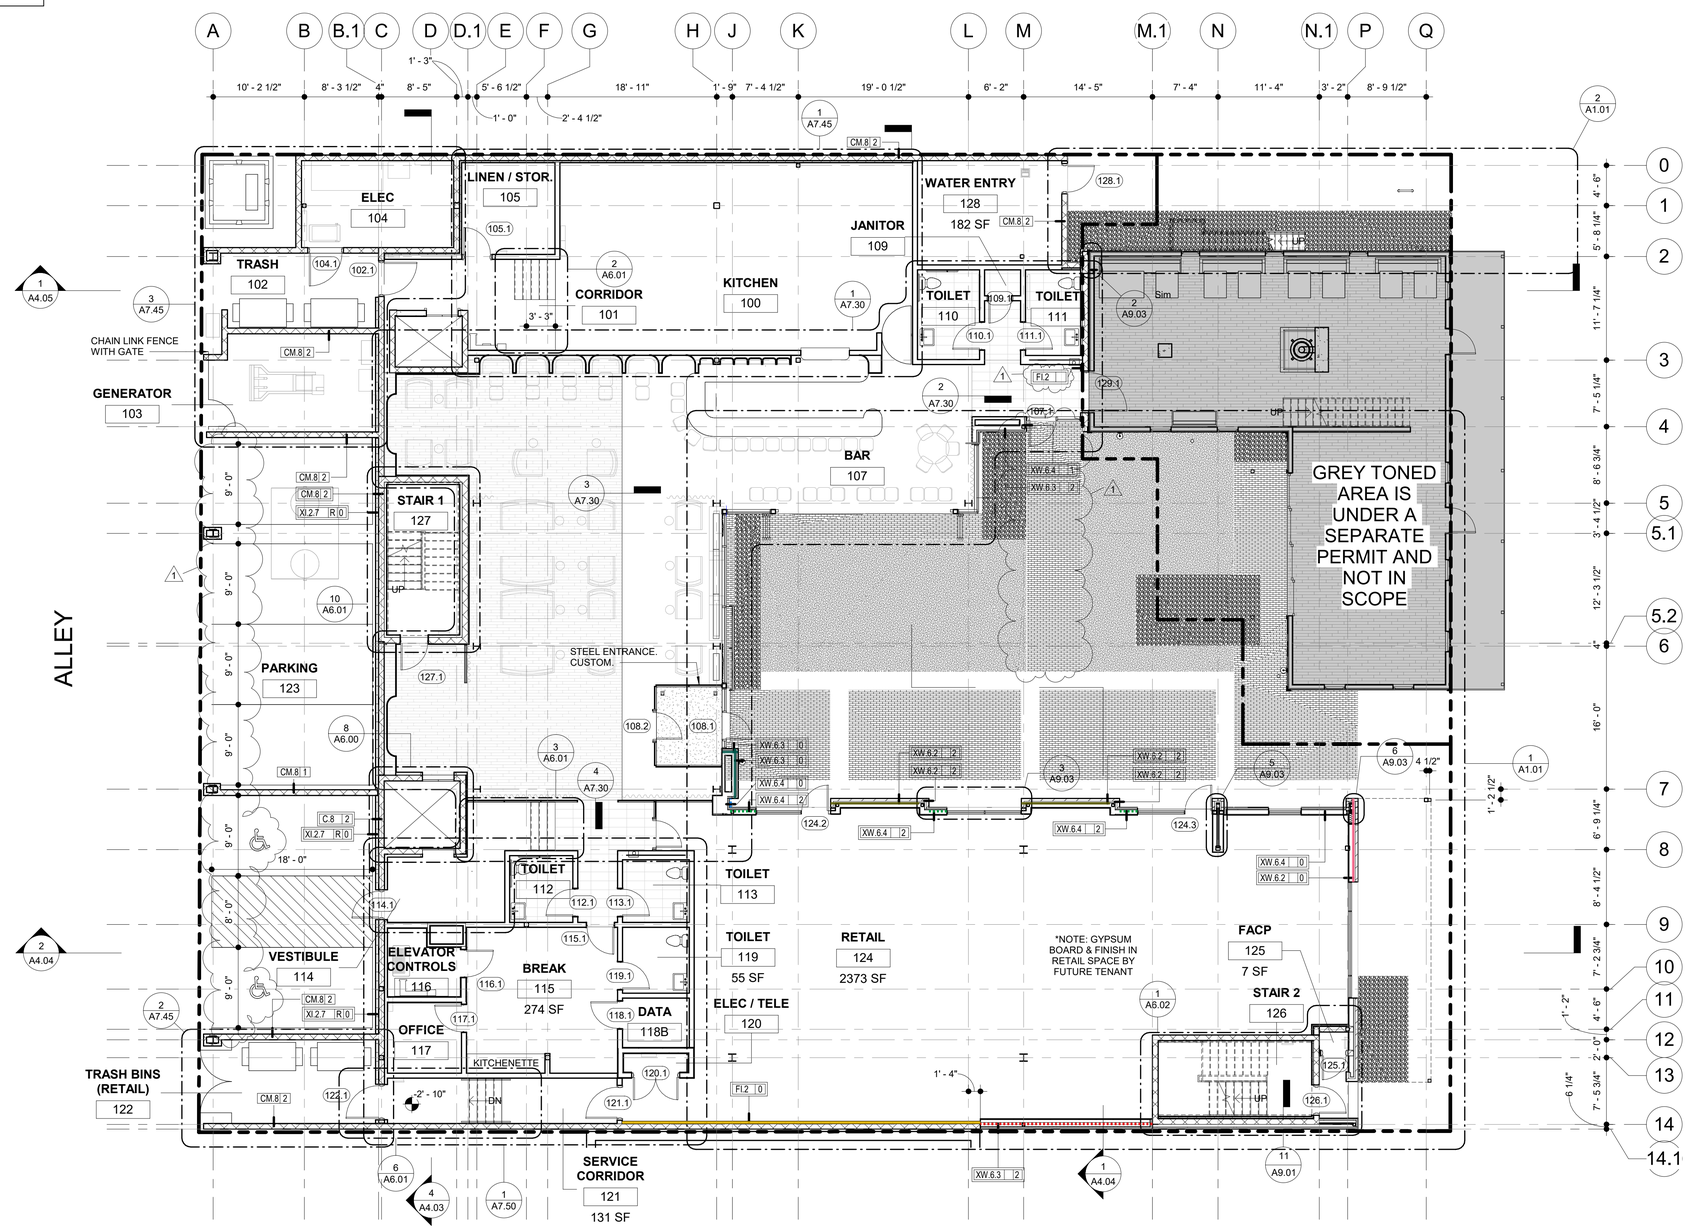

1 LEVEL 1
1/8" = 1'-0"

FLOOR PLAN - GENERAL NOTES

1. DIMENSIONS ARE TO FACE OF STUD/CMU TYP. UON.
2. WHEN "CLEAR" OR "FIN" IS CALLED OUT ON A DIMENSION, PROVIDE DIMENSION NOTED FROM FACE OF FINISH TO FACE OF FINISH.
3. DIMENSION FROM EDGE OF DOOR FRAME TO EDGE OF ADJACENT PERPENDICULAR WALL FINISH SHALL BE 4" UON.
4. PROVIDE WATER RESISTANT GYP BD AT TOILET AND LAVATORY AREAS. MAINTAIN FIRE RATING AT ALL PARTITIONS
5. FRAMING INSTALLER SHALL NOT RELY ON THE LOCATION OF IN-PLACE CONCRETE WHEN PLACING FRAMING AS THERE MAY BE TOLERANCE INACCURACY AND FLUCTUATIONS IN THE CONCRETE. INSTEAD, THE FRAMER SHALL LOCATE FRAMING RELATIVE TO GRID LINES.
6. WINDOW AND DOOR DIMENSIONS ARE TO CENTERLINE OF WINDOWS AND DOORS TYP UON.
7. REFER TO WALL ASSEMBLY PAGES FOR WALL ASSEMBLY INFO.
8. REFER TO CODE ANALYSIS SHEETS FOR EXITING INFO.
9. REFER TO ACCESSABILITY STANDARDS FOR ACCESSABILITY NOTES
10. REFER TO ENLARGED PLANS FOR DETAILED DIMENSIONS, NOTES, WALL & DOOR TAGS.

INTERIOR WALL ASSEMBLIES - LEGEND

1. REFERENCE LEGEND, RE: FLOOR PLANS

W.6 | 1

PARTITION TYPE -
- FIRST POSITION INDICATES INTERIOR PARTITION TYPE AND MATERIAL DESIGNATION.
- SECOND POSITION INDICATES RELATIVE WIDTH OF PARTITION.
- THIRD POSITION INDICATES FIRE RATING.

W.6 | 1

DOUBLE LINES INDICATES ACOUSTICAL PARTITION - IDENTICAL TO DESIGNATED PARTITION TYPE EXCEPT WITH ACOUSTICAL INSULATION AND ACOUSTICAL SEALANT AT PERIMETER AND PENETRATIONS.

PARTITION - PARTITION REFERENCE SYMBOL IS ORIENTED TO DENOTED PARTITION ON SAME SIDE AS DELINEATED IN PARTITION DETAIL.

EXTERIOR WALL ASSEMBLIES - LEGEND

1. REFERENCE LEGEND, RE: FLOOR PLANS

XM.6.12 R 1

PARTITION TYPE -
- FIRST POSITION INDICATES EXTERIOR PARTITION TYPE AND MATERIAL DESIGNATION.
- SECOND POSITION INDICATES STUD WIDTH.
- THIRD POSITION INDICATES FINISH MATERIAL.
- "R" AFTER THIRD POSITION INDICATES CONTINUOUS RIGID INSULATION REQUIRED.
- FOURTH POSITION INDICATES FIRE RATING IN HOURS.

XM.6.12 R 1

DOUBLE LINES INDICATE PARTITIONS WHICH SHALL INCORPORATE THE INSULATION REQUIREMENTS NOTED IN THE WALL TYPE DETAILS. ADDITIONALLY, THESE PARTITIONS INCORPORATE ACOUSTICAL SEALANT AT PERIMETER AND PENETRATIONS.

PARTITION - PARTITION REFERENCE SYMBOL IS ORIENTED TO DENOTED PARTITION ON SAME SIDE AS DELINEATED IN PARTITION DETAIL.

2. FINISH MATERIALS

.1	NO FINISH
.2	BRICK
.3	WOOD - GREY
.4	WOOD - BLACK
.5	WOOD W/VERTICAL BATTENS - BLACK
.6	FRT WOOD W/VERTICAL BATTENS - BLACK
.7	FRP (FIBER-REINFORCED PLASTIC)
.8	WOOD - WHITE

C:\Users\daniel\Documents\City Hotel-2024_1_dlipscomb74Cdl.rvt

4/22/2026 1:06:20 PM

HELTSHE

M1A MERIDIAN 105 ARCHITECTURE

CITY HOTEL
415 PERRY STREET, CASTLE ROCK, CO.

DATE: 4.22.2026	ISSUED FOR: PERMIT	SHEET TITLE: LVL 1	SHEET NUMBER A2.01
PROJ. NO. 2023.002			

TAKE-OFF LEGEND - A2.02 (partition schedule order)

- CH.6-2 - BOARD ONLY (WOOD FRAMING EXCLUDED) - 14 wall(s) - 49.12 LF
- DW.4-1 - BOARD ONLY (WOOD FRAMING EXCLUDED) - 24 wall(s) - 507.87 LF
- FI.2-0 - BOARD ONLY (WOOD FRAMING EXCLUDED) - 2 wall(s) - 25.64 LF
- FI.6-0 - BOARD ONLY (WOOD FRAMING EXCLUDED) - 3 wall(s) - 86.17 LF
- FW.2-0 - BOARD ONLY (WOOD FRAMING EXCLUDED) - 16 wall(s) - 136.61 LF
- FW.4-0 - BOARD ONLY (WOOD FRAMING EXCLUDED) - 42 wall(s) - 156.60 LF
- FW.6-0 - BOARD ONLY (WOOD FRAMING EXCLUDED) - 3 wall(s) - 28.95 LF
- W.4-0 - BOARD ONLY (WOOD FRAMING EXCLUDED) - 96 wall(s) - 625.76 LF
- W.6-0 - BOARD ONLY (WOOD FRAMING EXCLUDED) - 3 wall(s) - 12.27 LF
- W.6-1 - BOARD ONLY (WOOD FRAMING EXCLUDED) - 1 wall(s) - 5.04 LF
- W.62-1 - BOARD ONLY (WOOD FRAMING EXCLUDED) - 34 wall(s) - 651.90 LF
- XW.6.3-0 - BOARD ONLY (WOOD FRAMING EXCLUDED) - 1 wall(s) - 65.99 LF
- XW.6.3-2 - BOARD ONLY (WOOD FRAMING EXCLUDED) - 21 wall(s) - 664.27 LF
- XW.6.4-0 - BOARD ONLY (WOOD FRAMING EXCLUDED) - 1 wall(s) - 19.43 LF
- XW.6.4-2 - BOARD ONLY (WOOD FRAMING EXCLUDED) - 2 wall(s) - 50.98 LF
- XW.6.6-1 - BOARD ONLY (WOOD FRAMING EXCLUDED) - 6 wall(s) - 64.34 LF

TAKE-OFF LEGEND - A2.02 (gypsum board ceilings / soffits)

blue area = gyp bd ceiling / soffit: 3 areas, 34.10 SF (Contents: board · ceiling tag · room · SF · ceiling height · detail · id)

measure: /Measure at the printed scale of the sheet; SF = Excel row (ceiling id)

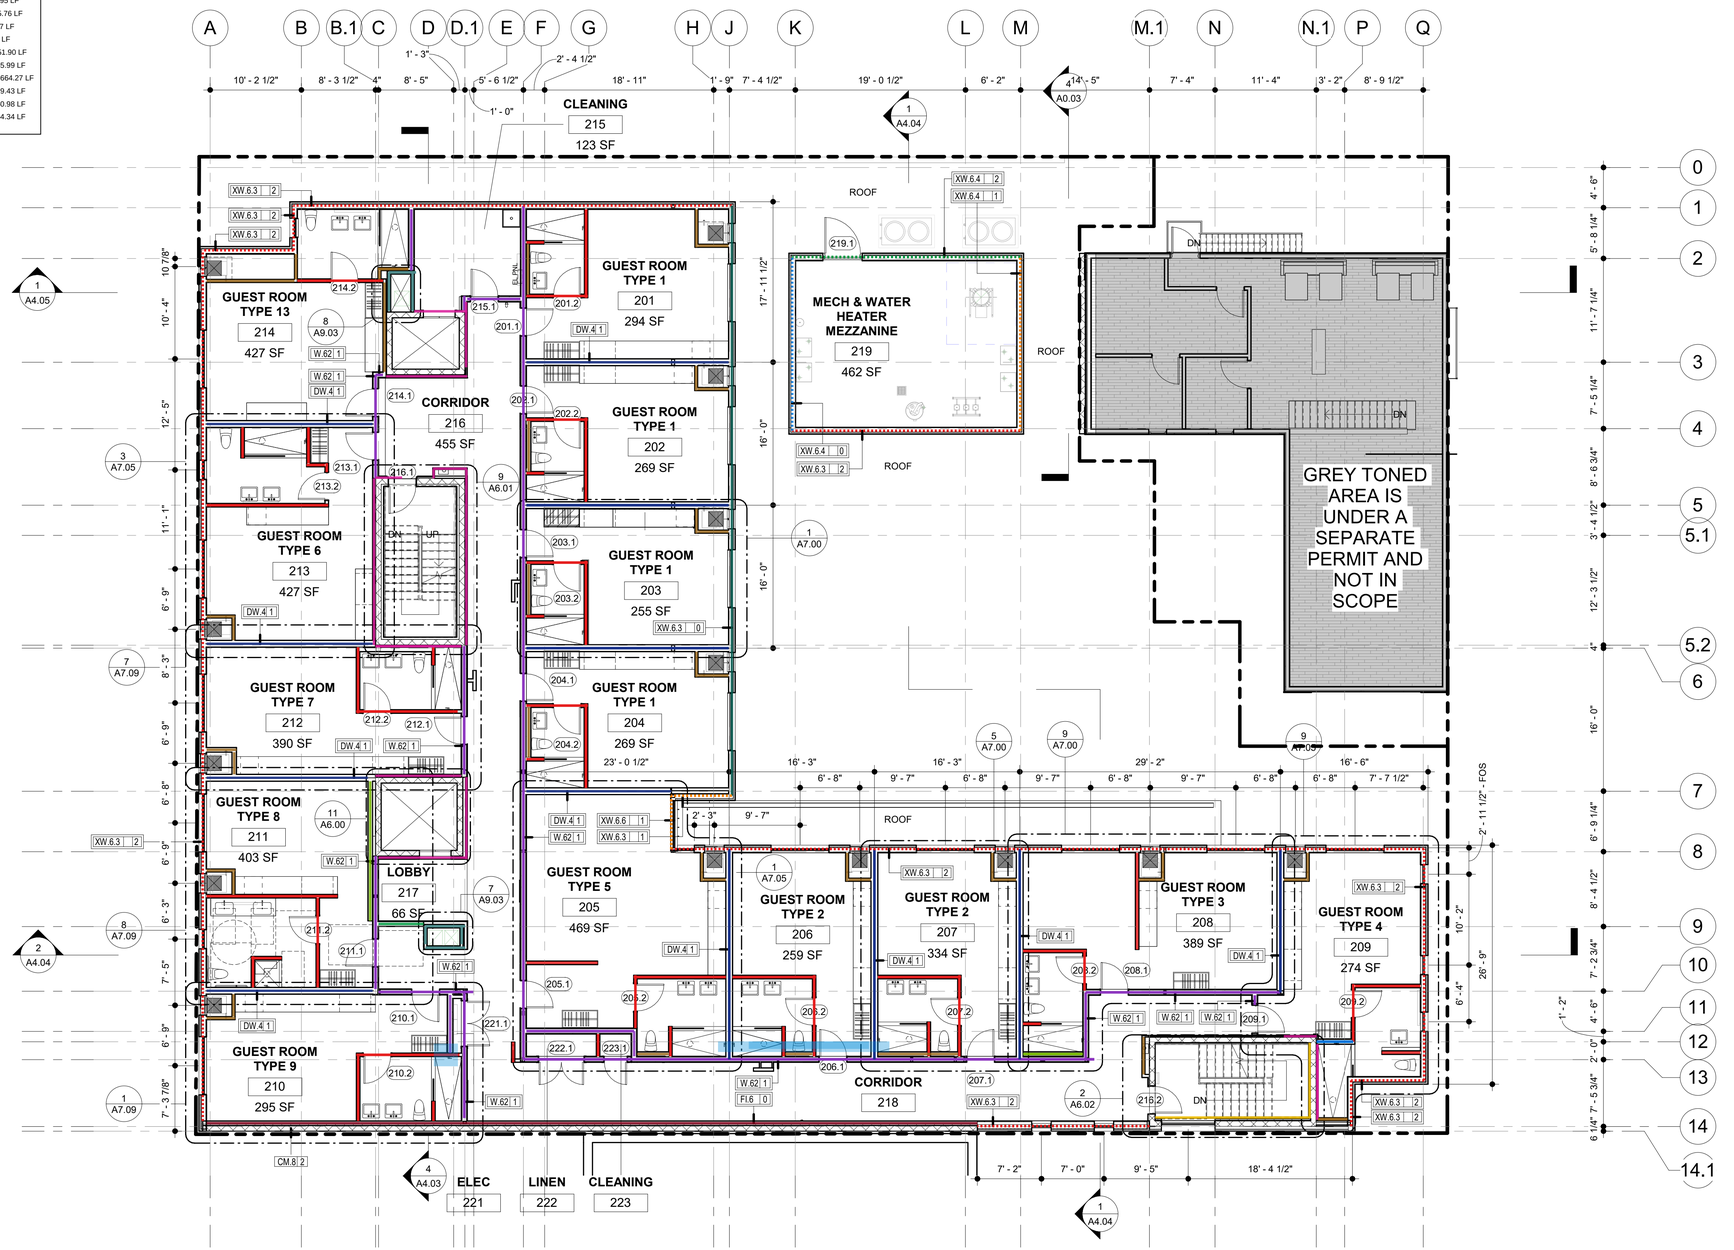

1 LEVEL 2
1/8" = 1'-0"

FLOOR PLAN - GENERAL NOTES

1. DIMENSIONS ARE TO FACE OF STUD/CMU TYP. UON.
2. WHEN "CLEAR" OR "FIN" IS CALLED OUT ON A DIMENSION, PROVIDE DIMENSION NOTED FROM FACE OF FINISH TO FACE OF FINISH.
3. DIMENSION FROM EDGE OF DOOR FRAME TO EDGE OF ADJACENT PERPENDICULAR WALL FINISH SHALL BE 4" UON.
4. PROVIDE WATER RESISTANT GYP BD AT TOILET AND LAVATORY AREAS. MAINTAIN FIRE RATING AT ALL PARTITIONS
5. FRAMING INSTALLER SHALL NOT RELY ON THE LOCATION OF IN-PLACE CONCRETE WHEN PLACING FRAMING AS THERE MAY BE TOLERANCE INACCURACY AND FLUCTUATIONS IN THE CONCRETE. INSTEAD, THE FRAMER SHALL LOCATE FRAMING RELATIVE TO GRID LINES.
6. WINDOW AND DOOR DIMENSIONS ARE TO CENTERLINE OF WINDOWS AND DOORS TYP UON.
7. REFER TO WALL ASSEMBLY PAGES FOR WALL ASSEMBLY INFO.
8. REFER TO CODE ANALYSIS SHEETS FOR EXITING INFO.
9. REFER TO ACCESSABILITY STANDARDS FOR ACCESSABILITY NOTES
10. REFER TO ENLARGED PLANS FOR DETAILED DIMENSIONS, NOTES, WALL & DOOR TAGS.

INTERIOR WALL ASSEMBLIES - LEGEND

1. REFERENCE LEGEND, RE: FLOOR PLANS

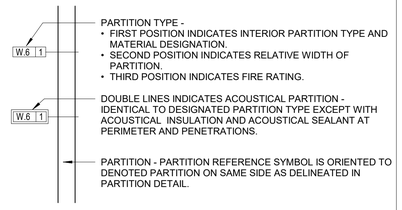

PARTITION TYPE -
- FIRST POSITION INDICATES INTERIOR PARTITION TYPE AND MATERIAL DESIGNATION.
- SECOND POSITION INDICATES RELATIVE WIDTH OF PARTITION.
- THIRD POSITION INDICATES FIRE RATING.

DOUBLE LINES INDICATES ACOUSTICAL PARTITION - IDENTICAL TO DESIGNATED PARTITION TYPE EXCEPT WITH ACOUSTICAL INSULATION AND ACOUSTICAL SEALANT AT PERIMETER AND PENETRATIONS.

PARTITION - PARTITION REFERENCE SYMBOL IS ORIENTED TO DENOTED PARTITION ON SAME SIDE AS DELINEATED IN PARTITION DETAIL.

EXTERIOR WALL ASSEMBLIES - LEGEND

1. REFERENCE LEGEND, RE: FLOOR PLANS

PARTITION TYPE -
- FIRST POSITION INDICATES EXTERIOR PARTITION TYPE AND MATERIAL DESIGNATION.
- SECOND POSITION INDICATES STUD WIDTH.
- THIRD POSITION INDICATES FINISH MATERIAL.
- "R" AFTER THIRD POSITION INDICATES CONTINUOUS RIGID INSULATION REQUIRED.
- FOURTH POSITION INDICATES FIRE RATING IN HOURS.

DOUBLE LINES INDICATE PARTITIONS WHICH SHALL INCORPORATE THE INSULATION REQUIREMENTS NOTED IN THE WALL TYPE DETAILS. ADDITIONALLY, THESE PARTITIONS INCORPORATE ACOUSTICAL SEALANT AT PERIMETER AND PENETRATIONS.

PARTITION - PARTITION REFERENCE SYMBOL IS ORIENTED TO DENOTED PARTITION ON SAME SIDE AS DELINEATED IN PARTITION DETAIL.

2. FINISH MATERIALS

- .1 NO FINISH
- .2 BRICK
- .3 WOOD - GREY
- .4 WOOD - BLACK
- .5 WOOD W/VERTICAL BATTENS - BLACK
- .6 FRT WOOD W/VERTICAL BATTENS - BLACK
- .7 FRP (FIBER-REINFORCED PLASTIC)
- .8 WOOD - WHITE

C:\Users\daniel\Documents\City Hotel-2024_1_dlipscomb74CJ8.rvt

4/22/2026 1:06:25 PM

HELTSHE | M1A MERIDIAN 105 ARCHITECTURE

CITY HOTEL
415 PERRY STREET, CASTLE ROCK, CO.

DATE: 4.22.2026	ISSUED FOR: PERMIT	SHEET TITLE: LVL 2
PROJ. NO. 2023.002		

SHEET NUMBER
A2.02

TAKE-OFF LEGEND - A2.03 (partition schedule order)

- DW.4-1 - BOARD ONLY (WOOD FRAMING EXCLUDED) - 13 wall(s) - 248.08 LF
- FI.2-0 - BOARD ONLY (WOOD FRAMING EXCLUDED) - 2 wall(s) - 26.13 LF
- FI.6-0 - BOARD ONLY (WOOD FRAMING EXCLUDED) - 2 wall(s) - 85.44 LF
- FW.2-0 - BOARD ONLY (WOOD FRAMING EXCLUDED) - 13 wall(s) - 139.11 LF
- FW.4-0 - BOARD ONLY (WOOD FRAMING EXCLUDED) - 35 wall(s) - 118.95 LF
- FW.6-0 - BOARD ONLY (WOOD FRAMING EXCLUDED) - 13 wall(s) - 71.33 LF
- W.4-0 - BOARD ONLY (WOOD FRAMING EXCLUDED) - 96 wall(s) - 595.03 LF
- W.6-0 - BOARD ONLY (WOOD FRAMING EXCLUDED) - 3 wall(s) - 11.73 LF
- W.62-1 - BOARD ONLY (WOOD FRAMING EXCLUDED) - 36 wall(s) - 573.50 LF
- XW.6.3-0 - BOARD ONLY (WOOD FRAMING EXCLUDED) - 2 wall(s) - 73.01 LF
- XW.6.3-2 - BOARD ONLY (WOOD FRAMING EXCLUDED) - 18 wall(s) - 610.00 LF
- XW.6.6-0 - BOARD ONLY (WOOD FRAMING EXCLUDED) - 1 wall(s) - 5.78 LF

TAKE-OFF LEGEND - A2.03 (gypsum board ceilings / soffits)

blue area = gyp bd ceiling / soffit: 3 areas, 37.90 SF (Contents: board · ceiling tag · room · SF · ceiling height · detail · id)

measure: /Measure at the printed scale of the sheet; SF = Excel row (ceiling id)

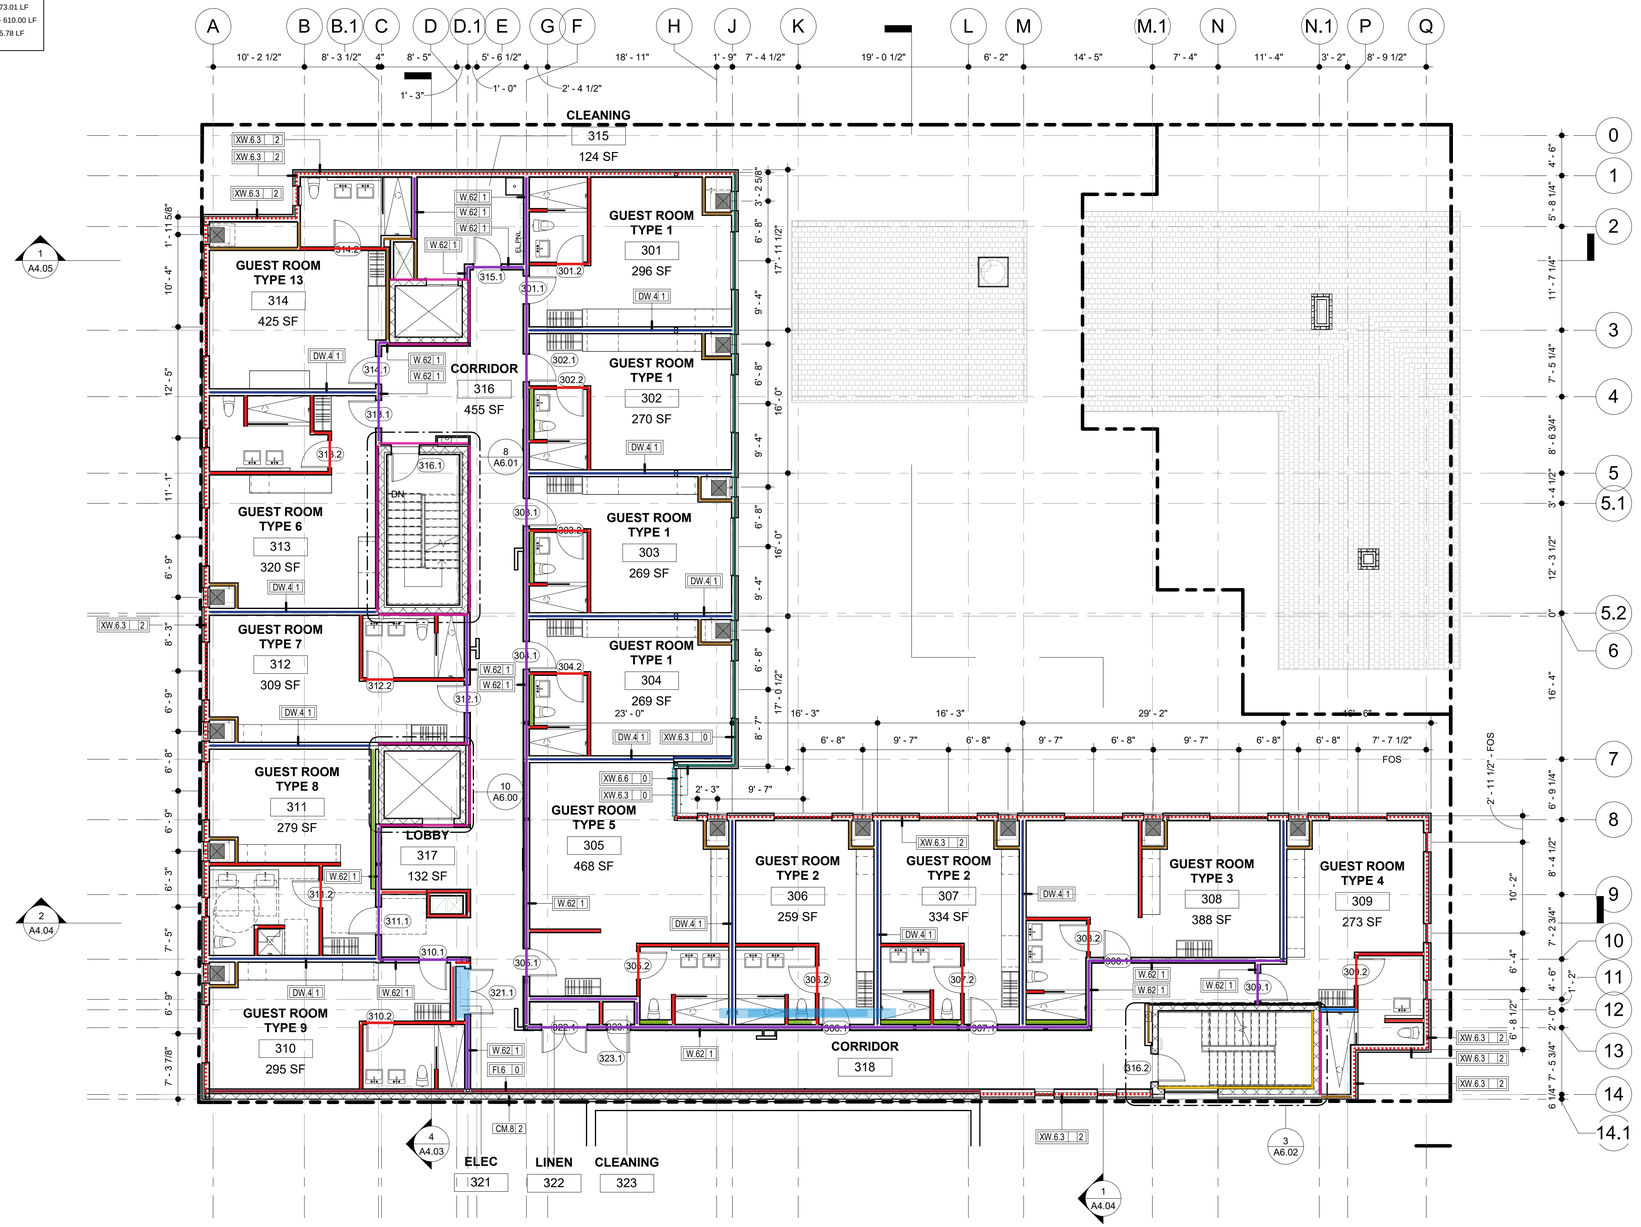

1 LEVEL 3
1/8" = 1'-0"

FLOOR PLAN - GENERAL NOTES

1. DIMENSIONS ARE TO FACE OF STUD/CMU TYP. UON.
2. WHEN "CLEAR" OR "FIN" IS CALLED OUT ON A DIMENSION, PROVIDE DIMENSION NOTED FROM FACE OF FINISH TO FACE OF FINISH.
3. DIMENSION FROM EDGE OF DOOR FRAME TO EDGE OF ADJACENT PERPENDICULAR WALL FINISH SHALL BE 4" UON.
4. PROVIDE WATER RESISTANT GYP BD AT TOILET AND LAVATORY AREAS. MAINTAIN FIRE RATING AT ALL PARTITIONS
5. FRAMING INSTALLER SHALL NOT RELY ON THE LOCATION OF IN-PLACE CONCRETE WHEN PLACING FRAMING AS THERE MAY BE TOLERANCE INACCURACY AND FLUCTUATIONS IN THE CONCRETE. INSTEAD, THE FRAMER SHALL LOCATE FRAMING RELATIVE TO GRID LINES.
6. WINDOW AND DOOR DIMENSIONS ARE TO CENTERLINE OF WINDOWS AND DOORS TYP UON.
7. REFER TO WALL ASSEMBLY PAGES FOR WALL ASSEMBLY INFO.
8. REFER TO CODE ANALYSIS SHEETS FOR EXITING INFO.
9. REFER TO ACCESSABILITY STANDARDS FOR ACCESSABILITY NOTES
10. REFER TO ENLARGED PLANS FOR DETAILED DIMENSIONS, NOTES, WALL & DOOR TAGS.

INTERIOR WALL ASSEMBLIES - LEGEND

1. REFERENCE LEGEND, RE: FLOOR PLANS

PARTITION TYPE -
- FIRST POSITION INDICATES INTERIOR PARTITION TYPE AND MATERIAL DESIGNATION.
- SECOND POSITION INDICATES RELATIVE WIDTH OF PARTITION.
- THIRD POSITION INDICATES FIRE RATING.

DOUBLE LINES INDICATES ACOUSTICAL PARTITION - IDENTICAL TO DESIGNATED PARTITION TYPE EXCEPT WITH ACOUSTICAL INSULATION AND ACOUSTICAL SEALANT AT PERIMETER AND PENETRATIONS.

PARTITION - PARTITION REFERENCE SYMBOL IS ORIENTED TO DENOTED PARTITION ON SAME SIDE AS DELINEATED IN PARTITION DETAIL.

EXTERIOR WALL ASSEMBLIES - LEGEND

1. REFERENCE LEGEND, RE: FLOOR PLANS

PARTITION TYPE -
- FIRST POSITION INDICATES EXTERIOR PARTITION TYPE AND MATERIAL DESIGNATION.
- SECOND POSITION INDICATES STUD WIDTH.
- THIRD POSITION INDICATES FINISH MATERIAL.
- "R" AFTER THIRD POSITION INDICATES CONTINUOUS RIGID INSULATION REQUIRED.
- FOURTH POSITION INDICATES FIRE RATING IN HOURS.

DOUBLE LINES INDICATE PARTITIONS WHICH SHALL INCORPORATE THE INSULATION REQUIREMENTS NOTED IN THE WALL TYPE DETAILS. ADDITIONALLY, THESE PARTITIONS INCORPORATE ACOUSTICAL SEALANT AT PERIMETER AND PENETRATIONS.

PARTITION - PARTITION REFERENCE SYMBOL IS ORIENTED TO DENOTED PARTITION ON SAME SIDE AS DELINEATED IN PARTITION DETAIL.

2. FINISH MATERIALS

.1 NO FINISH
.2 BRICK
.3 WOOD - GREY
.4 WOOD - BLACK
.5 WOOD W/VERTICAL BATTENS - BLACK
.6 FRT WOOD W/VERTICAL BATTENS - BLACK
.7 FRP (FIBER-REINFORCED PLASTIC)
.8 WOOD - WHITE

C:\Users\daniel\Documents\City Hotel-2024_1_dlhjxscomb74CJ8.rvt

4/22/2026 1:06:31 PM

HELTSHE

M1A MERIDIAN 105 ARCHITECTURE

CITY HOTEL
415 PERRY STREET, CASTLE ROCK, CO.

DATE: 4.22.2026	ISSUED FOR: PERMIT	SHEET TITLE: LVL 3
PROJ. NO. 2023.002		

SHEET NUMBER
A2.03

TAKE-OFF LEGEND - A2.04 (partition schedule order)

- DW.4-1 - BOARD ONLY (WOOD FRAMING EXCLUDED) - 10 wall(s) - 169.94 LF
- FI.6-0 - BOARD ONLY (WOOD FRAMING EXCLUDED) - 1 wall(s) - 60.64 LF
- FW.2-0 - BOARD ONLY (WOOD FRAMING EXCLUDED) - 11 wall(s) - 110.02 LF
- FW.4-0 - BOARD ONLY (WOOD FRAMING EXCLUDED) - 16 wall(s) - 80.19 LF
- FW.6-0 - BOARD ONLY (WOOD FRAMING EXCLUDED) - 5 wall(s) - 48.98 LF
- W.4-0 - BOARD ONLY (WOOD FRAMING EXCLUDED) - 33 wall(s) - 248.55 LF
- W.6-0 - BOARD ONLY (WOOD FRAMING EXCLUDED) - 3 wall(s) - 8.79 LF
- W.6-1 - BOARD ONLY (WOOD FRAMING EXCLUDED) - 2 wall(s) - 6.82 LF
- W.62-1 - BOARD ONLY (WOOD FRAMING EXCLUDED) - 18 wall(s) - 237.07 LF
- XW.6.6-0 - BOARD ONLY (WOOD FRAMING EXCLUDED) - 6 wall(s) - 76.51 LF
- XW.6.6-1 - BOARD ONLY (WOOD FRAMING EXCLUDED) - 2 wall(s) - 21.56 LF
- XW.6.6-2 - BOARD ONLY (WOOD FRAMING EXCLUDED) - 27 wall(s) - 404.69 LF

TAKE-OFF LEGEND - A2.04 (gypsum board ceilings / soffits)

blue area = gyp bd ceiling / soffit: 1 areas, 151.85 SF (Contents: board · ceiling tag · room · SF · ceiling height · detail · id)

measure: /Measure at the printed scale of the sheet; SF = Excel row (ceiling id)

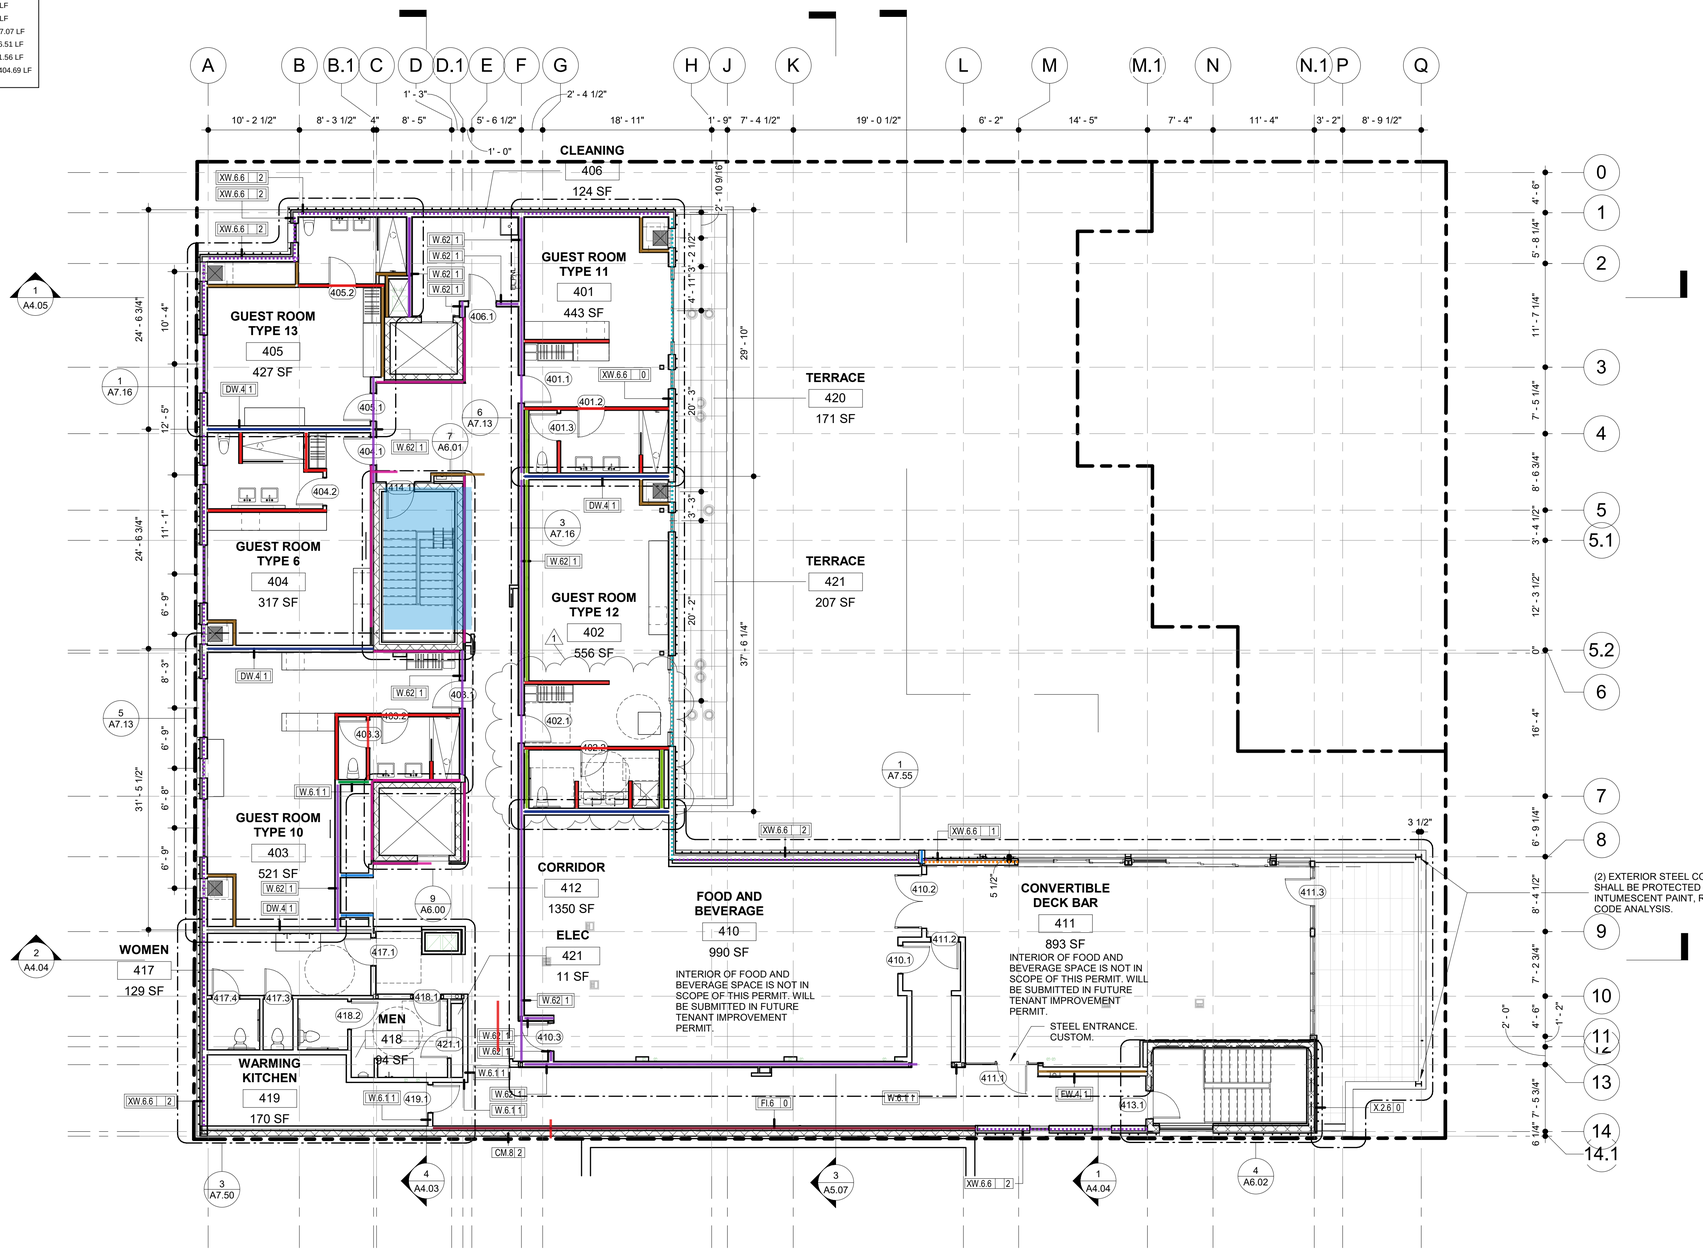

1 LEVEL 4
1/8" = 1'-0"

FLOOR PLAN - GENERAL NOTES

1. DIMENSIONS ARE TO FACE OF STUD/CMU TYP. UON.
2. WHEN "CLEAR" OR "FIN" IS CALLED OUT ON A DIMENSION, PROVIDE DIMENSION NOTED FROM FACE OF FINISH TO FACE OF FINISH.
3. DIMENSION FROM EDGE OF DOOR FRAME TO EDGE OF ADJACENT PERPENDICULAR WALL FINISH SHALL BE 4" UON.
4. PROVIDE WATER RESISTANT GYP BD AT TOILET AND LAVATORY AREAS. MAINTAIN FIRE RATING AT ALL PARTITIONS
5. FRAMING INSTALLER SHALL NOT RELY ON THE LOCATION OF IN-PLACE CONCRETE WHEN PLACING FRAMING AS THERE MAY BE TOLERANCE INACCURACY AND FLUCTUATIONS IN THE CONCRETE. INSTEAD, THE FRAMER SHALL LOCATE FRAMING RELATIVE TO GRID LINES.
6. WINDOW AND DOOR DIMENSIONS ARE TO CENTERLINE OF WINDOWS AND DOORS TYP UON.
7. REFER TO WALL ASSEMBLY PAGES FOR WALL ASSEMBLY INFO.
8. REFER TO CODE ANALYSIS SHEETS FOR EXITING INFO.
9. REFER TO ACCESSABILITY STANDARDS FOR ACCESSABILITY NOTES
10. REFER TO ENLARGED PLANS FOR DETAILED DIMENSIONS, NOTES, WALL & DOOR TAGS.

INTERIOR WALL ASSEMBLIES - LEGEND

1. REFERENCE LEGEND, RE: FLOOR PLANS

EXTERIOR WALL ASSEMBLIES - LEGEND

1. REFERENCE LEGEND, RE: FLOOR PLANS

2. FINISH MATERIALS

.1 NO FINISH
.2 BRICK
.3 WOOD - GREY
.4 WOOD - BLACK
.5 WOOD W/VERTICAL BATTENS - BLACK
.6 FRT WOOD W/VERTICAL BATTENS - BLACK
.7 FRP (FIBER-REINFORCED PLASTIC)
.8 WOOD - WHITE

C:\Users\daniel\Documents\City Hotel-2024_1_dlipscomb74CJB.rvt

4/22/2026 1:06:37 PM

HELTSHE | M1A MERIDIAN 105 ARCHITECTURE

CITY HOTEL
415 PERRY STREET, CASTLE ROCK, CO.

DATE: 4.22.2026
PROJ. NO. 2023.002
ISSUED FOR: PERMIT
SHEET TITLE: LVL 4

SHEET NUMBER
A2.04

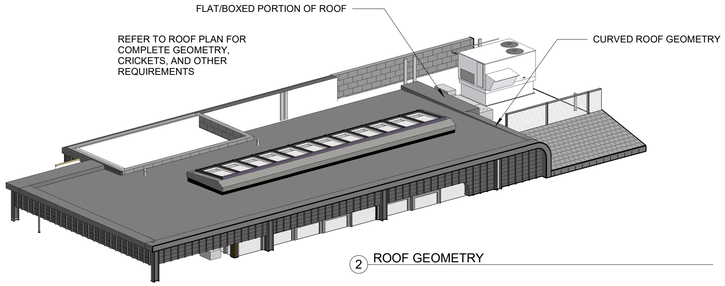

2 ROOF GEOMETRY

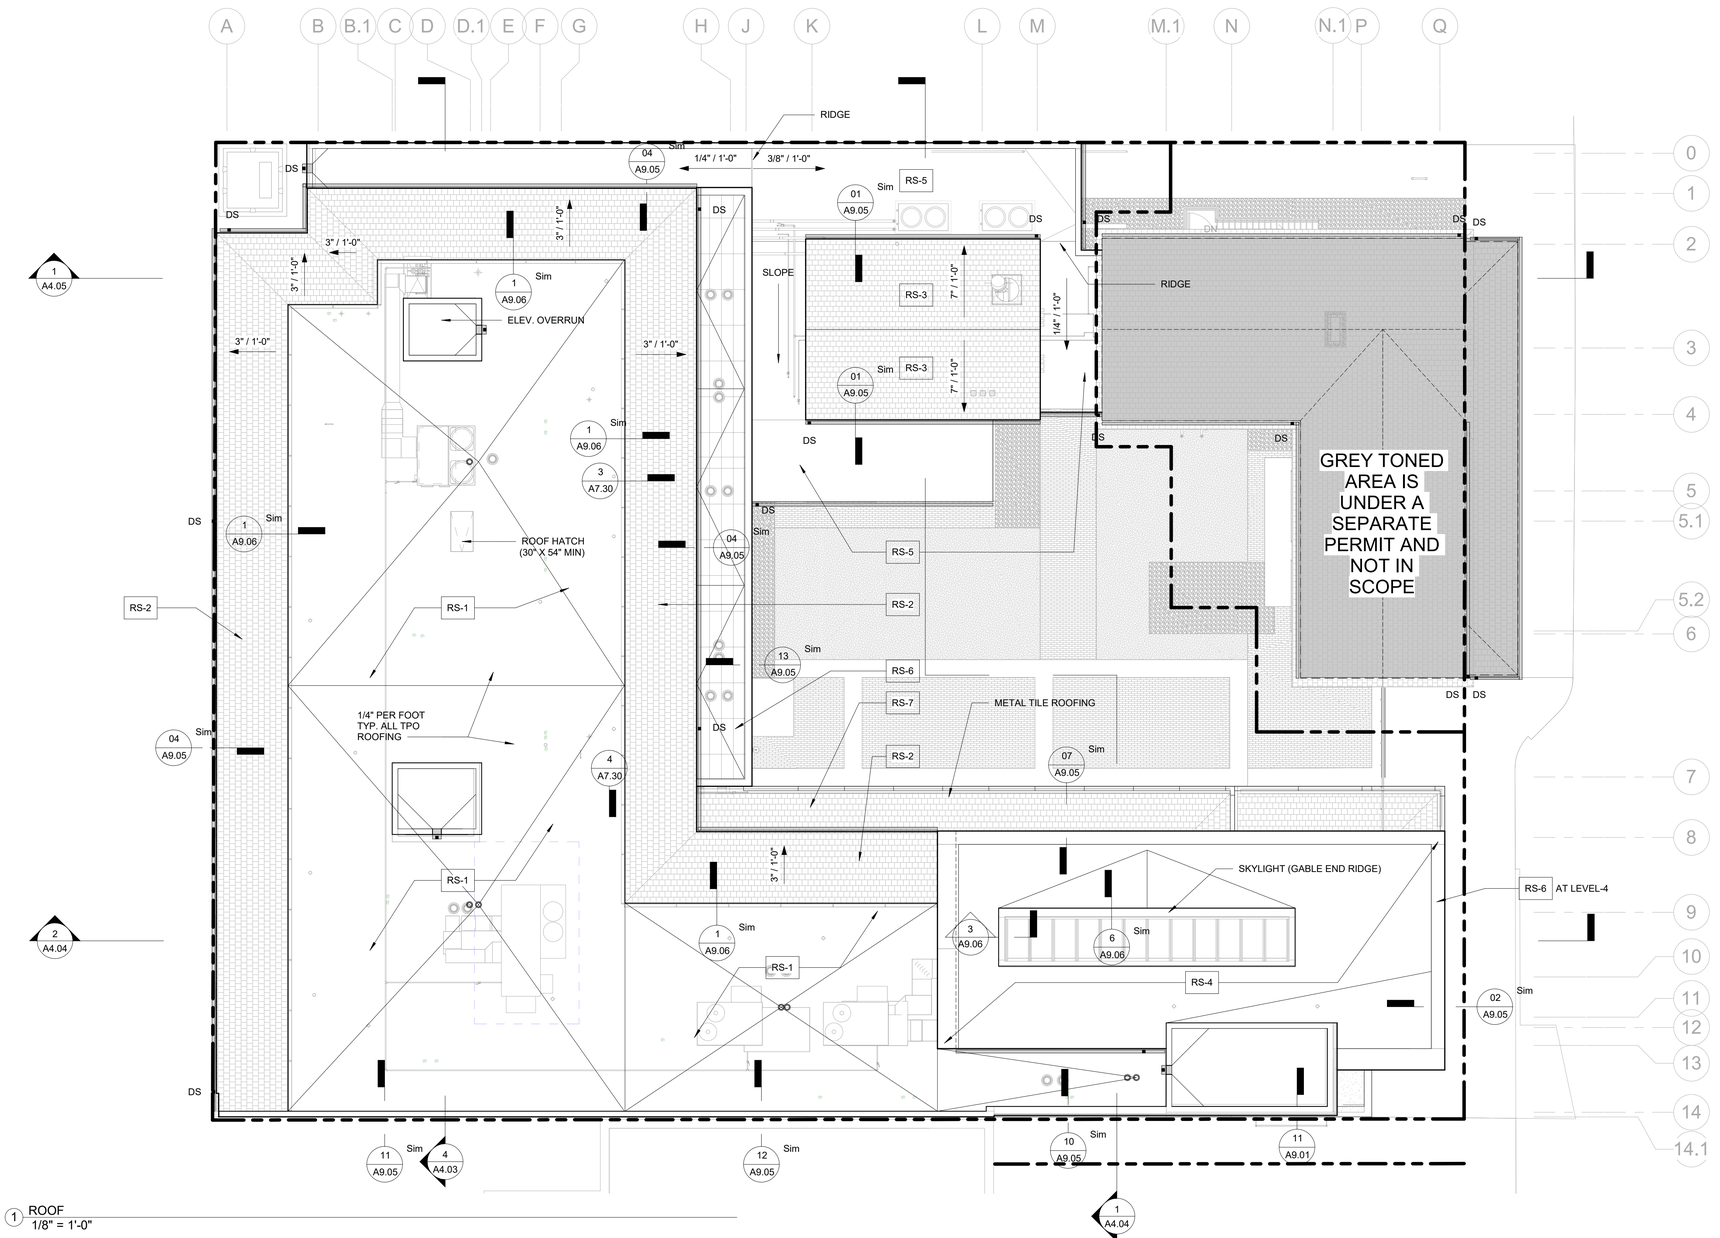

1 ROOF
1/8" = 1'-0"

ROOF PLAN - GENERAL NOTES

1. ROOF SLOPE INDICATED THUS:
2. SLOPES SHOWN REPRESENT THE MINIMUM SLOPE ALLOWED. STRUCTURE SLOPES AT 3/8" PER FOOT, UON.
3. PROVIDE TAPERED INSULATION AS SHOWN AND AS REQUIRED AT ALL ROOF AREAS TO PROVIDE POSITIVE DRAINAGE THROUGHOUT. THE MINIMUM SLOPE ALLOWED IN THE *VALLEY* SHALL BE 1/4" PER FOOT.
4. ALL ROOF PENETRATIONS SHALL BE A MINIMUM OF 3'-0" CLEAR FROM FACE OF PARAPETS, CURBS, WALLS AND VALLEYS UON.
5. PROVIDE PRESERVATIVE TREATED WOOD BLOCKING AS REQUIRED BY MANUFACTURER AND AS SHOWN IN THE DOCUMENTS FOR FASTENING THE ROOF TYP UON.
6. PROVIDE EXTERIOR GRADE FIRE-RETARDANT TREATED PLYWOOD SHEATHING AT THE BACKSIDE OF STUD PARAPETS TYP UON.
7. COORDINATE ROOF DRAIN AND EQUIPMENT OPENING LOCATIONS WITH FINAL JOIST LAYOUT.
8. PROVIDE CRICKETS BEHIND ALL ROOF PENETRATIONS AND EQUIPMENT.
9. PROVIDE SPLASHBLOCK AT ALL DOWNSPOUTS DISCHARGING TO ROOF OR GRADE TYP.
10. PROVIDE 12" MIN CURBS (ABOVE FINISHED ROOF SURFACE) BENEATH ALL MECH EQUIPMENT.

ROOFING SYSTEM NOTES

RS-1 ROOF SYSTEM (RS-1)
- FULLY ADHERED TPO (WHITE) MEMBRANE SYSTEM
- ½" OVERLAY BOARD
- SLOPED ROOF TAPERS AS REQUIRED
- 6" BASE LAYER POLYISO RIGID INSULATION. (2) LAYERS 3" THICKNESS W/ STAGGERED JOINTS
- PLYWOOD SHEATHING, RE: STRUCT, HORIZONTAL ASSEMBLIES

RS-2 ROOF SYSTEM (RS-2)
- COATED STEEL SHINGLES
- UNDERLAYMENT (ICE & WATER SHIELD ENTIRE SURFACE)
- PLYWOOD DECKING
- 4" BASE LAYER POLYISO RIGID INSULATION. (MIN R-20)
- VAPOR BARRIER
- ROOF SHEATHING, RE: STRUCT, HORIZONTAL ASSEMBLIES
- R-30 FIBERGLASS BATT INSULATION IN CAVITY

RS-3 ROOF SYSTEM (RS-3)
- COATED STEEL SHINGLES
- UNDERLAYMENT
- PLYWOOD DECKING
- 6" BASE LAYER POLYISO RIGID INSULATION. (2) LAYERS 3" THICKNESS W/ STAGGERED JOINTS
- VAPOR BARRIER
- ROOF SHEATHING, RE: STRUCT, HORIZONTAL ASSEMBLIES

RS-4 ROOF SYSTEM (RS-4)
- FULLY ADHERED TPO (WHITE) MEMBRANE SYSTEM
- ½" OVERLAY BOARD
- SLOPED ROOF TAPERS AS REQUIRED
- 3" BASE LAYER POLYISO RIGID INSULATION.
- PLYWOOD SHEATHING, RE: STRUCT, HORIZONTAL ASSEMBLIES
- 3" CLOSED-CELL SPRAYFOAM INSULATION

RS-5 ROOF SYSTEM (RS-5)
- FULLY ADHERED TPO (WHITE) MEMBRANE SYSTEM
- ½" OVERLAY BOARD
- SLOPED ROOF TAPERS AS REQUIRED
- 6" BASE LAYER POLYISO RIGID INSULATION. (2) LAYERS 3" THICKNESS W/ STAGGERED JOINTS
- ROOF DECK:
  1. METAL DECK, RE: STRUCT, HORIZONTAL ASSEMBLIES (5A)
  2. PLYWOOD SHEATHING, ON WOOD JOISTS (5B)

RS-6 ROOF SYSTEM (RS-6)
- PORCELAIN PAVER/ RAISED PEDESTAL DECKING SYSTEM
- FULLY ADHERED TPO (WHITE) MEMBRANE SYSTEM
- SLOPED PLYWOOD SHEATHING
- TAPERED FIRRING STRIPS
- PLYWOOD SHEATHING, RE: STRUCT, HORIZONTAL ASSEMBLIES
- X" CLOSED-CELL SPRAY FOAM INSULATION
- ?

RS-7 ROOF SYSTEM (RS-7)
- STANDING SEAM METAL ROOFING
- SLOPED PLYWOOD SHEATHING (2:12)
- R-38 BATT INSULATION
- INTERNAL GUTTER SYSTEM

HELTSHE

M1A | MERIDIAN 105 ARCHITECTURE

CITY HOTEL
415 PERRY STREET, CASTLE ROCK, CO.

DATE: 4.22.2026	ISSUED FOR: PERMIT	SHEET TITLE: ROOF PLAN	SHEET NUMBER A2.05
PROJ. NO. 2023.002			

C:\Users\daniel\Documents\City Hotel-2024_1_dljpscomb74CJ8.rvt

4/22/2026 1:06:52 PM

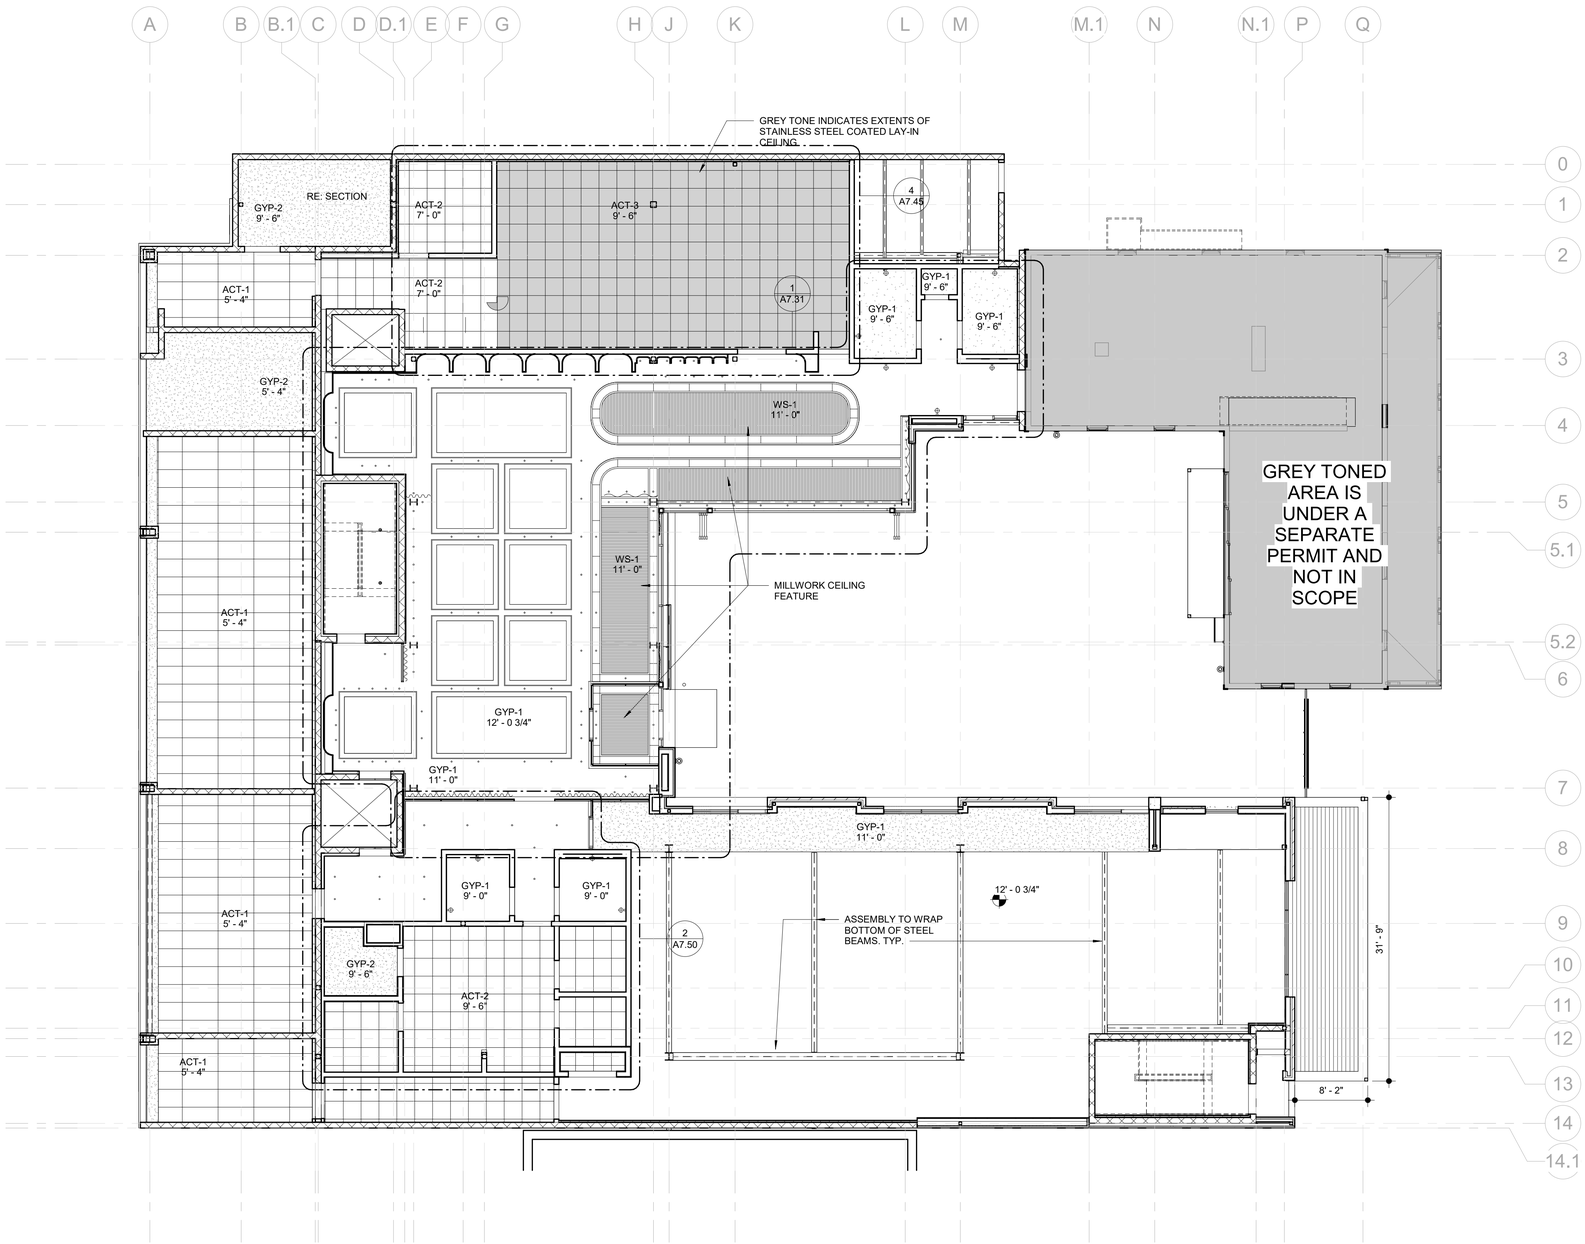

1 LEVEL 1 - RCP
1/8" = 1'-0"

CEILING LEGEND

CEILING TYPES:

ACT-1: 2X4 LAY-IN CEILING, PARKING

ACT-2: 2X2 LAY-IN CEILING, KITCHEN, BACK OF HOUSE

ACT-3: 2X2 LAY-IN CEILING, KITCHEN, WITH METAL FINISH

WS-1: WOOD SLAT CEILING. PRODUCT BY USG INTERIORS 'SPECIALTY CEILING SYSTEM', TRUE WOOD. WOOD VENEER COLOR SELECTED BY ARCHITECT, WITH BLACK FELT REVEAL BACKING. MILLWORK BORDERS AND FLAT PLANAR AREAS TO MATCH FINISH, MATERIAL, AND COLOR OF SLAT PRODUCT.

GYP-1: GYPSUM BOARD ON METAL SUSPENSION SYSTEM, OR WOOD FRAMING

GYP-2: GYPSUM BOARD CEILING, RATED 2-HOURS, AER-09038

NOTE: REFER TO LIGHTING PLANS FOR COMPLETE LAYOUTS AND SPECIFICATIONS OF LIGHTING FIXTURES. DIMENSIONED LOCATION TO BE PROVIDED BY ARCHITECT.

C:\Users\daniel\Documents\City Hotel-2024_1_dlipscomb74CJ8.rvt

4/22/2026 1:06:55 PM

HELTSHE

M1A MERIDIAN 105 ARCHITECTURE

CITY HOTEL
415 PERRY STREET, CASTLE ROCK, CO.

DATE: 4.22.2026	ISSUED FOR: PERMIT	SHEET TITLE: OVERALL RCP - LVL 1	SHEET NUMBER A3.01
PROJ. NO. 2023.002			

TAKE-OFF LEGEND - A3.02 (gypsum board ceilings / soffits)

blue area = gyp bd ceiling / soffit: 18 areas, 5,963.30 SF (Contents: board · ceiling tag · room · SF · ceiling height · detail · id)

measure: /Measure at the printed scale of the sheet; SF = Excel row (ceiling id)

1 LEVEL 2 - RCP
1/8" = 1'-0"

CEILING LEGEND

CEILING TYPES:

ACT-1: 2X4 LAY-IN CEILING, PARKING

ACT-2: 2X2 LAY-IN CEILING, KITCHEN, BACK OF HOUSE

ACT-3: 2X2 LAY-IN CEILING, KITCHEN, WITH METAL FINISH

WS-1: WOOD SLAT CEILING. PRODUCT BY USG INTERIORS 'SPECIALTY CEILING SYSTEM', TRUE WOOD. WOOD VENEER COLOR SELECTED BY ARCHITECT, WITH BLACK FELT REVEAL BACKING. MILLWORK BORDERS AND FLAT PLANAR AREAS TO MATCH FINISH, MATERIAL, AND COLOR OF SLAT PRODUCT.

GYP-1: GYPSUM BOARD ON METAL SUSPENSION SYSTEM, OR WOOD FRAMING

GYP-2: GYPSUM BOARD CEILING, RATED 2-HOURS, AER-09038

NOTE: REFER TO LIGHTING PLANS FOR COMPLETE LAYOUTS AND SPECIFICATIONS OF LIGHTING FIXTURES. DIMENSIONED LOCATION TO BE PROVIDED BY ARCHITECT.

HELTSHE

M1A MERIDIAN 105 ARCHITECTURE

CITY HOTEL
415 PERRY STREET, CASTLE ROCK, CO.

DATE: 4.22.2026
PROJ. NO. 2023.002

ISSUED FOR: PERMIT

SHEET TITLE: OVERALL RCP - LVL 2

SHEET NUMBER A3.02

C:\Users\daniel\Documents\City Hotel-2024_1_dlipscomb74CJB.rvt

4/22/2026 1:07:00 PM

TAKE-OFF LEGEND - A3.03 (gypsum board ceilings / soffits)

blue area = gyp bd ceiling / soffit: 18 areas, 5,779.50 SF (Contents: board · ceiling tag · room · SF · ceiling height · detail · id)

measure: /Measure at the printed scale of the sheet; SF = Excel row (ceiling id)

1 LEVEL 3 - RCP
1/8" = 1'-0"

CEILING LEGEND

CEILING TYPES:

ACT-1: 2X4 LAY-IN CEILING, PARKING

ACT-2: 2X2 LAY-IN CEILING, KITCHEN, BACK OF HOUSE

ACT-3: 2X2 LAY-IN CEILING, KITCHEN, WITH METAL FINISH

WS-1: WOOD SLAT CEILING. PRODUCT BY USG INTERIORS 'SPECIALTY CEILING SYSTEM', TRUE WOOD. WOOD VENEER COLOR SELECTED BY ARCHITECT, WITH BLACK FELT REVEAL BACKING. MILLWORK BORDERS AND FLAT PLANAR AREAS TO MATCH FINISH, MATERIAL, AND COLOR OF SLAT PRODUCT.

GYP-1: GYPSUM BOARD ON METAL SUSPENSION SYSTEM, OR WOOD FRAMING

GYP-2: GYPSUM BOARD CEILING, RATED 2-HOURS, AER-09038

NOTE: REFER TO LIGHTING PLANS FOR COMPLETE LAYOUTS AND SPECIFICATIONS OF LIGHTING FIXTURES. DIMENSIONED LOCATION TO BE PROVIDED BY ARCHITECT.

HELTSHE

M1A MERIDIAN 105 ARCHITECTURE

CITY HOTEL
415 PERRY STREET, CASTLE ROCK, CO.

DATE: 4.22.2026
PROJ. NO. 2023.002

ISSUED FOR: PERMIT

SHEET TITLE: OVERALL RCP - LVL 3

SHEET NUMBER A3.03

C:\Users\daniel\Documents\City Hotel-2024_1_dfjpscomb74CJB.rvt

4/22/2026 1:07:04 PM

TAKE-OFF LEGEND - A3.04 (gypsum board ceilings / soffits)

blue area = gyp bd ceiling / soffit: 6 areas, 1,903.37 SF (Contents: board · ceiling tag · room · SF · ceiling height · detail · id)

measure: /Measure at the printed scale of the sheet; SF = Excel row (ceiling id)

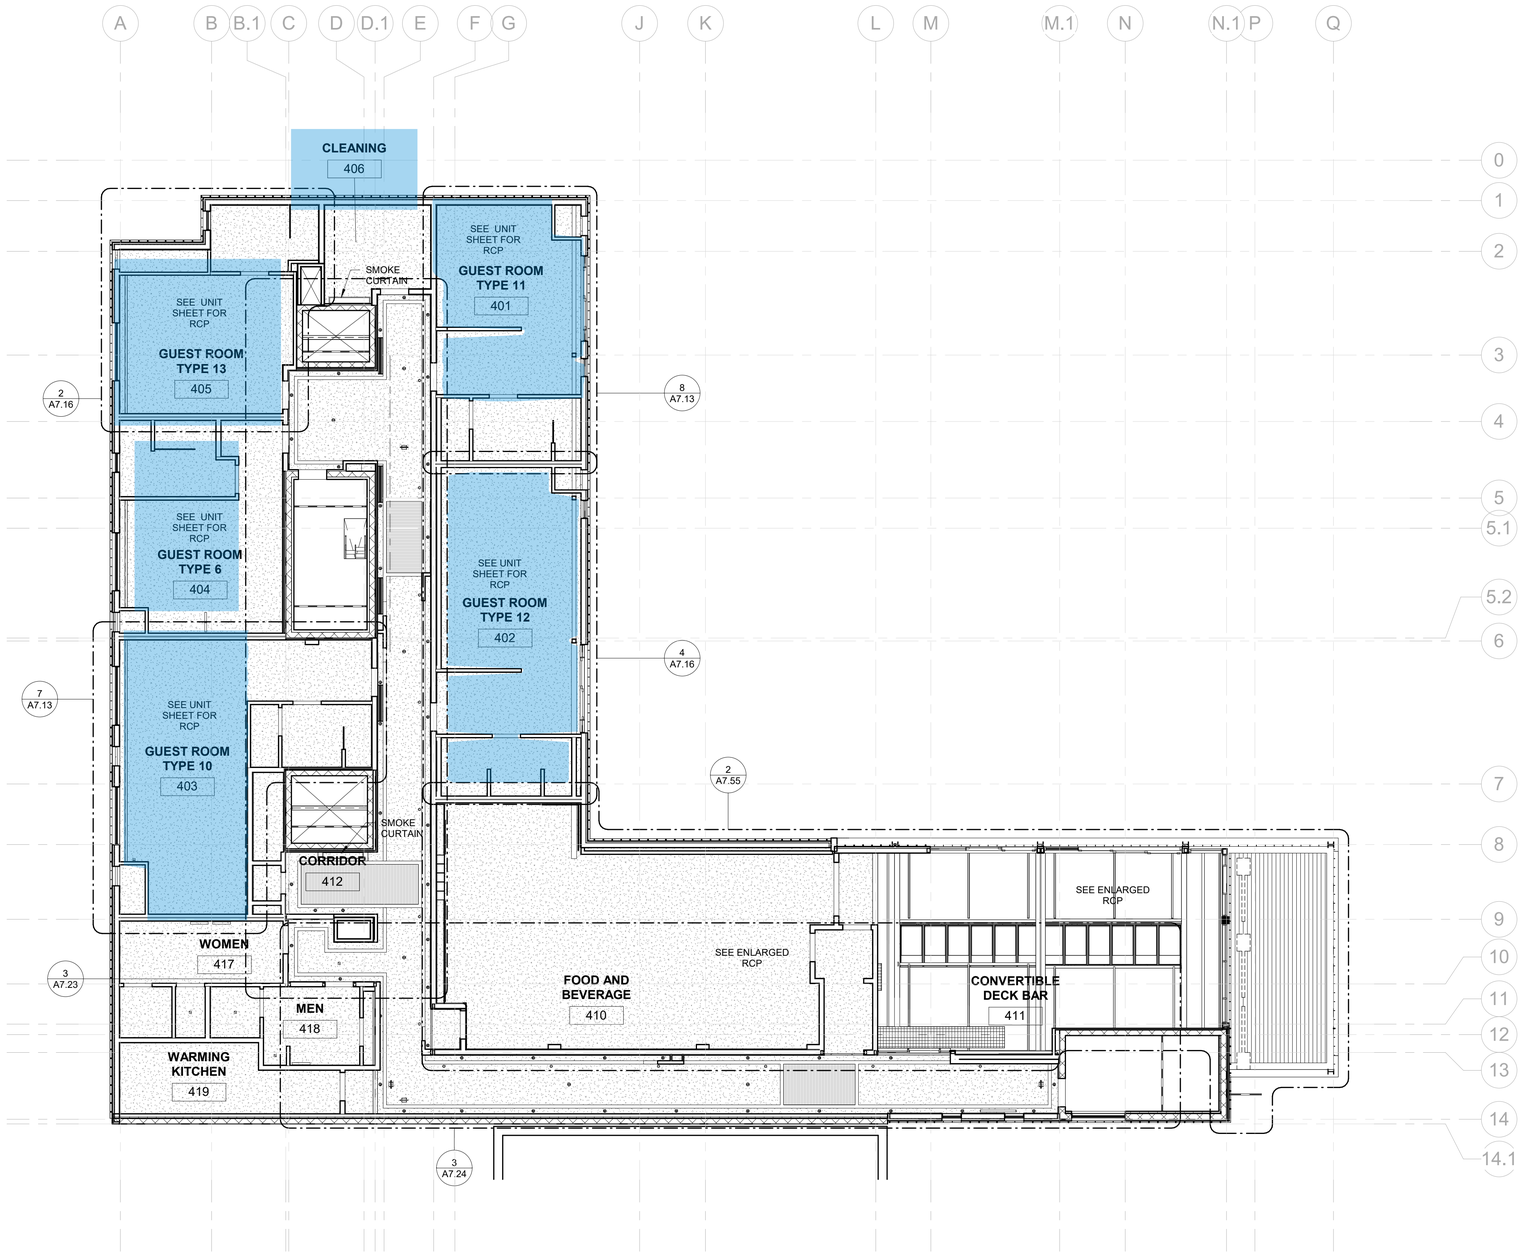

1 LEVEL 4 - RCP
1/8" = 1'-0"

CEILING LEGEND

CEILING TYPES:

ACT-1: 2X4 LAY-IN CEILING, PARKING

ACT-2: 2X2 LAY-IN CEILING, KITCHEN, BACK OF HOUSE

ACT-3: 2X2 LAY-IN CEILING, KITCHEN, WITH METAL FINISH

WS-1: WOOD SLAT CEILING. PRODUCT BY USG INTERIORS 'SPECIALTY CEILING SYSTEM', TRUE WOOD. WOOD VENEER COLOR SELECTED BY ARCHITECT, WITH BLACK FELT REVEAL BACKING. MILLWORK BORDERS AND FLAT PLANAR AREAS TO MATCH FINISH, MATERIAL, AND COLOR OF SLAT PRODUCT.

GYP-1: GYPSUM BOARD ON METAL SUSPENSION SYSTEM, OR WOOD FRAMING

GYP-2: GYPSUM BOARD CEILING, RATED 2-HOURS, AER-09038

NOTE: REFER TO LIGHTING PLANS FOR COMPLETE LAYOUTS AND SPECIFICATIONS OF LIGHTING FIXTURES. DIMENSIONED LOCATION TO BE PROVIDED BY ARCHITECT.

C:\Users\dariel\Documents\City Hotel-2024_1_dilpscomb74Cj8.rvt

4/22/2026 1:07:07 PM

HELTSHE

M1A MERIDIAN 105 ARCHITECTURE

CITY HOTEL
415 PERRY STREET, CASTLE ROCK, CO.

DATE: 4.22.2026
PROJ. NO. 2023.002

ISSUED FOR: PERMIT

SHEET TITLE: OVERALL RCP - LVL 4

SHEET NUMBER A3.04

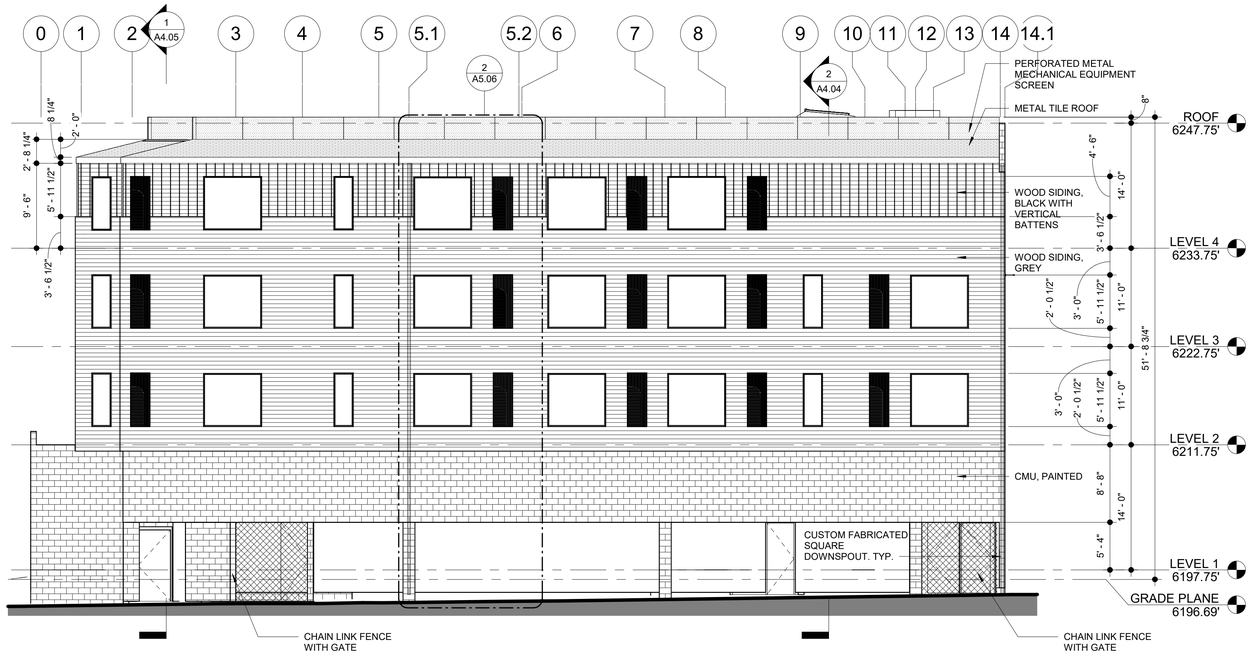

1 BUILDING ELEVATION - WEST FACING ALLEY FACADE
1/8" = 1'-0"

2 BUILDING ELEVATION - EAST-FACING COURTYARD FACADE
1/8" = 1'-0"

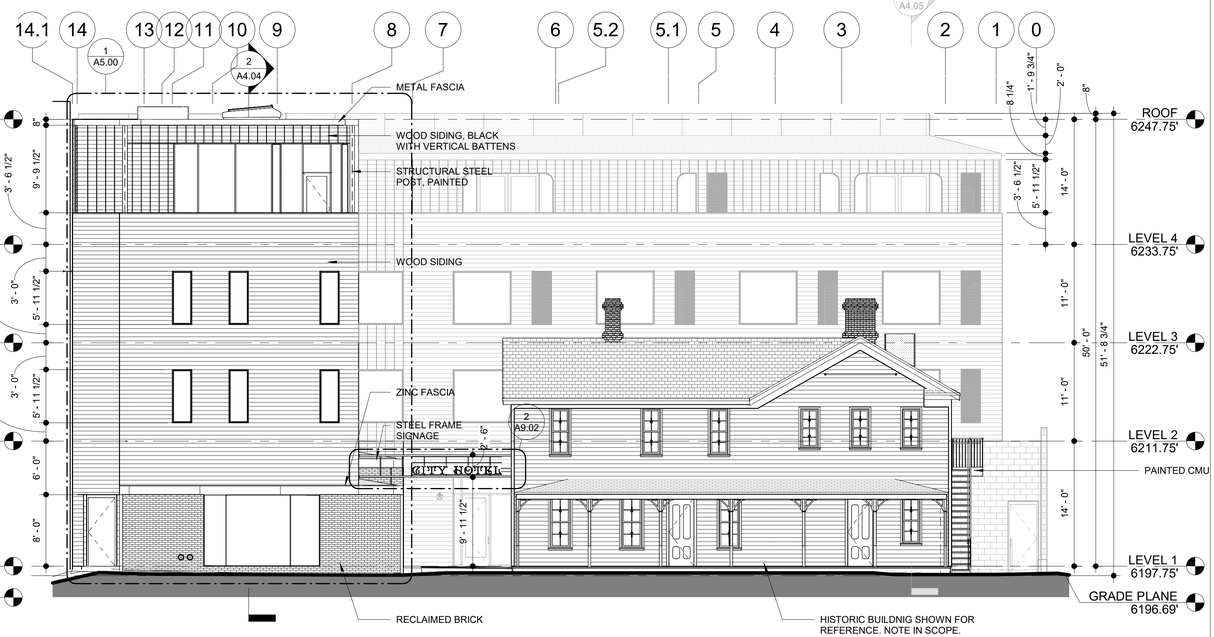

3 BUILDING ELEVATION - EAST FACING STREET FACADE
1/8" = 1'-0"

C:\Users\daniel\Documents\City Hotel-2024_1_dlpscomb74Cq8.rvt

4/22/2026 1:07:17 PM

HELTSHE

M1A | MERIDIAN 105 ARCHITECTURE

CITY HOTEL
415 PERRY STREET, CASTLE ROCK, CO.

DATE: 4.22.2026	ISSUED FOR: PERMIT	SHEET TITLE: ELEVATIONS	SHEET NUMBER A4.00
PROJ. NO. 2023.002			

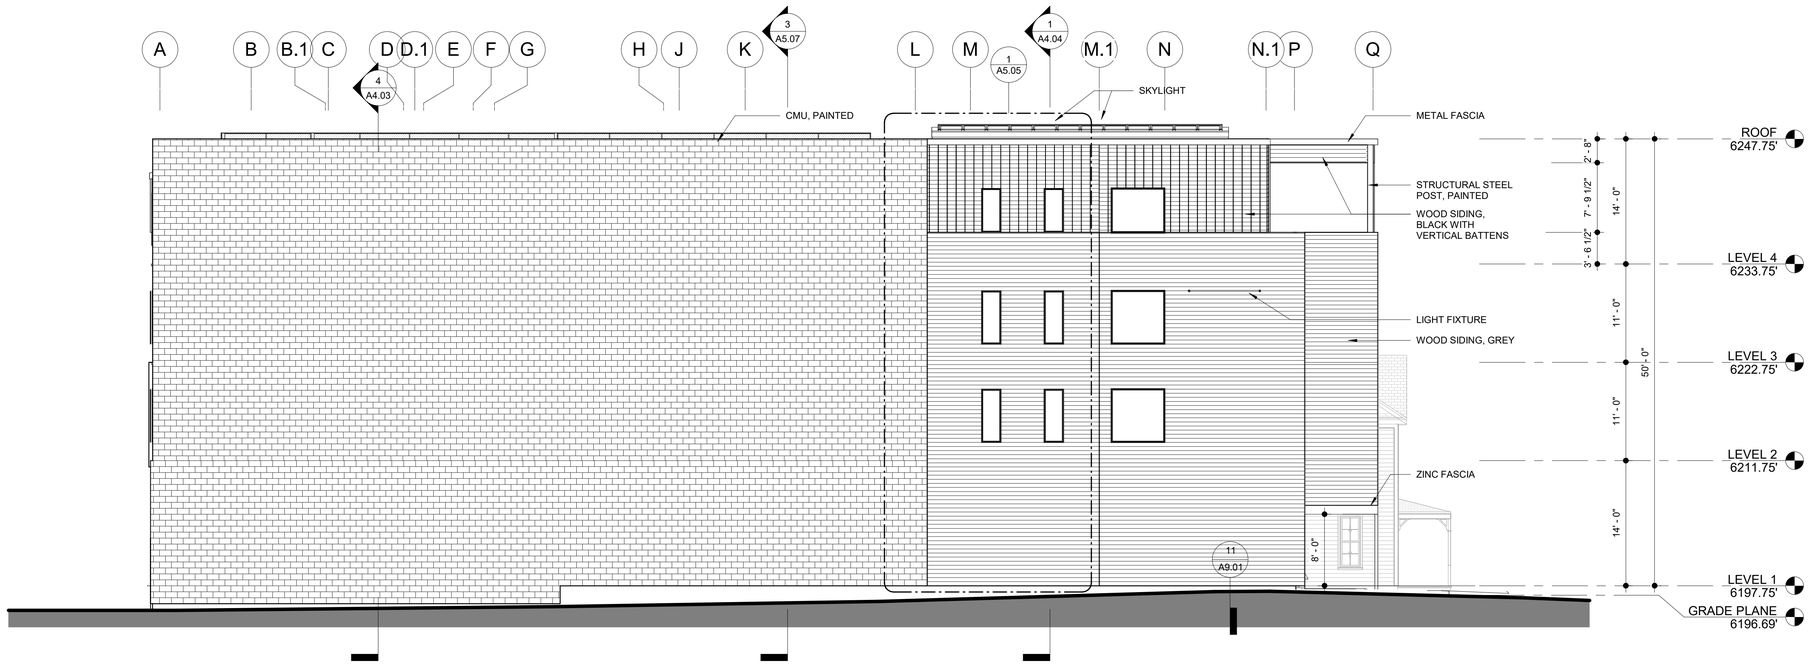

1 BUILDING ELEVATION - SOUTH FACING FACADE
1/8" = 1'-0"

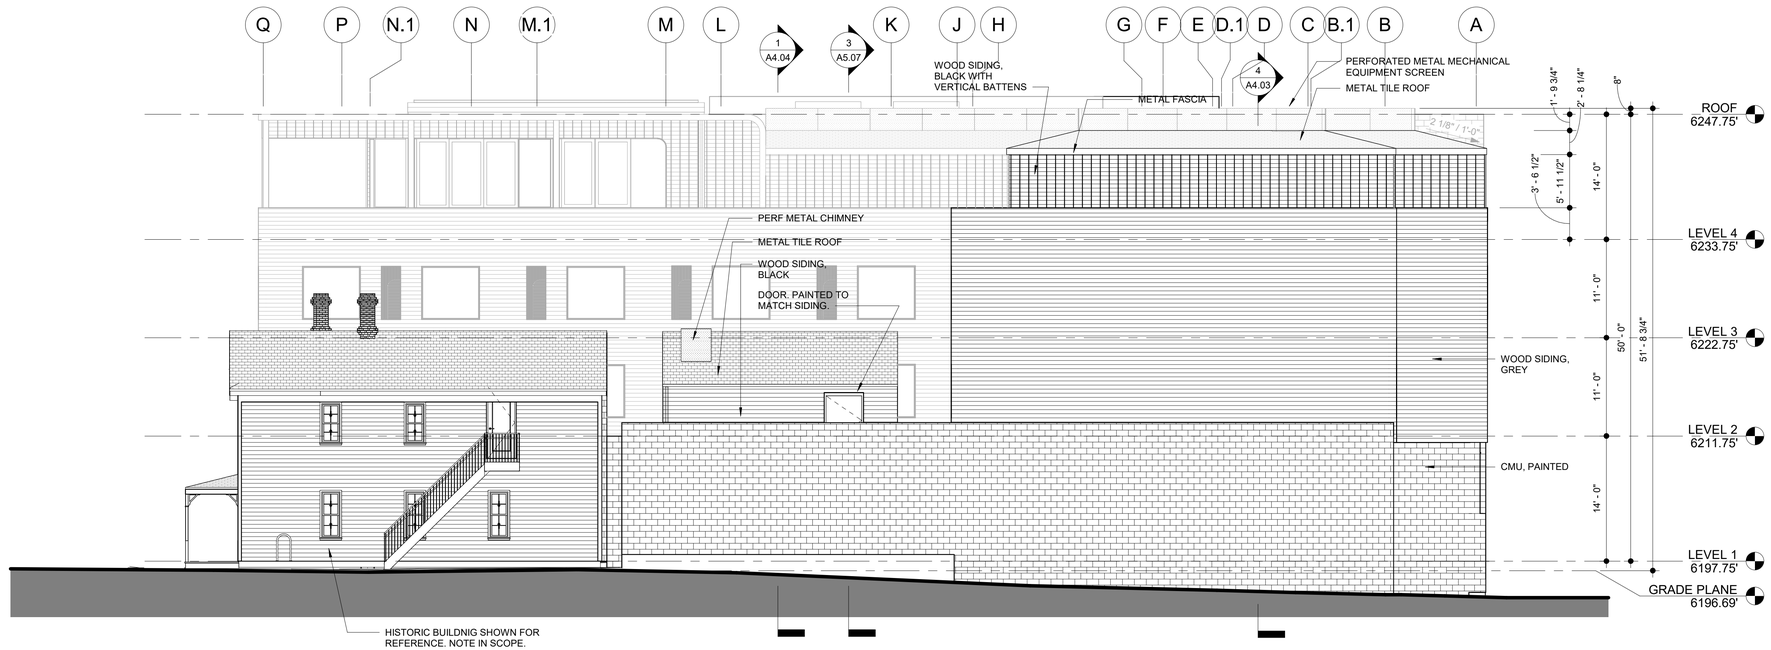

2 BUILDING ELEVATION - NORTH FACING BUILDING FACADE
1/8" = 1'-0"

C:\Users\daniel\Documents\City Hotel-2024_1_dljpscomb74Cd8.rvt
4/22/2026 1:07:24 PM

HELTSHE

M1A | MERIDIAN 105 ARCHITECTURE

CITY HOTEL
415 PERRY STREET, CASTLE ROCK, CO.

DATE: 4.22.2026
PROJ. NO. 2023.002

ISSUED FOR: PERMIT

SHEET TITLE: ELEVATIONS

SHEET NUMBER
A4.01

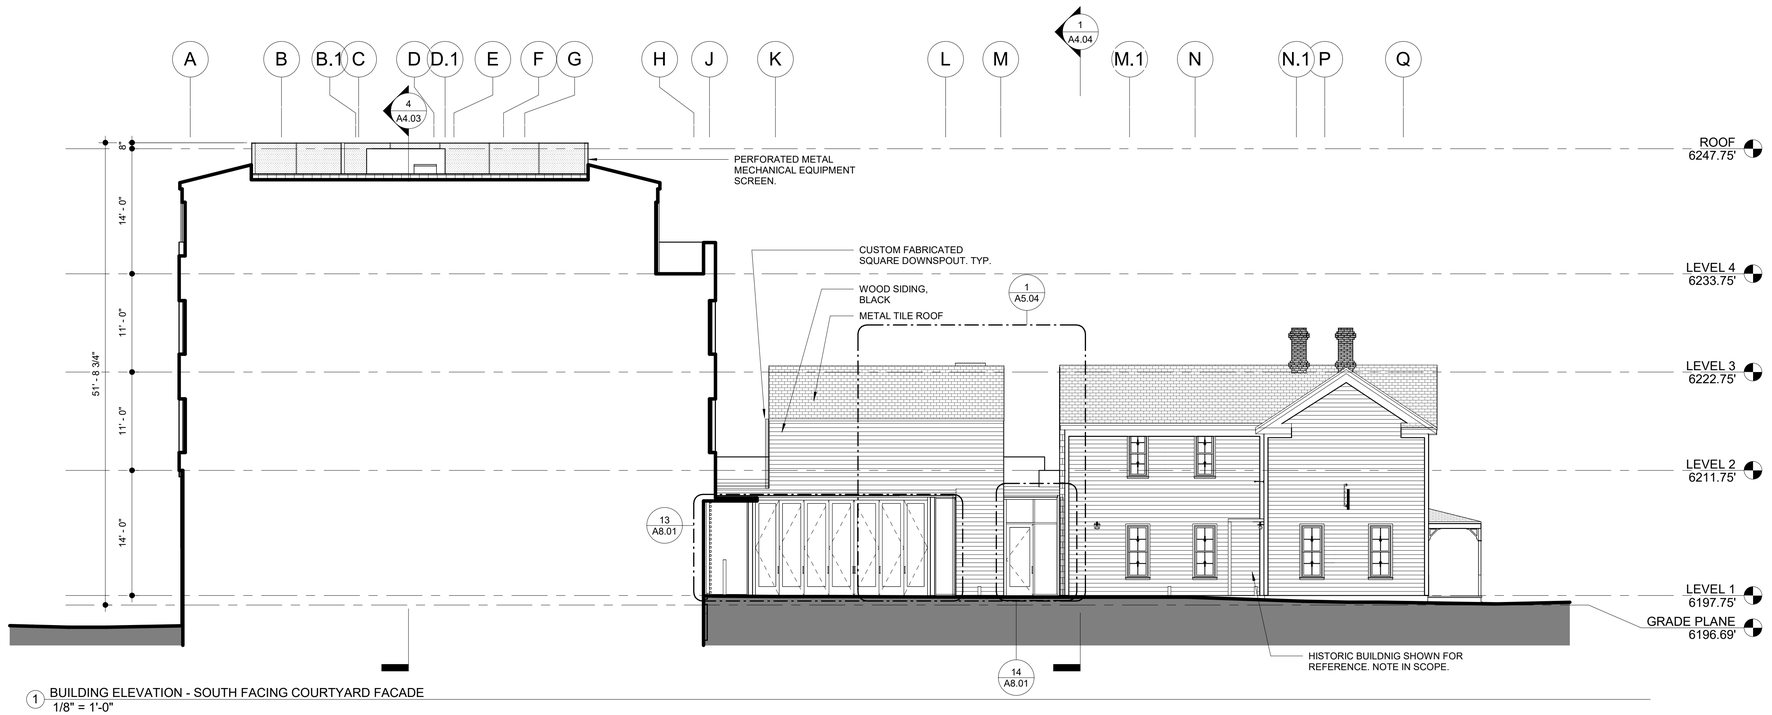

1 BUILDING ELEVATION - SOUTH FACING COURTYARD FACADE
1/8" = 1'-0"

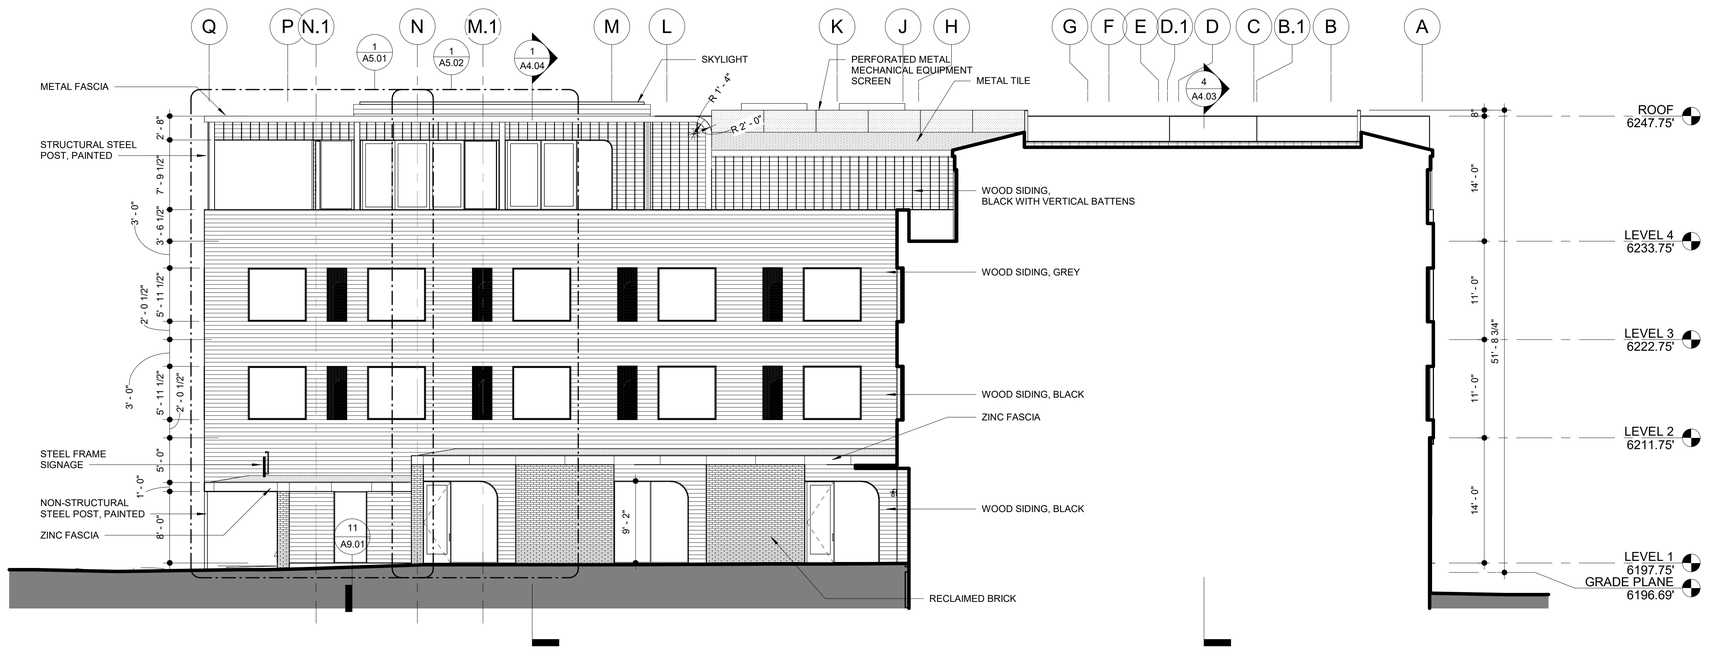

2 BUILDING ELEVATION - NORTH FACING COURTYARD FACADE
1/8" = 1'-0"

C:\Users\daniel\Documents\City Hotel-2024_1_dlipscomb74Cq8.rvt

4/22/2026 1:07:28 PM

HELTSHE

M1A MERIDIAN 105 ARCHITECTURE

CITY HOTEL
415 PERRY STREET, CASTLE ROCK, CO.

DATE: 4.22.2026	ISSUED FOR: PERMIT	SHEET TITLE: ELEVATIONS	SHEET NUMBER A4.02
PROJ. NO. 2023.002			

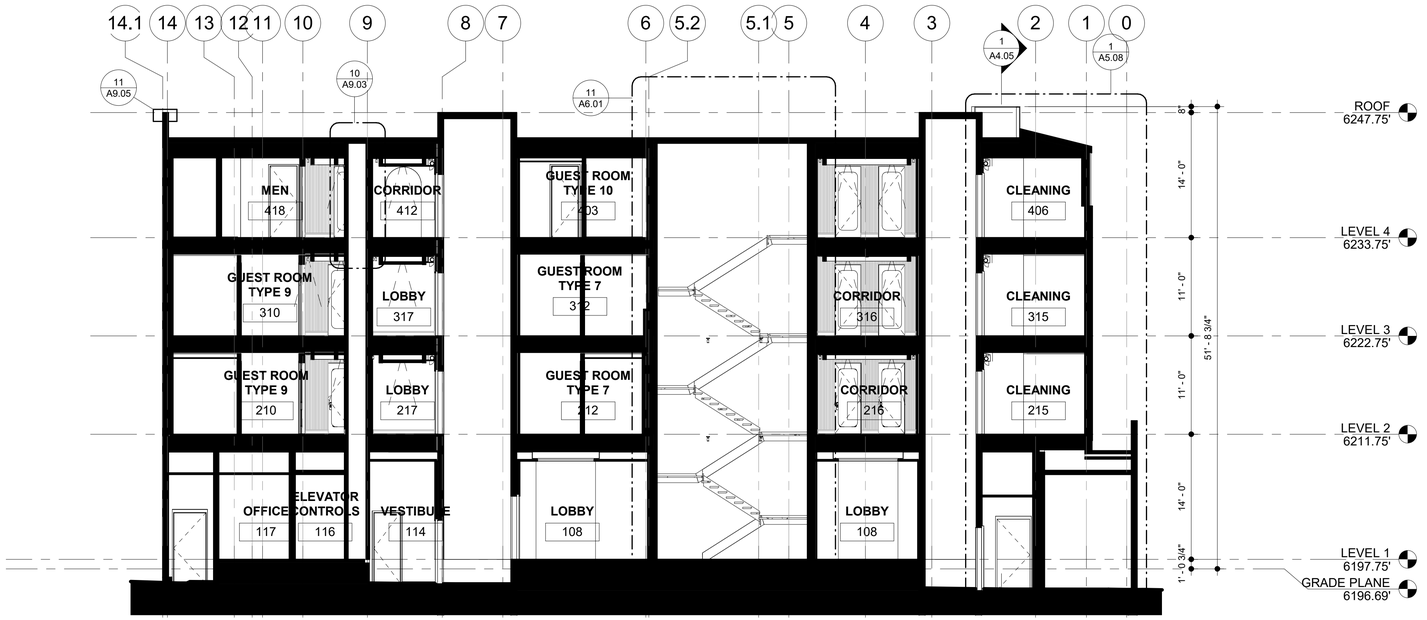

4 BUILDING SECTION - NORTH/SOUTH THROUGH LOBBY
1/8" = 1'-0"

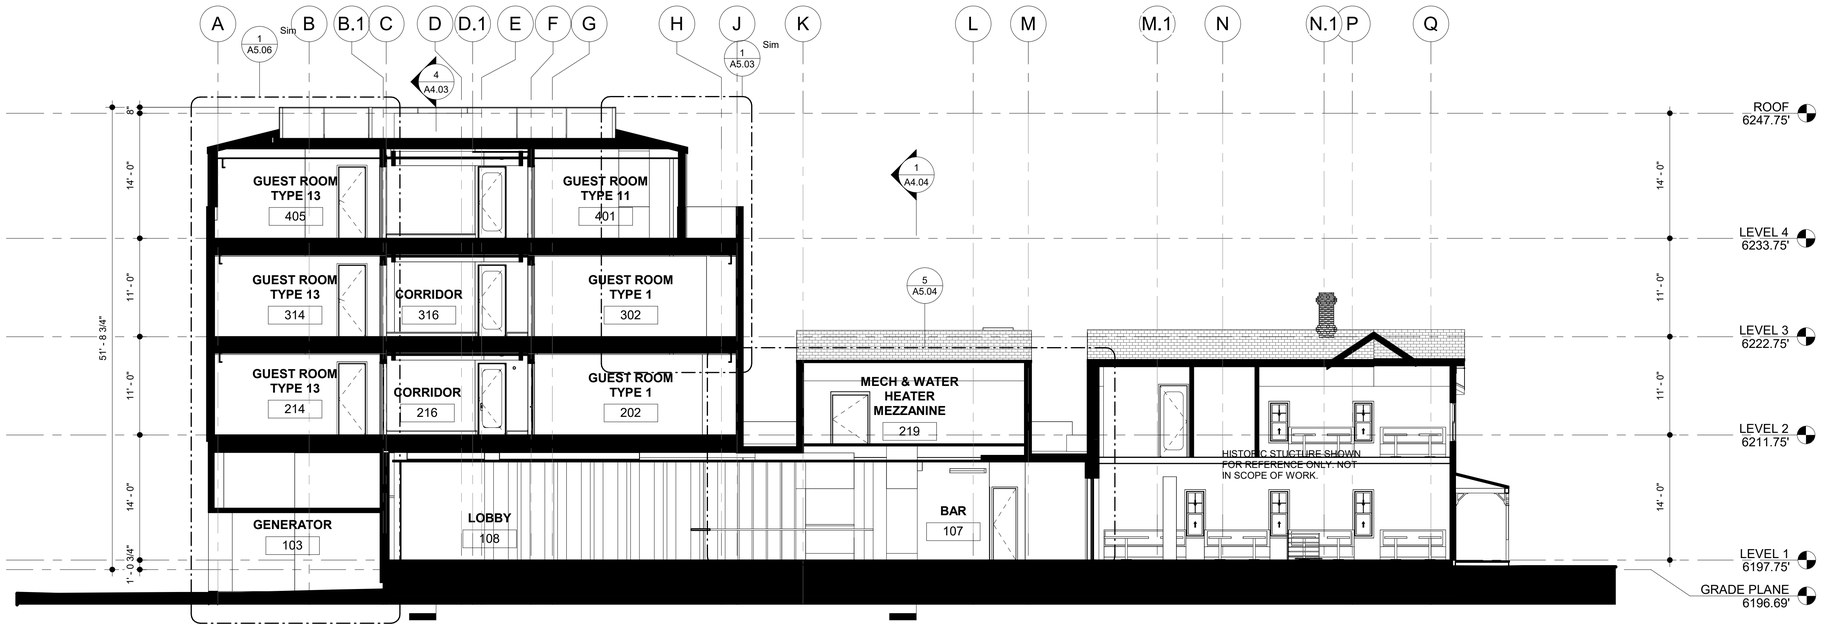

2 BUILDING SECTION - EAST/WEST THROUGH HISTORIC
1/8" = 1'-0"

HELTSHE

M1A MERIDIAN 105 ARCHITECTURE

CITY HOTEL
415 PERRY STREET, CASTLE ROCK, CO.

DATE: 4.22.2026	ISSUED FOR: PERMIT	SHEET TITLE: BUILDING SECTIONS	SHEET NUMBER A4.03
PROJ. NO. 2023.002			

C:\Users\daniel\Documents\City Hotel-2024_1_dlipscomb74CJB.rvt

4/22/2026 1:07:32 PM

1 BUILDING SECTION - NORTH/SOUTH THROUGH RETAIL
1/8" = 1'-0"

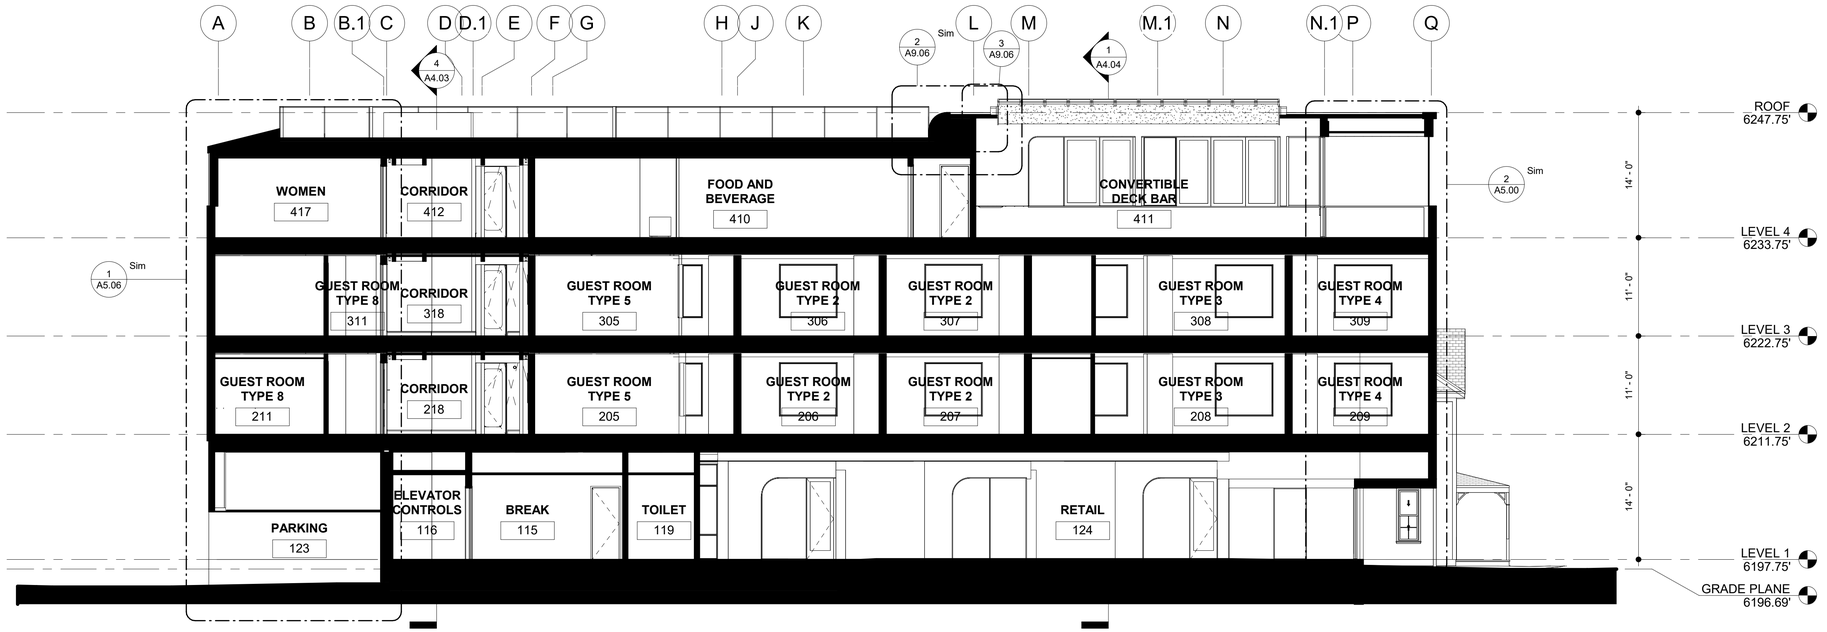

2 BUILDING SECTION - EAST/WEST
1/8" = 1'-0"

C:\Users\daniel\Documents\City Hotel-2024_1_dlipscomb74C.J8.rvt
4/22/2026 1:07:37 PM

HELTSHE

M1A MERIDIAN 105 ARCHITECTURE

CITY HOTEL
415 PERRY STREET, CASTLE ROCK, CO.

DATE: 4.22.2026	ISSUED FOR: PERMIT	SHEET TITLE: BUILDING SECTIONS	SHEET NUMBER A4.04
PROJ. NO. 2023.002			

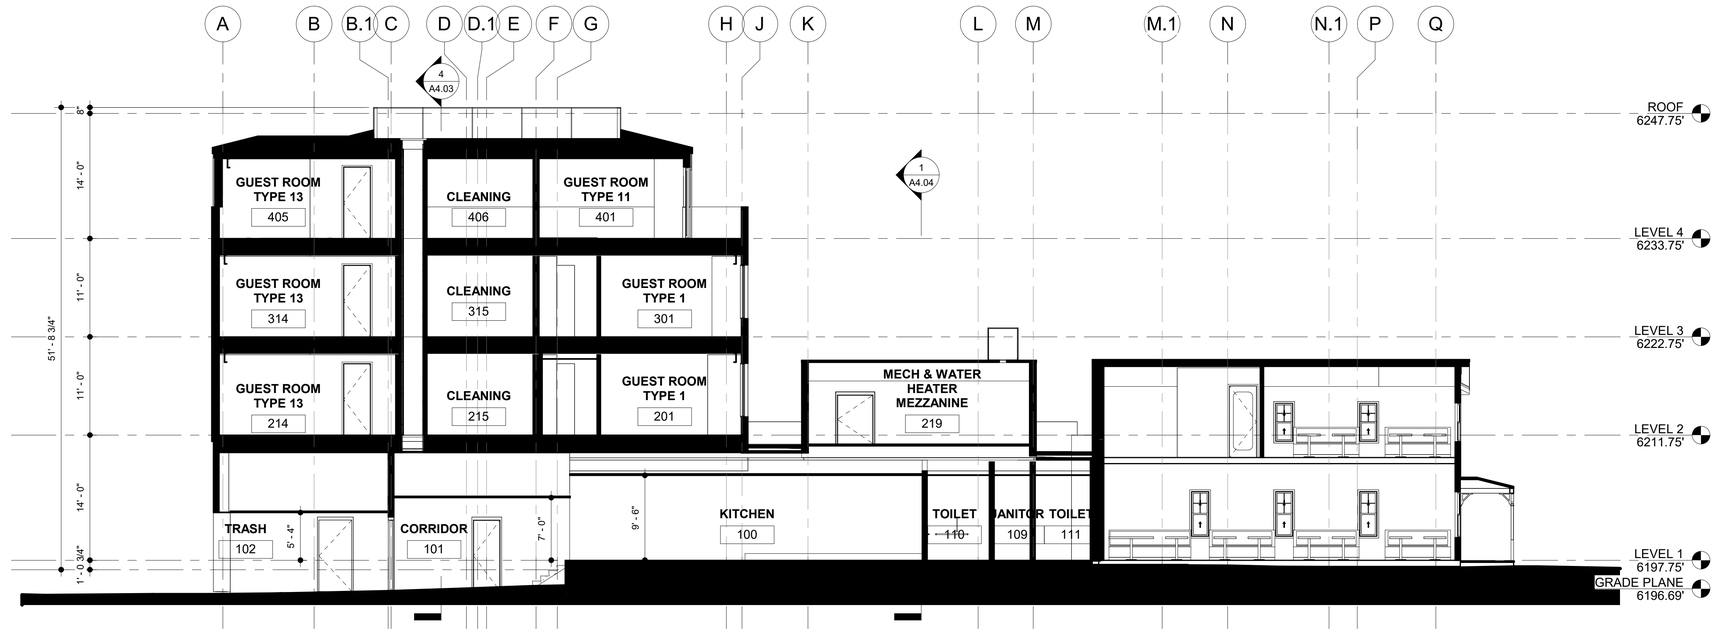

1 BUILDING SECTION - EAST/WEST2
1/8" = 1'-0"

C:\Users\daniel\Documents\City Hotel-2024_1_dlpscomb74Cj8.rvt

4/22/2026 1:07:39 PM

HELTSHE

M1A | MERIDIAN 105 ARCHITECTURE

CITY HOTEL

415 PERRY STREET, CASTLE ROCK, CO.

DATE: 4.22.2026
PROJ. NO. 2023.002

ISSUED FOR: PERMIT

SHEET TITLE: BUILDING SECTIONS

SHEET NUMBER
A4.05

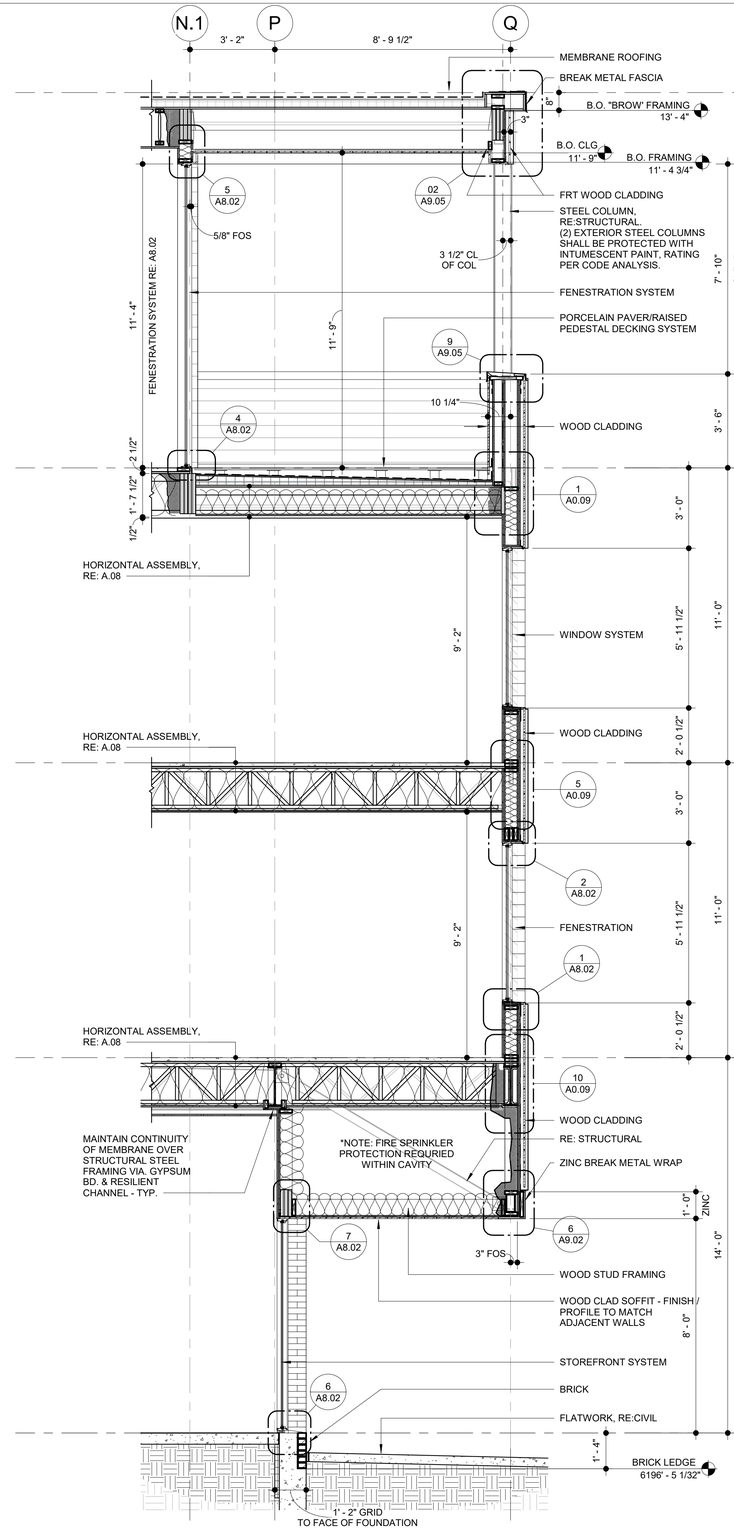

2 ENLARGED WALL SECTION - EAST WALL
3/8" = 1'-0"

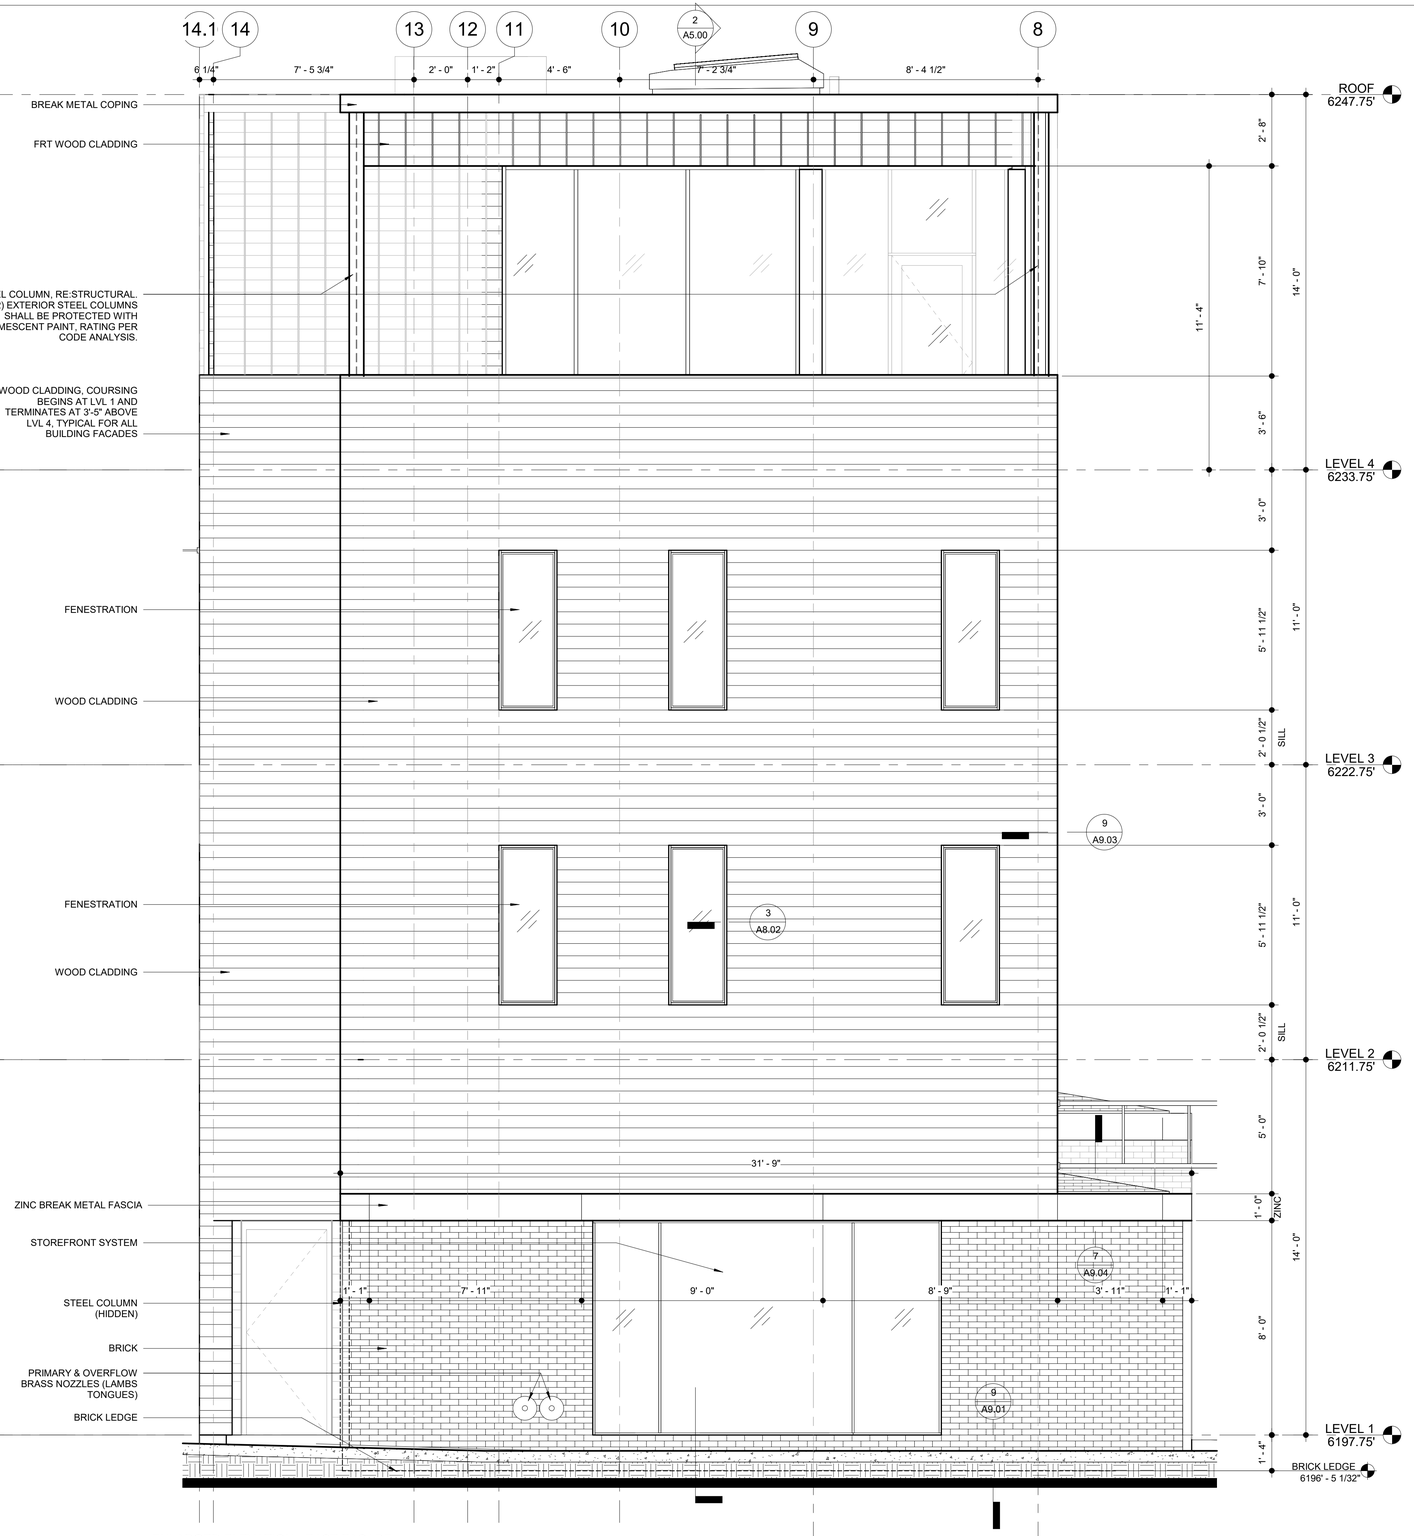

1 ENLARGED ELEVATION - EAST FACADE
3/8" = 1'-0"

HELTSHE

M1A | MERIDIAN 105 ARCHITECTURE

CITY HOTEL
415 PERRY STREET, CASTLE ROCK, CO.

DATE: 4.22.2026
PROJ. NO. 2023.002

ISSUED FOR: PERMIT

SHEET TITLE: ENLARGED WALL SECTIONS & ELEVATIONS

SHEET NUMBER
A5.00

C:\Users\daniel\Documents\City Hotel-2024_1_dlipscomb74CJ8.rvt

4/22/2026 1:07:42 PM

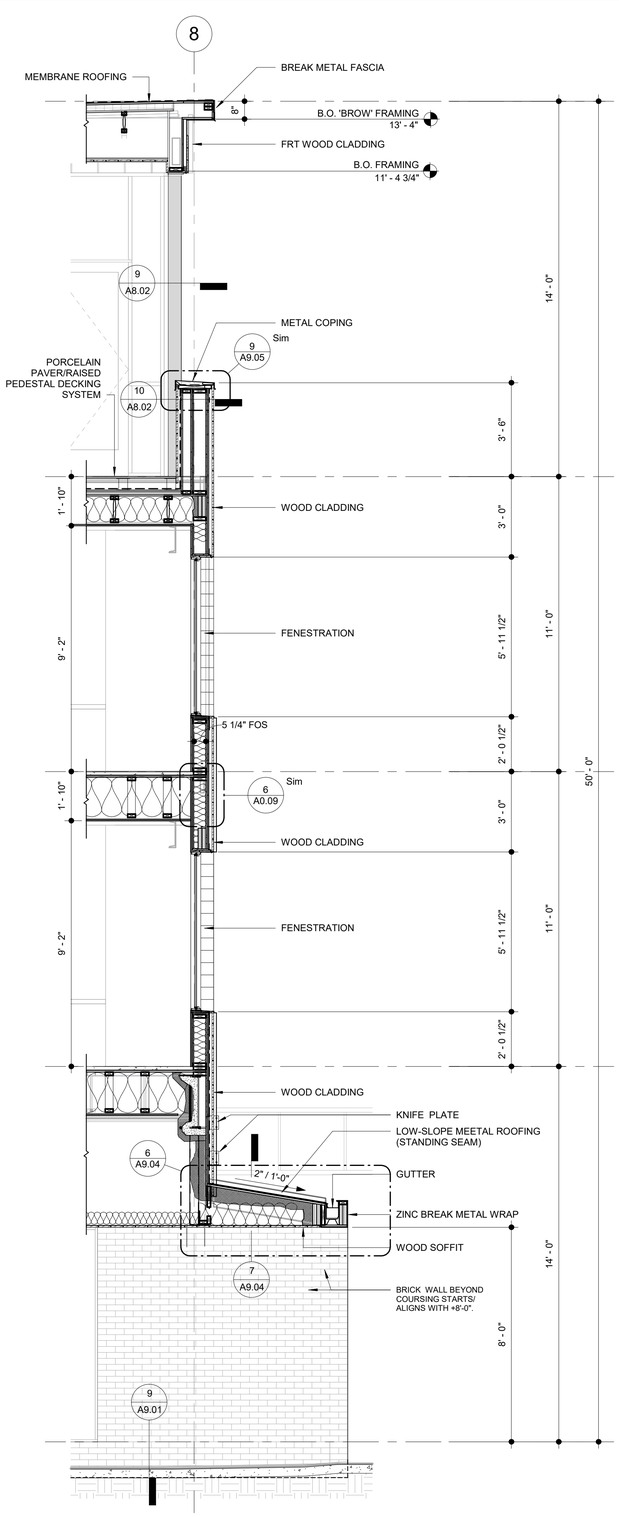

3 ENLARGED WALL SECTION - COURTYARD SOUTH WALL 2
3/8" = 1'-0"

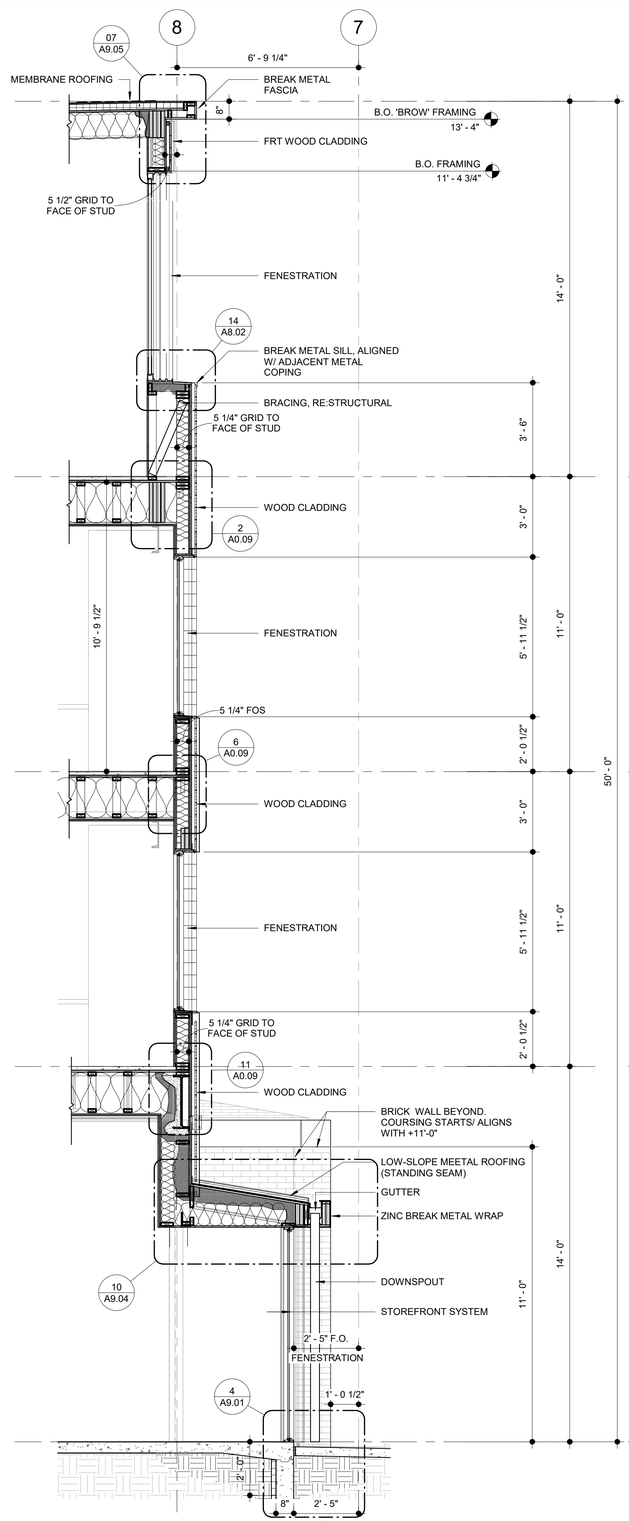

2 ENLARGED WALL SECTION - COURTYARD SOUTH WALL 1
3/8" = 1'-0"

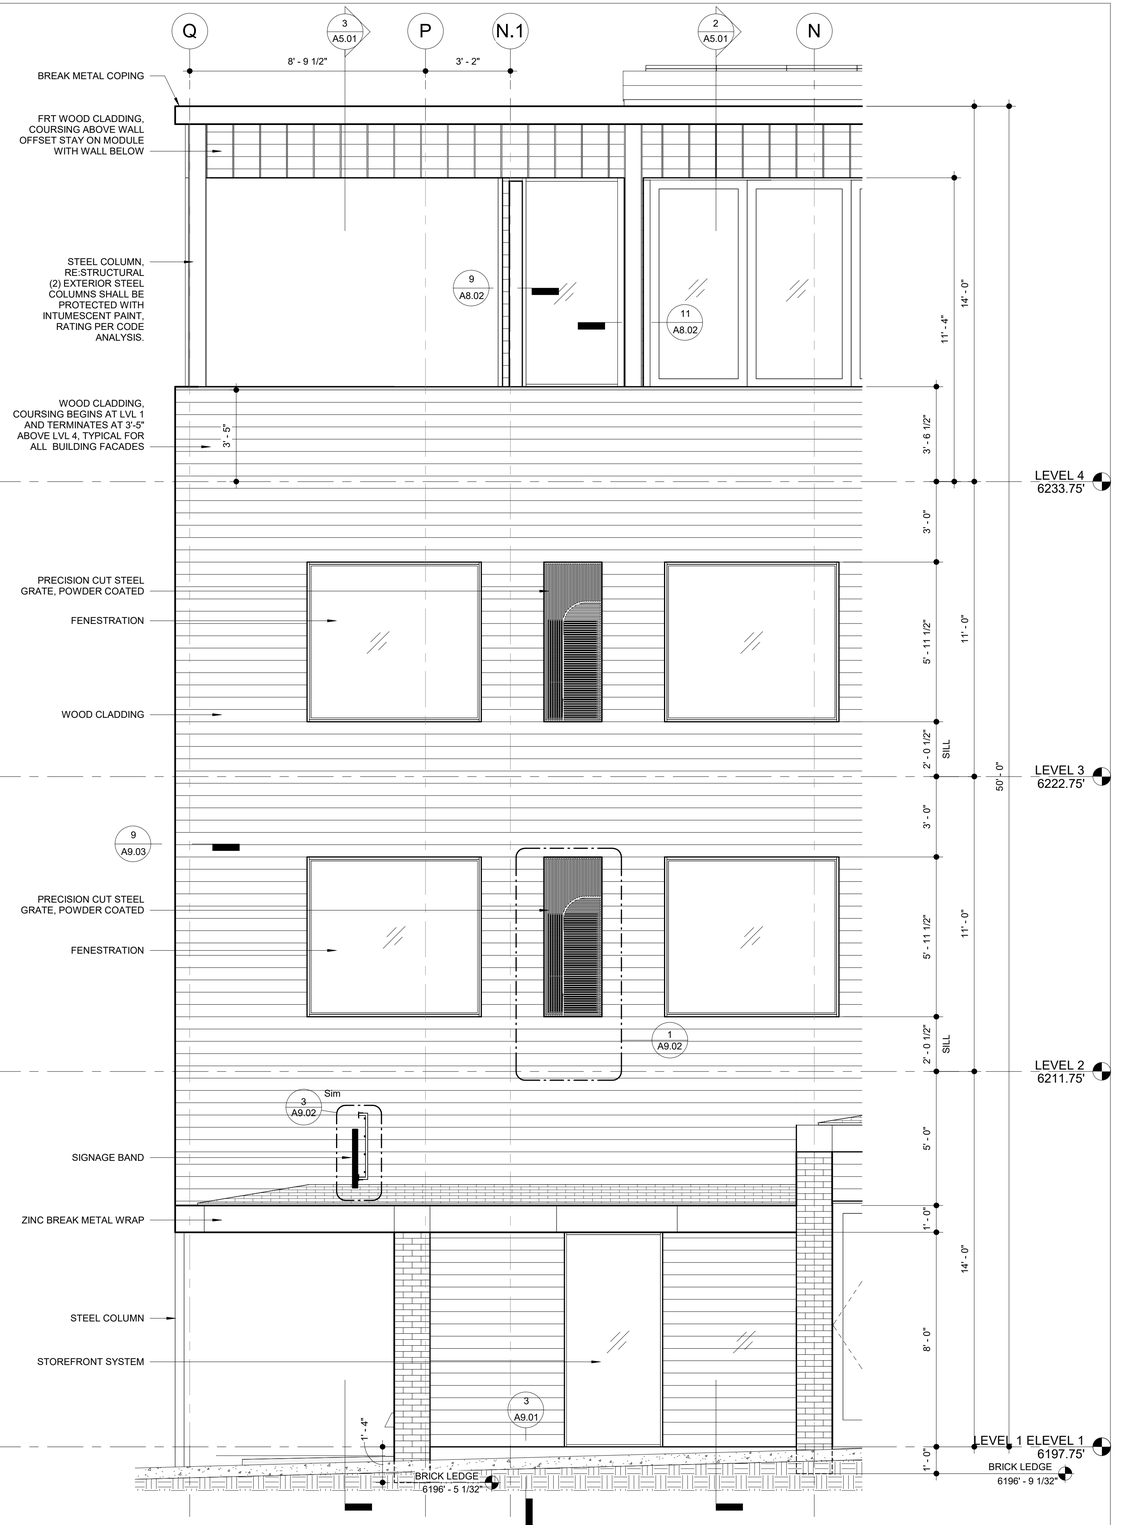

1 BUILDING ELEVATION - SOUTH SIDE COURTYARD
3/8" = 1'-0"

HELTSHE

M1A | MERIDIAN 105 ARCHITECTURE

CITY HOTEL

415 PERRY STREET, CASTLE ROCK, CO.

DATE: 4.22.2026	ISSUED FOR: PERMIT	SHEET TITLE: ENLARGED WALL SECTIONS & ELEVATIONS	SHEET NUMBER A5.01
PROJ. NO. 2023.002			

C:\Users\daniel\Documents\City Hotel-2024_1_dlipscomb74Cd8.rvt

4/22/2026 1:07:45 PM

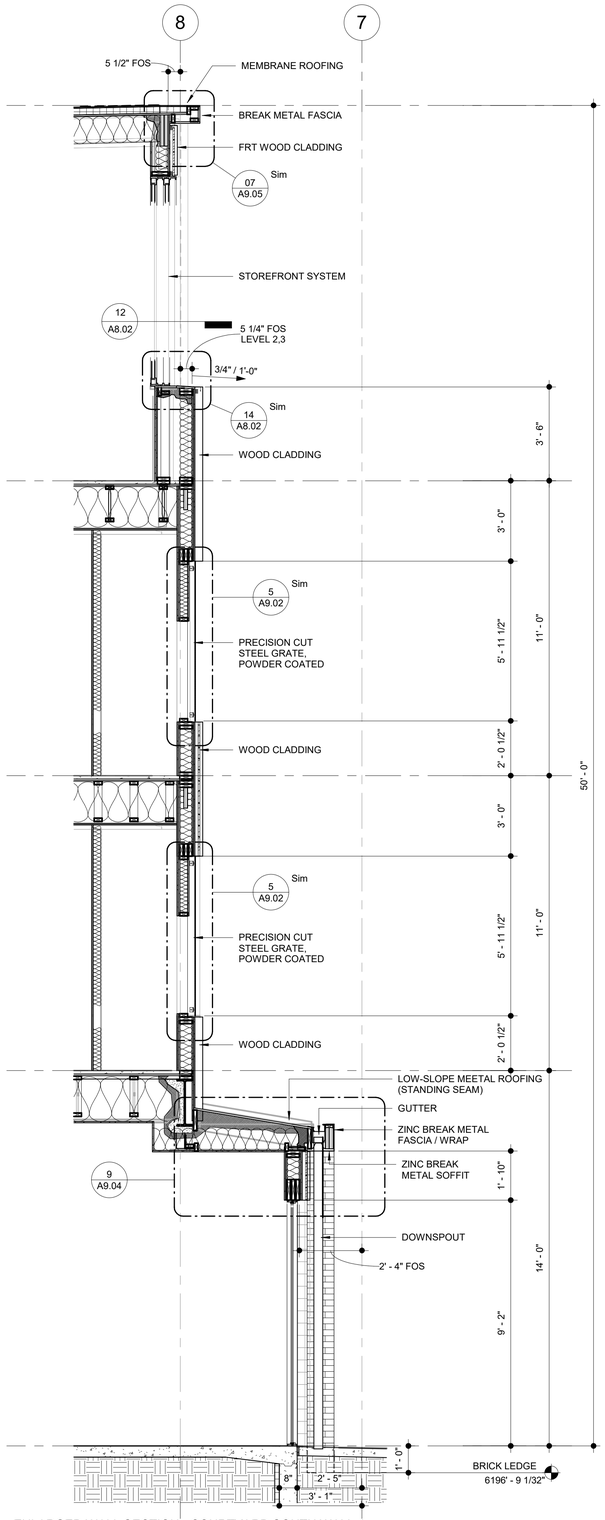

2 ENLARGED WALL SECTION - COURTYARD SOUTH WALL 4
3/8" = 1'-0"

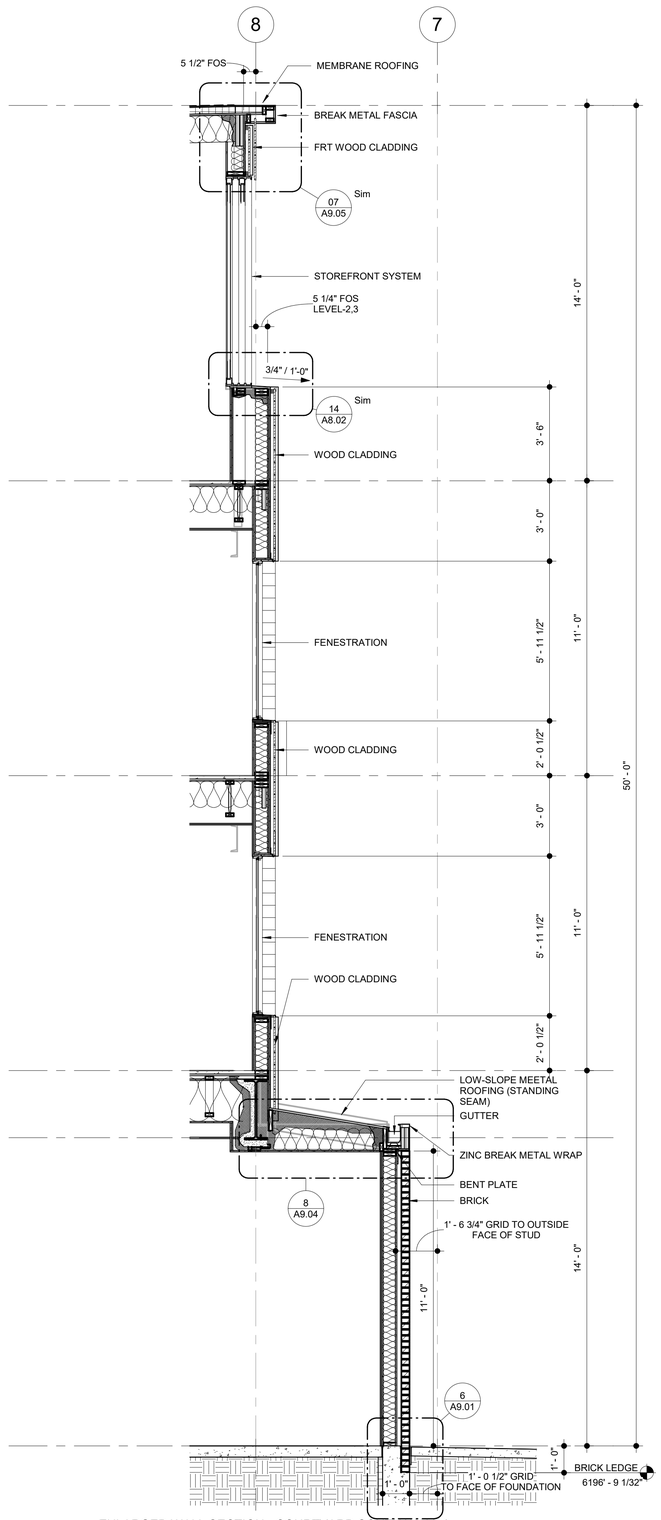

3 ENLARGED WALL SECTION - COURTYARD SOUTH WALL 3
3/8" = 1'-0"

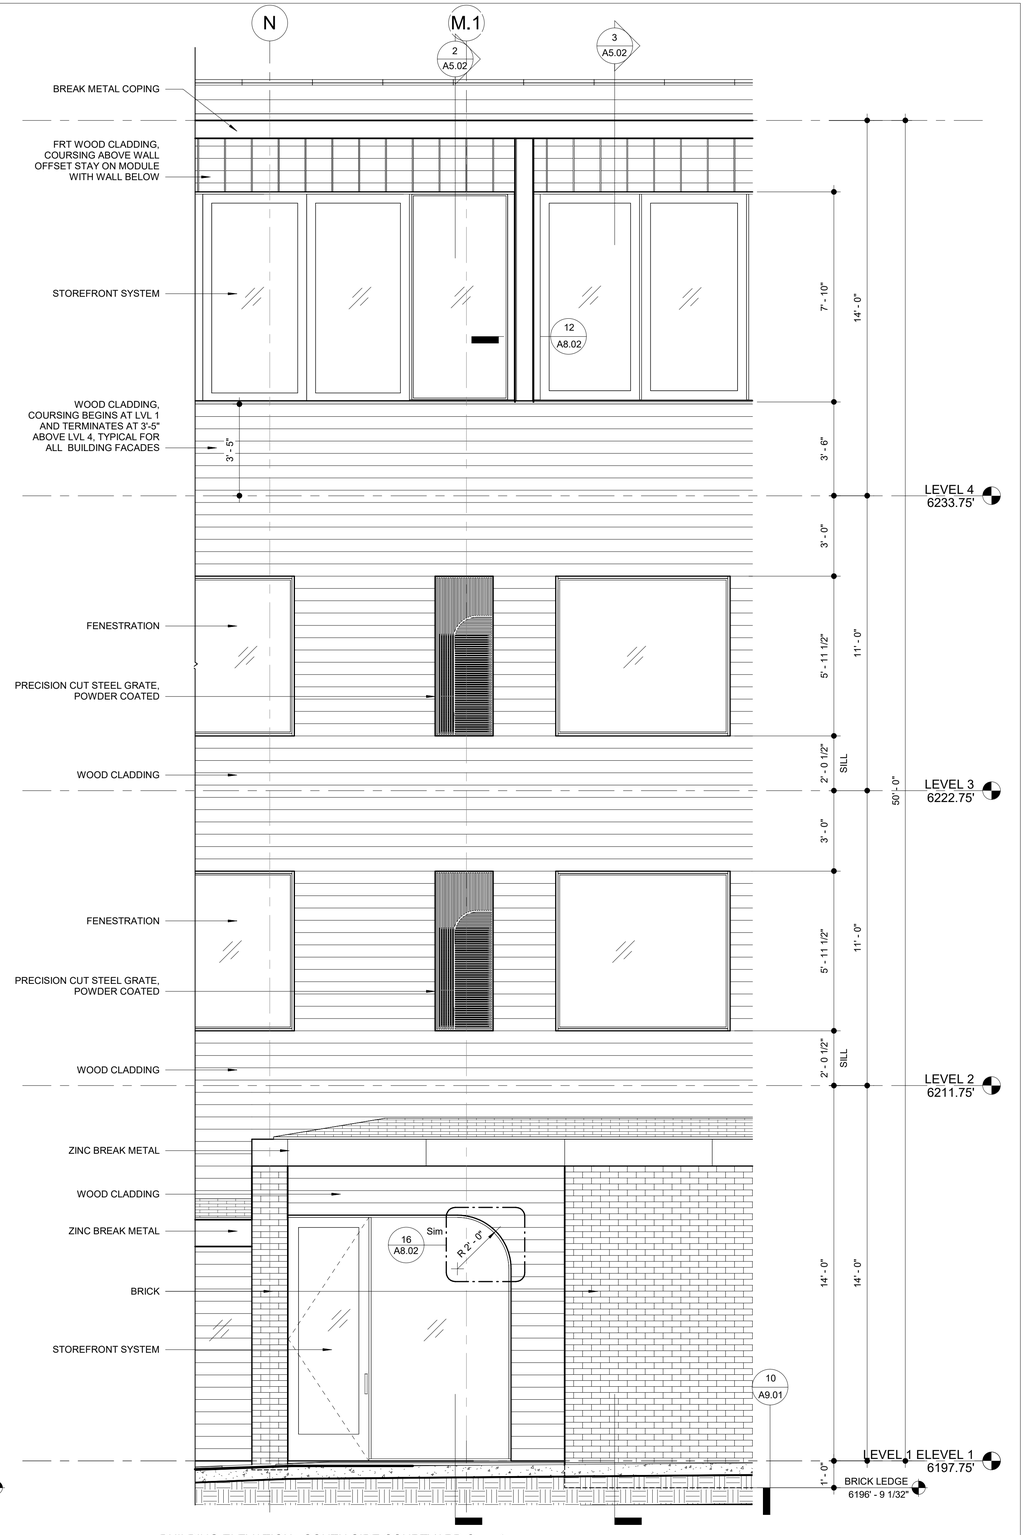

1 BUILDING ELEVATION - SOUTH SIDE COURTYARD Copy 1
3/8" = 1'-0"

HELTSHE

M1A | MERIDIAN 105 ARCHITECTURE

CITY HOTEL

415 PERRY STREET, CASTLE ROCK, CO.

DATE: 4.22.2026	ISSUED FOR: PERMIT	SHEET TITLE: ENLARGED WALL SECTIONS & ELEVATIONS	SHEET NUMBER A5.02
PROJ. NO. 2023.002			

C:\Users\daniel\Documents\City Hotel-2024_1_dljpscomb74Cd8.rvt

4/22/2026 1:07:48 PM

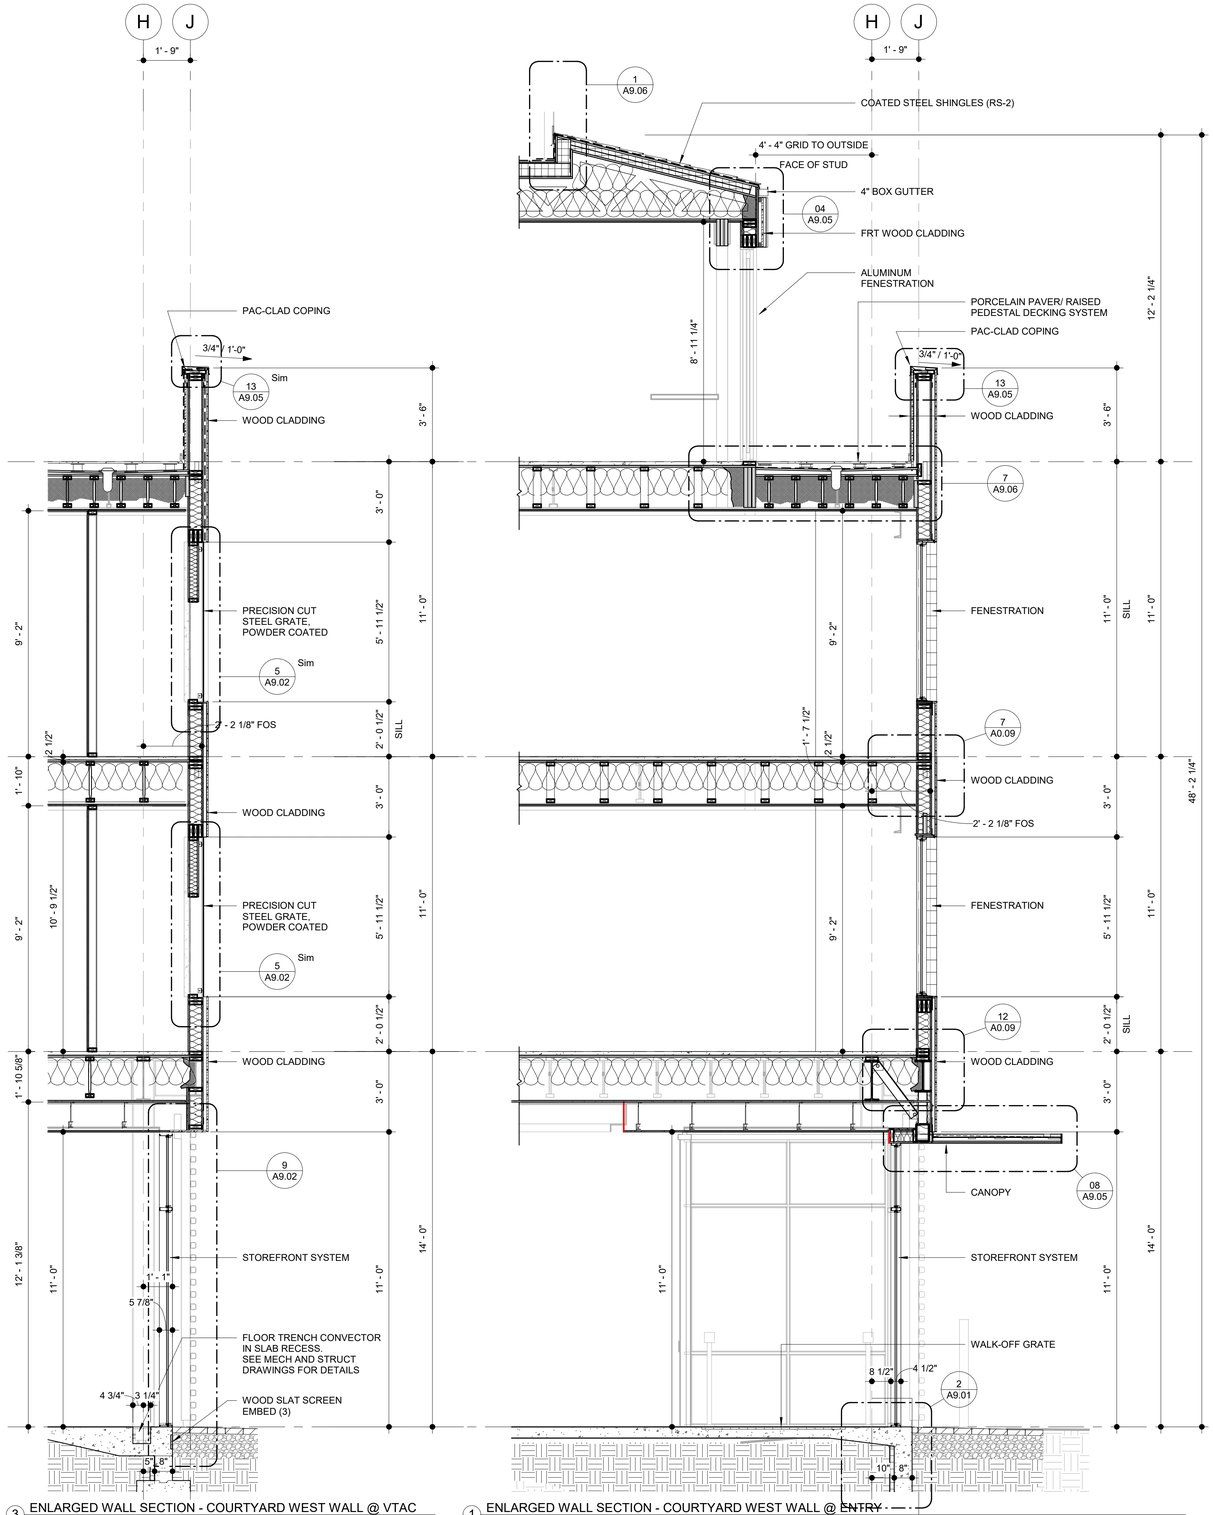

C:\Users\daniel\Documents\City Hotel-2024_1_dlipscomb74CJ8.rvt

4/22/2026 1:07:52 PM

HELTSHE

M1A | MERIDIAN 105 ARCHITECTURE

CITY HOTEL

415 PERRY STREET, CASTLE ROCK, CO.

DATE: 4.22.2026	ISSUED FOR: PERMIT	SHEET TITLE: ENLARGED WALL SECTIONS & ELEVATIONS	SHEET NUMBER A5.03
PROJ. NO. 2023.002			

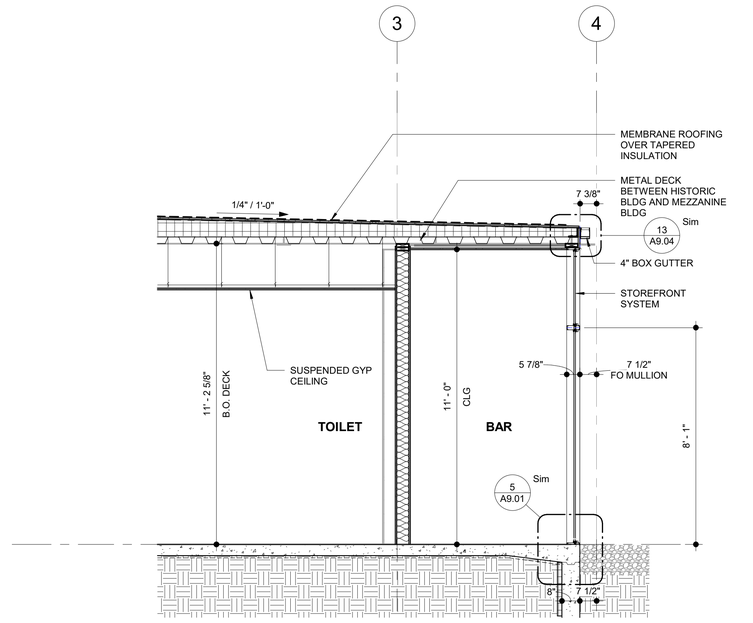

3 ENLARGED WALL SECTION - COURTYARD NORTH WALL 1
3/8" = 1'-0"

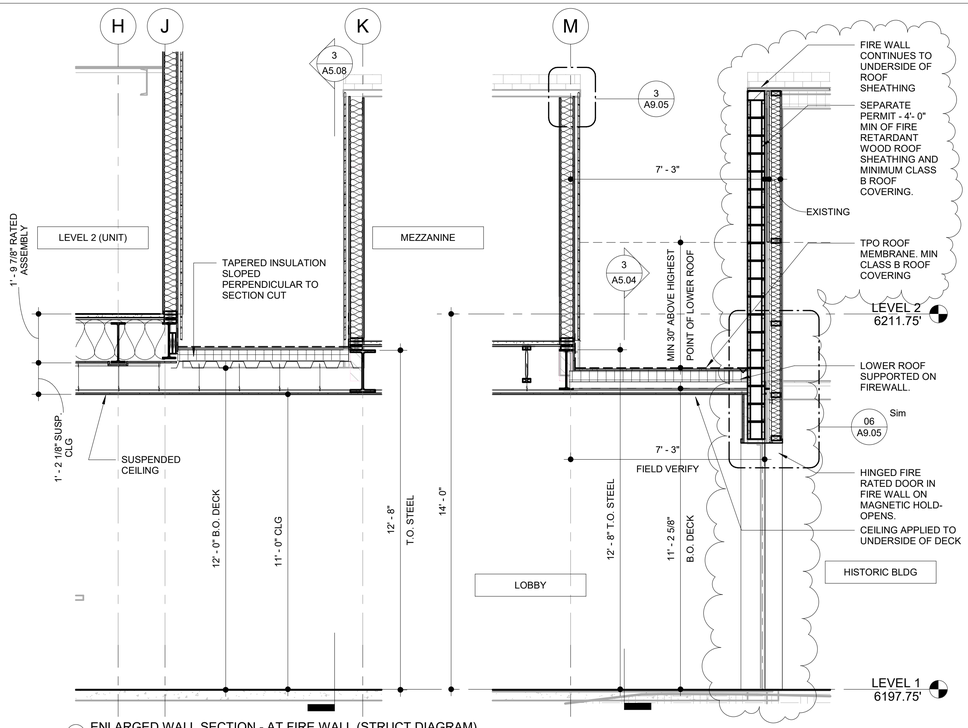

5 ENLARGED WALL SECTION - AT FIRE WALL (STRUCT DIAGRAM)
3/8" = 1'-0"

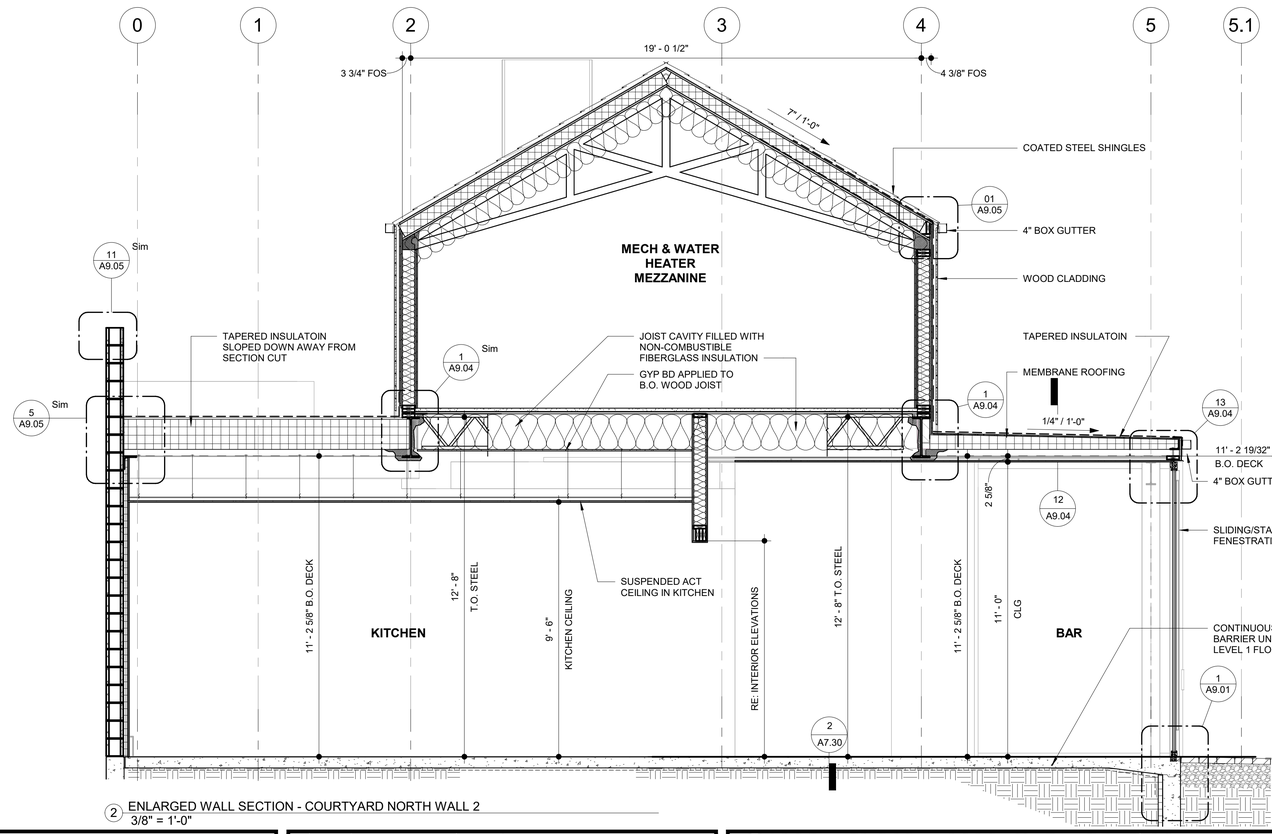

2 ENLARGED WALL SECTION - COURTYARD NORTH WALL 2
3/8" = 1'-0"

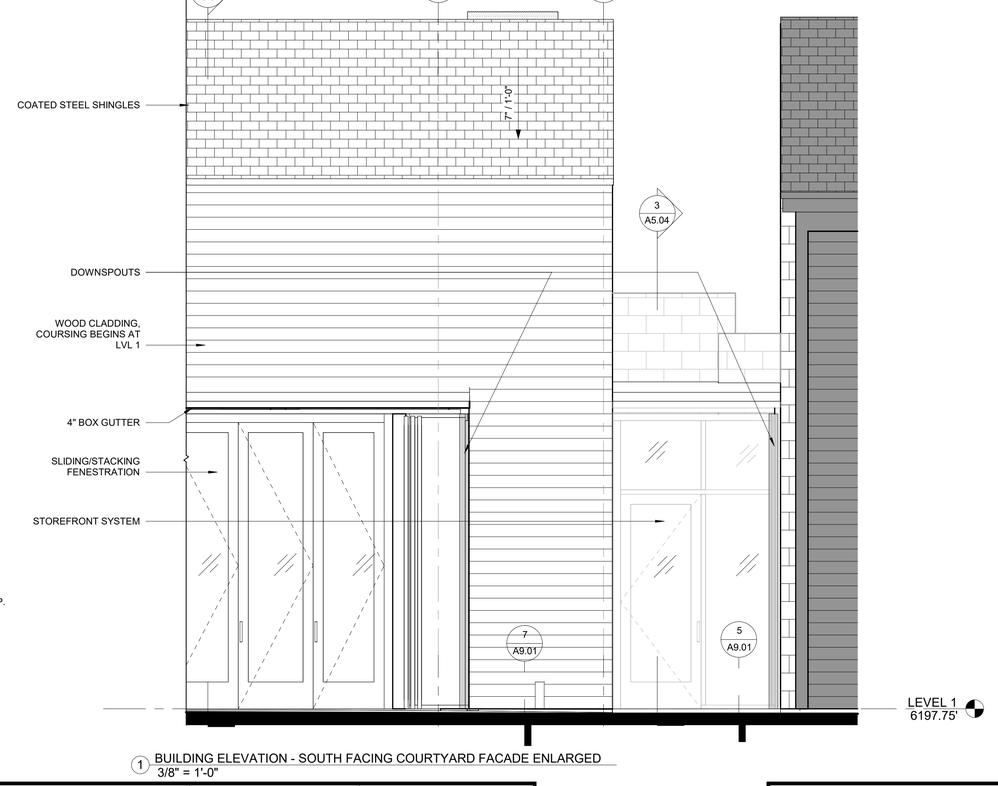

1 BUILDING ELEVATION - SOUTH FACING COURTYARD FACADE ENLARGED
3/8" = 1'-0"

HELTSHE

M1A MERIDIAN 105 ARCHITECTURE

CITY HOTEL
415 PERRY STREET, CASTLE ROCK, CO.

DATE: 4.22.2026	ISSUED FOR: PERMIT	SHEET TITLE: ENLARGED WALL SECTIONS & ELEVATIONS	SHEET NUMBER A5.04
PROJ. NO. 2023.002			

C:\Users\daniel\Documents\City Hotel-2024_1_dlipscomb74CJ8.rvt

4/22/2026 1:07:56 PM

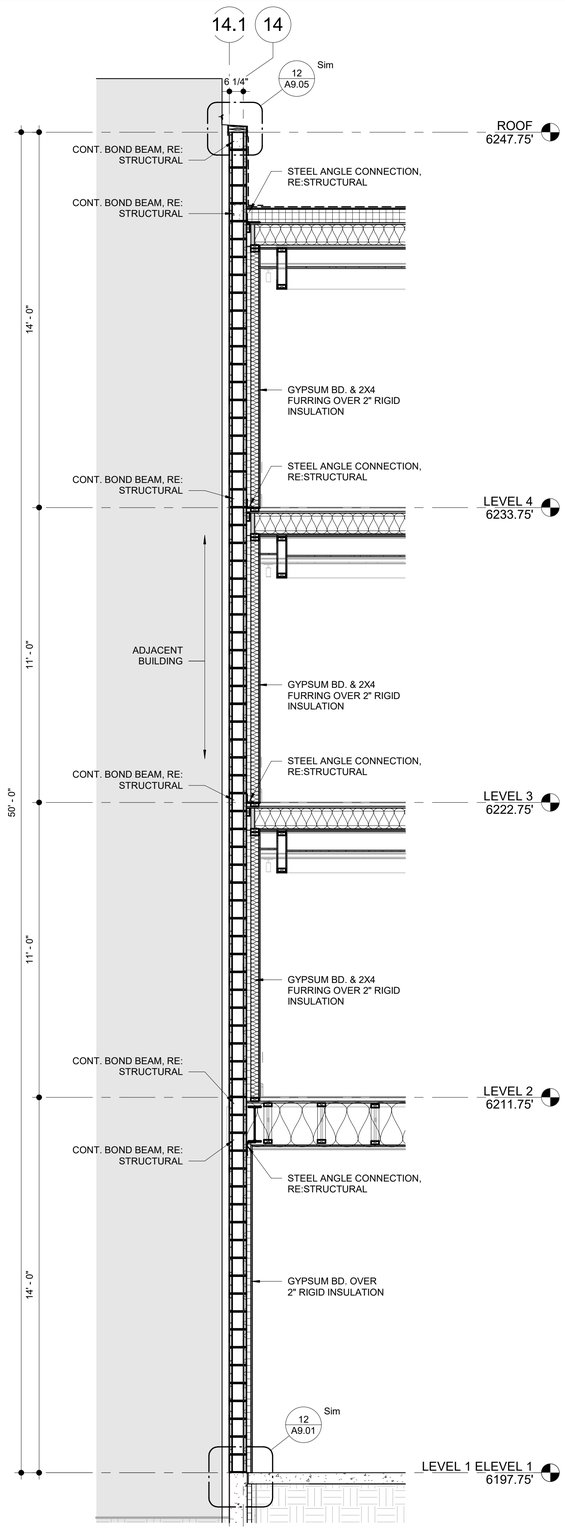

3 BUILDING SECTION - SOUTH FACADE THROUGH MASONRY
3/8" = 1'-0"

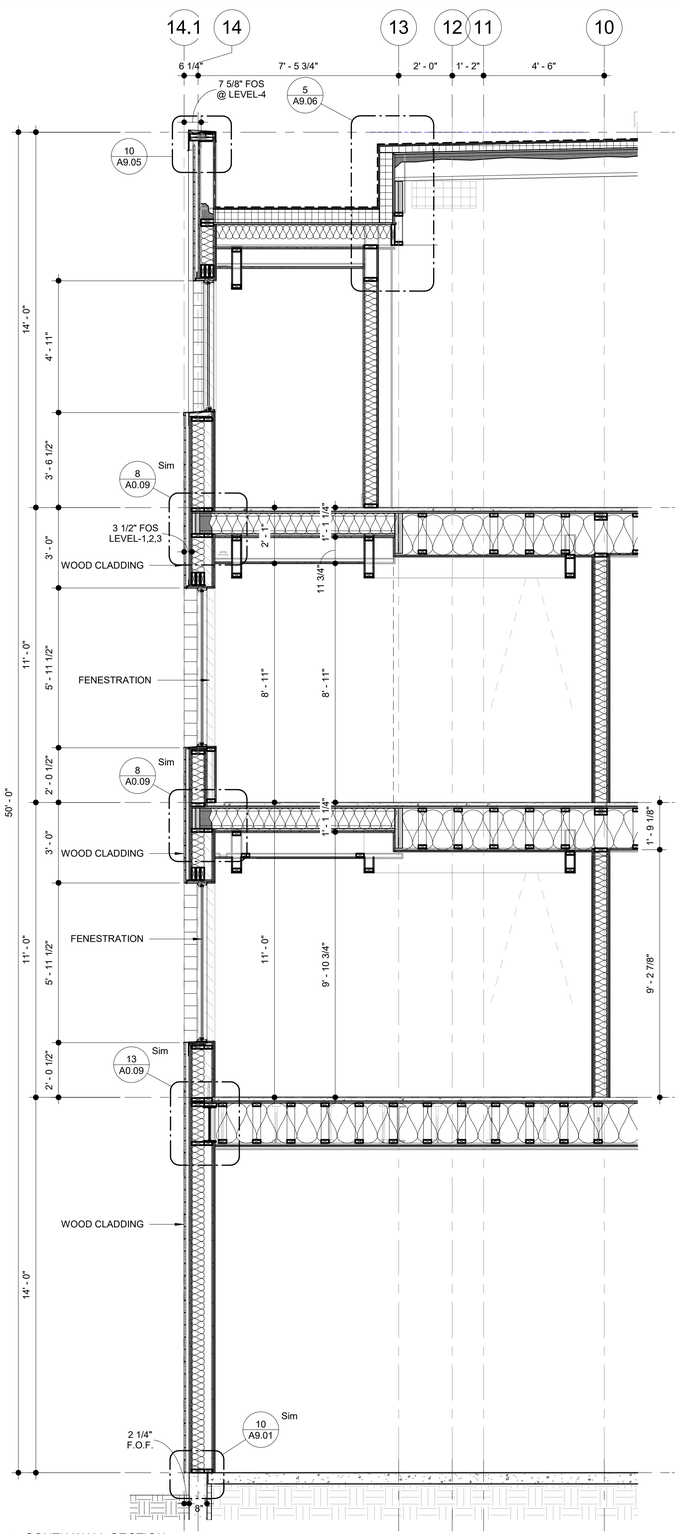

4 SOUTH WALL SECTION
3/8" = 1'-0"

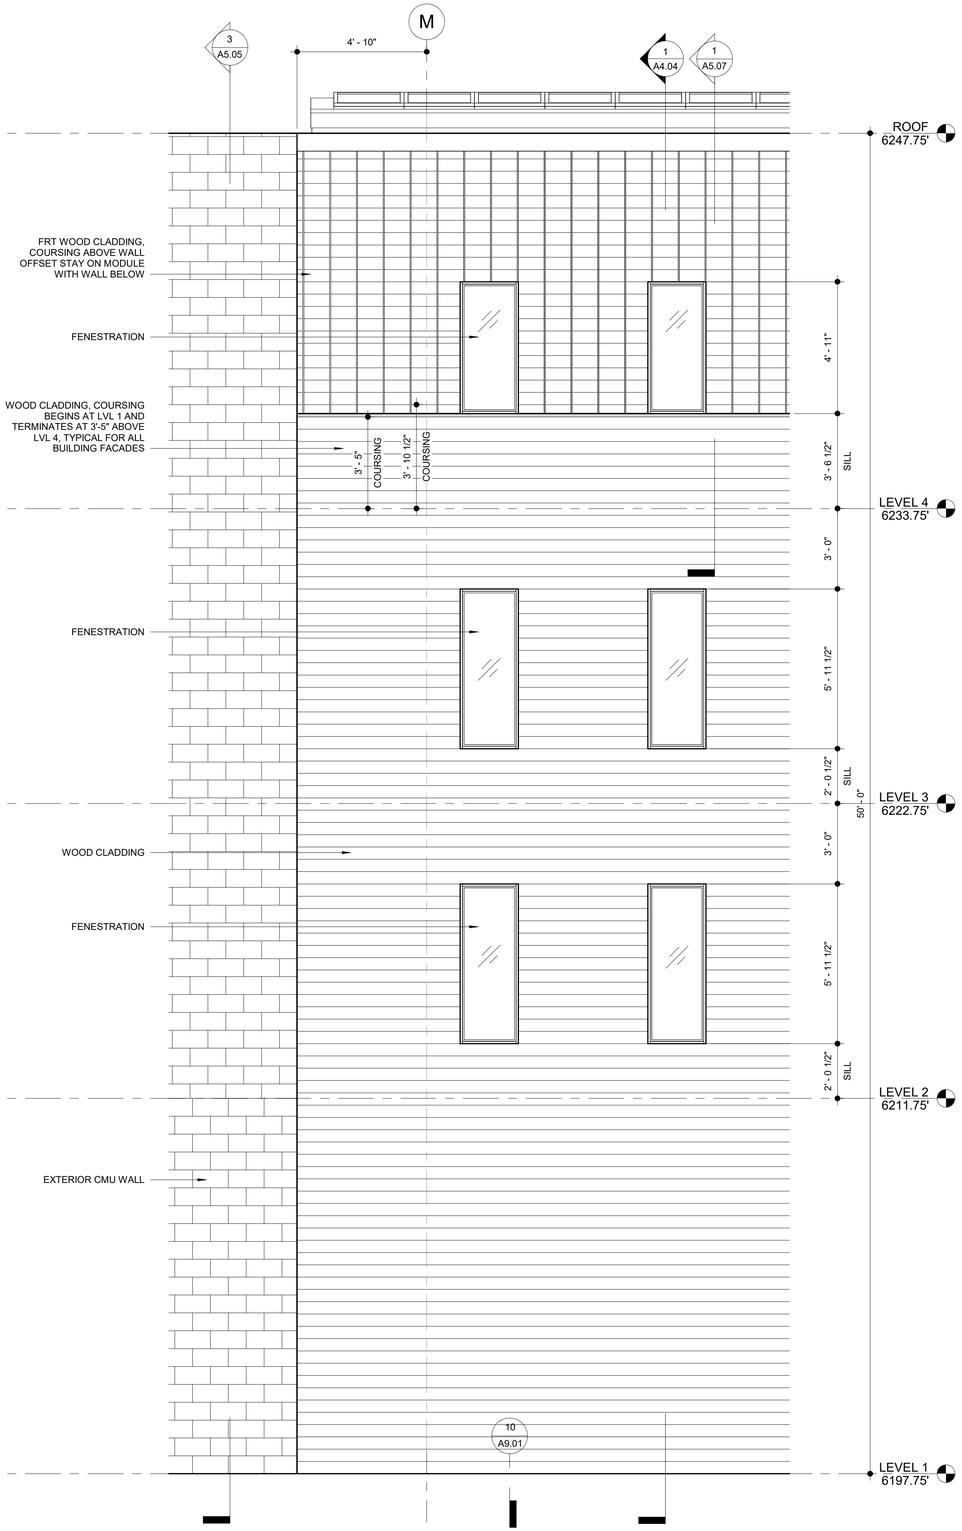

1 BUILDING ELEVATION - SOUTH FACING FACADE - Callout 1
3/8" = 1'-0"

HELTSHE

M1A | MERIDIAN 105 ARCHITECTURE

CITY HOTEL

415 PERRY STREET, CASTLE ROCK, CO.

DATE: 4.22.2026	ISSUED FOR: PERMIT	SHEET TITLE: ENLARGED WALL SECTIONS & ELEVATIONS	SHEET NUMBER A5.05
PROJ. NO. 2023.002			

C:\Users\daniel\Documents\City Hotel-2024_1_dljpscomb74CJB.rvt

4/22/2026 1:07:59 PM

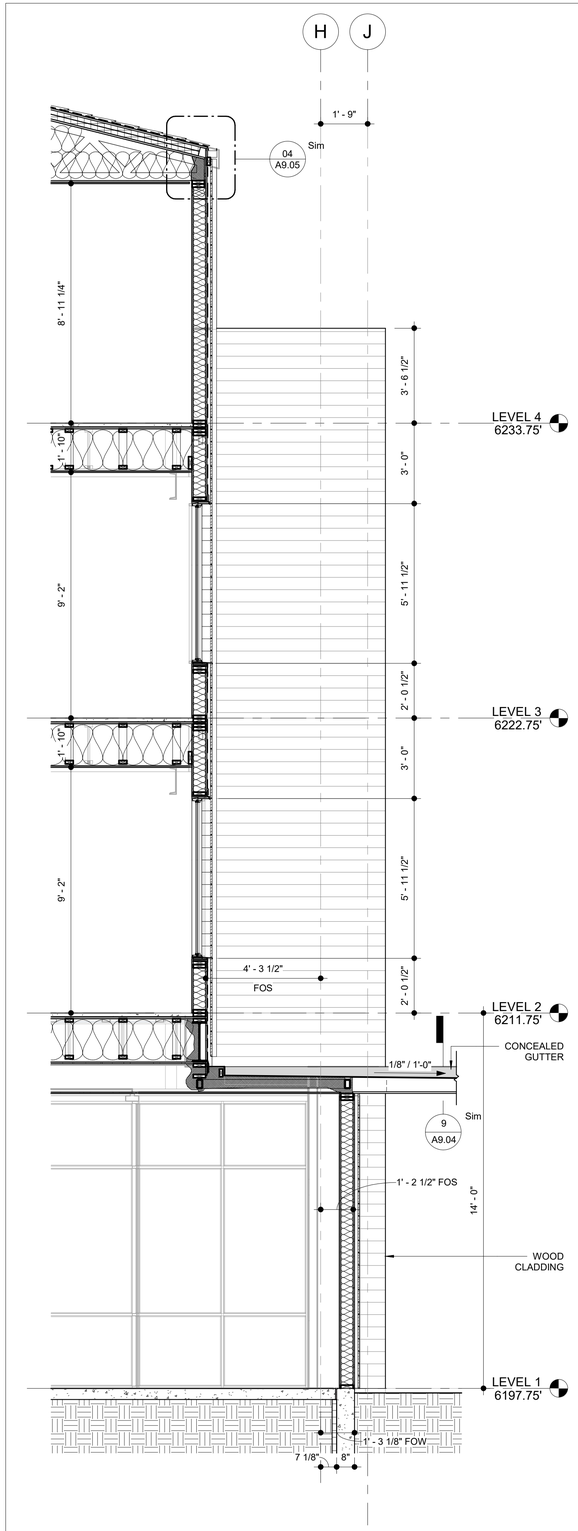

3 ENLARGED WALL SECTION - BUILDING NOTCH GL-C
3/8" = 1'-0"

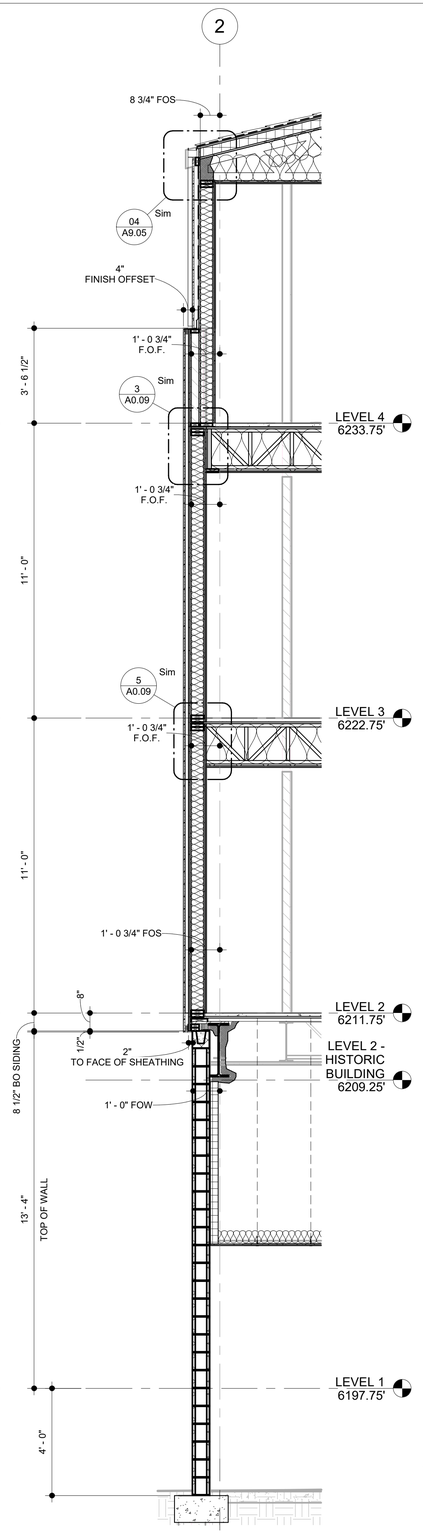

4 WALL - NORTHWEST CORNER
3/8" = 1'-0"

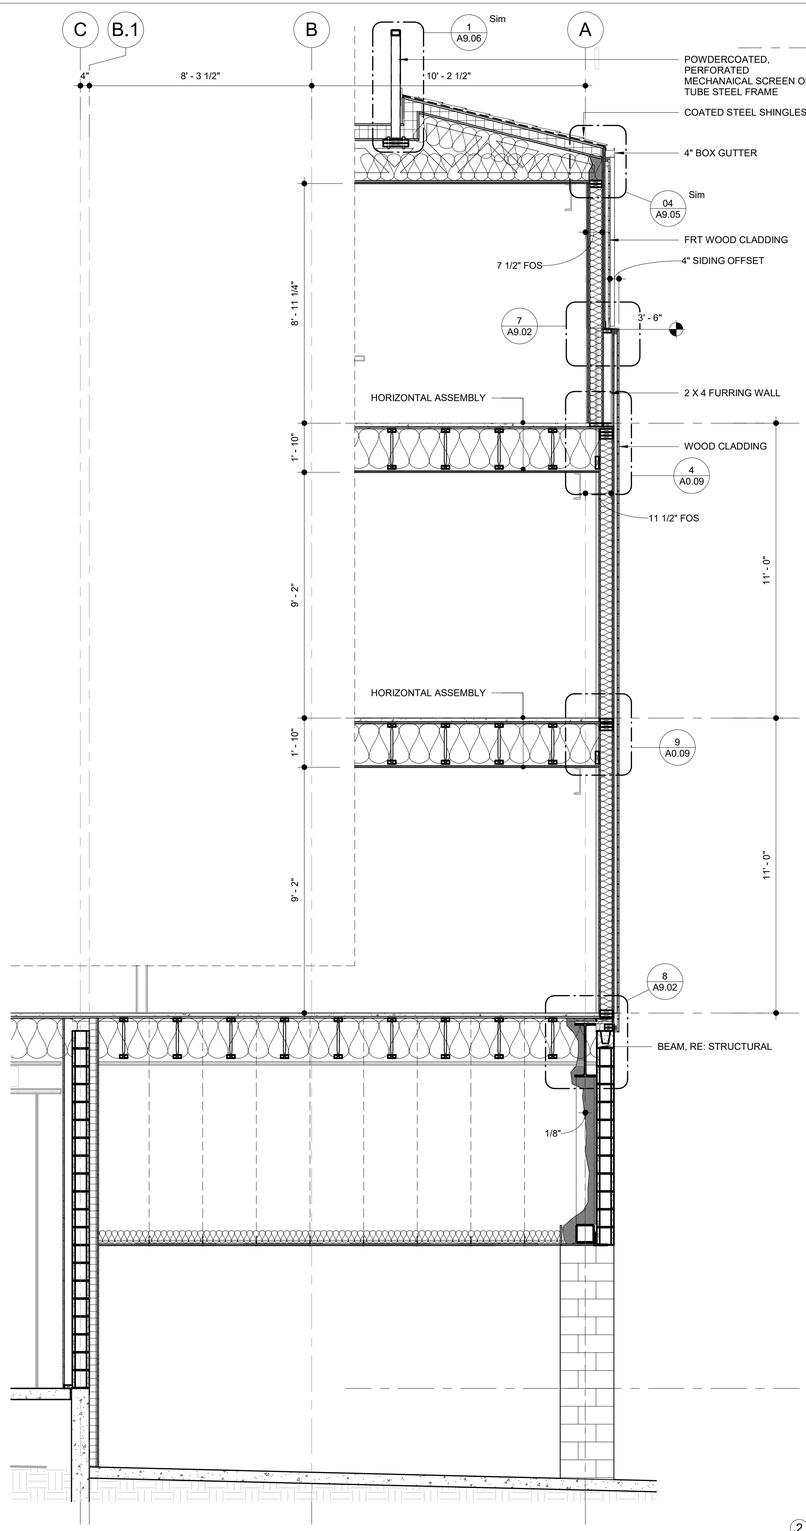

1 WALL SECTION WEST ALLEY
3/8" = 1'-0"

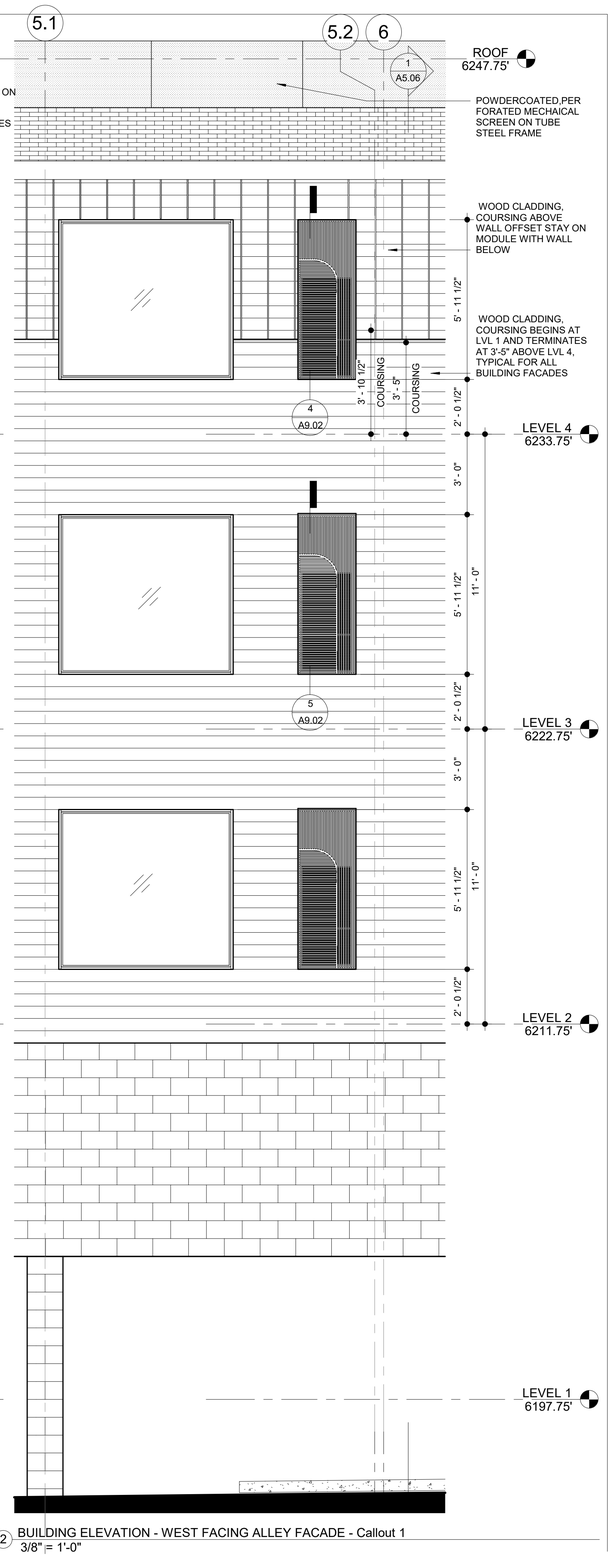

2 BUILDING ELEVATION - WEST FACING ALLEY FACADE - Callout 1
3/8" = 1'-0"

HELTSHE

M1A | MERIDIAN 105 ARCHITECTURE

CITY HOTEL

415 PERRY STREET, CASTLE ROCK, CO.

DATE: 4.22.2026	ISSUED FOR: PERMIT	SHEET TITLE: ENLARGED WALL SECTIONS & ELEVATIONS
PROJ. NO. 2023.002		

SHEET NUMBER
A5.06

C:\Users\daniel\Documents\City Hotel-2024_1_dlipscomb74Cd8.rvt

4/22/2026 1:08:03 PM

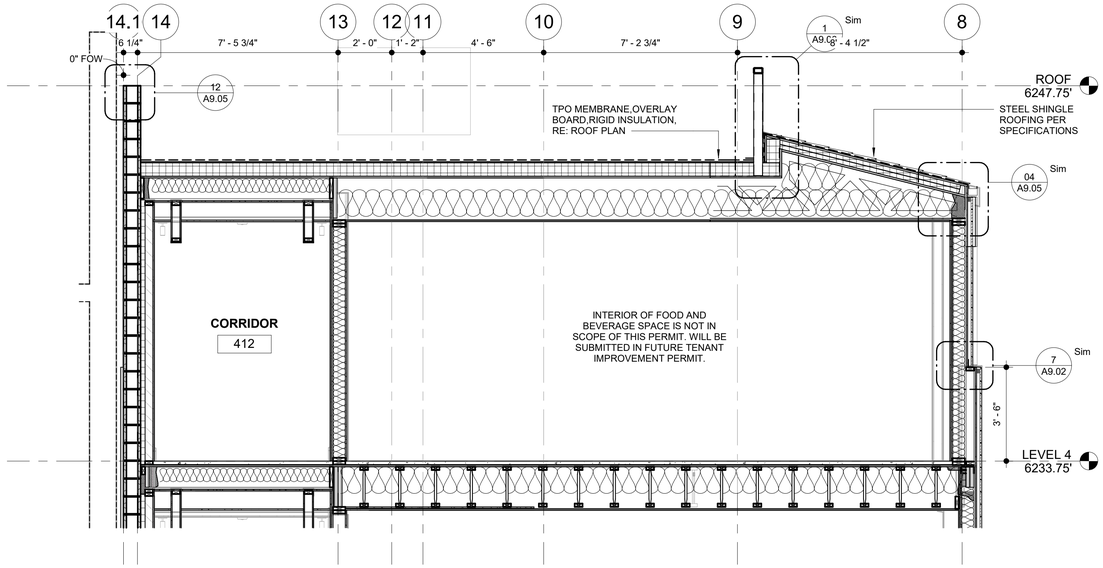

3 BUILDING SECTION - NORTH/SOUTH SPEAKEASY
3/8" = 1'-0"

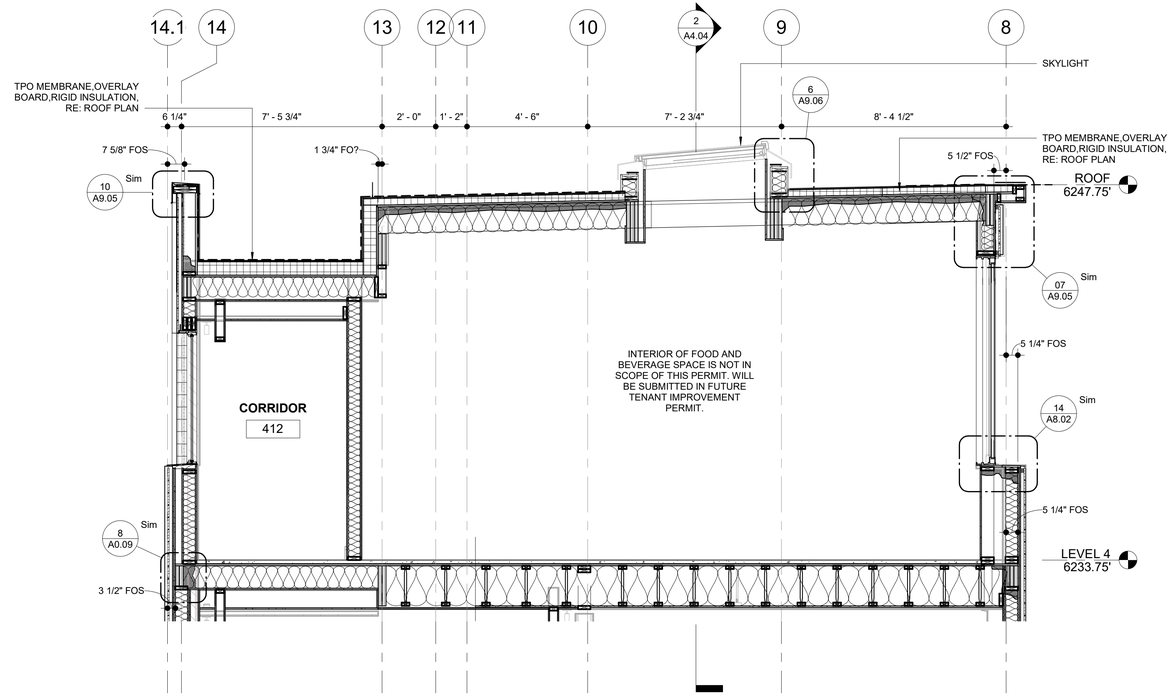

1 BUILDING SECTION - NORTH/SOUTH CURVED ROOF
3/8" = 1'-0"

HELTSHE

M1A | MERIDIAN 105 ARCHITECTURE

CITY HOTEL
415 PERRY STREET, CASTLE ROCK, CO.

DATE: 4.22.2026	ISSUED FOR: PERMIT	SHEET TITLE: ENLARGED WALL SECTIONS	SHEET NUMBER A5.07
PROJ. NO. 2023.002			

C:\Users\daniel\Documents\City Hotel-2024_1_dlipscomb74CJ8.rvt

4/22/2026 1:08:05 PM

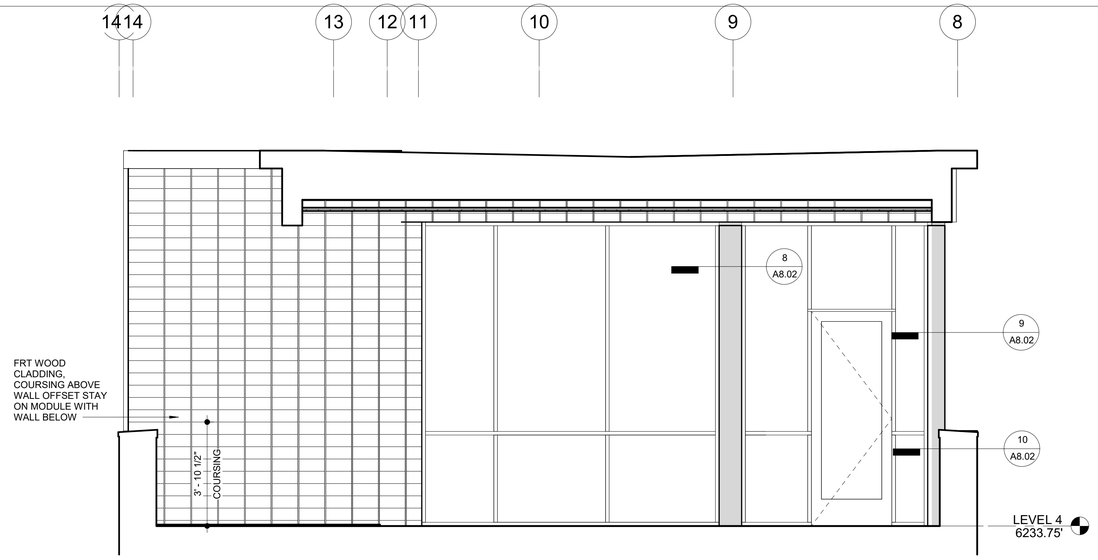

4 DECK BAR EXTERIOR ELEVATION - WEST
3/8" = 1'-0"

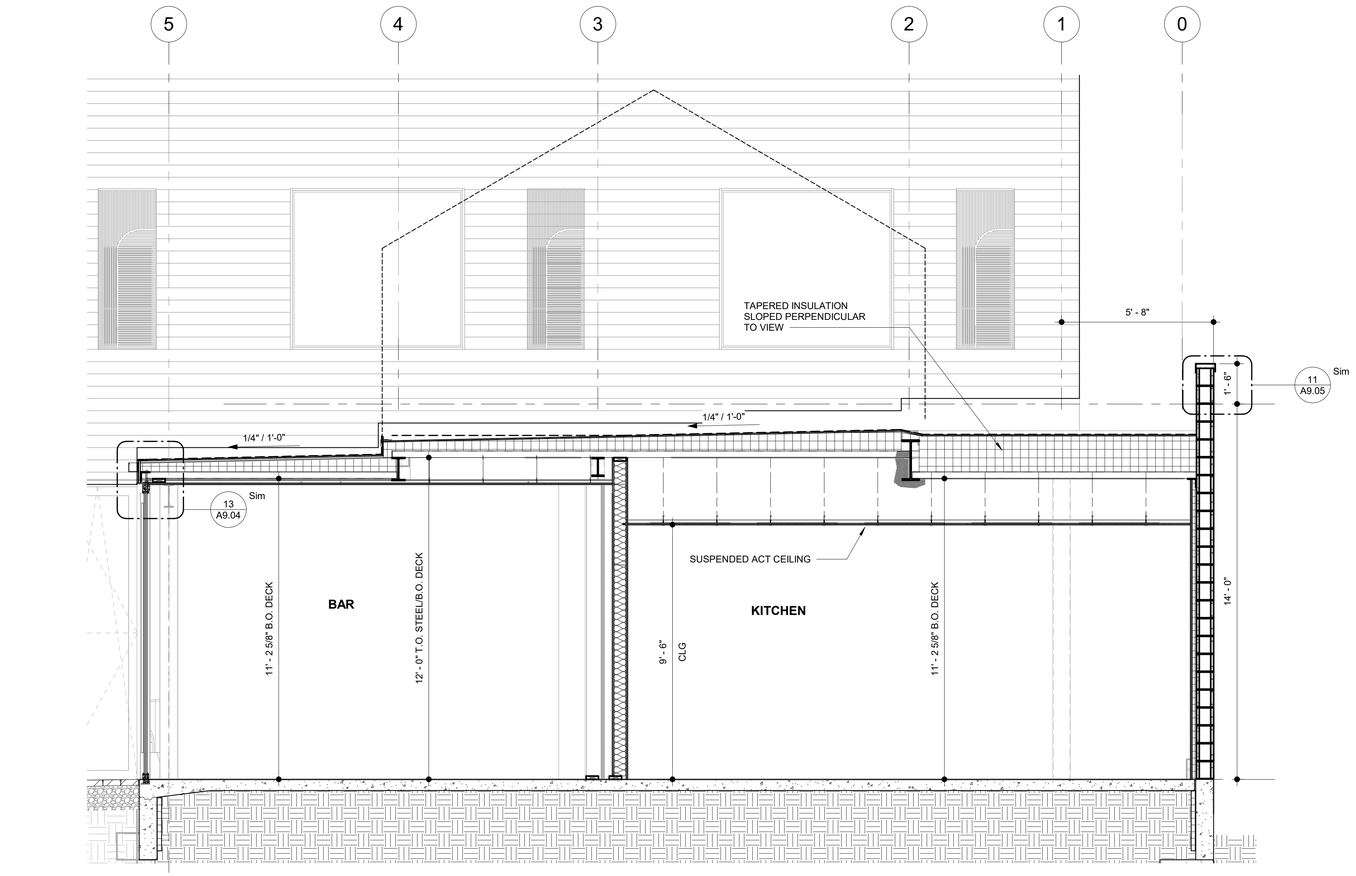

3 ENLARGED WALL SECTION - COURTYARD NORTH WALL 3
3/8" = 1'-0"

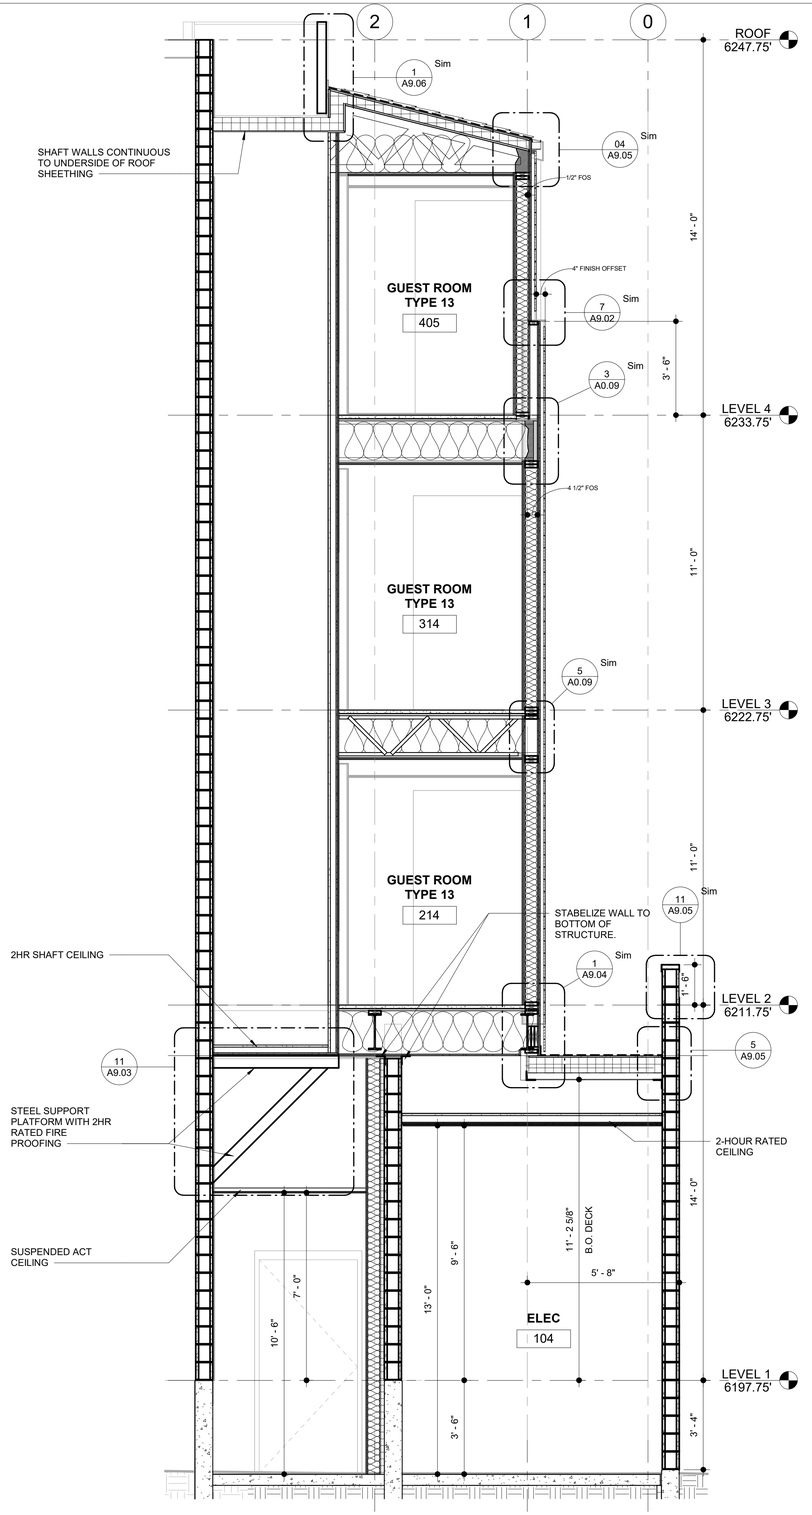

1 WALL SECTION - NORTH WALL @ SHAFT
3/8" = 1'-0"

C:\Users\daniel\Documents\City Hotel-2024_1_dljpscomb74Cs8.rvt

4/22/2026 1:08:08 PM

HELTSHE

M1A | MERIDIAN 105 ARCHITECTURE

CITY HOTEL

415 PERRY STREET, CASTLE ROCK, CO.

DATE: 4.22.2026	ISSUED FOR: PERMIT	SHEET TITLE: ENLARGED WALL SECTIONS	SHEET NUMBER A5.08
PROJ. NO. 2023.002			

TAKE-OFF LEGEND - A6.00 (partition schedule order)

- FW.1-0 - BOARD ONLY (WOOD FRAMING EXCLUDED) - 2 wall(s) - 18.79 LF
- FW.2-0 - BOARD ONLY (WOOD FRAMING EXCLUDED) - 1 wall(s) - 1.71 LF
- FW.4-0 - BOARD ONLY (WOOD FRAMING EXCLUDED) - 1 wall(s) - 2.93 LF

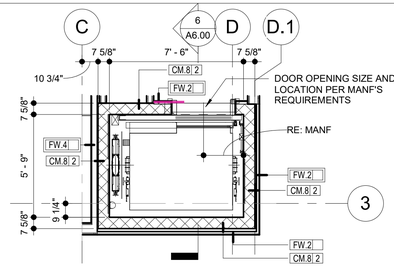

5 ENLARGED PLAN - SERVICE ELEVATOR - LVL 4
1/4" = 1'-0"

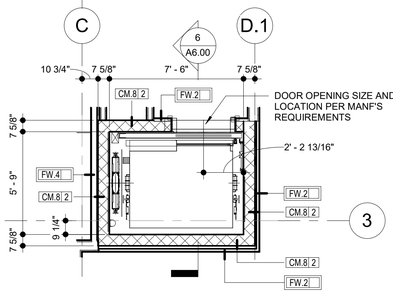

4 ENLARGED PLAN - SERVICE ELEVATOR - LVL 3
1/4" = 1'-0"

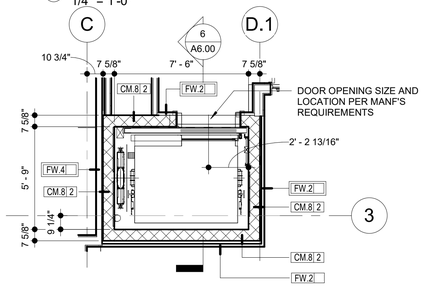

3 ENLARGED PLAN - SERVICE ELEVATOR - LVL 2
1/4" = 1'-0"

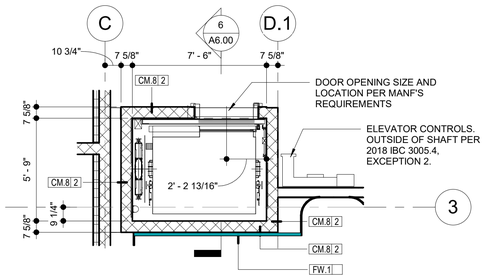

1 ENLARGED PLAN - SERVICE ELEVATOR - LVL 1
1/4" = 1'-0"

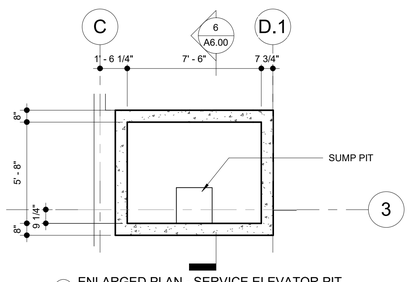

2 ENLARGED PLAN - SERVICE ELEVATOR PIT
1/4" = 1'-0"

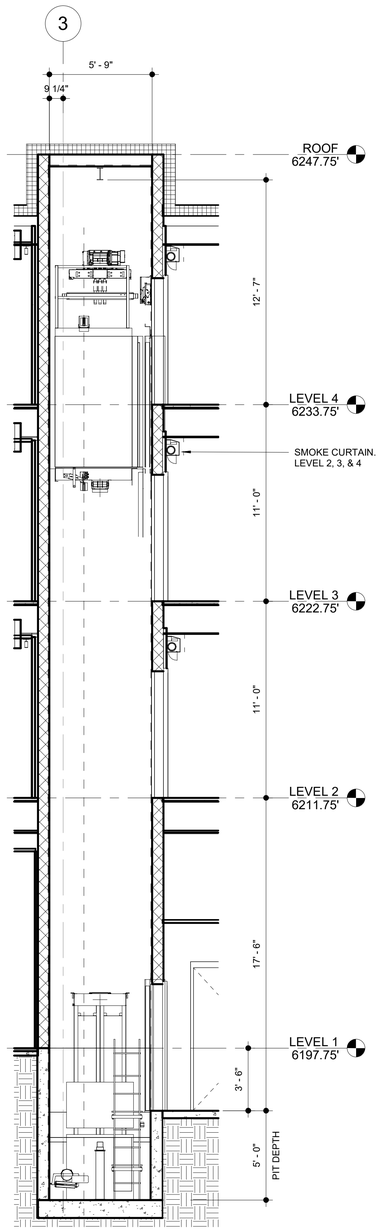

6 ENLARGED SECTION - SERVICE ELEVATOR
1/4" = 1'-0"

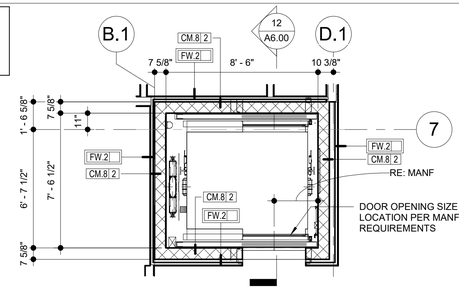

9 ENLARGED PLAN - LOBBY ELEVATOR - LVL 4
1/4" = 1'-0"

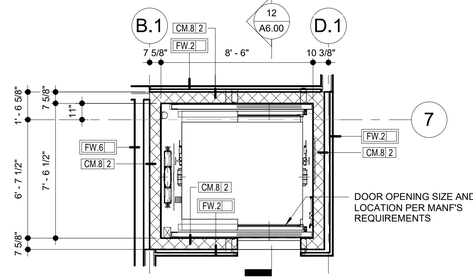

10 ENLARGED PLAN - LOBBY ELEVATOR - LVL 3
1/4" = 1'-0"

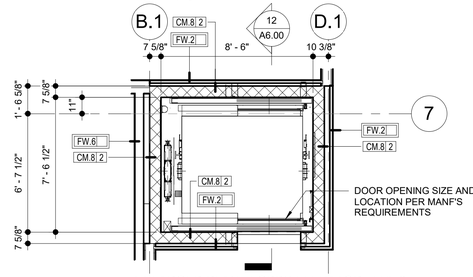

11 ENLARGED PLAN - LOBBY ELEVATOR - LVL 2
1/4" = 1'-0"

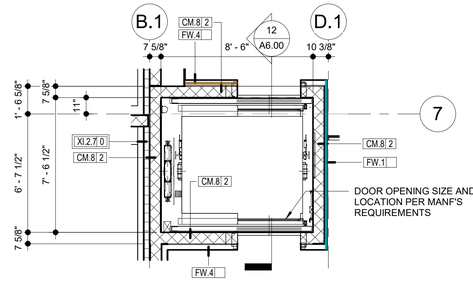

8 ENLARGED PLAN - LOBBY ELEVATOR - LVL 1
1/4" = 1'-0"

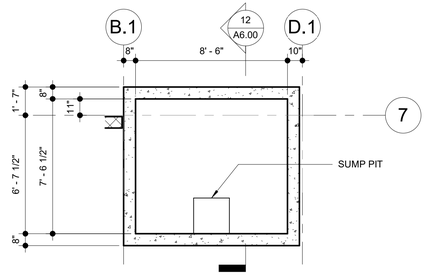

7 ENLARGED PLAN - LOBBY ELEVATOR PIT
1/4" = 1'-0"

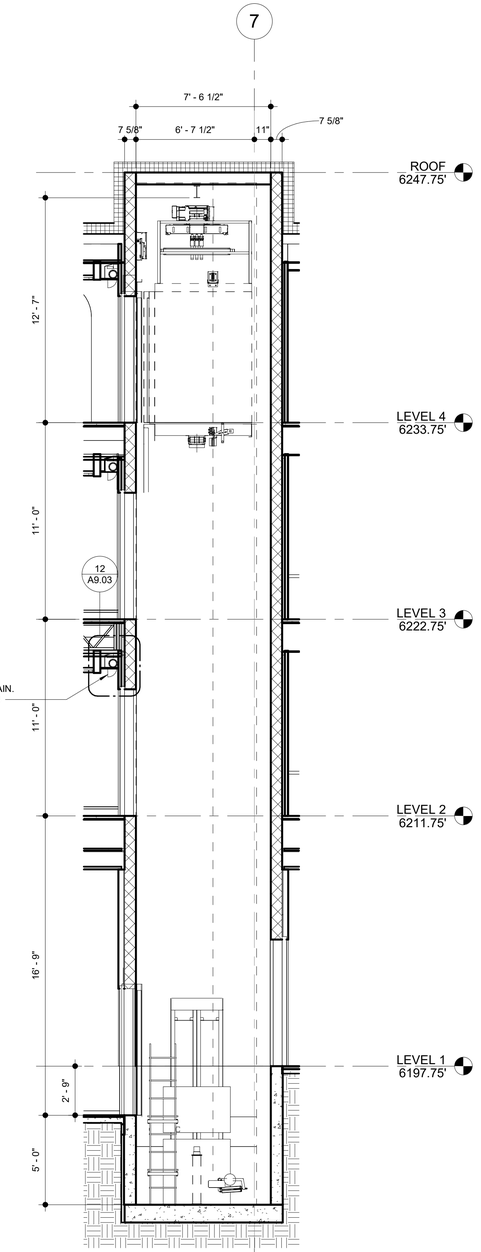

12 ENLARGED SECTION - LOBBY ELEVATOR
1/4" = 1'-0"

HELTSHE

M1A | MERIDIAN 105 ARCHITECTURE

CITY HOTEL

415 PERRY STREET, CASTLE ROCK, CO.

DATE: 4.22.2026	ISSUED FOR: PERMIT	SHEET TITLE: ELEVATOR PLANS & SECTIONS	SHEET NUMBER A6.00
PROJ. NO. 2023.002			

C:\Users\daniel\Documents\City Hotel-2024_1_dlipscomb74CJ8.rvt

4/22/2026 1:08:14 PM

TAKE-OFF LEGEND - A6.01 (partition schedule order)

FW.1-0 - BOARD ONLY (WOOD FRAMING EXCLUDED) - 3 wall(s) - 31.60 LF

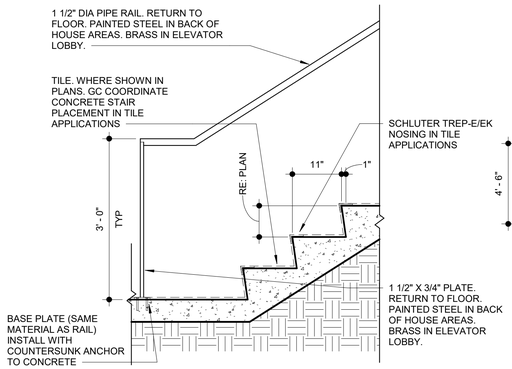

1 CONCRETE STAIR SECTION
3/4" = 1'-0"

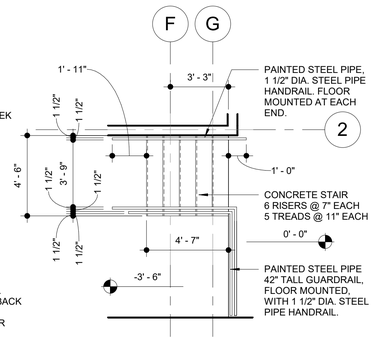

2 ENLARGED PLAN - NORTH RAMP - LVL 1
1/4" = 1'-0"

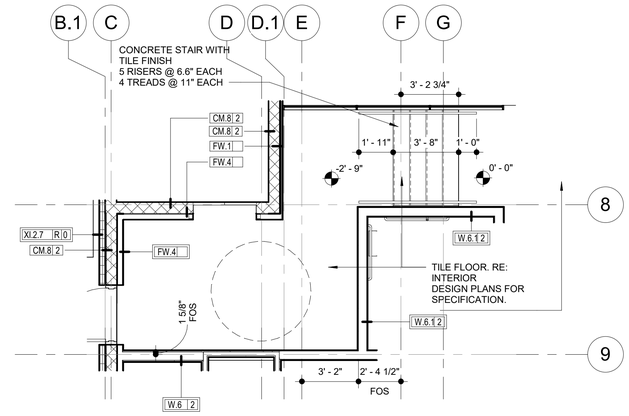

3 ENLARGED PLAN - LOBBY SERVICE STAIR - LVL 1
1/4" = 1'-0"

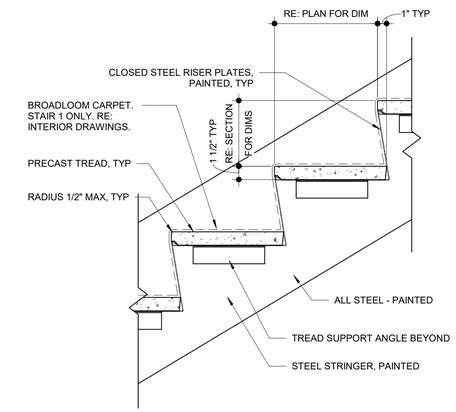

4 STAIR TREAD PRECAST
1 1/2" = 1'-0"

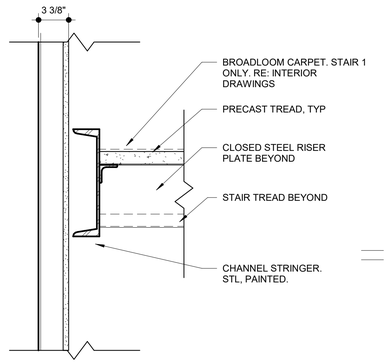

5 STAIR STRINGER
1 1/2" = 1'-0"

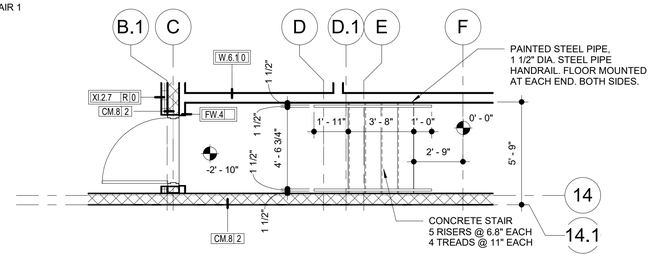

6 ENLARGED PLAN - RETAIL SERVICE STAIR - LVL 1
1/4" = 1'-0"

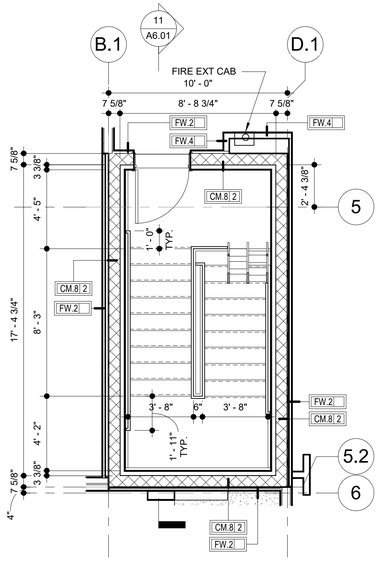

7 ENLARGED PLAN - LOBBY STAIR - LVL 4
1/4" = 1'-0"

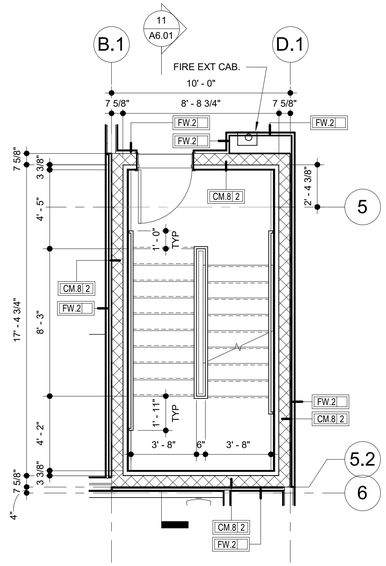

8 ENLARGED PLAN - LOBBY STAIR - LVL 3
1/4" = 1'-0"

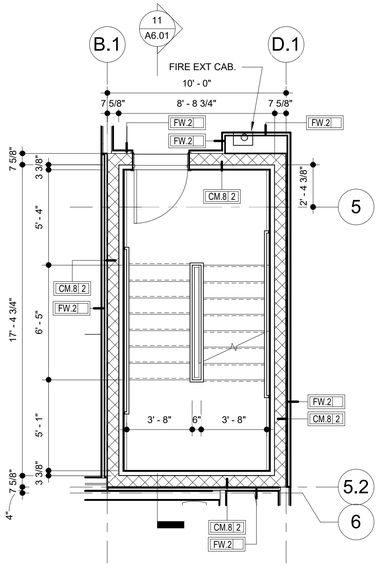

9 ENLARGED PLAN - LOBBY STAIR - LVL 2
1/4" = 1'-0"

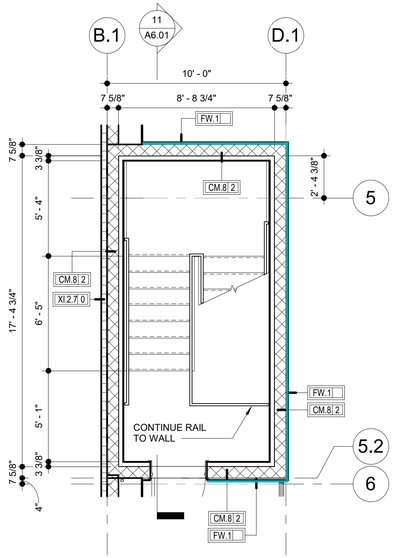

10 ENLARGED PLAN - LOBBY STAIR - LVL 1
1/4" = 1'-0"

STAIRS - GENERAL NOTES

1. **ALL OVERALL STAIR ENCLOSURE DIMENSIONS ARE TO FACE OF FINISH U.O.N.**
2. ALL HANDRAIL EXTENSIONS AT WALL ARE TO BE EQUAL TO STAIR TREAD AT BASE OF STAIR RUN AND 1'-0" AT TOP OF STAIR RUN PER CODE.
3. ALL HANDRAILS AT WALL TO BE 1-1/2" DIA. PIPE RAIL AND LOCATED 1-1/2" AWAY FROM FINISHED FACE OF WALL PER CODE.

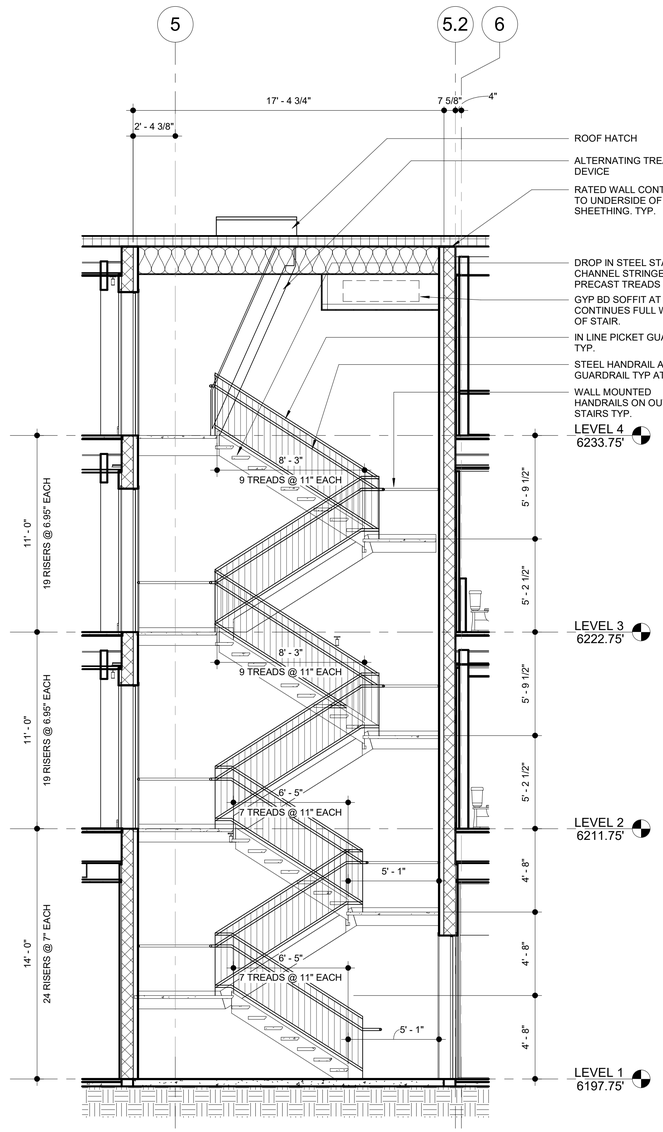

11 ENLARGED SECTION - LOBBY STAIR
1/4" = 1'-0"

C:\Users\daniel\Documents\City Hotel-2024_1_dlipscomb74CJ8.rvt

4/22/2026 1:08:20 PM

HELTSHE

M1A | MERIDIAN 105 ARCHITECTURE

CITY HOTEL

415 PERRY STREET, CASTLE ROCK, CO.

DATE: 4.22.2026	ISSUED FOR: PERMIT	SHEET TITLE: LOBBY STAIR PLANS & SECTIONS	SHEET NUMBER A6.01
PROJ. NO. 2023.002			

TAKE-OFF LEGEND - A6.02 (gypsum board ceilings / soffits)

blue area = gyp bd ceiling / soffit: 1 areas, 151.85 SF (Contents: board - ceiling tag - room - SF - ceiling height - detail - id)

measure: /Measure at the printed scale of the sheet; SF = Excel row (ceiling id)

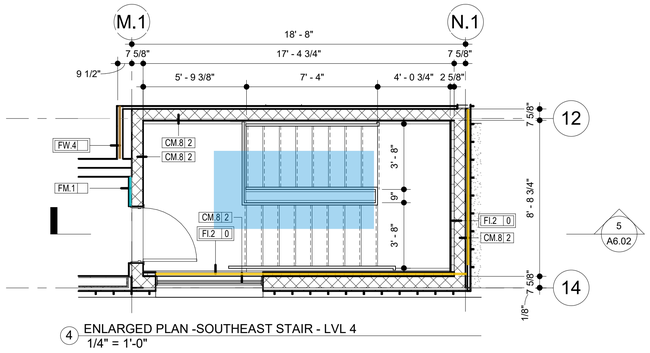

4 ENLARGED PLAN -SOUTHEAST STAIR - LVL 4
1/4" = 1'-0"

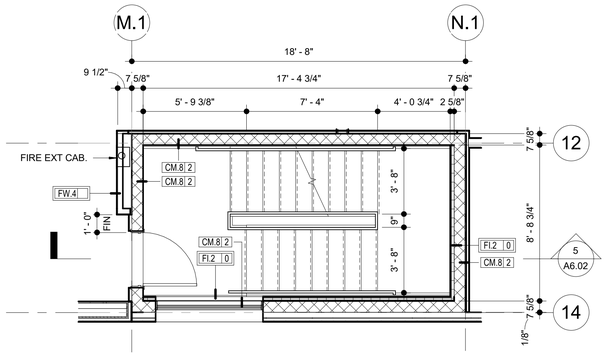

3 ENLARGED PLAN -SOUTHEAST STAIR - LVL 3
1/4" = 1'-0"

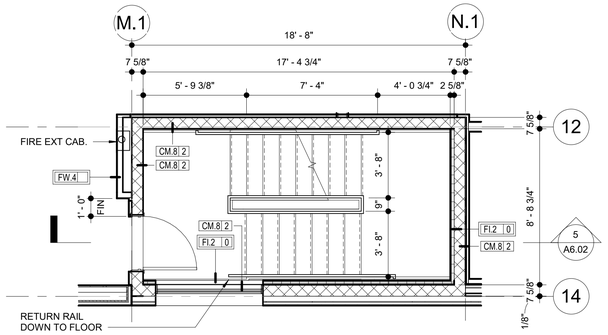

2 ENLARGED PLAN -SOUTHEAST STAIR - LVL 2
1/4" = 1'-0"

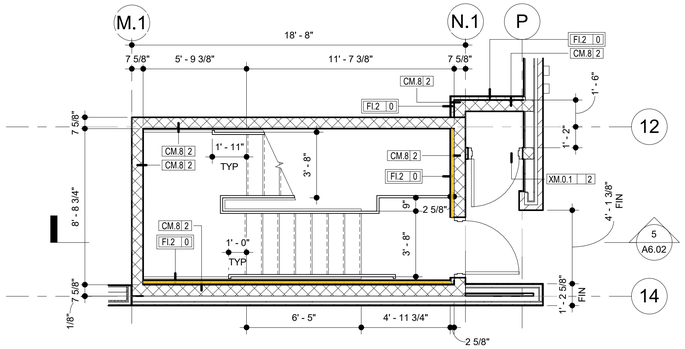

1 ENLARGED PLAN -SOUTHEAST STAIR - LVL 1
1/4" = 1'-0"

STAIRS - GENERAL NOTES

1. **ALL OVERALL STAIR ENCLOSURE DIMENSIONS ARE TO FACE OF FINISH U.O.N.**
2. ALL HANDRAIL EXTENSIONS AT WALL ARE TO BE EQUAL TO STAIR TREAD AT BASE OF STAIR RUN AND 1'-0" AT TOP OF STAIR RUN PER CODE.
3. ALL HANDRAILS AT WALL TO BE 1-1/2" DIA. PIPE RAIL AND LOCATED 1-1/2" AWAY FROM FINISHED FACE OF WALL PER CODE.

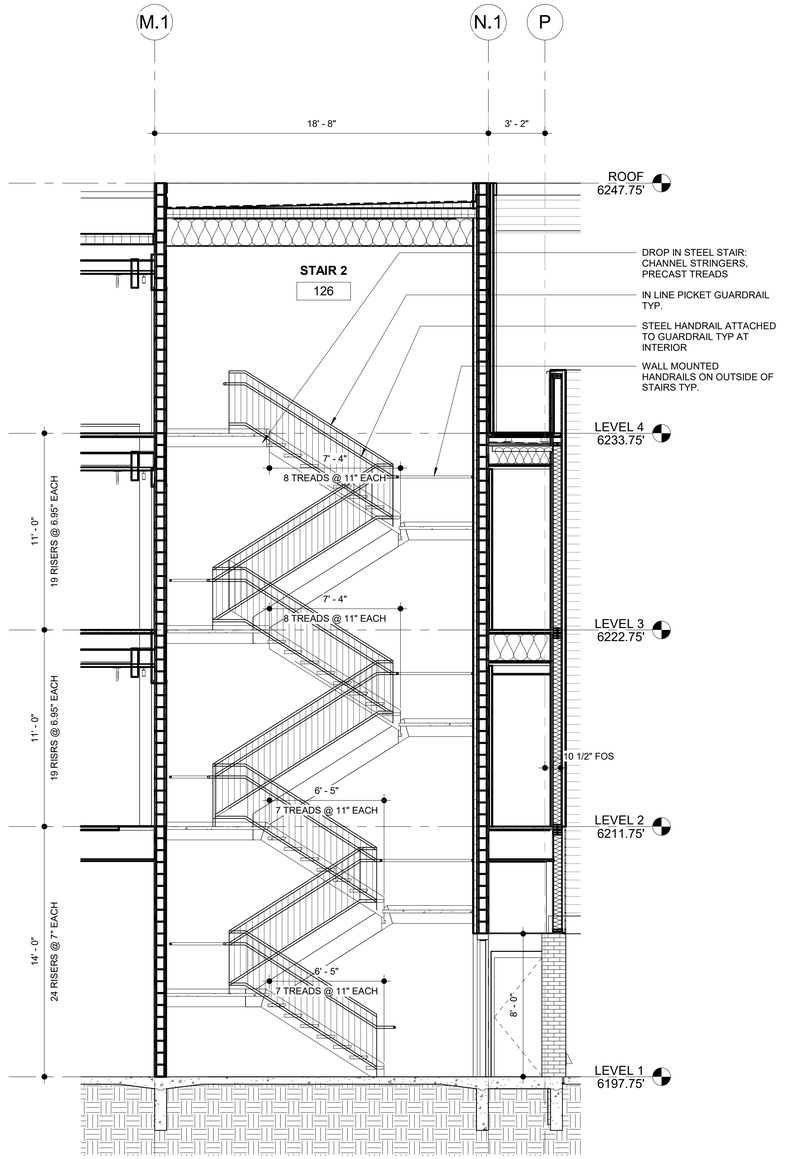

5 ENLARGED SECTION - SOUTHEAST STAIR
1/4" = 1'-0"

HELTSHE

M1A MERIDIAN 105 ARCHITECTURE

CITY HOTEL
415 PERRY STREET, CASTLE ROCK, CO.

DATE: 4.22.2026	ISSUED FOR: PERMIT	SHEET TITLE: SOUTHEAST STAIR PLANS & SECTIONS	SHEET NUMBER A6.02
PROJ. NO. 2023.002			

C:\Users\daniel\Documents\City Hotel-2024_1_dlhjscomb74CJ8.rvt

4/22/2026 1:08:24 PM

LIGHTING LEGEND

D - WALL SCONCE	E - ILLUMINATED MIRROR	F - RECESSED CAN

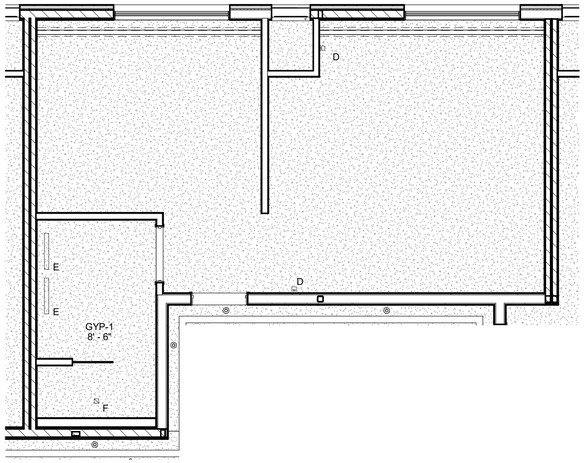

10 UNIT TYPE 3 - RCP
1/4" = 1'-0"

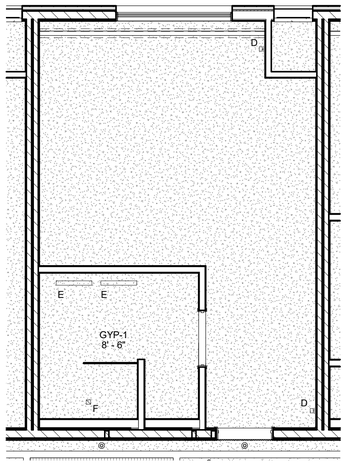

6 UNIT TYPE 2 - RCP
1/4" = 1'-0"

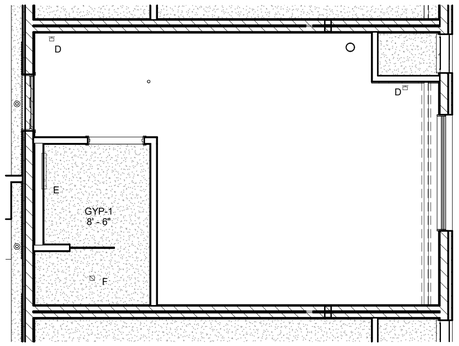

2 UNIT TYPE 1 - RCP
1/4" = 1'-0"

UNIT GENERAL NOTES

1. UNLESS OTHERWISE INDICATED BY A CEILING TAG, CEILING WHICH ARE SHOWN SHALL BE ASSUMED TO BE THE BOTTOM OF THE FLOOR/CEILING ASSEMBLY.
2. WHERE FURRING WALLS ARE SHOWN ADJACENT TO CORRIDOR AND UNIT DEMISING WALLS, THE RATED UNIT AND DEMISING WALLS SHALL BE CONSTRUCTED WITH ALL LAYERS OF THE ASSEMBLY, INCLUDING DRYWALL, BEHIND THE FURRING WALL, IN ORDER TO MAINTAIN BOTH THE FIRE RATING AND ACOUSTICAL PROPERTIES.
3. ARCHITECTURAL REFLECTED CEILING PLANS MAY NOT DEPICT ALL OF THE LIGHT FIXTURES REQUIRED IN THE UNIT. GC AND ELECTRICAL SUBCONTRACTOR SHALL REVIEW BOTH THE ARCHITECTURAL REFLECTED CEILING PLANS, AND THE ELECTRICAL LIGHTING PLANS, AND SHALL CONSIDER ALL OF THE REQUIRMENTS DEPICTED THROUGHOUT THE DRAWING SET AS CUMULATIVE. THE PURPOSE OF THE ARCHITECTURAL REFLECTED CEILING PLANS IS PRIMARILY TO CONVEY THE LOCATION OF DECORATIVE FIXTURES.
4. WHEN TWO DIFFERENT WALL TYPES BUTT END TO END, GC SHALL COORDINATE STUD OFFSETS AS REQUIRED TO ALLOW THE DRYWALL FINISH TO RUN SMOOTHLY, AND IN A SINGLE PLANE ACROSS THE WALL TRANSITION.
5. DIMENSION FROM EDGE OF DOOR FRAME TO EDGE OF ADJACENT PERPENDICULAR FINISH TO BE 4" UON.

CEILING LEGEND

CEILING TYPES:

ACT-1: 2X4 LAY-IN CEILING, PARKING

ACT-2: 2X2 LAY-IN CEILING, KITCHEN, BACK OF HOUSE

ACT-3: 2X2 LAY-IN CEILING, KITCHEN, WITH METAL FINISH

WS-1: WOOD SLAT CEILING. PRODUCT BY USG INTERIORS 'SPECIALTY CEILING SYSTEM', TRUE WOOD. WOOD VENEER COLOR SELECTED BY ARCHITECT, WITH BLACK FELT REVEAL BACKING. MILLWORK BORDERS AND FLAT PLANAR AREAS TO MATCH FINISH, MATERIAL, AND COLOR OF SLAT PRODUCT.

GYP-1: GYPSUM BOARD ON METAL SUSPENSION SYSTEM, OR WOOD FRAMING

GYP-2: GYPSUM BOARD CEILING, RATED 2-HOURS, AER-09038

NOTE: REFER TO LIGHTING PLANS FOR COMPLETE LAYOUTS AND SPECIFICATIONS OF LIGHTING FIXTURES. DIMENSIONED LOCATION TO BE PROVIDED BY ARCHITECT.

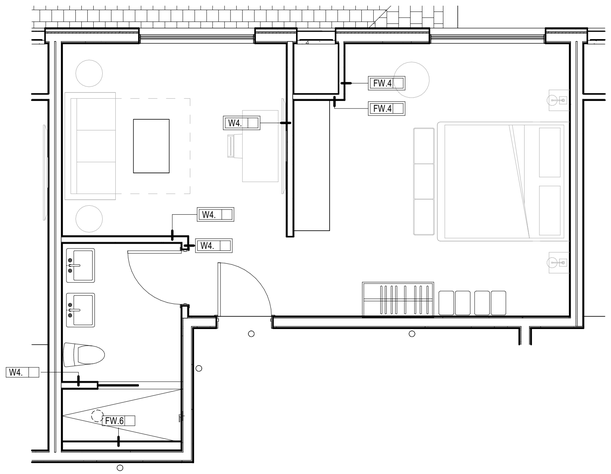

9 UNIT TYPE 3
1/4" = 1'-0"

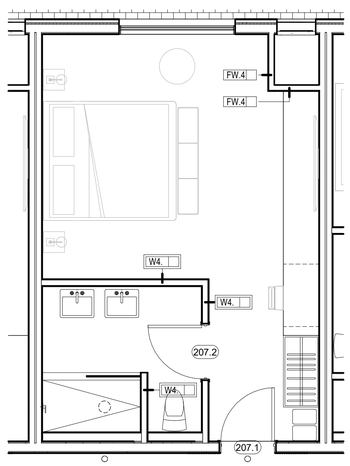

5 UNIT TYPE 2
1/4" = 1'-0"

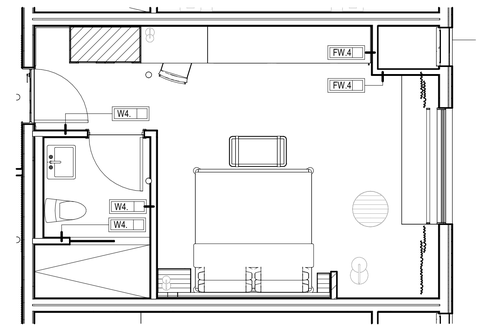

1 UNIT TYPE 1
1/4" = 1'-0"

HELTSHE

M1A MERIDIAN 105 ARCHITECTURE

CITY HOTEL
415 PERRY STREET, CASTLE ROCK, CO.

DATE: 4.22.2026	ISSUED FOR: PERMIT	SHEET TITLE: ENLARGED PLAN & RCP - UNIT TYPE 1, 2, 3	SHEET NUMBER A7.00
PROJ. NO. 2023.002			

C:\Users\daniel\Documents\City Hotel-2024_1_dlipscomb74Cj8.rvt

4/22/2026 1:06:29 PM

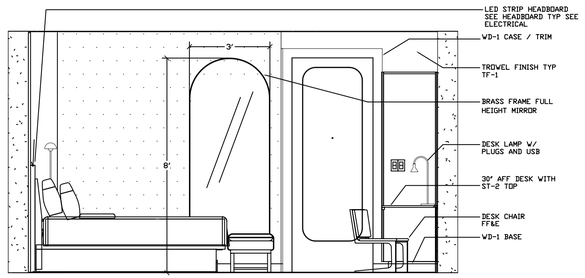

6 Elevation
3/8" = 1'-0"

Feature Trowel Finish Walls

Tambour Accent Millwork

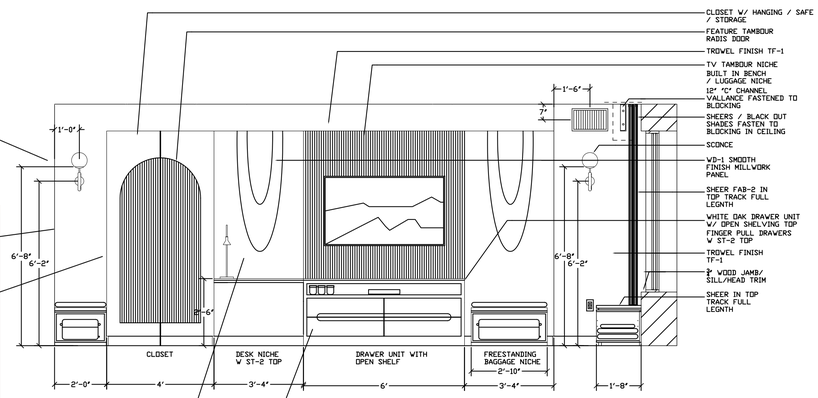

5 Elevation
3/8" = 1'-0"

White Oak Casework

White Oak Paneling

Counter

C Channel Valance

BlackOuts and Shers

Bedding

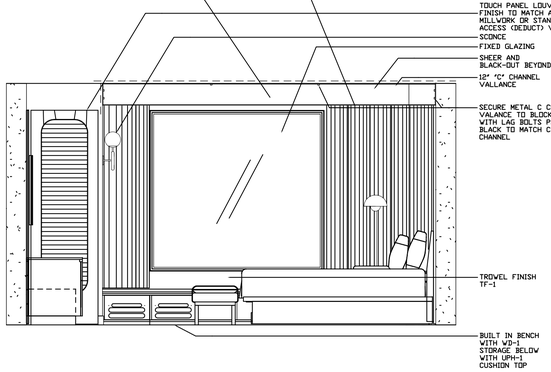

4 Elevation
3/8" = 1'-0"

Knotty White Oak Paneling

Leather Panel Headboard

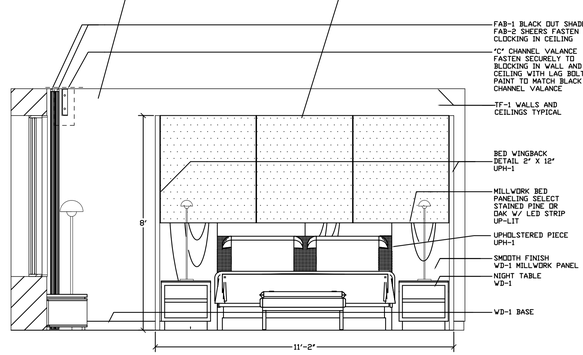

3 Elevation
3/8" = 1'-0"

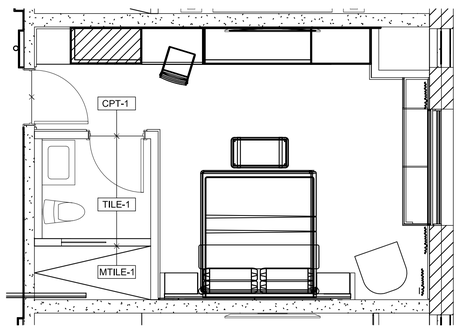

2 UNIT FINISHE PLAN
1/4" = 1'-0"

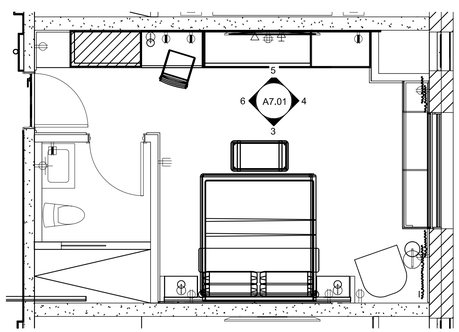

1 UNIT TYPE 1
1/4" = 1'-0"

C:\Users\daniel\Documents\City Hotel-2024_dlipscomb74CJ8.rvt

11/13/2024 3:04:58 PM

HELTSHE

M1A MERIDIAN 105 ARCHITECTURE

CITY HOTEL
415 PERRY STREET, CASTLE ROCK, CO.

DATE: 4.22.2026	ISSUED FOR: PERMIT	SHEET TITLE: ENLARGED PLAN & UNIT TYPE 1 ROOM ELEVATIONS	SHEET NUMBER A7.01
PROJ. NO. 2023.002			

STATE OF COLORADO CHAD MITCHELL 40754 LICENSED ARCHITECT

Towel Bar - Unlacquered Brass

Robe Hook - Unlacquered Brass

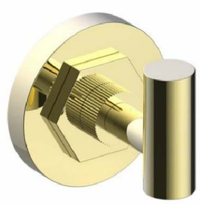

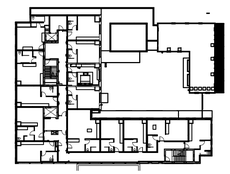

3 KEY PLAN - UNIT TYPE 1 - LVL 2
1" = 50'-0"

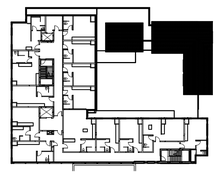

4 KEY PLAN - UNIT TYPE 1 - LVL 3
1" = 50'-0"

Vanity Concept - Trad Mod Finishes

Hand Towel - Unlacquered Brass

Vanity Sink - Matt Black W/ Brass handles

Shower- Matt Black W/ Brass handles

Mirror - Brass Full Height Door

Illuminated Mirror - Brass above Vanity

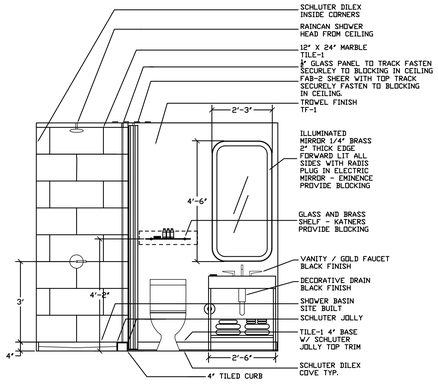

6 Elevation
3/8" = 1'-0"

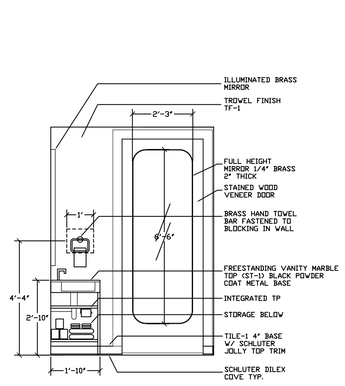

5 Elevation
3/8" = 1'-0"

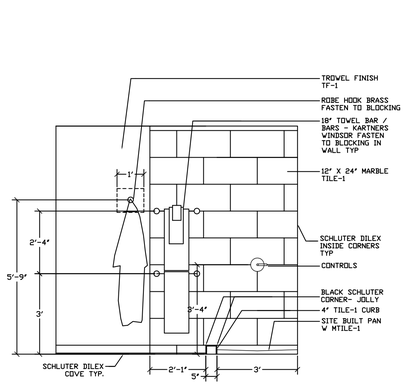

4 Elevation
3/8" = 1'-0"

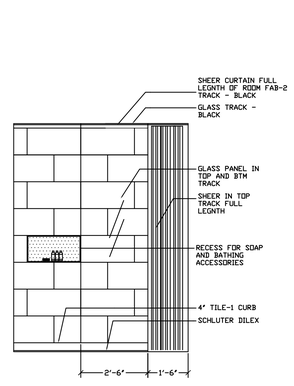

3 Elevation
3/8" = 1'-0"

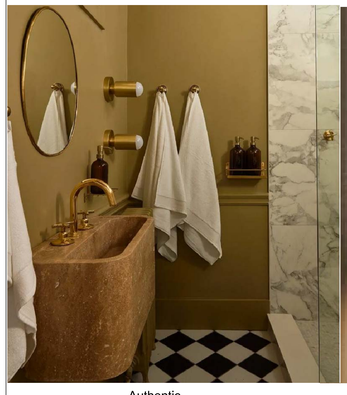

Authentic
Finishes

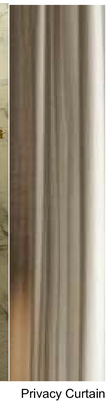

Privacy Curtain

Door Finish

Feature Trowel
Finish Walls

Counter / Flooring
/ Wet Walls

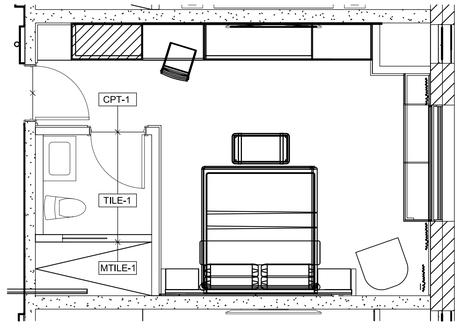

2 UNIT FINISH PLAN
1/4" = 1'-0"

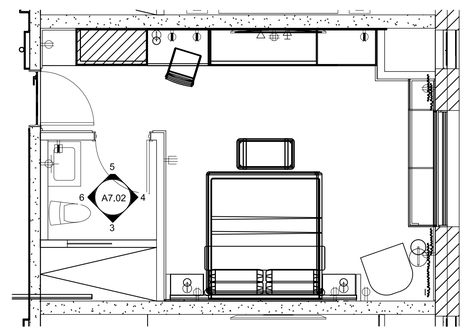

1 UNIT TYPE 1
1/4" = 1'-0"

C:\Users\daniel\Documents\City Hotel-2024_dlpscomb74CJB.rvt

11/13/2024 3:04:58 PM

HELTSHE

M1A | MERIDIAN 105 ARCHITECTURE

CITY HOTEL
415 PERRY STREET, CASTLE ROCK, CO.

DATE: 4.22.2026	ISSUED FOR: PERMIT	SHEET TITLE: ENLARGED PLAN UNIT TYPE 1 BATH DESIGN	SHEET NUMBER A7.02
PROJ. NO. 2023.002			

STATE OF COLORADO · CHAD MITCHELL · 40754 · LICENSED ARCHITECT

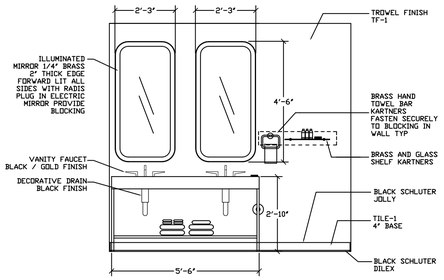

6 Elevation
3/8" = 1'-0"

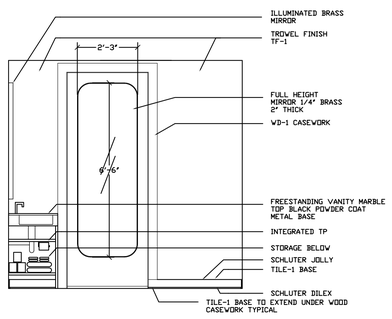

7 Elevation
3/8" = 1'-0"

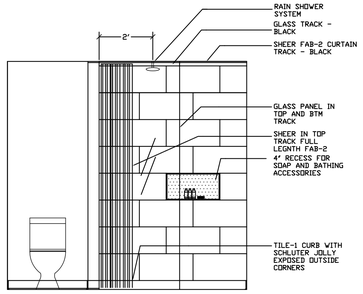

8 Elevation
3/8" = 1'-0"

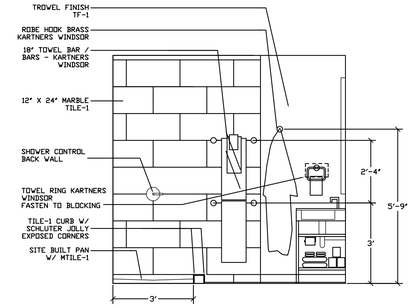

9 Elevation
3/8" = 1'-0"

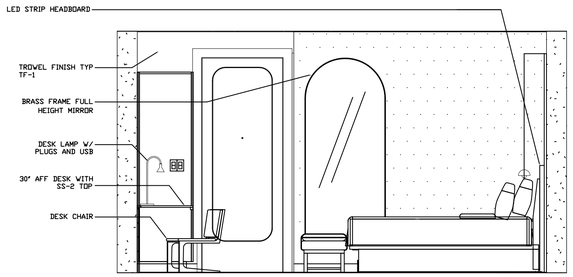

5 Elevation
3/8" = 1'-0"

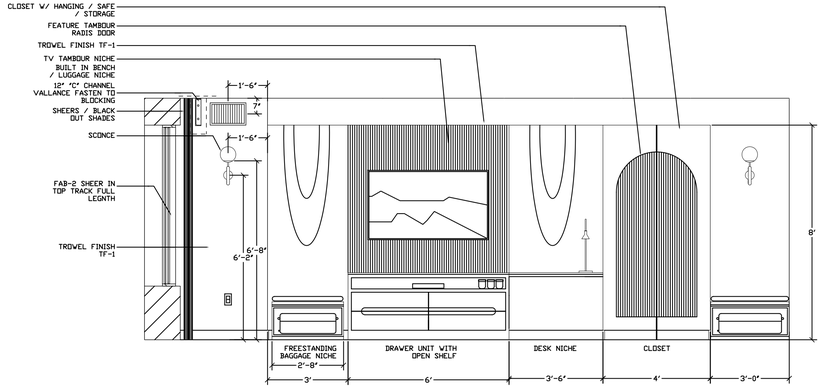

4 Elevation
3/8" = 1'-0"

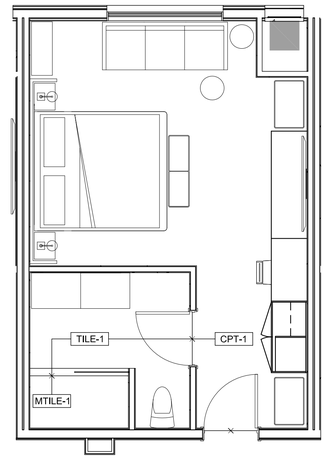

10 UNIT FINISH PLANS
1/4" = 1'-0"

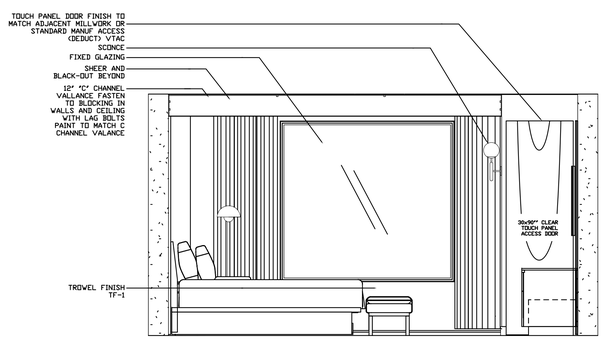

3 Elevation
3/8" = 1'-0"

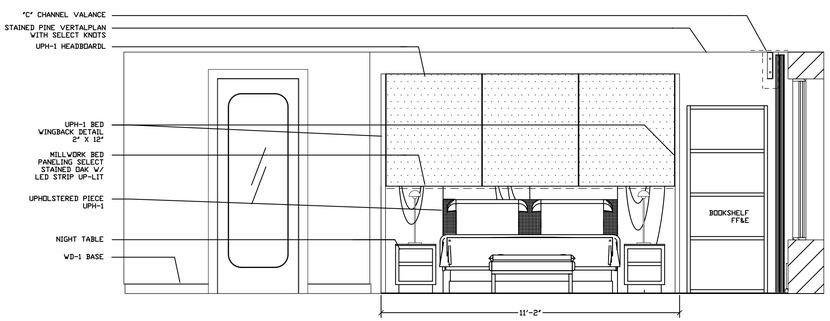

2 Elevation
3/8" = 1'-0"

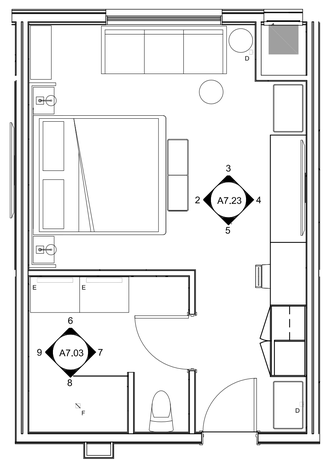

1 UNIT TYPE 2
1/4" = 1'-0"

C:\Users\danielf\Documents\City Hotel-2024_dlipscomb74CJ8.rvt
11/13/2024 3:04:58 PM

HELTSHE

M1A MERIDIAN 105 ARCHITECTURE

CITY HOTEL
415 PERRY STREET, CASTLE ROCK, CO.

DATE: 4.22.2026	ISSUED FOR: PERMIT	SHEET TITLE: ENLARGED PLAN UNIT TYPE 2 ROOM ELEVATIONS	SHEET NUMBER A7.03
PROJ. NO. 2023.002			

STATE OF COLORADO · CHAD MITCHELL · 40754 · LICENSED ARCHITECT

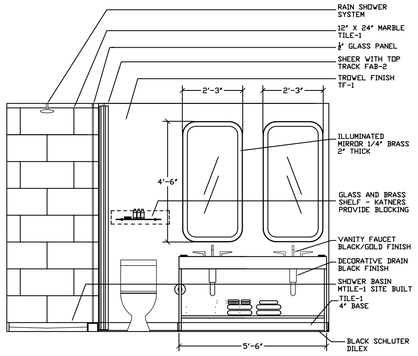

10 Elevation
3/8" = 1'-0"

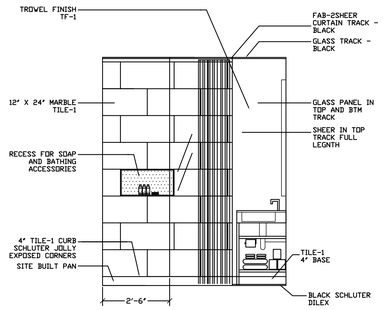

9 Elevation
3/8" = 1'-0"

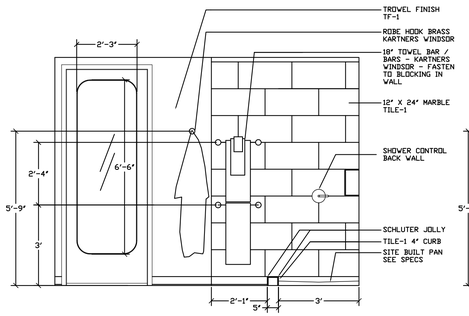

8 Elevation
3/8" = 1'-0"

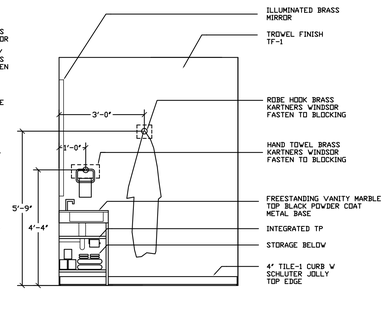

7 Elevation
3/8" = 1'-0"

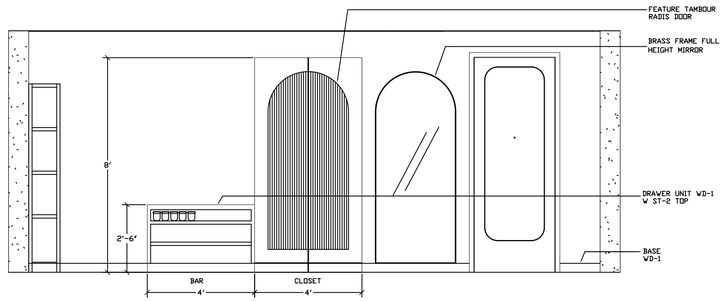

5 Elevation
3/8" = 1'-0"

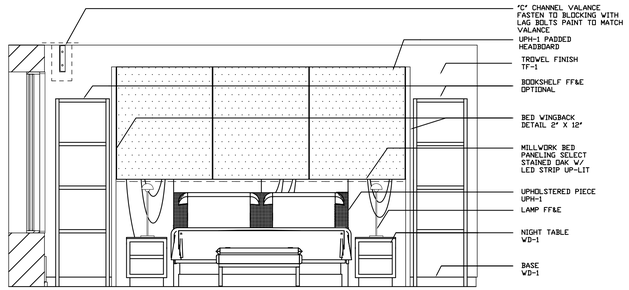

4 Elevation
3/8" = 1'-0"

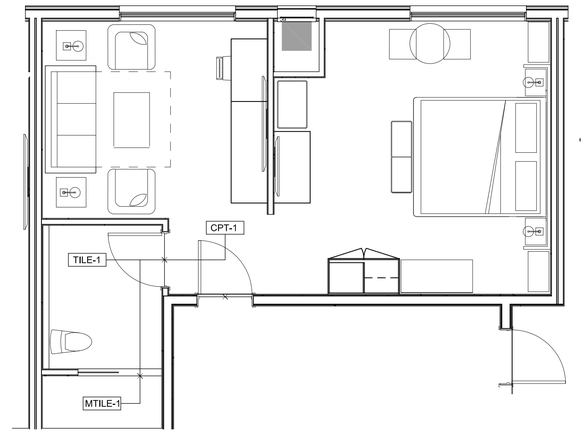

11 UNIT FINISH PLAN
1/4" = 1'-0"

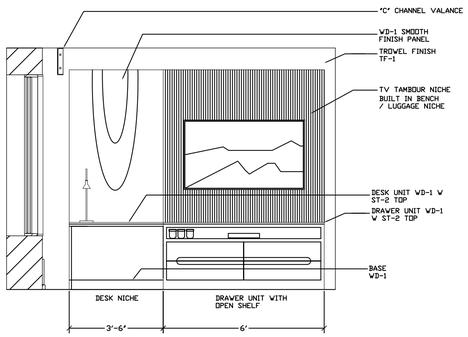

6 Elevation
3/8" = 1'-0"

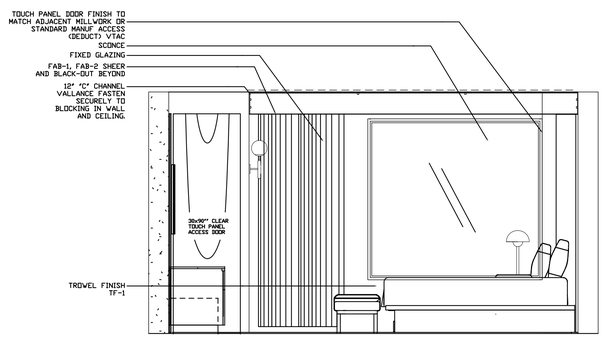

3 Elevation
3/8" = 1'-0"

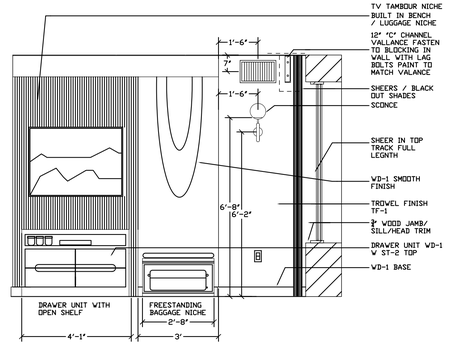

2 Elevation
3/8" = 1'-0"

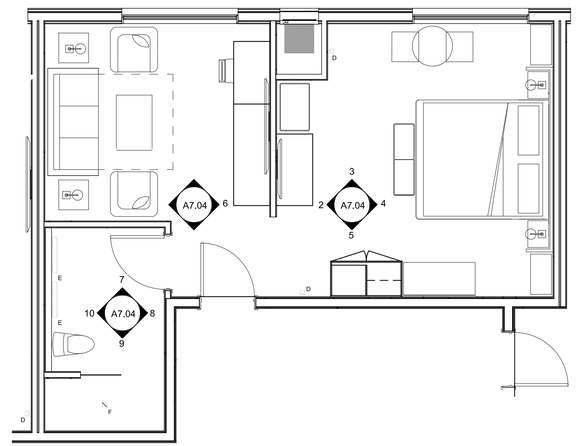

1 UNIT TYPE 3
1/4" = 1'-0"

C:\Users\daniel\Documents\City Hotel-2024_dlipscomb74CJ8.rvt
11/13/2024 3:04:58 PM

HELTSHE

M1A MERIDIAN 105 ARCHITECTURE

CITY HOTEL
415 PERRY STREET, CASTLE ROCK, CO.

DATE: 4.22.2026
PROJ. NO. 2023.002

ISSUED FOR:
PERMIT

SHEET TITLE:
ENLARGED PLAN
UNIT TYPE 3
ROOM ELEVATIONS

STATE OF COLORADO
CHAD MITCHELL
400754
LICENSED ARCHITECT

SHEET NUMBER
A7.04

LIGHTING LEGEND

D - WALL SCONCE	E - ILLUMINATED MIRROR	F - RECESSED CAN

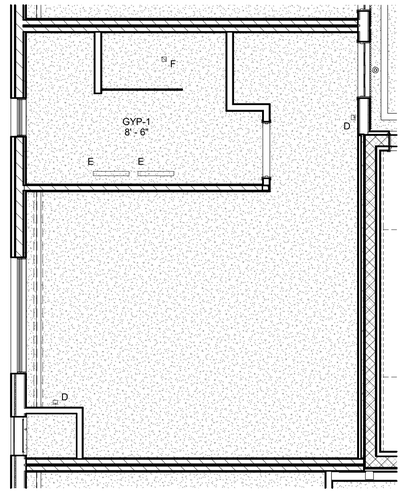

4 UNIT TYPE 6 - RCP
1/4" = 1'-0"

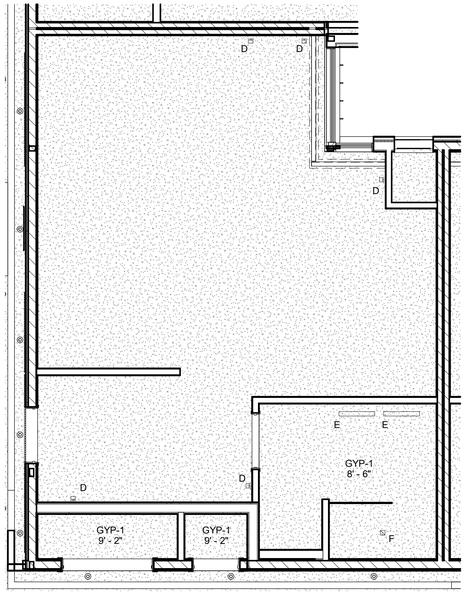

2 UNIT TYPE 5 - RCP
1/4" = 1'-0"

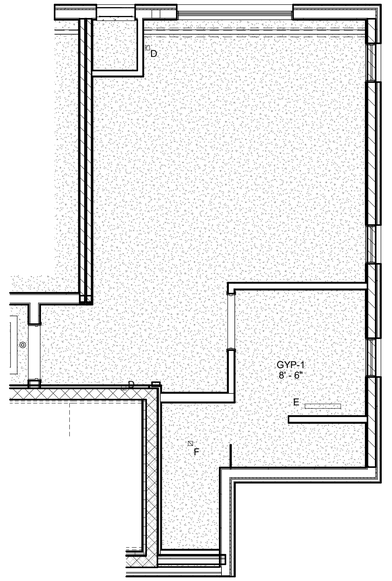

10 UNIT TYPE 4 - RCP
1/4" = 1'-0"

UNIT GENERAL NOTES

1. UNLESS OTHERWISE INDICATED BY A CEILING TAG, CEILING WHICH ARE SHOWN SHALL BE ASSUMED TO BE THE BOTTOM OF THE FLOOR/CEILING ASSEMBLY.
2. WHERE FURRING WALLS ARE SHOWN ADJACENT TO CORRIDOR AND UNIT DEMISING WALLS, THE RATED UNIT AND DEMISING WALLS SHALL BE CONSTRUCTED WITH ALL LAYERS OF THE ASSEMBLY, INCLUDING DRYWALL, BEHIND THE FURRING WALL, IN ORDER TO MAINTAIN BOTH THE FIRE RATING AND ACOUSTICAL PROPERTIES.
3. ARCHITECTURAL REFLECTED CEILING PLANS MAY NOT DEPICT ALL OF THE LIGHT FIXTURES REQUIRED IN THE UNIT. GC AND ELECTRICAL SUBCONTRACTOR SHALL REVIEW BOTH THE ARCHITECTURAL REFLECTED CEILING PLANS, AND THE ELECTRICAL LIGHTING PLANS, AND SHALL CONSIDER ALL OF THE REQUIRMENTS DEPICTED THROUGHOUT THE DRAWING SET AS CUMULATIVE. THE PURPOSE OF THE ARCHITECTURAL REFLECTED CEILING PLANS IS PRIMARILY TO CONVEY THE LOCATION OF DECORATIVE FIXTURES.
4. WHEN TWO DIFFERENT WALL TYPES BUTT END TO END, GC SHALL COORDINATE STUD OFFSETS AS REQUIRED TO ALLOW THE DRYWALL FINISH TO RUN SMOOTHLY, AND IN A SINGLE PLANE ACROSS THE WALL TRANSITION.
5. DIMENSION FROM EDGE OF DOOR FRAME TO EDGE OF ADJACENT PERPENDICULAR FINISH TO BE 4" UON.

CEILING LEGEND

CEILING TYPES:

ACT-1: 2X4 LAY-IN CEILING, PARKING

ACT-2: 2X2 LAY-IN CEILING, KITCHEN, BACK OF HOUSE

ACT-3: 2X2 LAY-IN CEILING, KITCHEN, WITH METAL FINISH

WS-1: WOOD SLAT CEILING. PRODUCT BY USG INTERIORS 'SPECIALTY CEILING SYSTEM', TRUE WOOD. WOOD VENEER COLOR SELECTED BY ARCHITECT, WITH BLACK FELT REVEAL BACKING. MILLWORK BORDERS AND FLAT PLANAR AREAS TO MATCH FINISH, MATERIAL, AND COLOR OF SLAT PRODUCT.

GYP-1: GYPSUM BOARD ON METAL SUSPENSION SYSTEM, OR WOOD FRAMING

GYP-2: GYPSUM BOARD CEILING, RATED 2-HOURS, AER-09038

NOTE: REFER TO LIGHTING PLANS FOR COMPLETE LAYOUTS AND SPECIFICATIONS OF LIGHTING FIXTURES. DIMENSIONED LOCATION TO BE PROVIDED BY ARCHITECT.

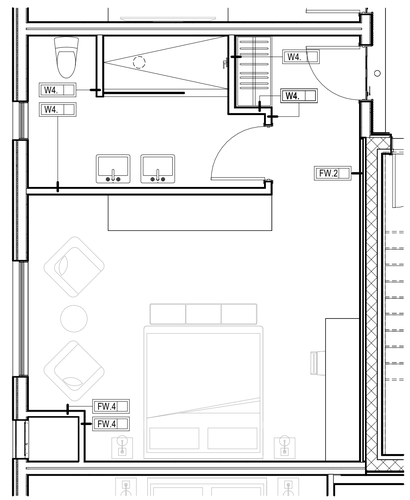

3 UNIT TYPE 6
1/4" = 1'-0"

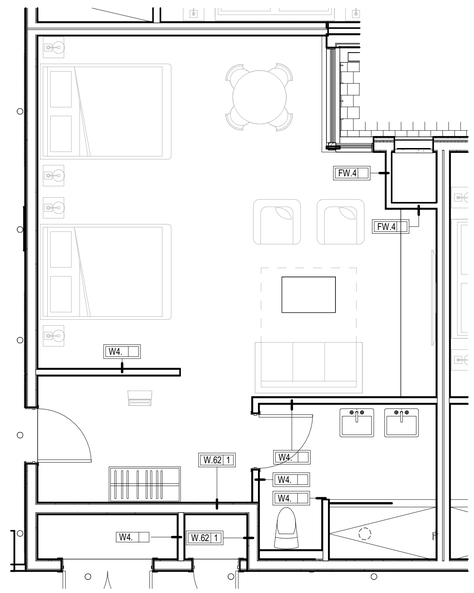

1 UNIT TYPE 5
1/4" = 1'-0"

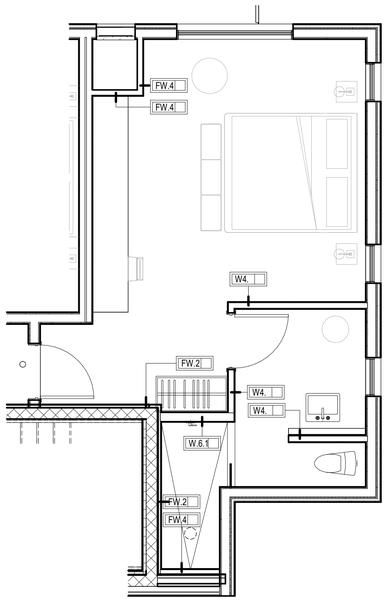

9 UNIT TYPE 4
1/4" = 1'-0"

HELTSHE

M1A MERIDIAN 105 ARCHITECTURE

CITY HOTEL
415 PERRY STREET, CASTLE ROCK, CO.

DATE: 4.22.2026	ISSUED FOR: PERMIT	SHEET TITLE: ENLARGED PLAN & RCP - UNIT TYPE 4, 5, 6	SHEET NUMBER A7.05
PROJ. NO. 2023.002			

C:\Users\daniel\Documents\City Hotel-2024_1_dlipscomb74Cq8.rvt
4/22/2026 1:08:34 PM

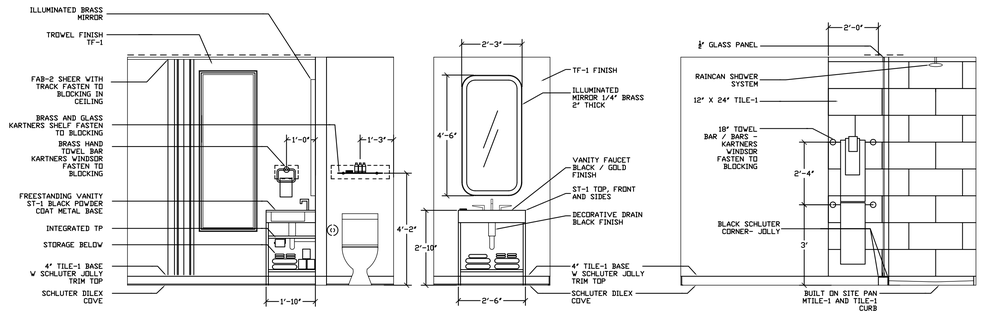

6 Elevation
3/8" = 1'-0"

7 Elevation
3/8" = 1'-0"

8 Elevation
3/8" = 1'-0"

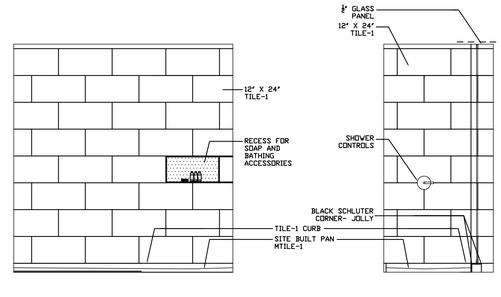

9 Elevation
3/8" = 1'-0"

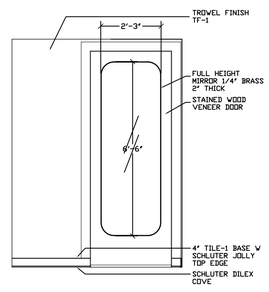

10 Elevation
3/8" = 1'-0"

11 Elevation
3/8" = 1'-0"

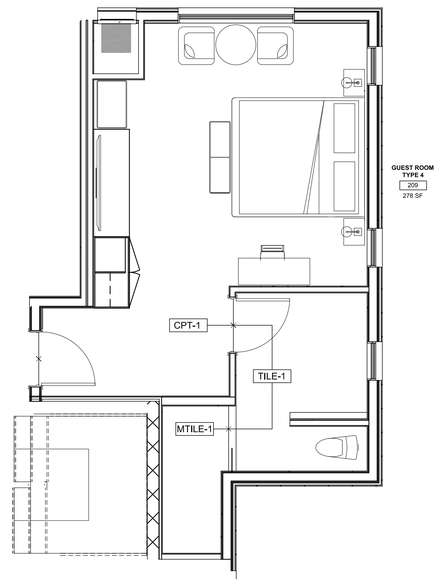

12 UNIT FINISH PLAN
1/4" = 1'-0"

4 Elevation
3/8" = 1'-0"

5 Elevation
3/8" = 1'-0"

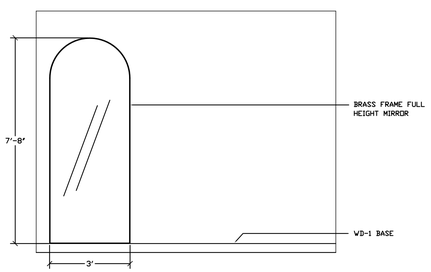

2 Elevation
3/8" = 1'-0"

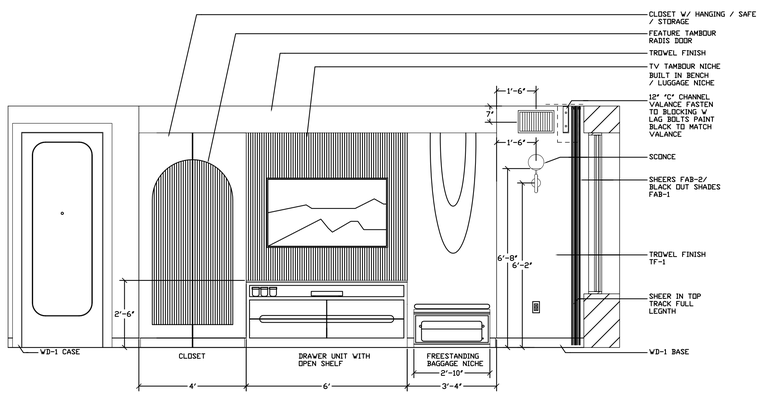

3 Elevation
3/8" = 1'-0"

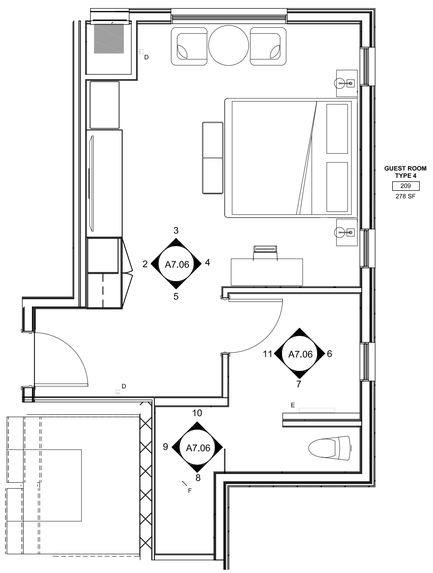

1 UNIT TYPE 4
1/4" = 1'-0"

C:\Users\danielt\Documents\City Hotel-2024_dlipscomb74CJ8.rvt
11/13/2024 3:04:58 PM

HELTSHE

M1A | MERIDIAN 105 ARCHITECTURE

CITY HOTEL
415 PERRY STREET, CASTLE ROCK, CO.

DATE: 4.22.2026
PROJ. NO. 2023.002

ISSUED FOR:
PERMIT

SHEET TITLE:
ENLARGED PLAN
UNIT TYPE 4
ROOM ELEVATIONS

STATE OF COLORADO
CHAD MITCHELL
400754
LICENSED ARCHITECT

SHEET NUMBER
A7.06

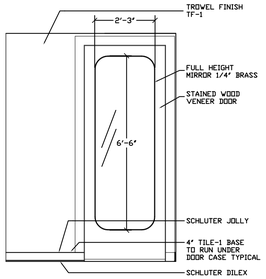

6 Elevation
3/8" = 1'-0"

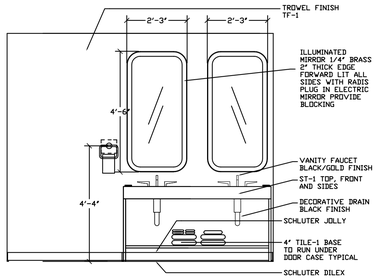

7 Elevation
3/8" = 1'-0"

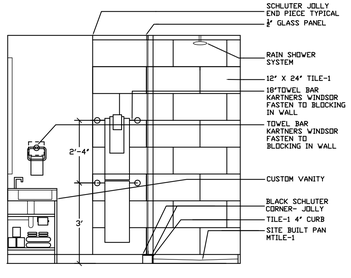

8 Elevation
3/8" = 1'-0"

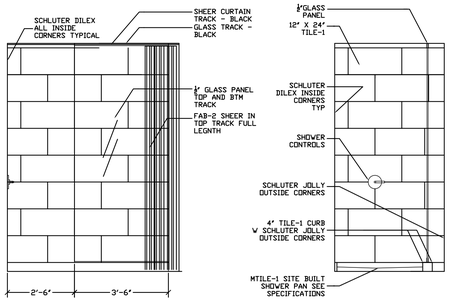

9 Elevation
3/8" = 1'-0"

10 Elevation
3/8" = 1'-0"

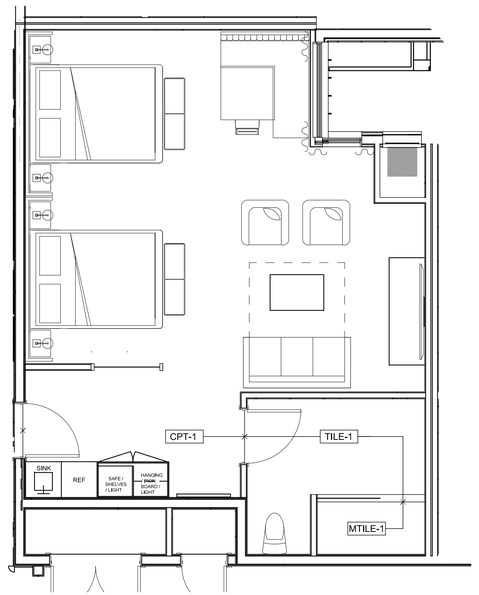

1 UNIT FINISH PLAN
1/4" = 1'-0"

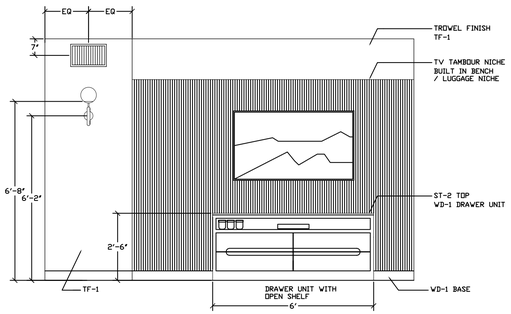

4 Elevation
3/8" = 1'-0"

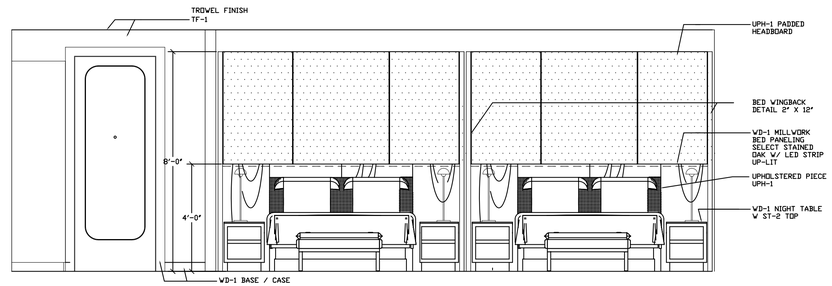

5 Elevation
3/8" = 1'-0"

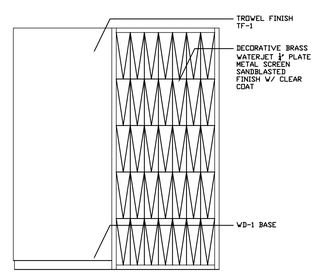

2 Elevation
3/8" = 1'-0"

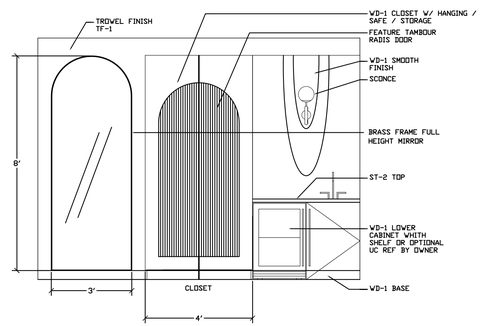

3 Elevation
3/8" = 1'-0"

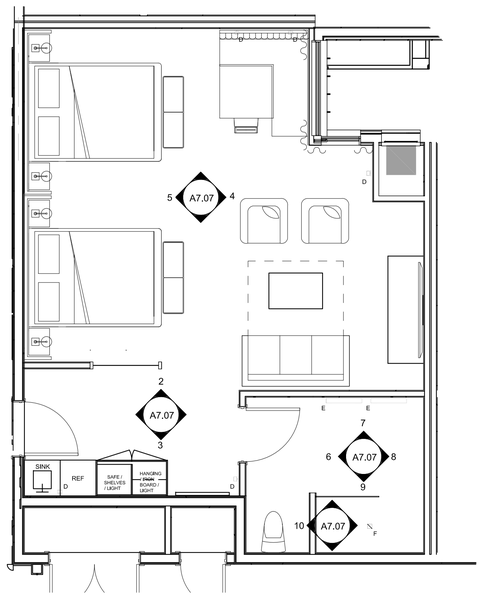

1 UNIT TYPE 5
1/4" = 1'-0"

C:\Users\danielf\Documents\City Hotel-2024_dlfpscomb74CJ8.rvt
11/13/2024 3:04:58 PM

HELTSHE

M1A | MERIDIAN 105 ARCHITECTURE

CITY HOTEL
415 PERRY STREET, CASTLE ROCK, CO.

DATE: 4.22.2026	ISSUED FOR: PERMIT	SHEET TITLE: ENLARGED PLAN UNIT TYPE 5 ROOM ELEVATIONS	SHEET NUMBER A7.07
PROJ. NO. 2023.002			

STATE OF COLORADO
CHAD MITCHELL
40754
LICENSED ARCHITECT

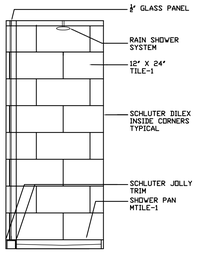

9 Elevation
3/8" = 1'-0"

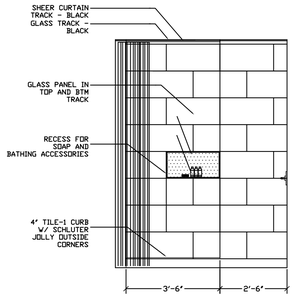

8 Elevation
3/8" = 1'-0"

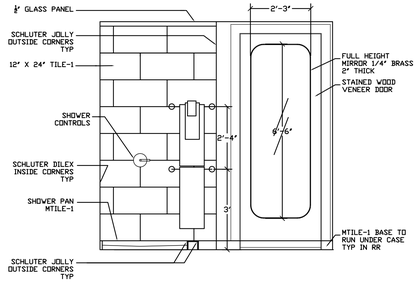

7 Elevation
3/8" = 1'-0"

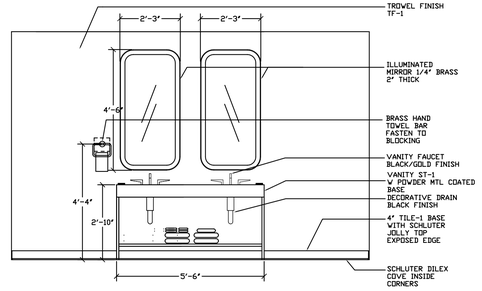

6 Elevation
3/8" = 1'-0"

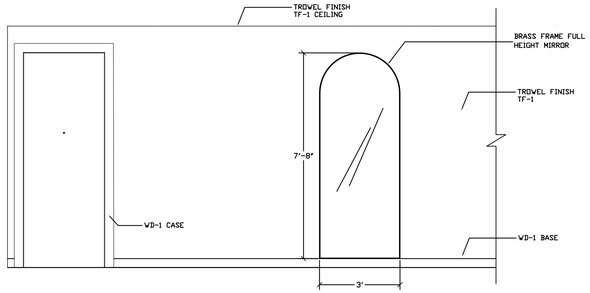

4 Elevation
3/8" = 1'-0"

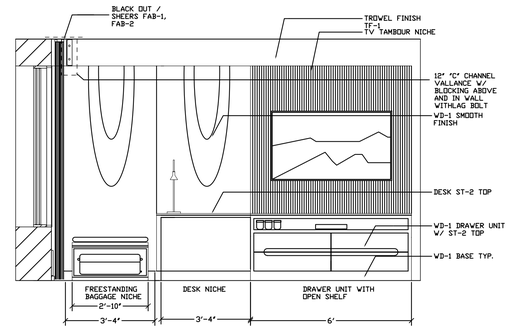

5 Elevation
3/8" = 1'-0"

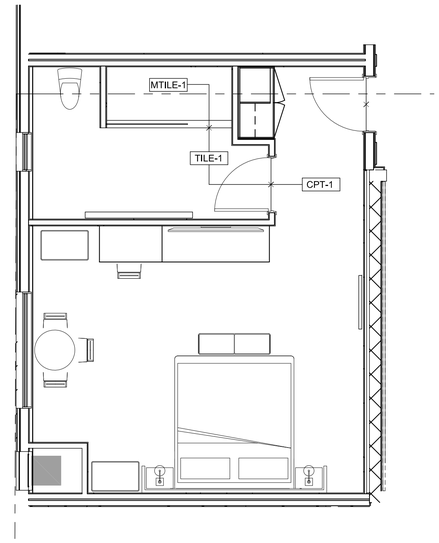

10 UNIT FINISH PLAN
1/4" = 1'-0"

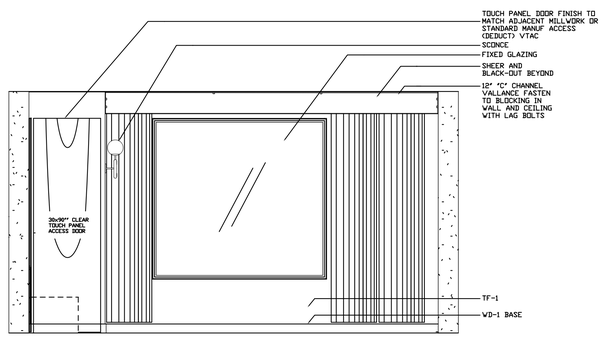

2 Elevation
3/8" = 1'-0"

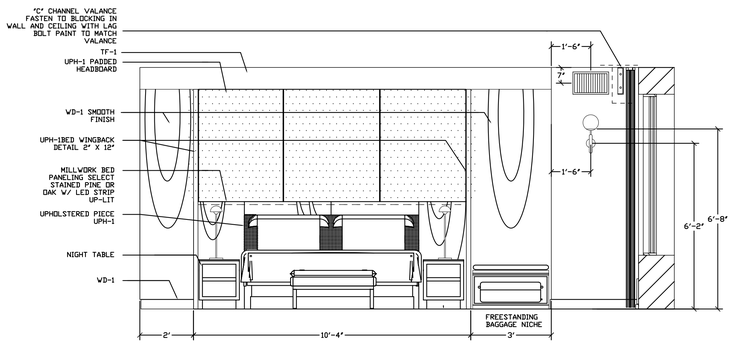

3 Elevation
3/8" = 1'-0"

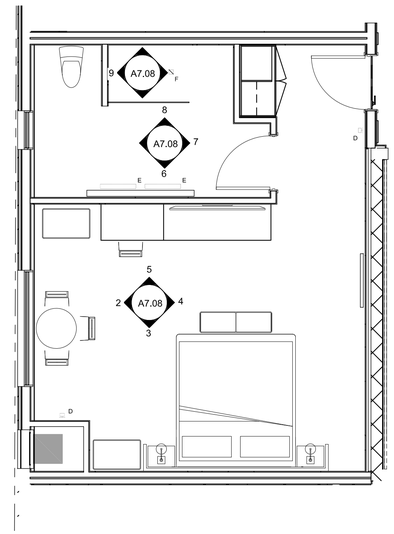

1 UNIT TYPE 6
1/4" = 1'-0"

STATE OF COLORADO
CHAD MITCHELL
20754
LICENSED ARCHITECT

HELTSHE

M1A | MERIDIAN 105 ARCHITECTURE

CITY HOTEL
415 PERRY STREET, CASTLE ROCK, CO.

DATE: 4.22.2026
PROJ. NO. 2023.002

ISSUED FOR: PERMIT

SHEET TITLE:
ENLARGED PLAN
UNIT TYPE 6
ROOM ELEVATIONS

SHEET NUMBER
A7.08

C:\Users\danielf\Documents\City Hotel-2024_dfpscomb74CJB.rvt
11/13/2024 3:04:58 PM

LIGHTING LEGEND

D - WALL SCONCE	E - ILLUMINATED MIRROR	F - RECESSED CAN

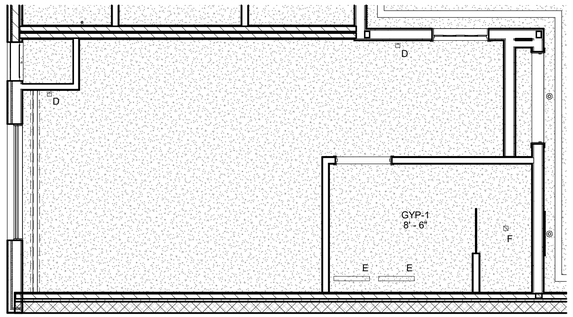

2 UNIT TYPE 9 - RCP
1/4" = 1'-0"

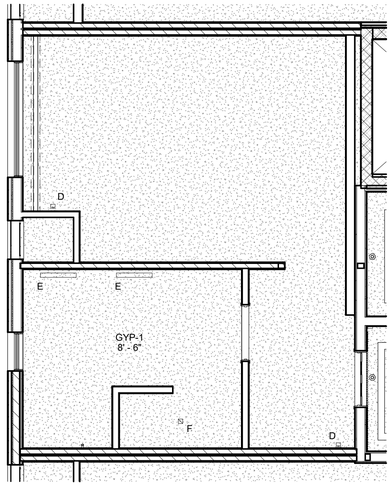

10 UNIT TYPE 8 - RCP
1/4" = 1'-0"

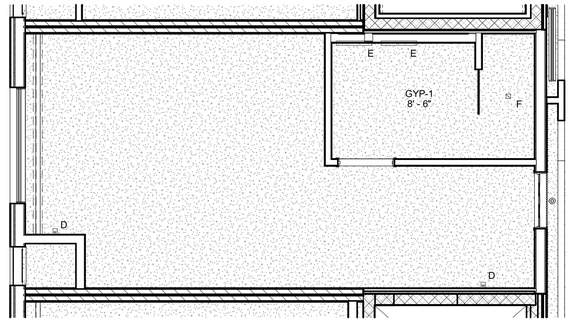

9 UNIT TYPE 7 - RCP
1/4" = 1'-0"

UNIT GENERAL NOTES

1. UNLESS OTHERWISE INDICATED BY A CEILING TAG, CEILING WHICH ARE SHOWN SHALL BE ASSUMED TO BE THE BOTTOM OF THE FLOOR/CEILING ASSEMBLY.
2. WHERE FURRING WALLS ARE SHOWN ADJACENT TO CORRIDOR AND UNIT DEMISING WALLS, THE RATED UNIT AND DEMISING WALLS SHALL BE CONSTRUCTED WITH ALL LAYERS OF THE ASSEMBLY, INCLUDING DRYWALL, BEHIND THE FURRING WALL, IN ORDER TO MAINTAIN BOTH THE FIRE RATING AND ACOUSTICAL PROPERTIES.
3. ARCHITECTURAL REFLECTED CEILING PLANS MAY NOT DEPICT ALL OF THE LIGHT FIXTURES REQUIRED IN THE UNIT. GC AND ELECTRICAL SUBCONTRACTOR SHALL REVIEW BOTH THE ARCHITECTURAL REFLECTED CEILING PLANS, AND THE ELECTRICAL LIGHTING PLANS, AND SHALL CONSIDER ALL OF THE REQUIRMENTS DEPICTED THROUGHOUT THE DRAWING SET AS CUMULATIVE. THE PURPOSE OF THE ARCHITECTURAL REFLECTED CEILING PLANS IS PRIMARILY TO CONVEY THE LOCATION OF DECORATIVE FIXTURES.
4. WHEN TWO DIFFERENT WALL TYPES BUTT END TO END, GC SHALL COORDINATE STUD OFFSETS AS REQUIRED TO ALLOW THE DRYWALL FINISH TO RUN SMOOTHLY, AND IN A SINGLE PLANE ACROSS THE WALL TRANSITION.
5. DIMENSION FROM EDGE OF DOOR FRAME TO EDGE OF ADJACENT PERPENDICULAR FINISH TO BE 4" UON.

CEILING LEGEND

CEILING TYPES:

ACT-1: 2X4 LAY-IN CEILING, PARKING

ACT-2: 2X2 LAY-IN CEILING, KITCHEN, BACK OF HOUSE

ACT-3: 2X2 LAY-IN CEILING, KITCHEN, WITH METAL FINISH

WS-1: WOOD SLAT CEILING. PRODUCT BY USG INTERIORS 'SPECIALTY CEILING SYSTEM', TRUE WOOD. WOOD VENEER COLOR SELECTED BY ARCHITECT, WITH BLACK FELT REVEAL BACKING. MILLWORK BORDERS AND FLAT PLANAR AREAS TO MATCH FINISH, MATERIAL, AND COLOR OF SLAT PRODUCT.

GYP-1: GYPSUM BOARD ON METAL SUSPENSION SYSTEM, OR WOOD FRAMING

GYP-2: GYPSUM BOARD CEILING, RATED 2-HOURS, AER-09038

NOTE: REFER TO LIGHTING PLANS FOR COMPLETE LAYOUTS AND SPECIFICATIONS OF LIGHTING FIXTURES. DIMENSIONED LOCATION TO BE PROVIDED BY ARCHITECT.

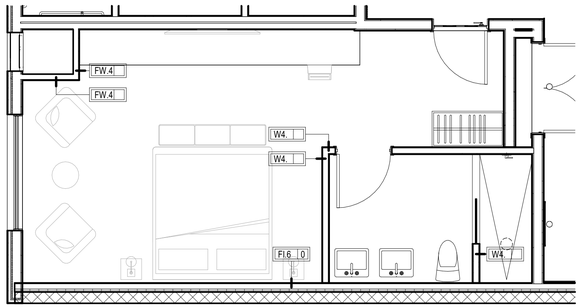

1 UNIT TYPE 9
1/4" = 1'-0"

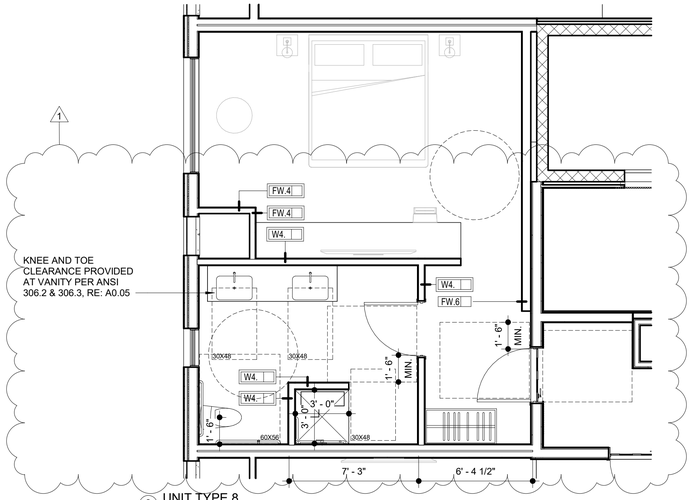

8 UNIT TYPE 8
1/4" = 1'-0"

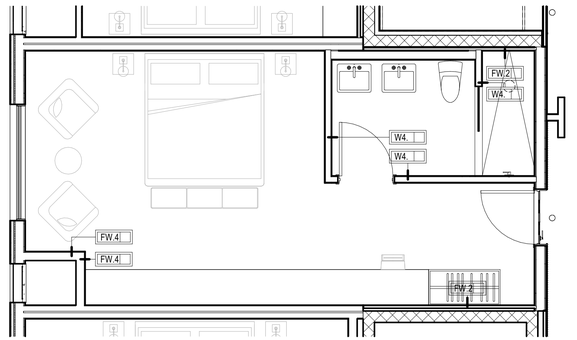

7 UNIT TYPE 7
1/4" = 1'-0"

C:\Users\daniel\Documents\City Hotel-2024_1_dlpscomb74Cj8.rvt

4/22/2026 1:08:38 PM

HELTSHE

M1A | MERIDIAN 105 ARCHITECTURE

CITY HOTEL
415 PERRY STREET, CASTLE ROCK, CO.

DATE: 4.22.2026
PROJ. NO. 2023.002

ISSUED FOR: PERMIT

SHEET TITLE: ENLARGED PLAN & RCP - UNIT TYPE 7, 8, 9

SHEET NUMBER
A7.09

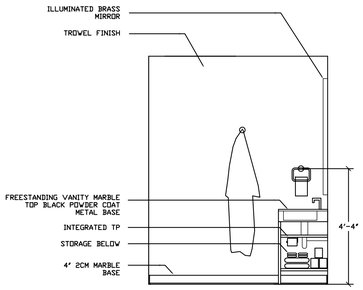

9 Elevation
3/8" = 1'-0"

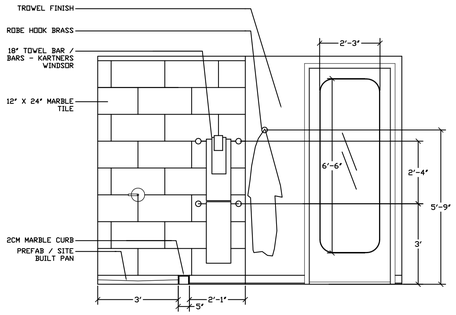

8 Elevation
3/8" = 1'-0"

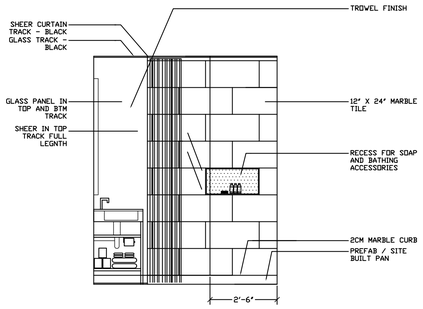

7 Elevation
3/8" = 1'-0"

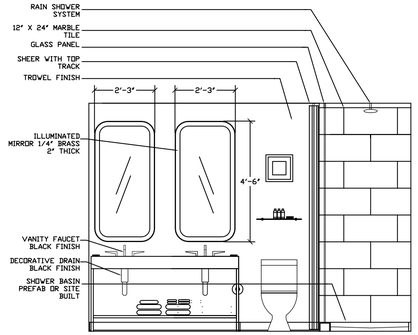

6 Elevation
3/8" = 1'-0"

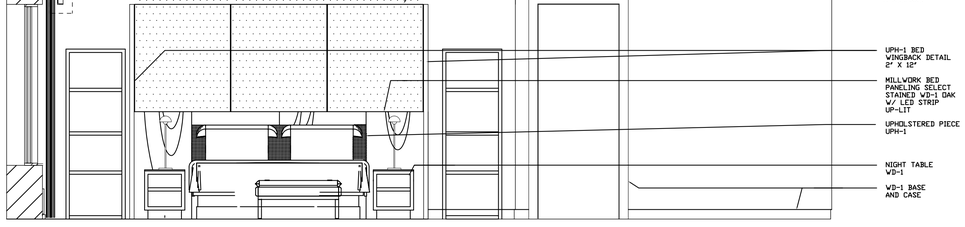

5 Elevation
3/8" = 1'-0"

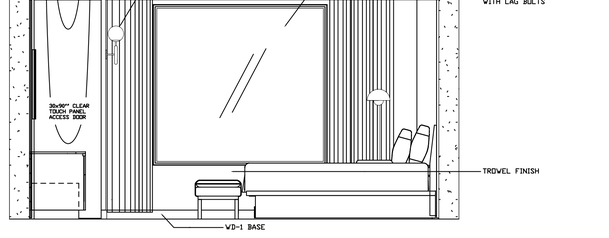

4 Elevation
3/8" = 1'-0"

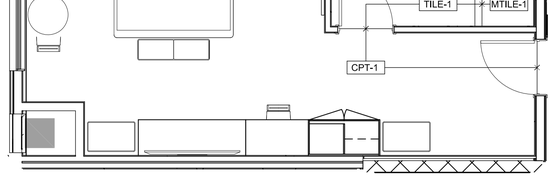

10 UNIT FINISH PLAN
1/4" = 1'-0"

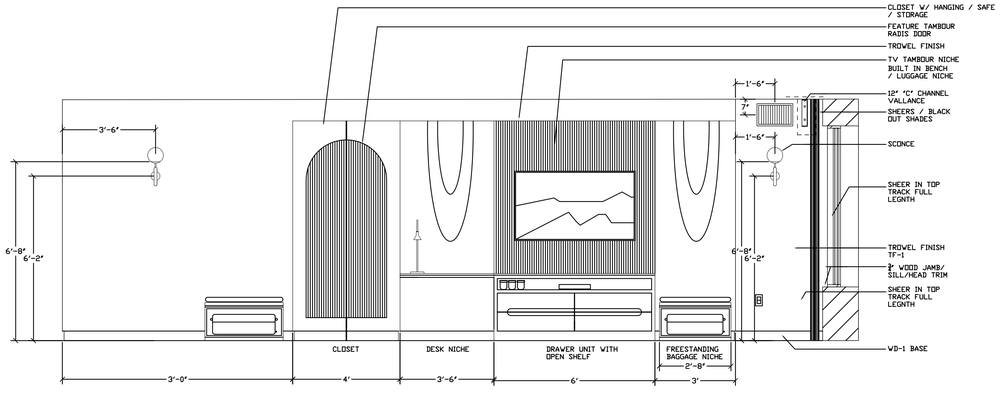

2 Elevation
3/8" = 1'-0"

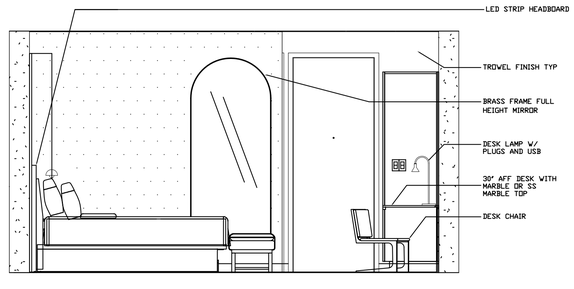

2 Elevation
3/8" = 1'-0"

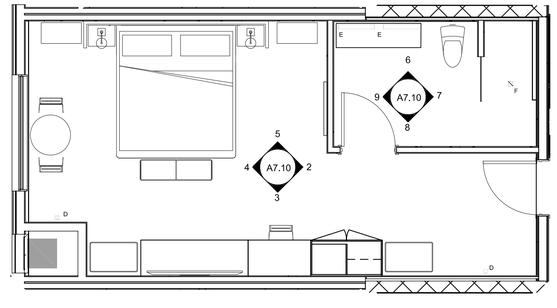

1 UNIT TYPE 7
1/4" = 1'-0"

C:\Users\danielf\Documents\City Hotel-2024_dlpscom7b74CJB.rvt
11/13/2024 3:04:56 PM

HELTSHE

M1A | MERIDIAN 105 ARCHITECTURE

CITY HOTEL
415 PERRY STREET, CASTLE ROCK, CO.

DATE: 4.22.2026	ISSUED FOR: PERMIT	SHEET TITLE: ENLARGED PLAN UNIT TYPE 7 ROOM ELEVATIONS	SHEET NUMBER A7.10
PROJ. NO. 2023.002			

STATE OF COLORADO
CHAD MITCHELL
40754
LICENSED ARCHITECT

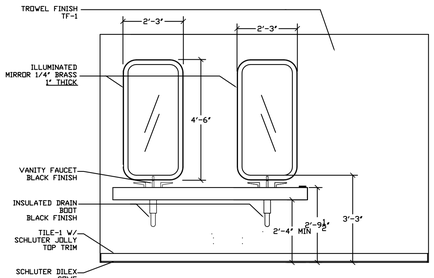

11 Elevation
3/8" = 1'-0"

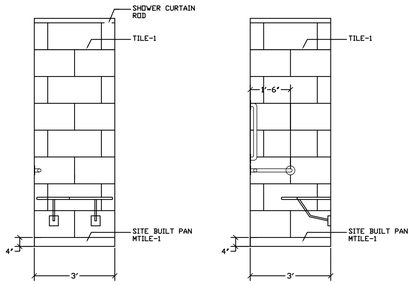

10 Elevation
3/8" = 1'-0"

9 Elevation
3/8" = 1'-0"

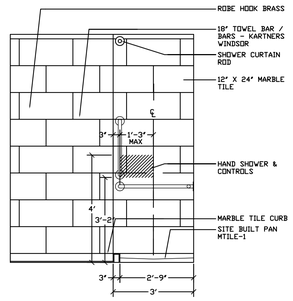

8 Elevation
3/8" = 1'-0"

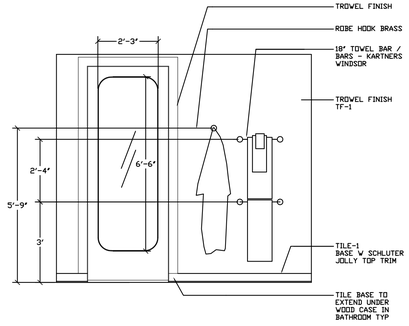

7 Elevation
3/8" = 1'-0"

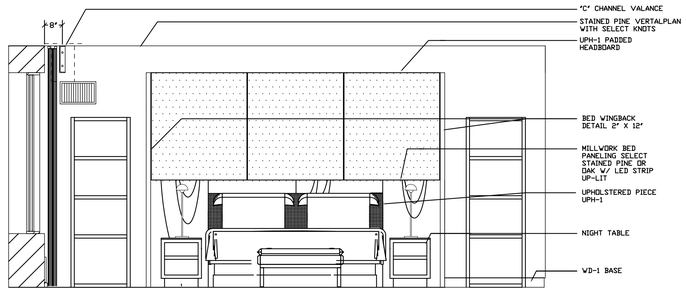

6 Elevation
3/8" = 1'-0"

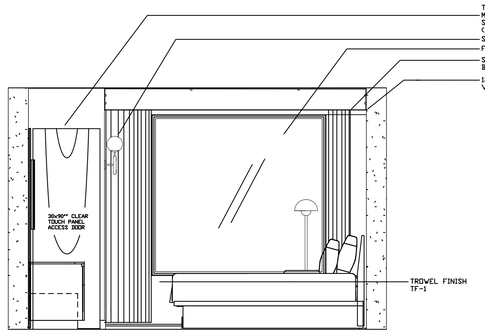

5 Elevation
3/8" = 1'-0"

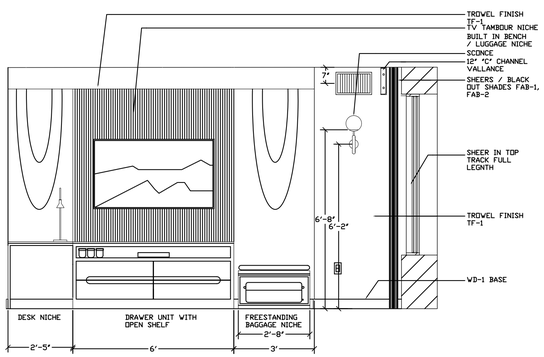

4 Elevation
3/8" = 1'-0"

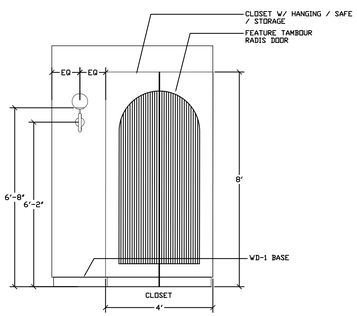

3 Elevation
3/8" = 1'-0"

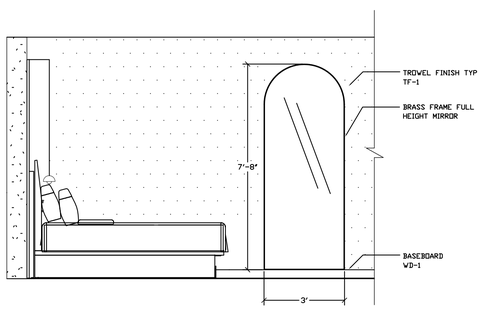

2 Elevation
3/8" = 1'-0"

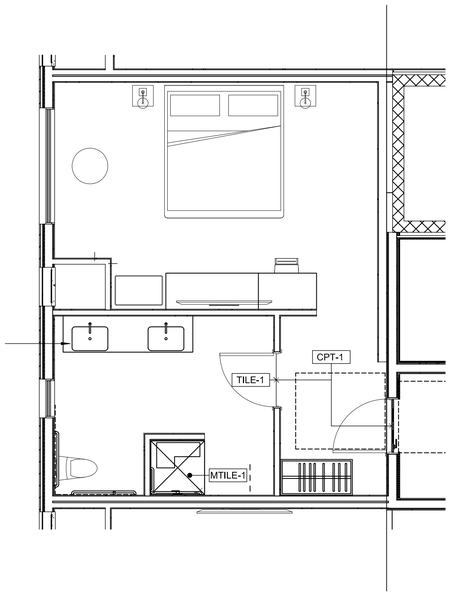

7 UNIT FINISH PLANS
1/4" = 1'-0"

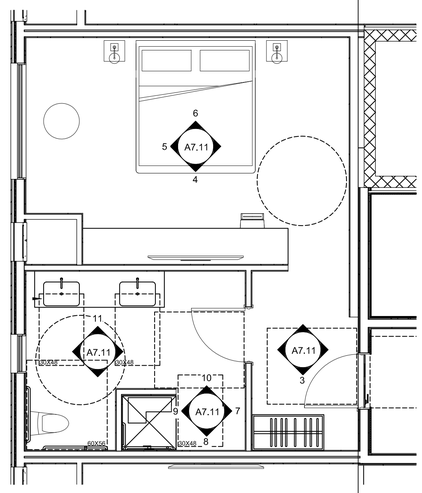

1 UNIT TYPE 8
1/4" = 1'-0"

C:\Users\daniel\Documents\City Hotel-2024_dfipscomb74CJ8.rvt
11/13/2024 3:04:58 PM

HELTSHE

M1A | MERIDIAN 105 ARCHITECTURE

CITY HOTEL
415 PERRY STREET, CASTLE ROCK, CO.

DATE: 4.22.2026
PROJ. NO. 2023.002

ISSUED FOR: PERMIT

SHEET TITLE: ENLARGED PLAN UNIT TYPE 8 ROOM ELEVATIONS

STATE OF COLORADO
CHAD MITCHELL
#20754
LICENSED ARCHITECT

SHEET NUMBER
A7.11

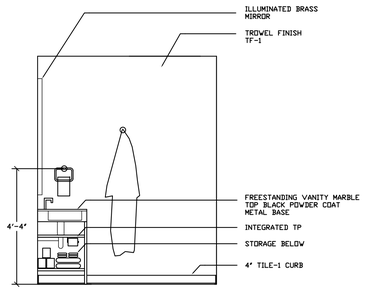

8 Elevation
3/8" = 1'-0"

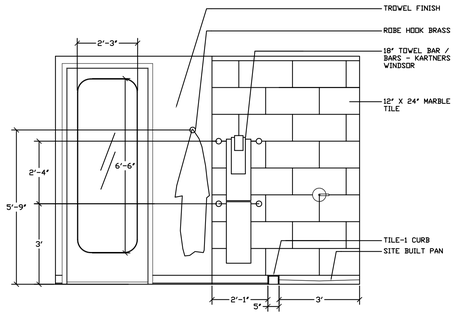

7 Elevation
3/8" = 1'-0"

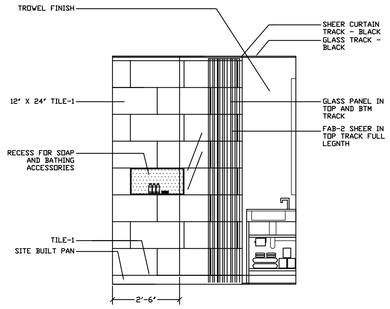

6 Elevation
3/8" = 1'-0"

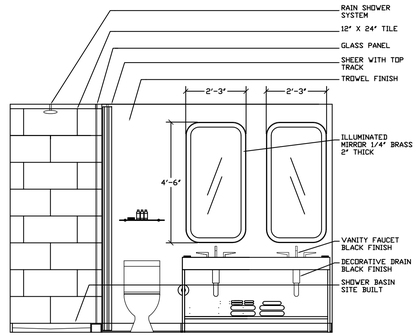

5 Elevation
3/8" = 1'-0"

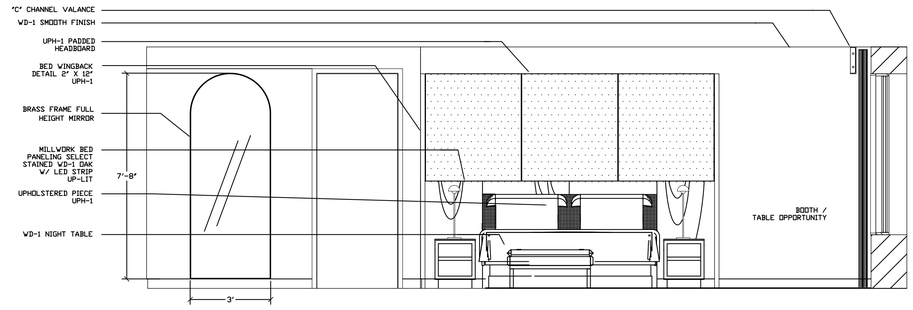

4 Elevation
3/8" = 1'-0"

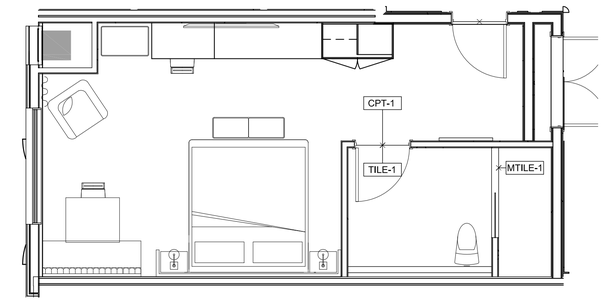

9 UNIT FINISH PLAN
1/4" = 1'-0"

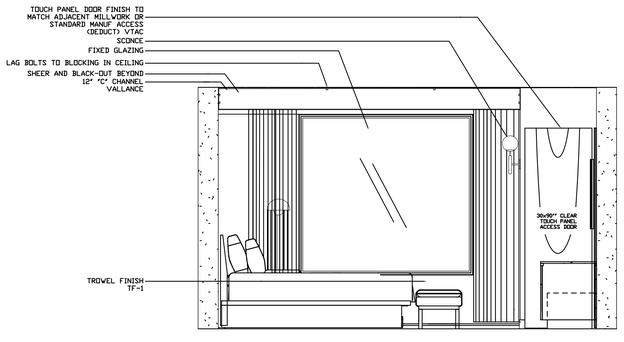

3 Elevation
3/8" = 1'-0"

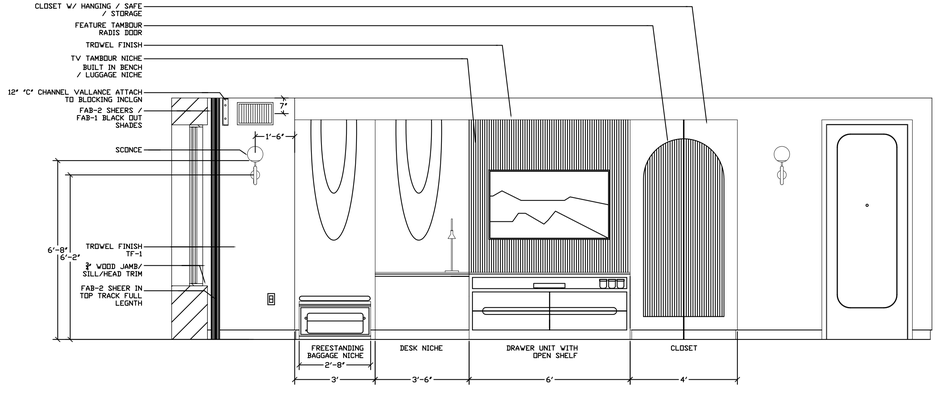

2 Elevation
3/8" = 1'-0"

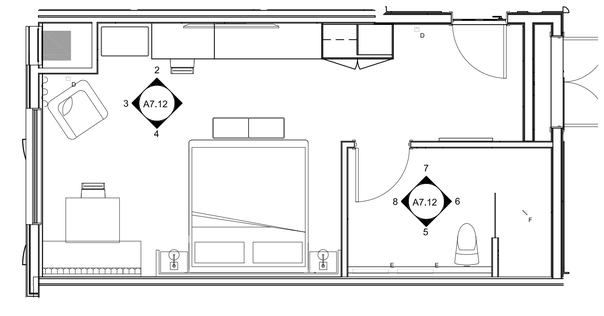

1 UNIT TYPE 9
1/4" = 1'-0"

C:\Users\danielf\Documents\City Hotel-2024_dlbpscomb74CJB.rvt

11/13/2024 3:04:58 PM

HELTSHE

M1A MERIDIAN 105 ARCHITECTURE

CITY HOTEL
415 PERRY STREET, CASTLE ROCK, CO.

DATE: 4.22.2026	ISSUED FOR: PERMIT	SHEET TITLE: ENLARGED PLAN & ROOM ELEVATIONS UNIT 9	SHEET NUMBER A7.12
PROJ. NO. 2023.002			

STATE OF COLORADO · CHAD MITCHELL · 40754 · LICENSED ARCHITECT

LIGHTING LEGEND

D - WALL SCONCE	E - ILLUMINATED MIRROR	F - RECESSED CAN

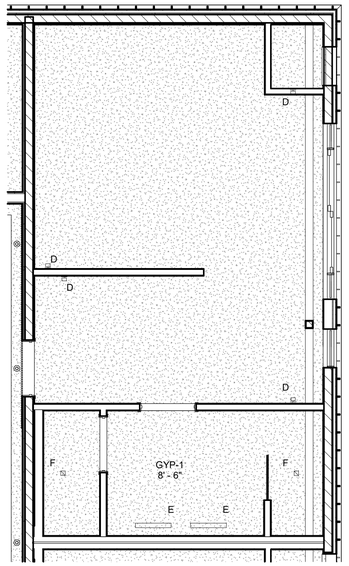

8 UNIT TYPE 11 - RCP
1/4" = 1'-0"

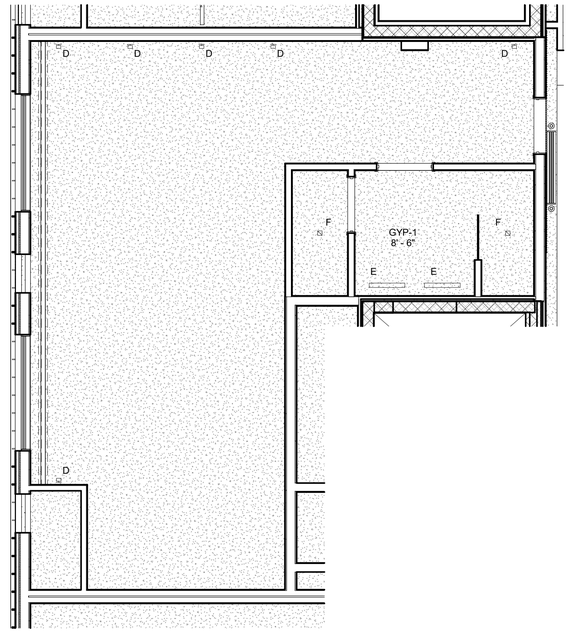

7 UNIT TYPE 10 - RCP
1/4" = 1'-0"

UNIT GENERAL NOTES

1. UNLESS OTHERWISE INDICATED BY A CEILING TAG, CEILING WHICH ARE SHOWN SHALL BE ASSUMED TO BE THE BOTTOM OF THE FLOOR/CEILING ASSEMBLY.
2. WHERE FURRING WALLS ARE SHOWN ADJACENT TO CORRIDOR AND UNIT DEMISING WALLS, THE RATED UNIT AND DEMISING WALLS SHALL BE CONSTRUCTED WITH ALL LAYERS OF THE ASSEMBLY, INCLUDING DRYWALL, BEHIND THE FURRING WALL, IN ORDER TO MAINTAIN BOTH THE FIRE RATING AND ACOUSTICAL PROPERTIES.
3. ARCHITECTURAL REFLECTED CEILING PLANS MAY NOT DEPICT ALL OF THE LIGHT FIXTURES REQUIRED IN THE UNIT. GC AND ELECTRICAL SUBCONTRACTOR SHALL REVIEW BOTH THE ARCHITECTURAL REFLECTED CEILING PLANS, AND THE ELECTRICAL LIGHTING PLANS, AND SHALL CONSIDER ALL OF THE REQUIRMENTS DEPICTED THROUGHOUT THE DRAWING SET AS CUMULATIVE. THE PURPOSE OF THE ARCHITECTURAL REFLECTED CEILING PLANS IS PRIMARILY TO CONVEY THE LOCATION OF DECORATIVE FIXTURES.
4. WHEN TWO DIFFERENT WALL TYPES BUTT END TO END, GC SHALL COORDINATE STUD OFFSETS AS REQUIRED TO ALLOW THE DRYWALL FINISH TO RUN SMOOTHLY, AND IN A SINGLE PLANE ACROSS THE WALL TRANSITION.
5. DIMENSION FROM EDGE OF DOOR FRAME TO EDGE OF ADJACENT PERPENDICULAR FINISH TO BE 4" UON.

CEILING LEGEND

CEILING TYPES:

ACT-1: 2X4 LAY-IN CEILING, PARKING

ACT-2: 2X2 LAY-IN CEILING, KITCHEN, BACK OF HOUSE

ACT-3: 2X2 LAY-IN CEILING, KITCHEN, WITH METAL FINISH

WS-1: WOOD SLAT CEILING. PRODUCT BY USG INTERIORS 'SPECIALTY CEILING SYSTEM', TRUE WOOD. WOOD VENEER COLOR SELECTED BY ARCHITECT, WITH BLACK FELT REVEAL BACKING. MILLWORK BORDERS AND FLAT PLANAR AREAS TO MATCH FINISH, MATERIAL, AND COLOR OF SLAT PRODUCT.

GYP-1: GYPSUM BOARD ON METAL SUSPENSION SYSTEM, OR WOOD FRAMING

GYP-2: GYPSUM BOARD CEILING, RATED 2-HOURS, AER-09038

NOTE: REFER TO LIGHTING PLANS FOR COMPLETE LAYOUTS AND SPECIFICATIONS OF LIGHTING FIXTURES. DIMENSIONED LOCATION TO BE PROVIDED BY ARCHITECT.

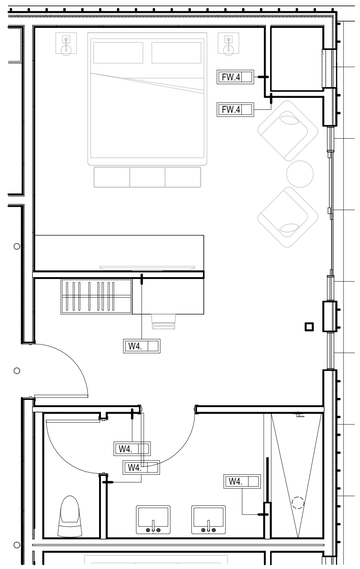

6 UNIT TYPE 11
1/4" = 1'-0"

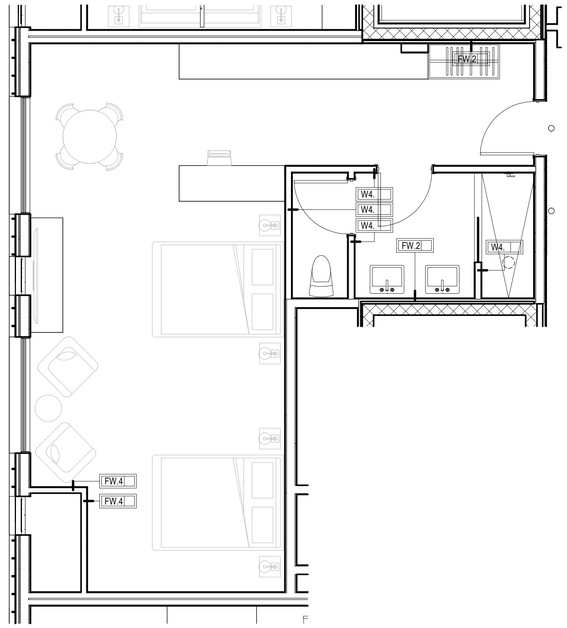

5 UNIT TYPE 10
1/4" = 1'-0"

HELTSHE

M1A MERIDIAN 105 ARCHITECTURE

CITY HOTEL
415 PERRY STREET, CASTLE ROCK, CO.

DATE: 4.22.2026	ISSUED FOR: PERMIT	SHEET TITLE: ENLARGED PLAN & RCP - UNIT TYPE 10, 11	SHEET NUMBER A7.13
PROJ. NO. 2023.002			

C:\Users\daniel\Documents\City Hotel-2024_1_dlipscomb74Cj8.rvt

4/22/2026 1:06:42 PM

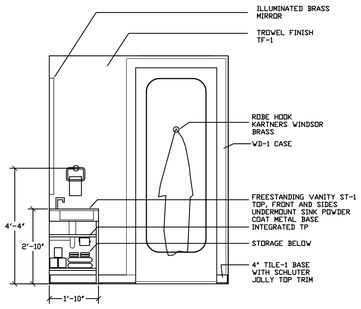

8 Elevation
3/8" = 1'-0"

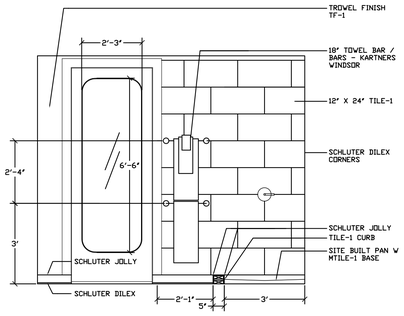

7 Elevation
3/8" = 1'-0"

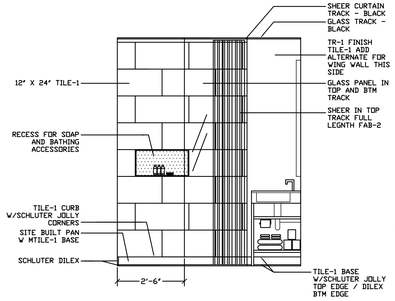

6 Elevation
3/8" = 1'-0"

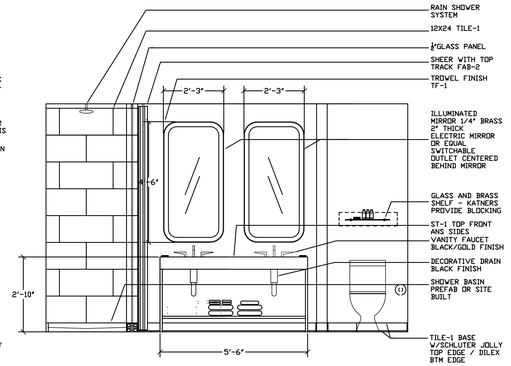

5 Elevation
3/8" = 1'-0"

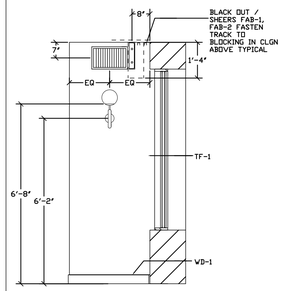

9 Elevation
3/8" = 1'-0"

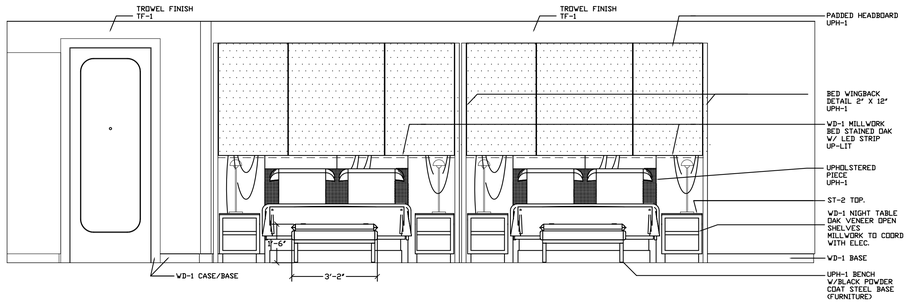

4 Elevation
3/8" = 1'-0"

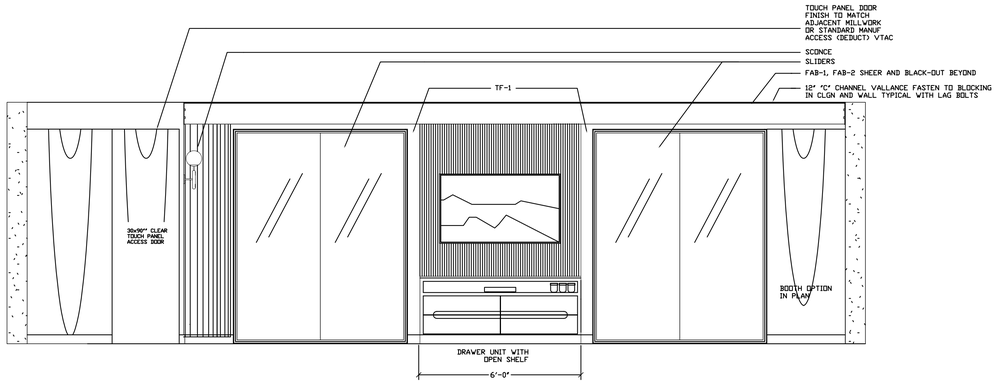

3 Elevation
3/8" = 1'-0"

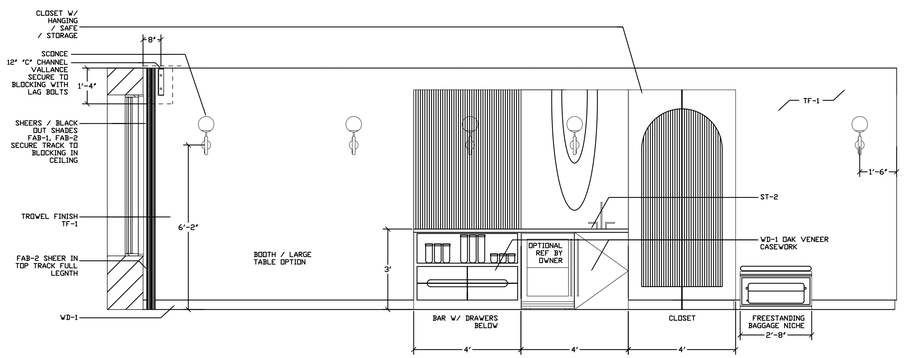

2 Elevation
3/8" = 1'-0"

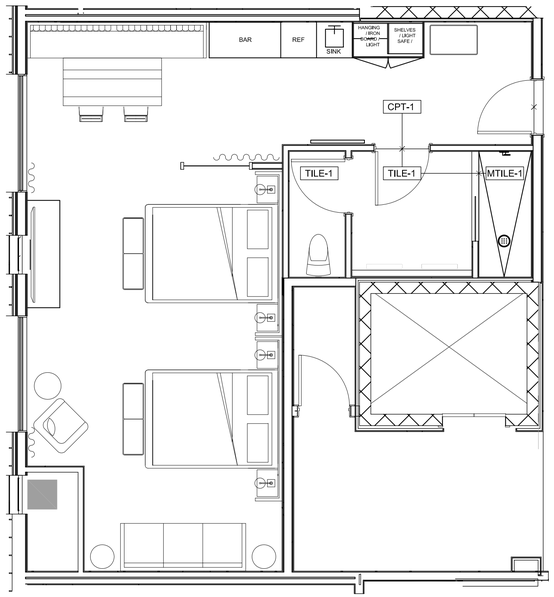

9 UNIT TYPE 10 FLOOR FINISHES
1/4" = 1'-0"

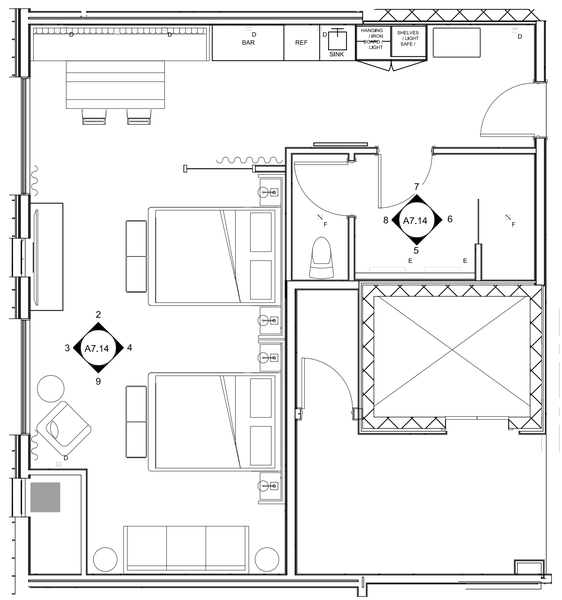

1 UNIT TYPE 10
1/4" = 1'-0"

C:\Users\danielf\Documents\City Hotel-2024_dfipscomb74CJB.rvt
11/13/2024 3:04:58 PM

HELTSHE

M1A | MERIDIAN 105 ARCHITECTURE

CITY HOTEL
415 PERRY STREET, CASTLE ROCK, CO.

DATE: 4.22.2026	ISSUED FOR: PERMIT	SHEET TITLE: ENLARGED PLAN & UNIT TYPE 10 ROOM ELEVATIONS
PROJ. NO. 2023.002		

STATE OF COLORADO · CHAD MITCHELL · 40754 · LICENSED ARCHITECT

SHEET NUMBER
A7.14

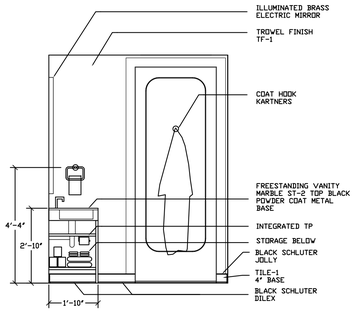

9 Elevation
3/8" = 1'-0"

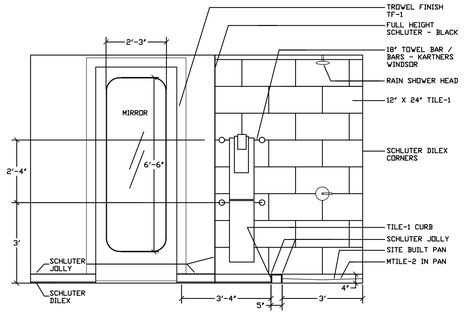

8 Elevation
3/8" = 1'-0"

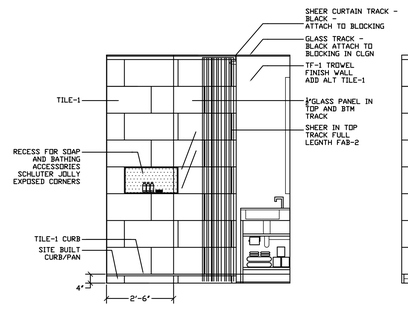

7 Elevation
3/8" = 1'-0"

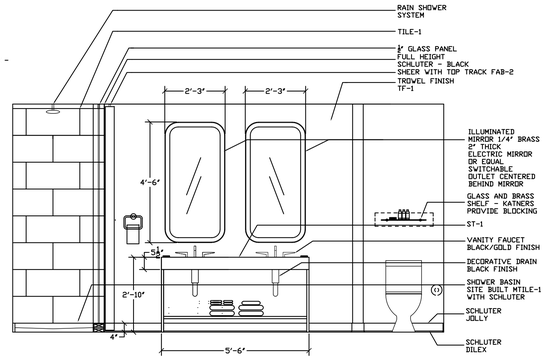

6 Elevation
3/8" = 1'-0"

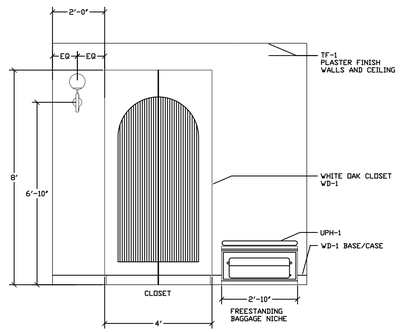

5 Elevation
3/8" = 1'-0"

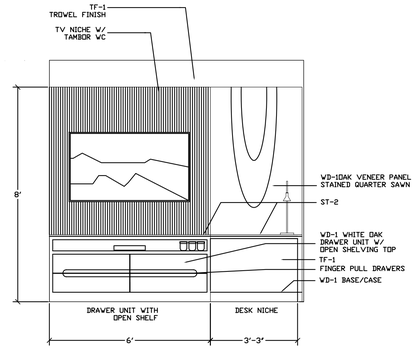

4 Elevation
3/8" = 1'-0"

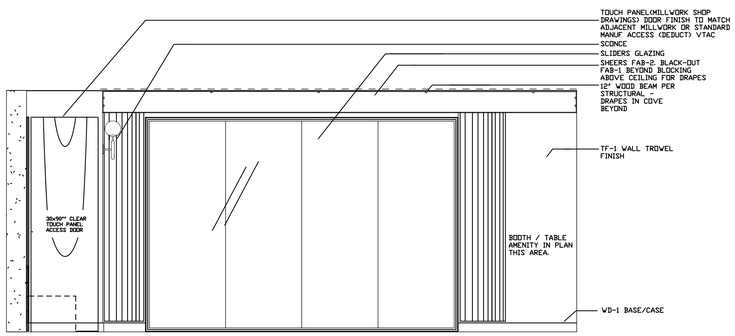

3 Elevation
3/8" = 1'-0"

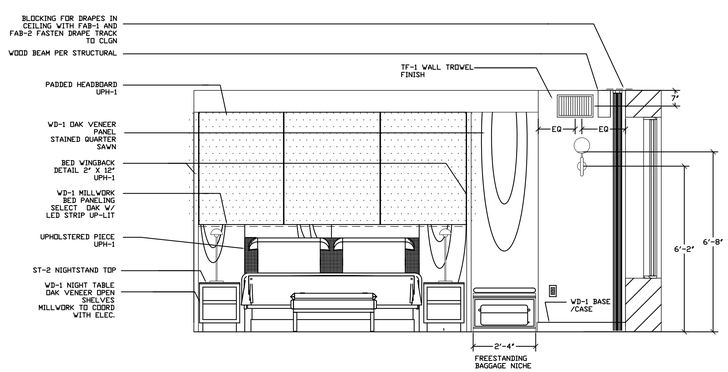

2 Elevation
3/8" = 1'-0"

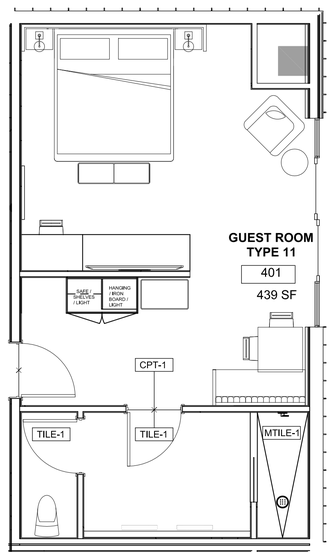

10 UNIT TYPE 11 FLOOR FINISHES
1/4" = 1'-0"

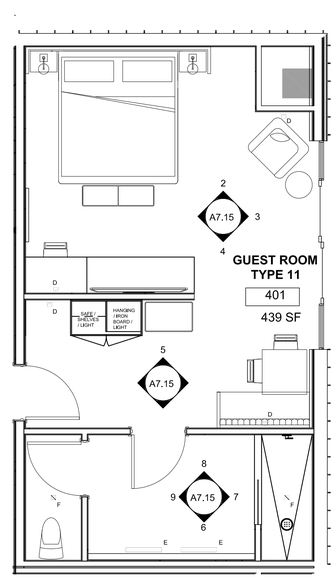

1 UNIT TYPE 11
1/4" = 1'-0"

STATE OF COLORADO
CHAD MITCHELL
40734
LICENSED ARCHITECT

HELTSHE

M1A | MERIDIAN 105 ARCHITECTURE

CITY HOTEL
415 PERRY STREET, CASTLE ROCK, CO.

DATE: 4.22.2026
PROJ. NO. 2023.002

ISSUED FOR: PERMIT

SHEET TITLE: ENLARGED PLAN & UNIT TYPE 11 ROOM ELEVATIONS

SHEET NUMBER
A7.15

C:\Users\daniel\Documents\City Hotel-2024_dlhscomb74CJ8.rvt
11/13/2024 3:04:58 PM

LIGHTING LEGEND

D - WALL SCONCE	E - ILLUMINATED MIRROR	F - RECESSED CAN

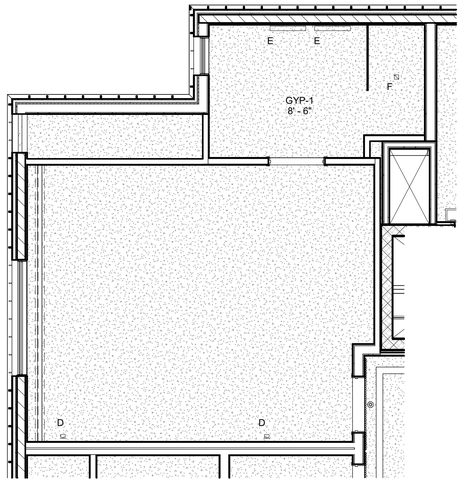

2 UNIT TYPE 13 - RCP
1/4" = 1'-0"

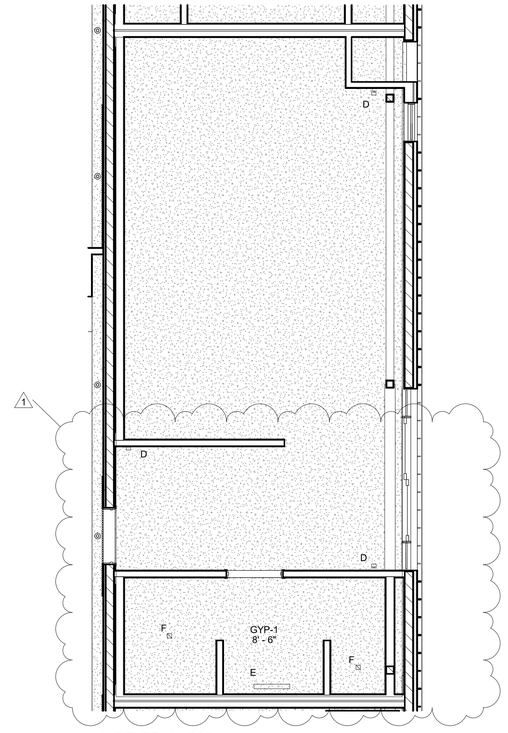

4 UNIT TYPE 12 - RCP
1/4" = 1'-0"

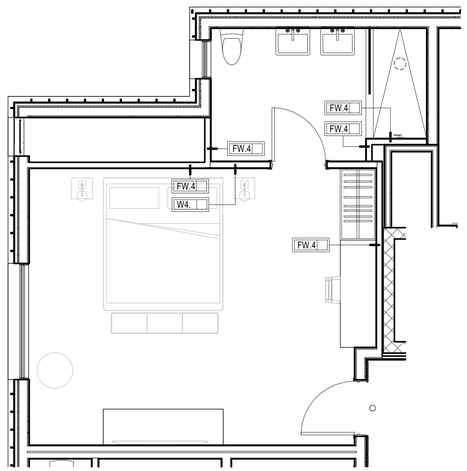

1 UNIT TYPE 13
1/4" = 1'-0"

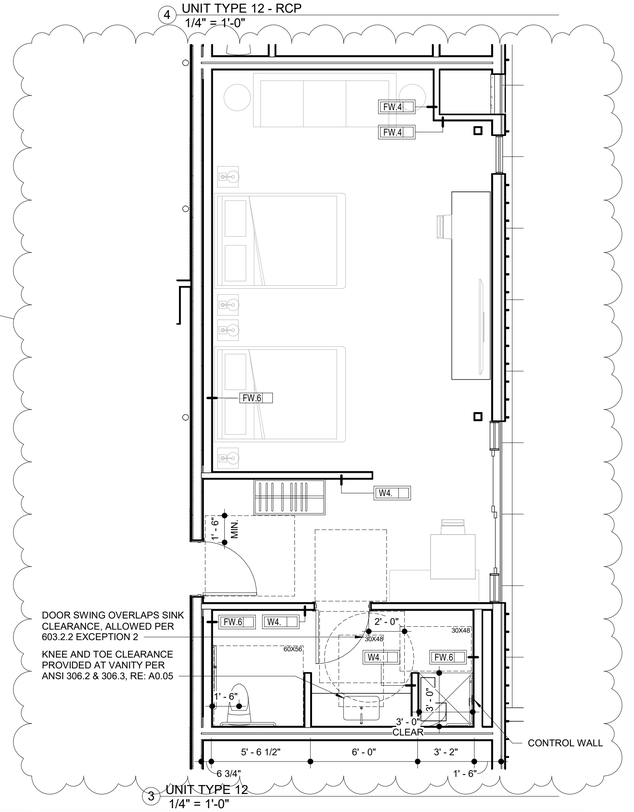

3 UNIT TYPE 12
1/4" = 1'-0"

UNIT GENERAL NOTES

1. UNLESS OTHERWISE INDICATED BY A CEILING TAG, CEILING WHICH ARE SHOWN SHALL BE ASSUMED TO BE THE BOTTOM OF THE FLOOR/CEILING ASSEMBLY.
2. WHERE FURRING WALLS ARE SHOWN ADJACENT TO CORRIDOR AND UNIT DEMISING WALLS, THE RATED UNIT AND DEMISING WALLS SHALL BE CONSTRUCTED WITH ALL LAYERS OF THE ASSEMBLY, INCLUDING DRYWALL, BEHIND THE FURRING WALL, IN ORDER TO MAINTAIN BOTH THE FIRE RATING AND ACOUSTICAL PROPERTIES.
3. ARCHITECTURAL REFLECTED CEILING PLANS MAY NOT DEPICT ALL OF THE LIGHT FIXTURES REQUIRED IN THE UNIT. GC AND ELECTRICAL SUBCONTRACTOR SHALL REVIEW BOTH THE ARCHITECTURAL REFLECTED CEILING PLANS, AND THE ELECTRICAL LIGHTING PLANS, AND SHALL CONSIDER ALL OF THE REQUIRMENTS DEPICTED THROUGHOUT THE DRAWING SET AS CUMULATIVE. THE PURPOSE OF THE ARCHITECTURAL REFLECTED CEILING PLANS IS PRIMARILY TO CONVEY THE LOCATION OF DECORATIVE FIXTURES.
4. WHEN TWO DIFFERENT WALL TYPES BUTT END TO END, GC SHALL COORDINATE STUD OFFSETS AS REQUIRED TO ALLOW THE DRYWALL FINISH TO RUN SMOOTHLY, AND IN A SINGLE PLANE ACROSS THE WALL TRANSITION.
5. DIMENSION FROM EDGE OF DOOR FRAME TO EDGE OF ADJACENT PERPENDICULAR FINISH TO BE 4" UON.

CEILING LEGEND

CEILING TYPES:

ACT-1: 2X4 LAY-IN CEILING, PARKING

ACT-2: 2X2 LAY-IN CEILING, KITCHEN, BACK OF HOUSE

ACT-3: 2X2 LAY-IN CEILING, KITCHEN, WITH METAL FINISH

WS-1: WOOD SLAT CEILING. PRODUCT BY USG INTERIORS 'SPECIALTY CEILING SYSTEM', TRUE WOOD. WOOD VENEER COLOR SELECTED BY ARCHITECT, WITH BLACK FELT REVEAL BACKING. MILLWORK BORDERS AND FLAT PLANAR AREAS TO MATCH FINISH, MATERIAL, AND COLOR OF SLAT PRODUCT.

GYP-1: GYPSUM BOARD ON METAL SUSPENSION SYSTEM, OR WOOD FRAMING

GYP-2: GYPSUM BOARD CEILING, RATED 2-HOURS, AER-09038

NOTE: REFER TO LIGHTING PLANS FOR COMPLETE LAYOUTS AND SPECIFICATIONS OF LIGHTING FIXTURES. DIMENSIONED LOCATION TO BE PROVIDED BY ARCHITECT.

C:\Users\daniel\Documents\City Hotel-2024_1_dlipscomb74Ca8.rvt
4/22/2026 1:08:45 PM

HELTSHE

M1A | MERIDIAN 105 ARCHITECTURE

CITY HOTEL
415 PERRY STREET, CASTLE ROCK, CO.

DATE: 4.22.2026
PROJ. NO. 2023.002

ISSUED FOR: PERMIT

SHEET TITLE: ENLARGED PLAN & RCP - UNIT TYPE 12,13

SHEET NUMBER
A7.16

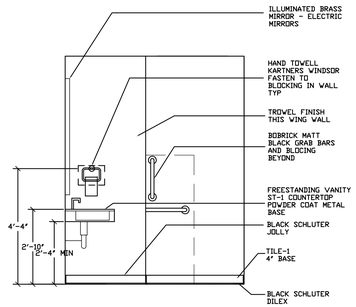

9 Elevation
3/8" = 1'-0"

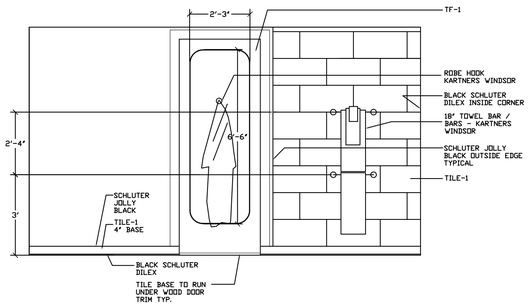

8 Elevation
3/8" = 1'-0"

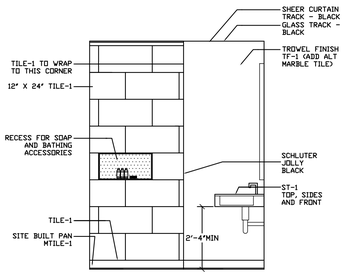

7 Elevation
3/8" = 1'-0"

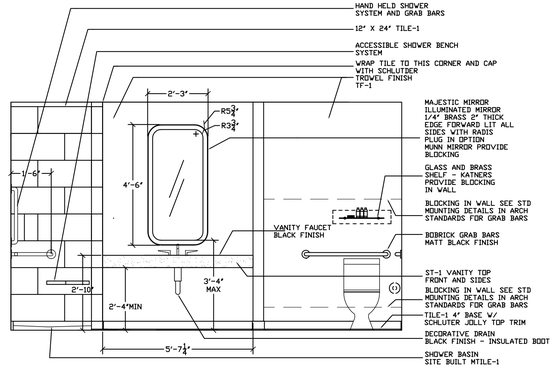

6 Elevation
3/8" = 1'-0"

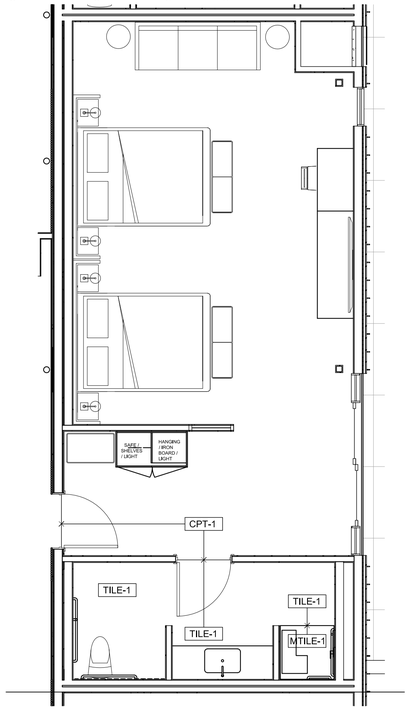

10 UNIT TYPE 12 FLOOR FINISH
1/4" = 1'-0"

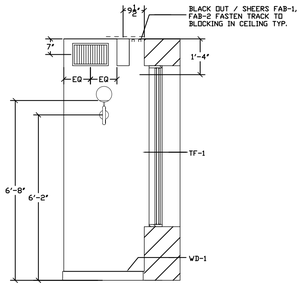

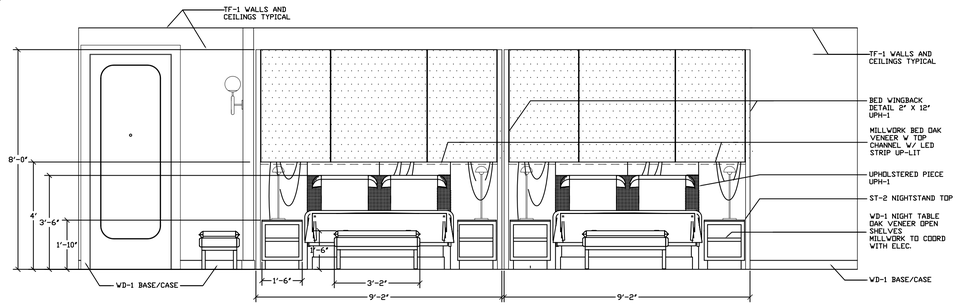

5 Elevation
3/8" = 1'-0"

4 Elevation
3/8" = 1'-0"

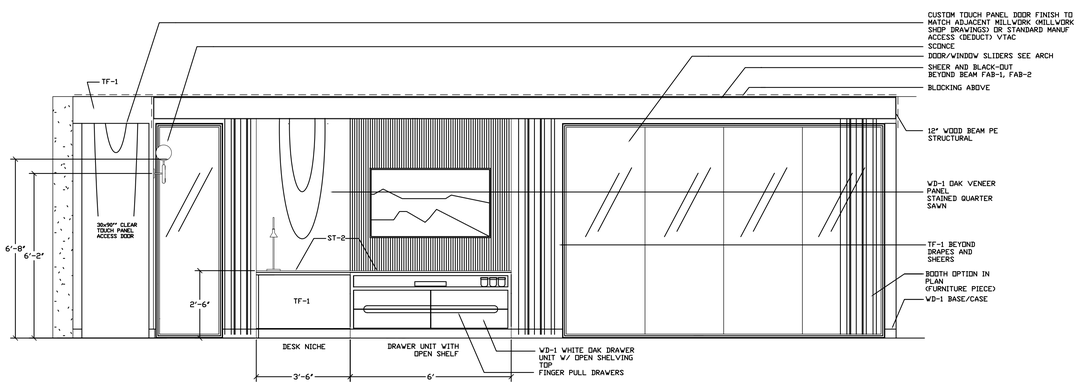

3 Elevation
3/8" = 1'-0"

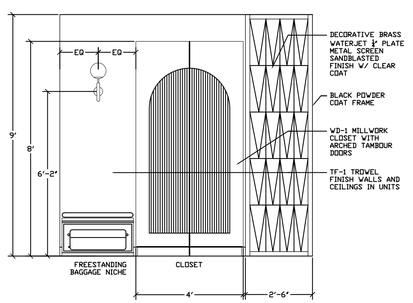

2 Elevation
3/8" = 1'-0"

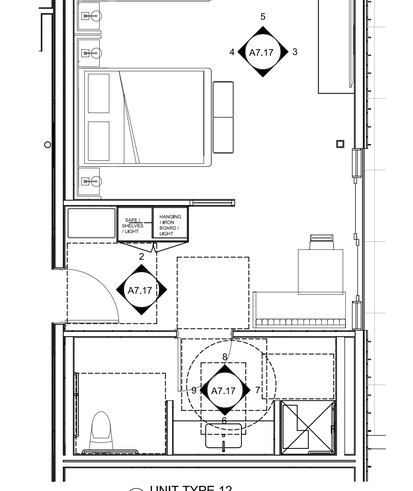

1 UNIT TYPE 12
1/4" = 1'-0"

C:\Users\daniel\Documents\City Hotel-2024_dlpscom\b74CJB.rvt
11/13/2024 3:04:58 PM

HELTSHE

M1A | MERIDIAN 105 ARCHITECTURE

CITY HOTEL
415 PERRY STREET, CASTLE ROCK, CO.

DATE: 4.22.2026
PROJ. NO. 2023.002

ISSUED FOR: PERMIT

SHEET TITLE: ENLARGED PLAN & UNIT TYPE 12 ROOM ELEVATIONS

STATE OF COLORADO
CHAD MITCHELL
400754
LICENSED ARCHITECT

SHEET NUMBER
A7.17

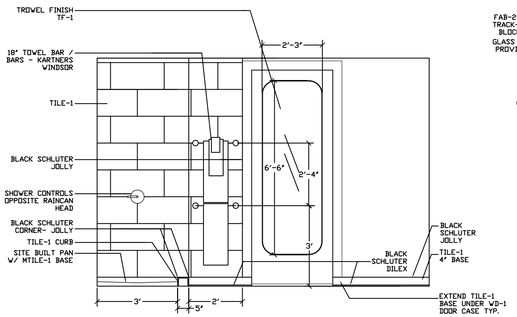

8 Elevation
3/8" = 1'-0"

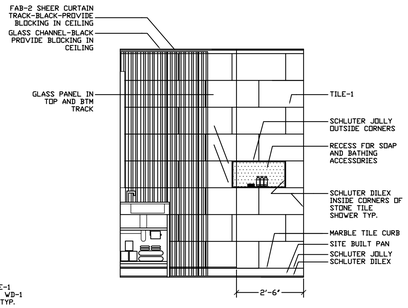

7 Elevation
3/8" = 1'-0"

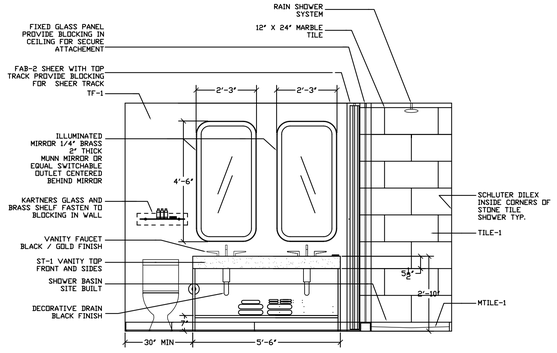

6 Elevation
3/8" = 1'-0"

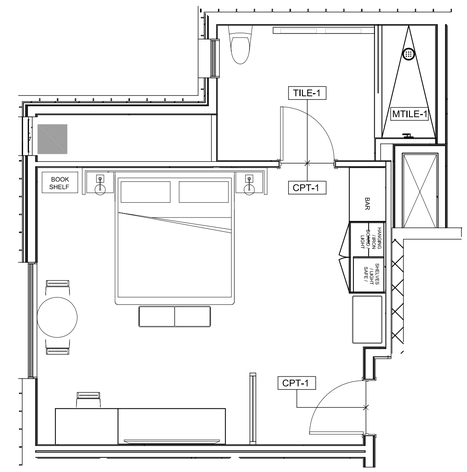

9 UNIT TYPE 13 - FLOOR FINISH
1/4" = 1'-0"

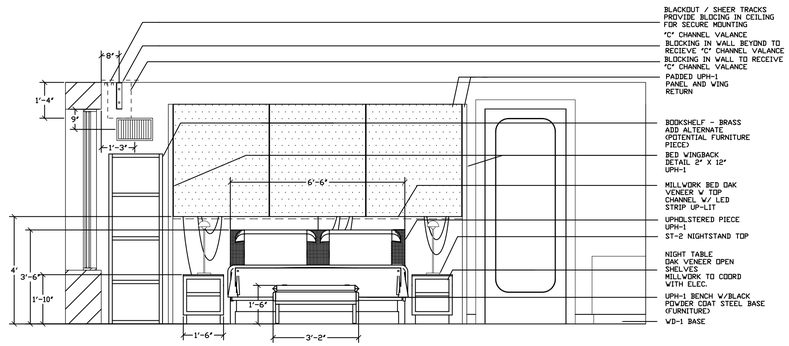

5 Elevation
3/8" = 1'-0"

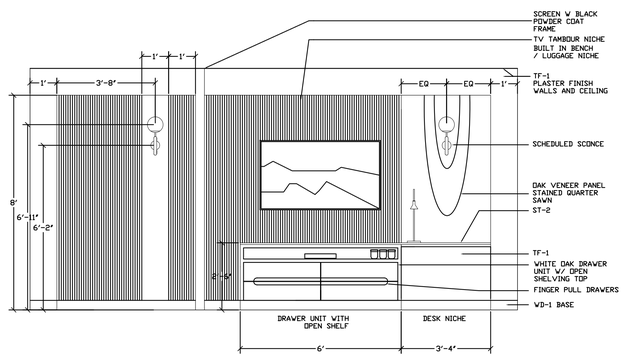

4 Elevation
3/8" = 1'-0"

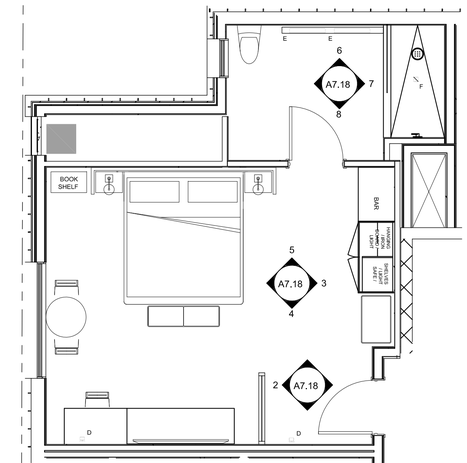

1 UNIT TYPE 13
1/4" = 1'-0"

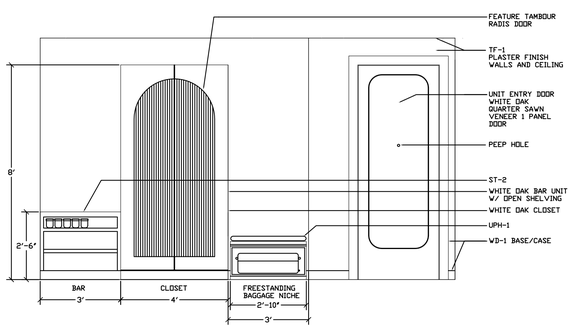

3 Elevation
3/8" = 1'-0"

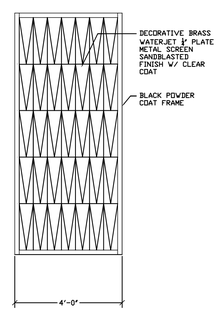

2 Elevation
3/8" = 1'-0"

C:\Users\daniel\Documents\City Hotel-2024_dlhscomb74CJ8.rvt
11/13/2024 3:04:58 PM

HELTSHE

M1A | MERIDIAN 105 ARCHITECTURE

CITY HOTEL
415 PERRY STREET, CASTLE ROCK, CO.

DATE: 4.22.2026
PROJ. NO. 2023.002

ISSUED FOR: PERMIT

SHEET TITLE: ENLARGED PLAN & UNIT TYPE 13 ROOM ELEVATIONS

STATE OF COLORADO * CHAD MITCHELL * 37734 * LICENSED ARCHITECT *

SHEET NUMBER
A7.18

FINISH SCHEDULE - ROOMS

ITEM NO.	AREA	NOTES	MANUFACTURER	MODEL	COLOR	NOTES
CPT-1	THROUGHOUT ROOMS	BROADLOOM	SHAW HOSPITALITY	SOLUTION DYE COLORPOINT - 32 OZ	SILVERS, TAUPES, GOLDS - 6 COLOR	BARBARA MARCY - 303.478.1802
CPT-1 ALT	THROUGHOUT ROOMS ALT	ALT DEDUCT BROADLOOM	SHAW HOSPITALITY	SOLUTION DYE MLCL - 32 OZ	SILVER, TAUPE, GOLD - 3 COLOR	BARBARA MARCY - 303.478.1802
TILE- 1	ROOM BATHROOM TILE	12X24 MARBLE TILE	SPEC CERAMICS	BIANCO DOLOMITI SELECT HONED	COLOR: WHITE	BRETT HAWKINS - 480.798.6905
TILE-1 ALT	ROOM BATHROOM TILE ALT	12X24 PORCELAIN TILE	SPEC CERAMICS	CAESAR COSMIX	COLOR: VENUS	BRETT HAWKINS - 480.798.6905
MTILE-1	SHOWER FLOOR MOSIAC	$\frac{1}{2}$" X $\frac{1}{2}$" ANTI SLIP SHOWER TILE	SPEC CERAMICS	APPIANI ANTHOLOGHIA ANTISDRUCCIOLO	CLEMATIDE MAS409C (R11-C)	BRETT HAWKINS - 480.798.6905
MTILE-1 ALT	SHOWER FLOOR MOSIAC ALT	1" X 1" ANTI SLIP SHOWER TILE	SPEC CERAMICS	APPIANI ANTHOLOGHIA ANTISDRUCCIOLO	CLEMATIDE MAS709C (R11-C)	BRETT HAWKINS - 480.798.6905
TF-1	WALLS AND CEILINGS	2 COAT PLASTER / CONC FINISH	VALENTINO	DOVE GREY - COLOR # 1VS0008	STYLE: TADELAKT	MAX SEDBROOK - 303.910.3644
TF-1 ALT	WALLS / CEILINGS PAINT ALT	VINYL WALLCOVERING	WOLF GORDON	PECKHAM	PKM 8-3775 RAIN	KENLEY GRAVES - 303.249.2629
WD-1	ROOM INTERIORS	CASE/BASE	-	4" SOLID OAK CASE AND BASE	STAINED QUARTER SAWN	SATIN CLEAR COAT SEALER
WD-1 ALT	ROOM INTERIORS ALT	CASE/BASE	-	4" PAINTED MDF	SW - 7639 ETHEREAL MOOD	EGGSHELL
GROUT	ROOM BATHROOM GROUT	SANDED	CUSTOM BLDG PRODUCTS	GROUT SOLUTIONS	# 185 NEW TAUPE	SAMPLE IN FIELD TO BE APPROVED BY DESIGN TEAM IN ADVANCE.
FAB-1	ROOM BLACKOUT DRAPE	150% FULLNESS - ROD DRAW	LEBATEX	DORMIR - 9599-0-BKO - LINEN	54" - NO REPEAT - 19.42 OZ	BARBARA MARCY - 303.478.1802
FAB-2	ROOM SHEER	150% FULLNESS - ROD DRAW	LEBATEX	LUNA VOILE - 9698-0-SHR - CHAMPAGNE	118" - NO REPEAT - .29 OZ	BARBARA MARCY - 303.478.1802
ST-1	BATHROOM VANITY STONE	3 CM	LACOUR STONEWORKS	SOAPSTONE - NATURAL STONE	STORMY BLACK	720-570-0467 OR EQUAL
ST-2	ROOM CASEWORK STONE	3 CM	LACOUR STONEWORKS	QUARTZITE - NATURAL STONE	SUPER WHITE	720-570-0467 OR EQUAL
UPH-1	CASEWORK LEATHER	48 SF HIDES	CARROLL LEATHER	DEFY THE LAWS	WHISKEY TONE	BARBARA MARCY - 303.478.1802
UPH-1 ALT	WOLF GORDON POLYURETHANE	UPHOLSTERY	WOLF GORDON	VAQUERO	SADDLE - VAQ 9630	KENLEY GRAVES - 303.249.2629

FINISH SCHEDULE - PUBLIC SPACES

ITEM NO.	AREA	NOTES	MANUFACTURER	MODEL	COLOR	NOTES
PCPT-1	THROUGHOUT HALLWAYS	BROADLOOM	SHAW HOSPITALITY	SOLUTION DYE COLORPOINT - 36 OZ	SILVERS, TAUPES, GOLDS - 6 COLOR	BARBARA MARCY - 303.478.1802
PCPT-1 ALT	THROUGHOUT ROOMS ALT	ALT DEDUCT BROADLOOM	SHAW HOSPITALITY	SOLUTION DYE MLCL - 36 OZ	SILVER, TAUPE, GOLD - 3 COLOR	BARBARA MARCY - 303.478.1802
TILE- 1	PUBLIC RESTROOM TILE	12X24 MARBLE TILE	SPEC CERAMICS	BIANCO DOLOMITI SELECT HONED	COLOR: WHITE	BRETT HAWKINS - 480.798.6905
TILE-1 ALT	PUBLIC RESTROOM TILE ALT	12X24 PORCELAIN TILE	SPEC CERAMICS	CAESAR COSMIX	COLOR: VENUS	BRETT HAWKINS - 480.798.6905
WF-1	MAIN LOBBY	3/4" X 3" X 30"	CUSTOM MILLED	HERRINGBONE WHITE OAK	STAINED	CARLISLE OR EQUAL
WF-1 ALT	MAIN LOBBY	3/4" X 4-10" X 8-12' PLANKS	CUSTOM MILLED	WHITE OAK WIDE PLANK	STAINED	CARLISLE OR EQUAL
TF-1	WALLS AND CEILINGS	2 COAT PLASTER / CONC FINISH	VALENTINO	DOVE GREY - COLOR # 1VS0008	STYLE: TADELAKT	MAX SEDBROOK - 303.910.3644
TF-1 ALT	WALLS / CEILINGS PAINT ALT	VINYL WALLCOVERING	WOLF GORDON	PECKHAM	PKM 8-3775 RAIN	KENLEY GRAVES - 303.249.2629
WD-1	PUBLIC SPACE	CASE/BASE	-	4" SOLID OAK CASE AND BASE	STAINED QUARTER SAWN	SATIN CLEAR COAT SEALER
WD-1 ALT	PUBLIC SPACE	CASE/BASE	-	4" PAINTED MDF	SW - 7639 ETHEREAL MOOD	EGGSHELL
GROUT	RESTROOM GROUT	SANDED	CUSTOM BLDG PRODUCTS	GROUT SOLUTIONS	# 185 NEW TAUPE	SAMPLE IN FIELD TO BE APPROVED BY DESIGN TEAM IN ADVANCE.
WM-1	ENTRANCE VESTIBULE	SIZED TO FIT	AMERICAN FLOOR MATS	COCOA MATS - 1" THICK	COLOR: NATURAL	OR EQUAL - HEAVY DUTY WALK OFF
FAB-2	PUBLIC SHEER	150% FULLNESS - ROD DRAW	LEBATEX	LUNA VOILE - 9698-0-SHR - CHAMPAGNE	118" - NO REPEAT - .29 OZ	BARBARA MARCY - 303.478.1802
MTL-1	METAL BALL BAR SCREEN	125% FULLNESS - FIXED	BALL CHAIN	$\frac{1}{4}$" ANTIQUE BROWN BALL-BAR	SIZE PER DRAWINGS	BILL TAUBER 914.720.3164
CONC	MAIN LOBBY	EXPOSED CONCRETE	-	EXPOSED AGGREGATE	NATURAL / PARCHMENT	CLEAR SEALER
ST-1	PUBLIC SPACE STONE	3 CM	LACOUR STONEWORKS	SOAPSTONE - NATURAL STONE	STORMY BLACK	720-570-0467 OR EQUAL
ST-2	PUBLIC SPACE STONE	3 CM	LACOUR STONEWORKS	QUARTZITE - NATURAL STONE	SUPER WHITE	720-570-0467 OR EQUAL
VCT-1	BOH OFFICE	-	ARMSTRONG	VINYL COMPOSITION TILE	CLASSIC BLACK 5C910	-
P-1	BOH	BOH WALLS	SHERWIN WILLIAMS	-	SW 7029 AGREEABLE GRAY	EGGSHELL FINISH
P-2	BOH	BOH CEILINGS	SHERWIN WILLIAMS	-	SW 7014 EIDER WHITE	FLAT FINISH

1 FINISHES
NTS

STATE OF COLORADO
CHAD MITCHELL
400754
LICENSED ARCHITECT

HELTSHE

M1A MERIDIAN 105 ARCHITECTURE

CITY HOTEL
415 PERRY STREET, CASTLE ROCK, CO.

DATE: 4.22.2026
PROJ. NO. 2023.002

ISSUED FOR: PERMIT

SHEET TITLE: FINISH SPECIFICATIONS

SHEET NUMBER
A7.19

C:\Users\daniel\Documents\City Hotel-2024_dllpscomb74CJ8.rvt
11/13/2024 3:04:58 PM

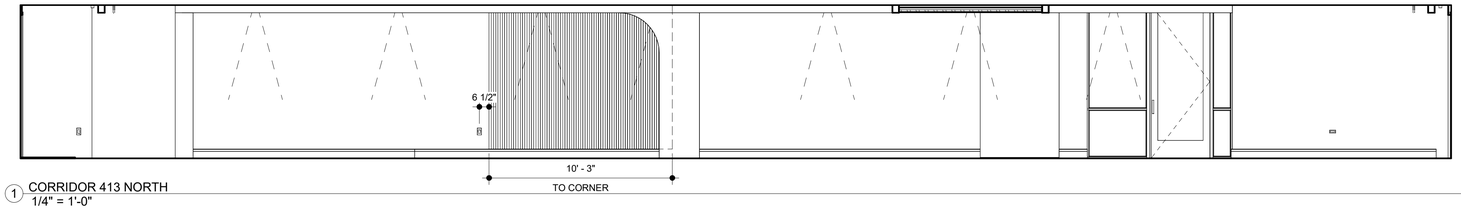

1 CORRIDOR 413 NORTH
1/4" = 1'-0"

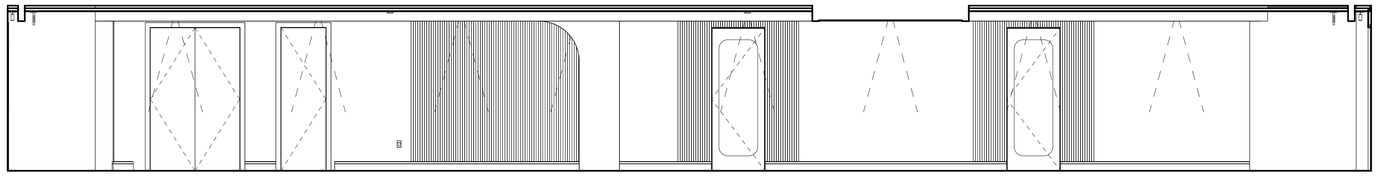

3 CORRIDOR 318 NORTH
1/4" = 1'-0"

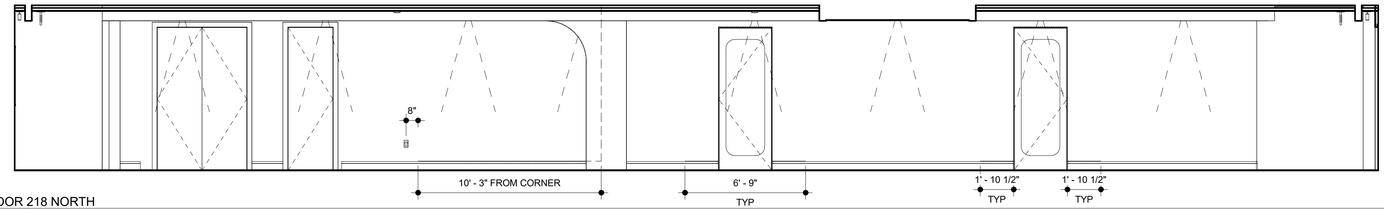

5 CORRIDOR 218 NORTH
1/4" = 1'-0"

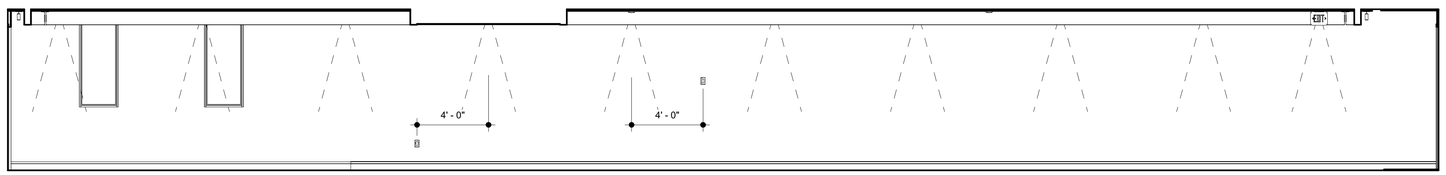

2 CORRIDOR 413 SOUTH
1/4" = 1'-0"

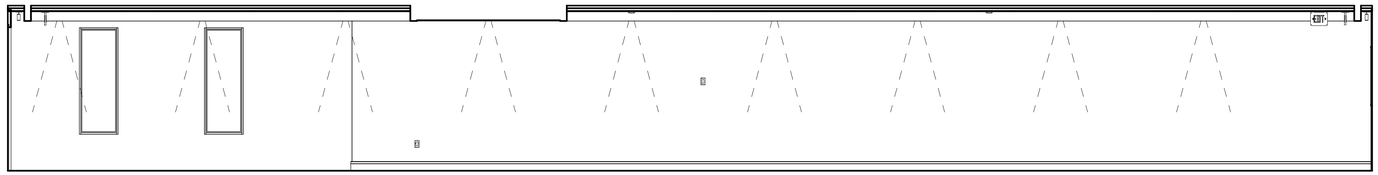

4 CORRIDOR 318 SOUTH
1/4" = 1'-0"

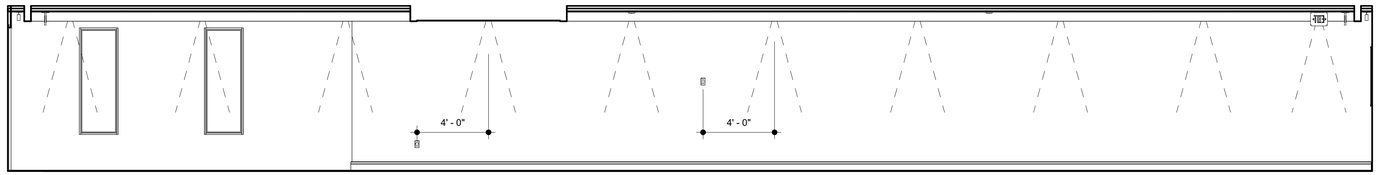

6 CORRIDOR 218 SOUTH
1/4" = 1'-0"

HELTSHE

M1A | MERIDIAN 105 ARCHITECTURE

CITY HOTEL
415 PERRY STREET, CASTLE ROCK, CO.

DATE: 4.22.2026	ISSUED FOR: PERMIT	SHEET TITLE: CORRIDOR ELEVATIONS	SHEET NUMBER A7.20
PROJ. NO. 2023.002			

C:\Users\daniel\Documents\City Hotel-2024_1_dlipscomb74CJB.rvt

4/22/2026 1:08:49 PM

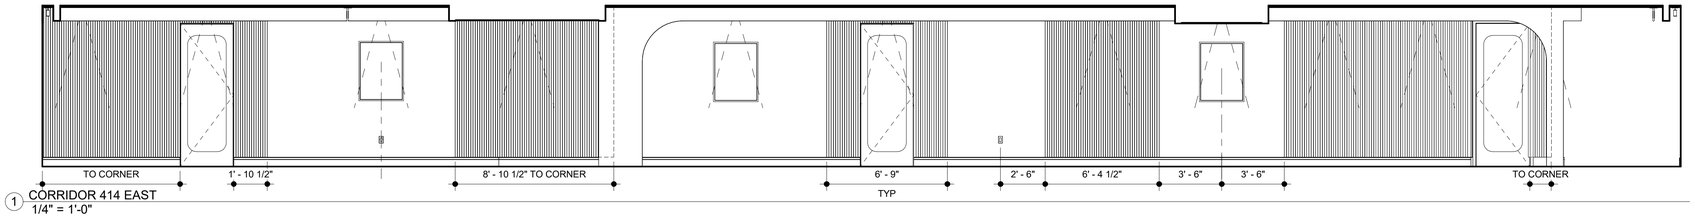

1 CORRIDOR 414 EAST
1/4" = 1'-0"

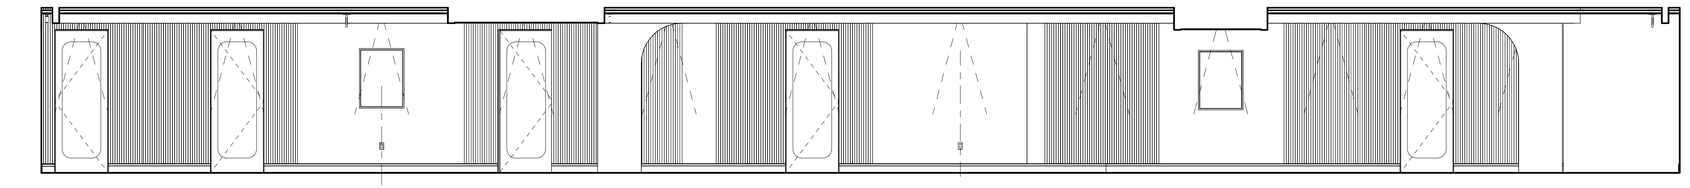

2 CORRIDOR 316 EAST
1/4" = 1'-0"

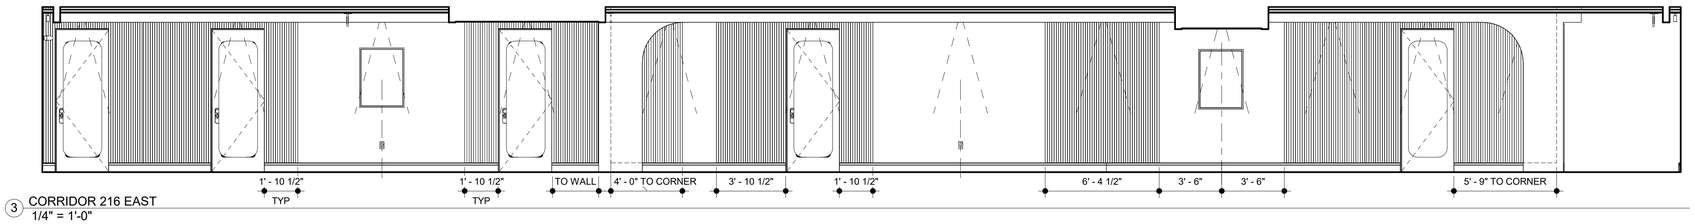

3 CORRIDOR 216 EAST
1/4" = 1'-0"

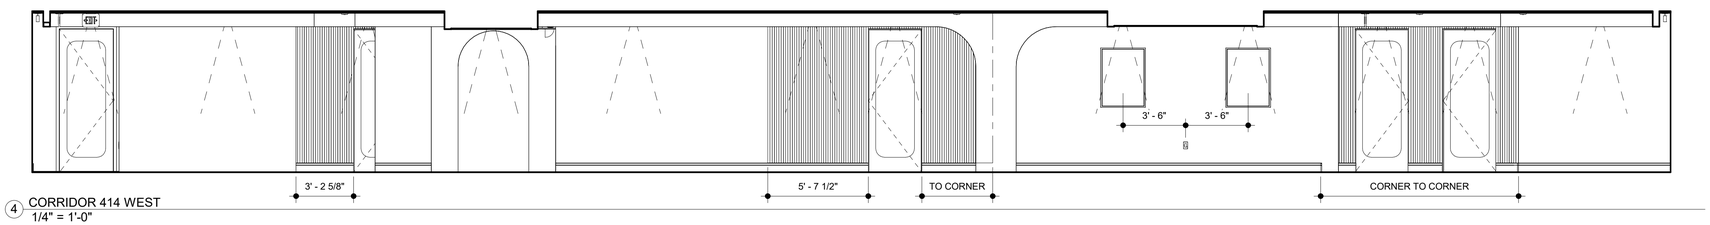

4 CORRIDOR 414 WEST
1/4" = 1'-0"

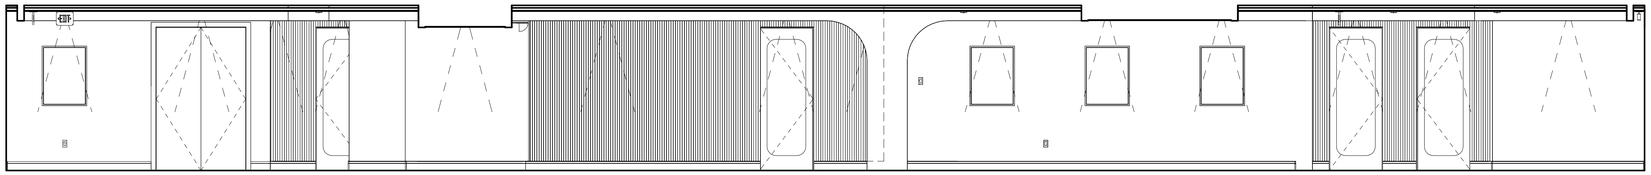

5 CORRIDOR 316 WEST
1/4" = 1'-0"

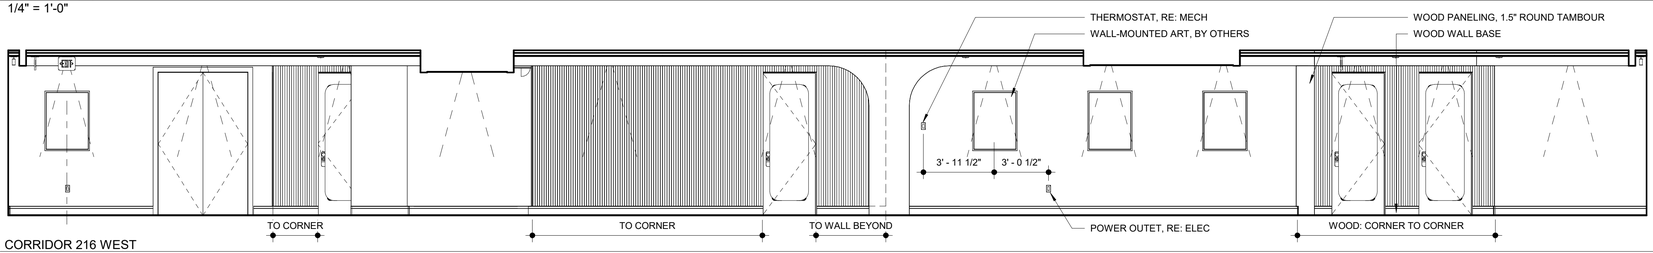

6 CORRIDOR 216 WEST
1/4" = 1'-0"

HELTSHE

M1A | MERIDIAN 105 ARCHITECTURE

CITY HOTEL
415 PERRY STREET, CASTLE ROCK, CO.

DATE: 4.22.2026
PROJ. NO. 2023.002

ISSUED FOR: PERMIT

SHEET TITLE: CORRIDOR ELEVATIONS

SHEET NUMBER A7.21

C:\Users\daniel\Documents\City Hotel-2024_1_dlipscomb74CJB.rvt
4/22/2026 1:08:54 PM

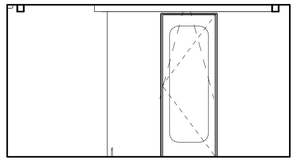

25 CORRIDOR 413 NOOK1 SOUTH
1/4" = 1'-0"

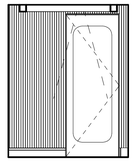

26 CORRIDOR 413 NOOK1 WEST
1/4" = 1'-0"

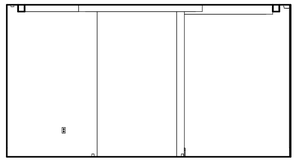

27 CORRIDOR 413 NOOK1 NORTH
1/4" = 1'-0"

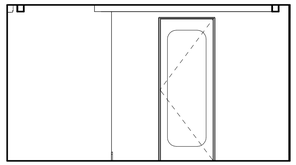

22 CORRIDOR 318 NOOK1 SOUTH
1/4" = 1'-0"

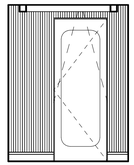

23 CORRIDOR 318 NOOK1 WEST
1/4" = 1'-0"

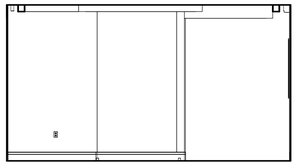

24 CORRIDOR 318 NOOK1 NORTH
1/4" = 1'-0"

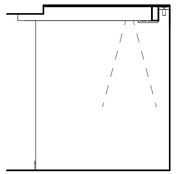

32 CORRIDOR 318 NOOK2 WEST
1/4" = 1'-0"

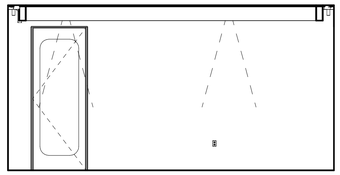

33 CORRIDOR 318 NOOK2 NORTH
1/4" = 1'-0"

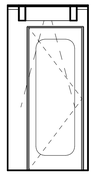

34 CORRIDOR 318 NOOK2 EAST
1/4" = 1'-0"

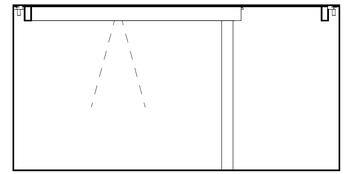

35 CORRIDOR 318 NOOK2 SOUTH
1/4" = 1'-0"

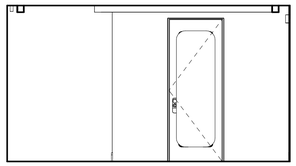

19 CORRIDOR 218 NOOK1 SOUTH
1/4" = 1'-0"

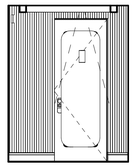

20 CORRIDOR 218 NOOK1 WEST
1/4" = 1'-0"

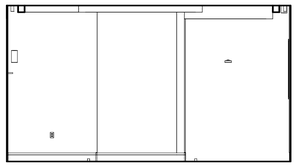

21 CORRIDOR 218 NOOK1 NORTH
1/4" = 1'-0"

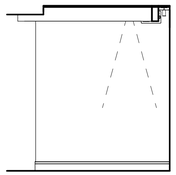

28 CORRIDOR 218 NOOK2 WEST
1/4" = 1'-0"

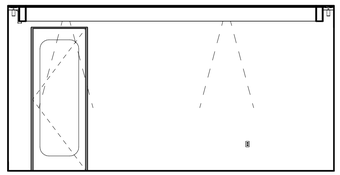

29 CORRIDOR 218 NOOK2 NORTH
1/4" = 1'-0"

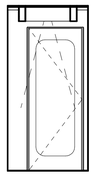

31 CORRIDOR 218 NOOK2 EAST
1/4" = 1'-0"

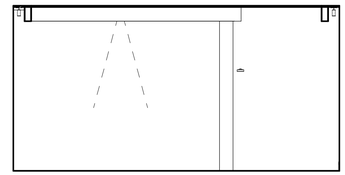

30 CORRIDOR 218 NOOK2 SOUTH
1/4" = 1'-0"

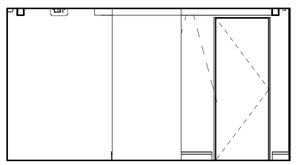

9 CORRIDOR 414 NOOK SOUTH
1/4" = 1'-0"

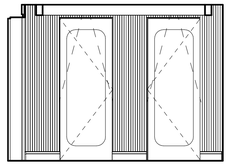

8 CORRIDOR 414 NOOK WEST
1/4" = 1'-0"

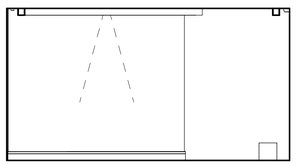

7 CORRIDOR 414 NOOK NORTH
1/4" = 1'-0"

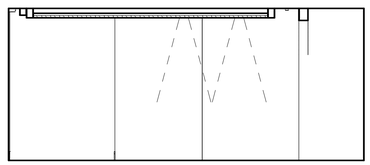

15 LOBBY 412 SOUTH
1/4" = 1'-0"

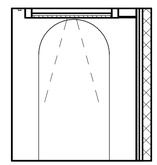

14 LOBBY 412 WEST
1/4" = 1'-0"

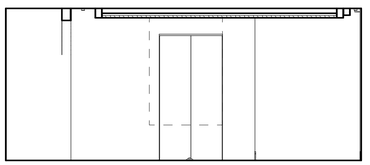

13 LOBBY 412 NORTH
1/4" = 1'-0"

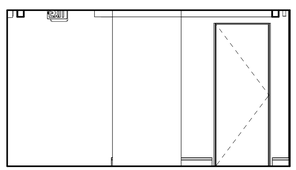

6 CORRIDOR 316 NOOK SOUTH
1/4" = 1'-0"

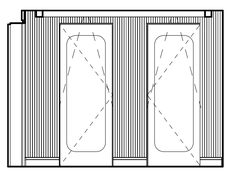

5 CORRIDOR 316 NOOK WEST
1/4" = 1'-0"

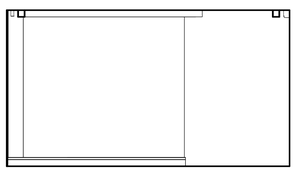

4 CORRIDOR 316 NOOK NORTH
1/4" = 1'-0"

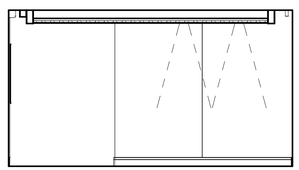

18 LOBBY 317 SOUTH
1/4" = 1'-0"

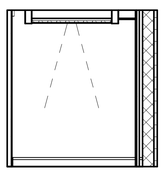

17 LOBBY 317 WEST
1/4" = 1'-0"

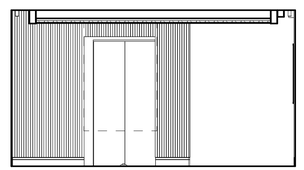

16 LOBBY 317 NORTH
1/4" = 1'-0"

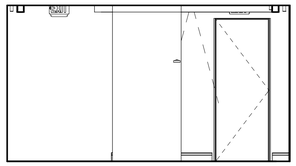

3 CORRIDOR 216 NOOK SOUTH
1/4" = 1'-0"

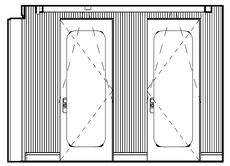

2 CORRIDOR 216 NOOK WEST
1/4" = 1'-0"

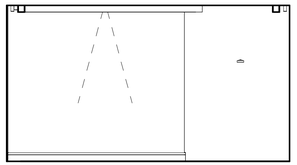

1 CORRIDOR 216 NOOK NORTH
1/4" = 1'-0"

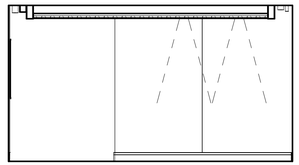

12 LOBBY 217 SOUTH
1/4" = 1'-0"

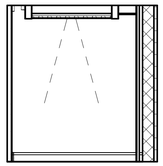

11 LOBBY 217 WEST
1/4" = 1'-0"

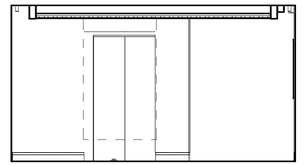

10 LOBBY 217 NORTH
1/4" = 1'-0"

C:\Users\daniel\Documents\City Hotel-2024_1_dlipscomb7AC8.rvt

4/22/2026 1:09:06 PM

HELTSHE

M1A MERIDIAN 105 ARCHITECTURE

CITY HOTEL
415 PERRY STREET, CASTLE ROCK, CO.

DATE: 4.22.2026
PROJ. NO. 2023.002

ISSUED FOR:
PERMIT

SHEET TITLE:
CORRIDOR ELEVATIONS

SHEET NUMBER
A7.22

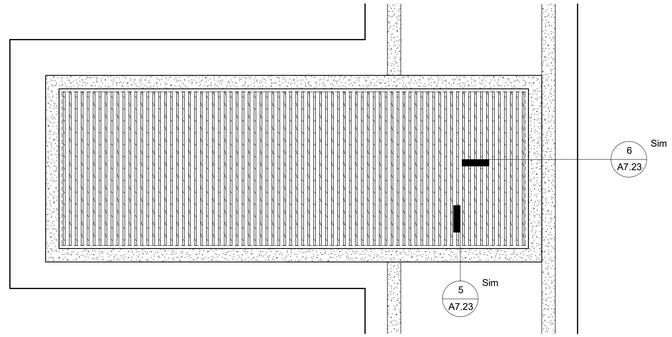

4 ENLARGED RCP - WOOD SLAT CEILING
1/2" = 1'-0"

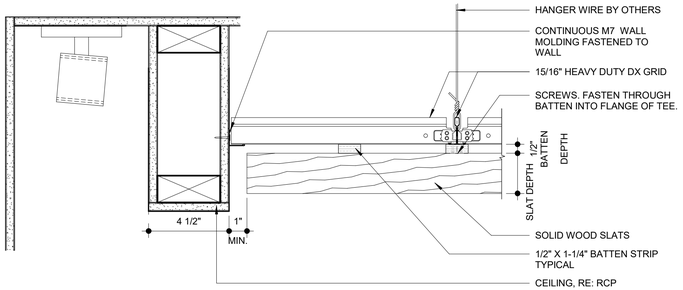

5 WOOD SLAT DETAIL
3" = 1'-0"

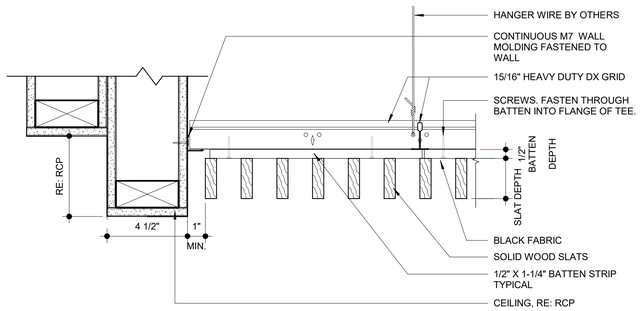

6 WOOD SLAT DETAIL 2
3" = 1'-0"

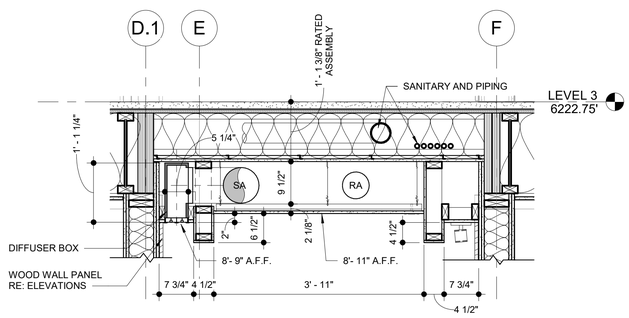

7 WALL DETAIL - CORRIDOR CEILING
3/4" = 1'-0"

CEILING LEGEND

CEILING TYPES:

ACT-1: 2X4 LAY-IN CEILING, PARKING

ACT-2: 2X2 LAY-IN CEILING, KITCHEN, BACK OF HOUSE

ACT-3: 2X2 LAY-IN CEILING, KITCHEN, WITH METAL FINISH

WS-1: WOOD SLAT CEILING. PRODUCT BY USG INTERIORS 'SPECIALTY CEILING SYSTEM', TRUE WOOD. WOOD VENEER COLOR SELECTED BY ARCHITECT, WITH BLACK FELT REVEAL BACKING. MILLWORK BORDERS AND FLAT PLANAR AREAS TO MATCH FINISH, MATERIAL, AND COLOR OF SLAT PRODUCT.

GYP-1: GYPSUM BOARD ON METAL SUSPENSION SYSTEM, OR WOOD FRAMING

GYP-2: GYPSUM BOARD CEILING, RATED 2-HOURS, AER-09038

NOTE: REFER TO LIGHTING PLANS FOR COMPLETE LAYOUTS AND SPECIFICATIONS OF LIGHTING FIXTURES. DIMENSIONED LOCATION TO BE PROVIDED BY ARCHITECT.

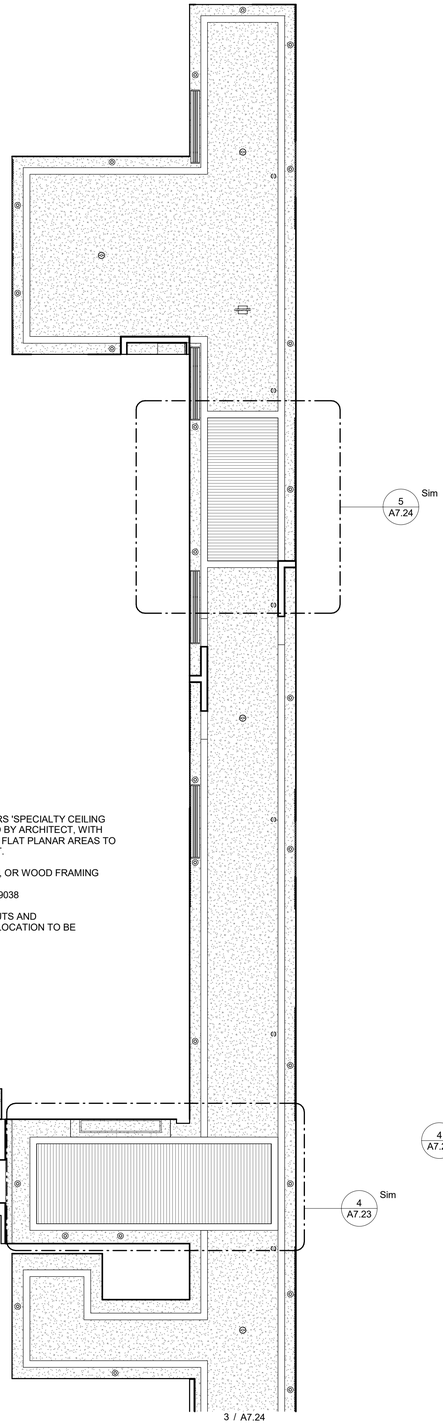

3 ENLARGED RCP N-S - LEVEL 4
1/4" = 1'-0"

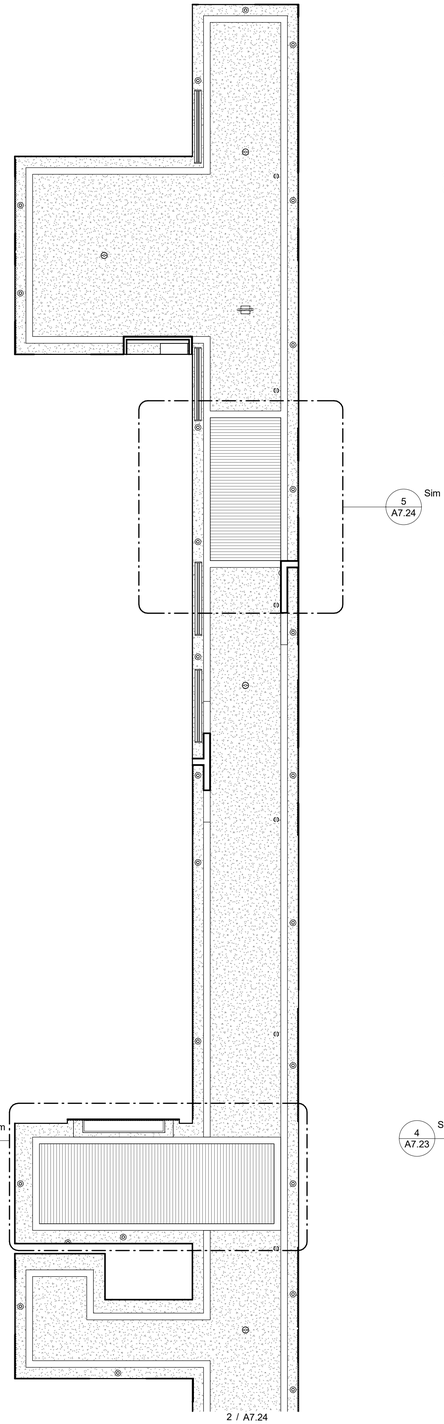

2 ENLARGED RCP N-S - LEVEL 3
1/4" = 1'-0"

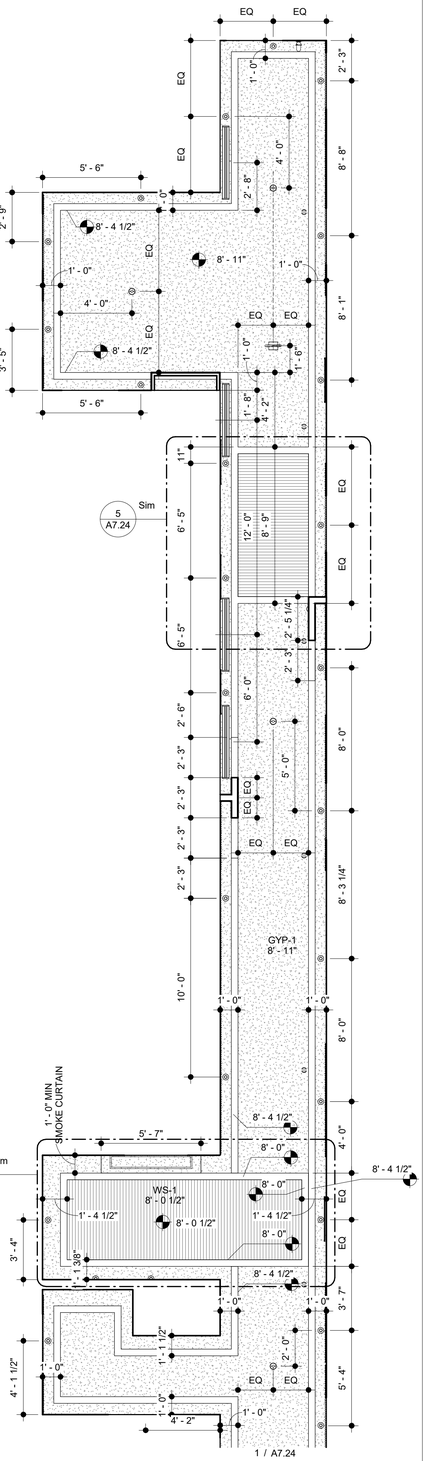

1 ENLARGED RCP N-S - LEVEL 2
1/4" = 1'-0"

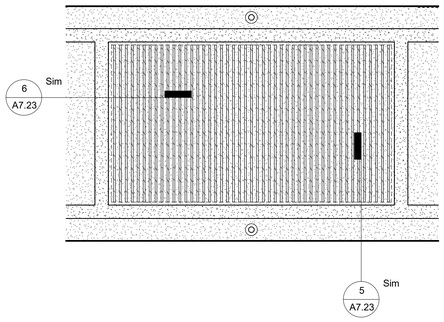

4 ENLARGED RCP - WOOD SLAT CEILING 2
1/2" = 1'-0"

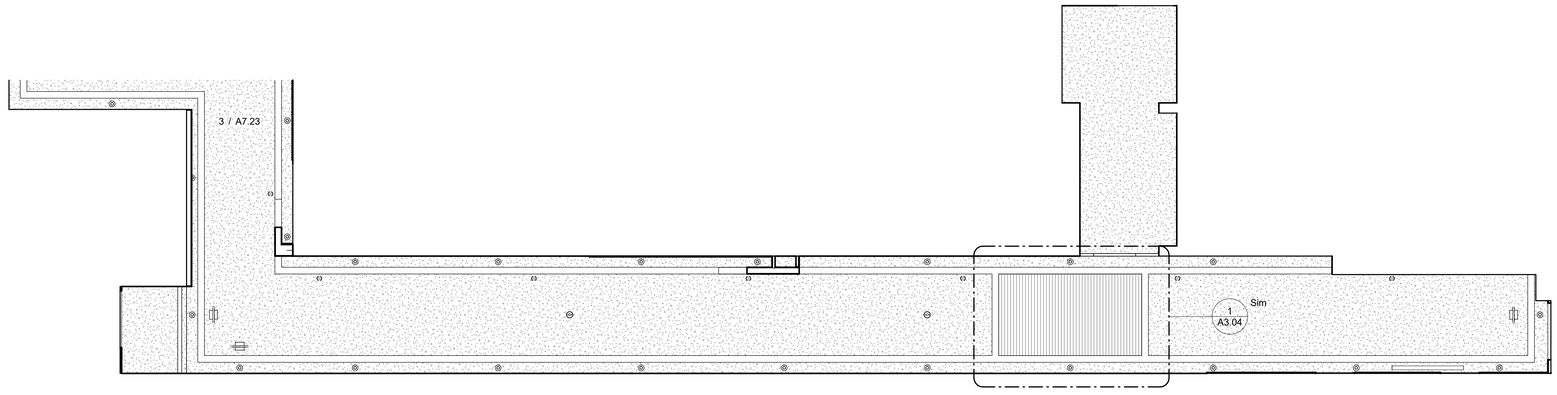

3 ENLARGED RCP E-W - LEVEL 4
1/4" = 1'-0"

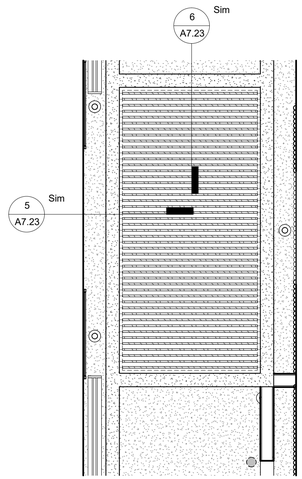

5 ENLARGED RCP - WOOD SLAT CEILING 3
1/2" = 1'-0"

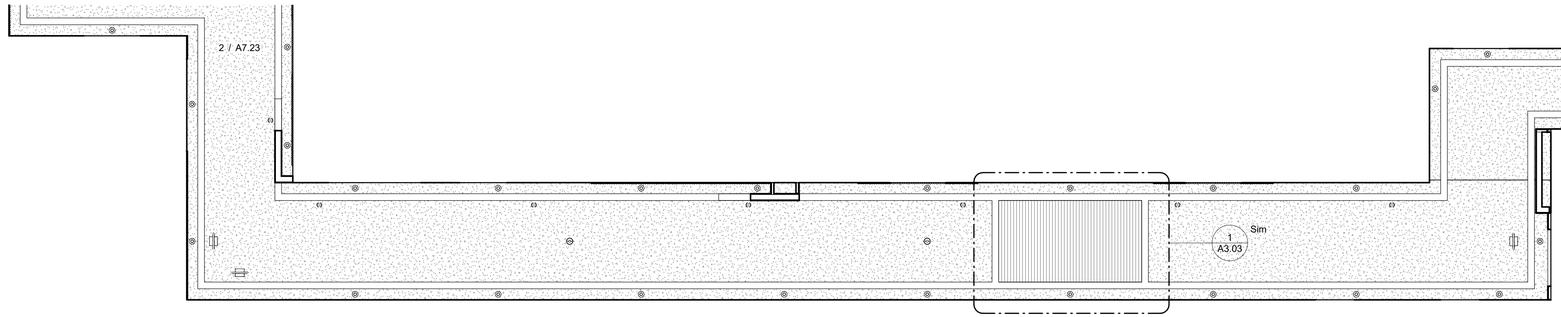

2 ENLARGED RCP E-W - LEVEL 3
1/4" = 1'-0"

CEILING LEGEND

CEILING TYPES:

ACT-1: 2X4 LAY-IN CEILING, PARKING

ACT-2: 2X2 LAY-IN CEILING, KITCHEN, BACK OF HOUSE

ACT-3: 2X2 LAY-IN CEILING, KITCHEN, WITH METAL FINISH

WS-1: WOOD SLAT CEILING. PRODUCT BY USG INTERIORS 'SPECIALTY CEILING SYSTEM', TRUE WOOD. WOOD VENEER COLOR SELECTED BY ARCHITECT, WITH BLACK FELT REVEAL BACKING. MILLWORK BORDERS AND FLAT PLANAR AREAS TO MATCH FINISH, MATERIAL, AND COLOR OF SLAT PRODUCT.

GYP-1: GYPSUM BOARD ON METAL SUSPENSION SYSTEM, OR WOOD FRAMING

GYP-2: GYPSUM BOARD CEILING, RATED 2-HOURS, AER-09038

NOTE: REFER TO LIGHTING PLANS FOR COMPLETE LAYOUTS AND SPECIFICATIONS OF LIGHTING FIXTURES. DIMENSIONED LOCATION TO BE PROVIDED BY ARCHITECT.

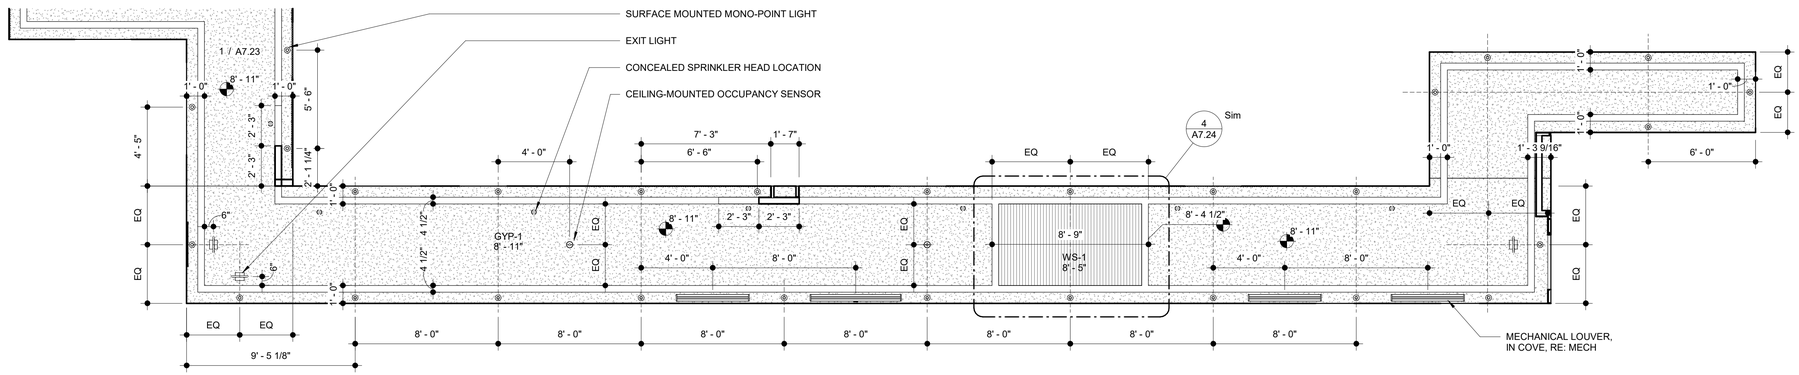

1 ENLARGED RCP E-W - LEVEL 2
1/4" = 1'-0"

C:\Users\daniel\Documents\City Hotel-2024_1_dlipscomb74CJ8.rvt
4/22/2026 1:09:17 PM

HELTSHE

M1A MERIDIAN 105 ARCHITECTURE

CITY HOTEL
415 PERRY STREET, CASTLE ROCK, CO.

DATE: 4.22.2026
PROJ. NO. 2023.002

ISSUED FOR:
PERMIT

SHEET TITLE:
CORRIDOR
REFLECTED CEILING
PLANS, AND DETAILS

SHEET NUMBER
A7.24

TAKE-OFF LEGEND - A7.30 (partition schedule order)

- FI.2-0 - BOARD ONLY (WOOD FRAMING EXCLUDED) - 2 wall(s) - 11.67 LF
- FW.4-0 - BOARD ONLY (WOOD FRAMING EXCLUDED) - 2 wall(s) - 12.92 LF
- W.6-0 - BOARD ONLY (WOOD FRAMING EXCLUDED) - 9 wall(s) - 113.13 LF

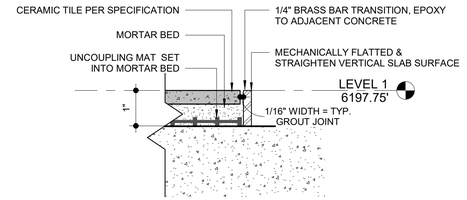

2 SECTION DETAIL - TILE / CONCRETE TRANSITION
6" = 1'-0"

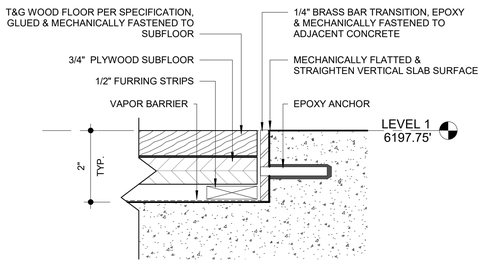

3 SECTION DETAIL - WOOD / CONCRETE TRANSITION
6" = 1'-0"

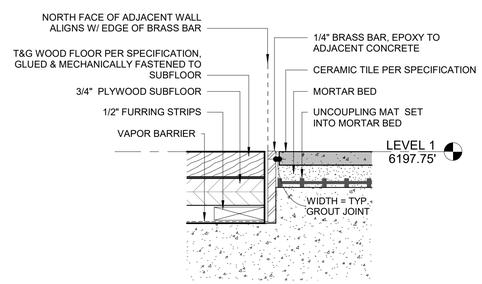

4 SECTION DETAIL - WOOD / TILE TRANSITION
6" = 1'-0"

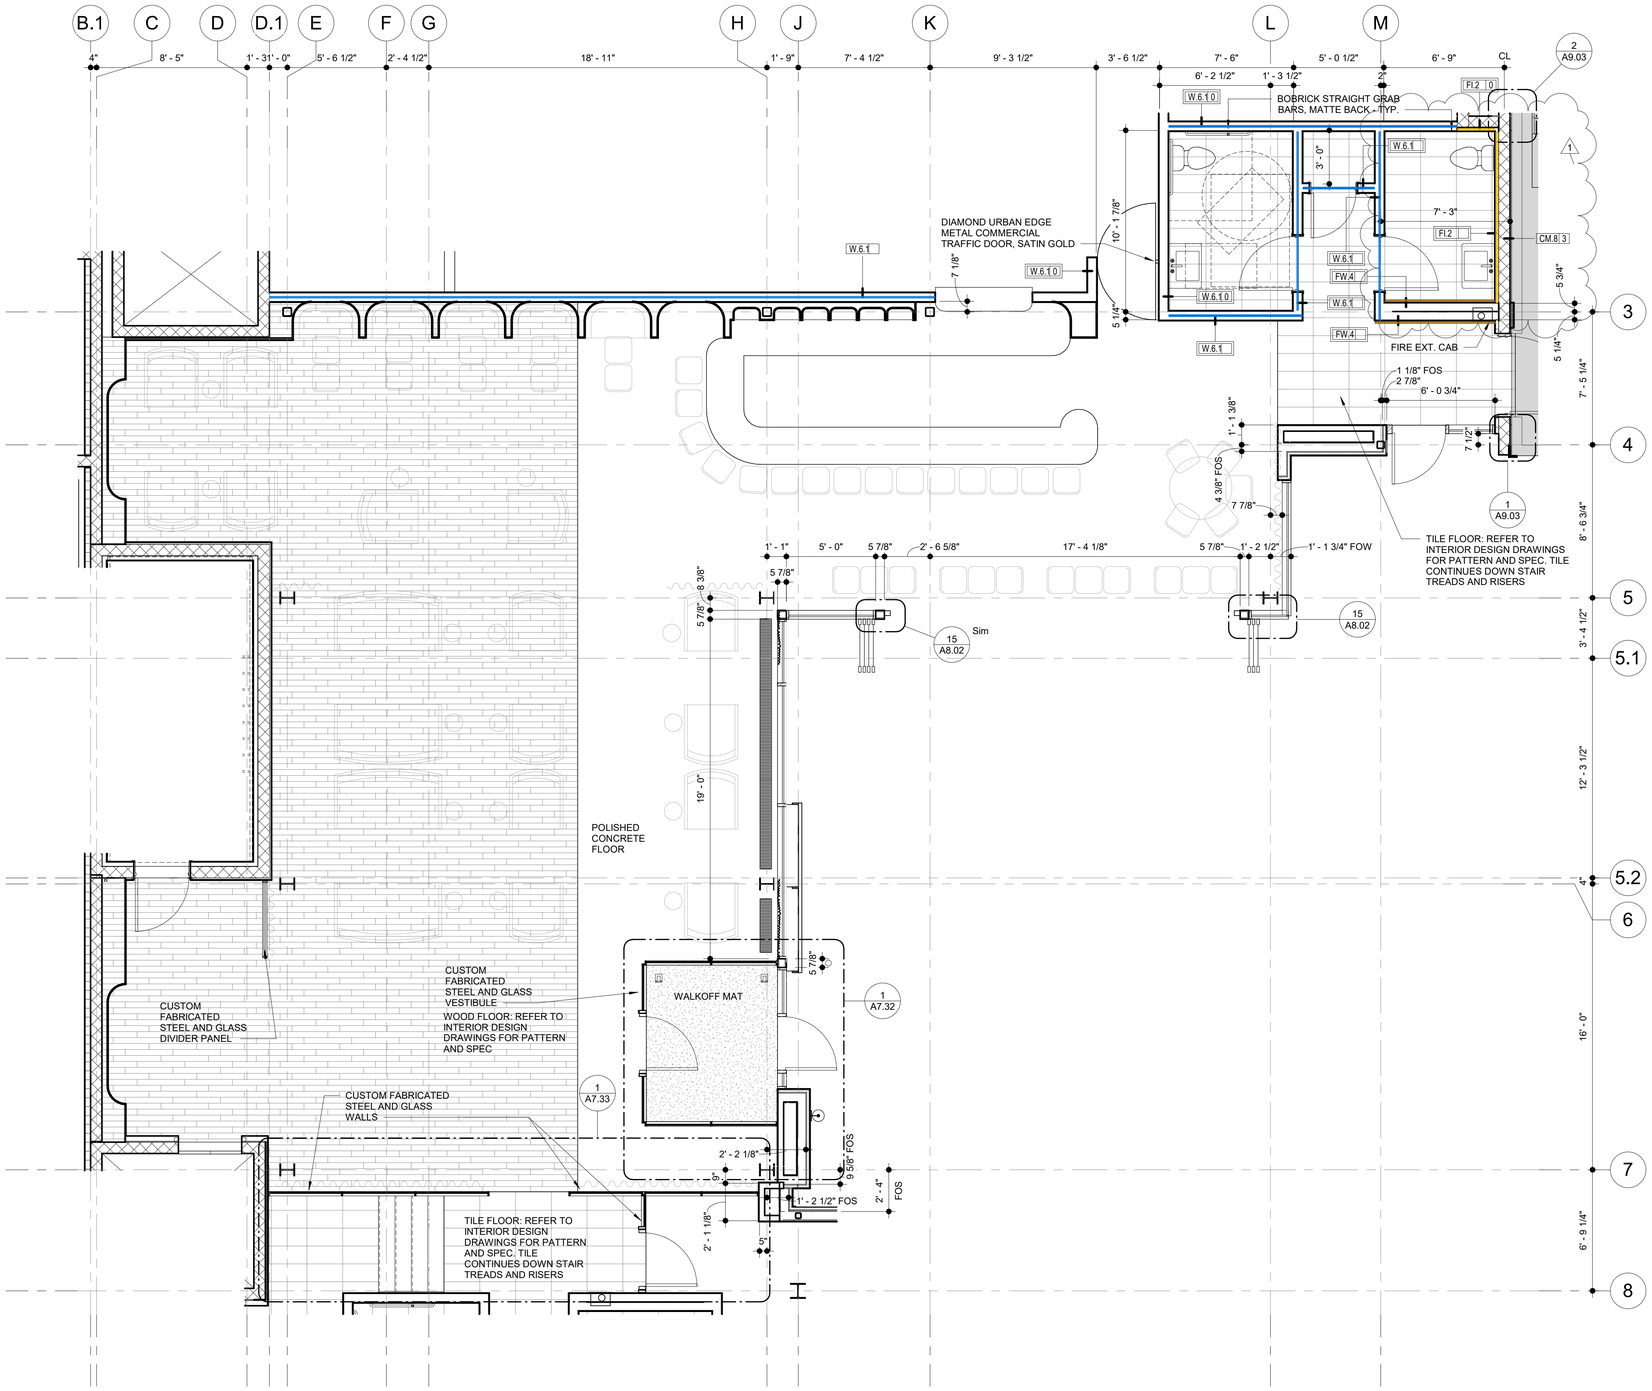

1 ENLARGEDPLAN - LOBBY & BAR
1/4" = 1'-0"

C:\Users\daniel\Documents\City Hotel-2024_1_dlipscomb74CJ8.rvt
4/22/2026 1:09:20 PM

HELTSHE | M1A MERIDIAN 105 ARCHITECTURE

CITY HOTEL
415 PERRY STREET, CASTLE ROCK, CO.

DATE: 4.22.2026
PROJ. NO. 2023.002

ISSUED FOR: PERMIT

SHEET TITLE: LOBBY - ENLARGED PLANS

SHEET NUMBER
A7.30

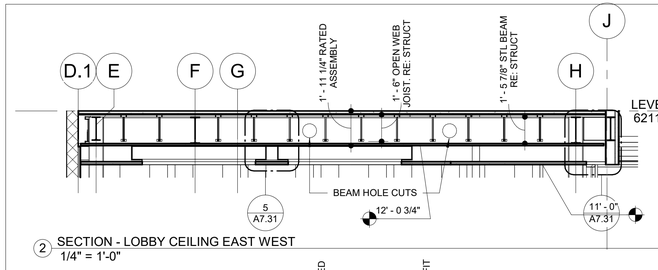

2 SECTION - LOBBY CEILING EAST WEST
1/4" = 1'-0"

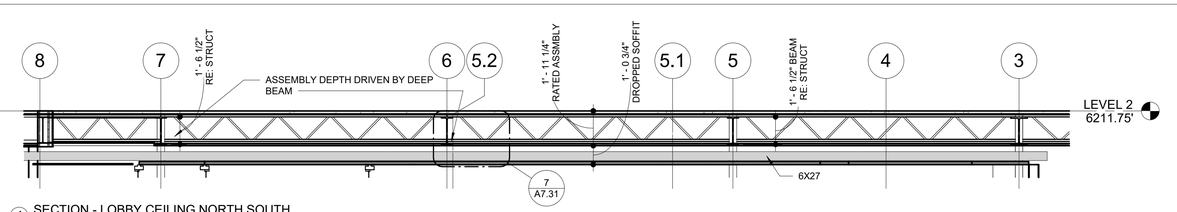

4 SECTION - LOBBY CEILING NORTH SOUTH
1/4" = 1'-0"

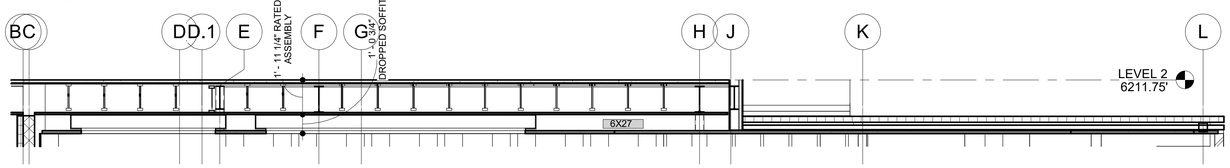

3 SECTION - BAR CEILING EAST WEST
1/4" = 1'-0"

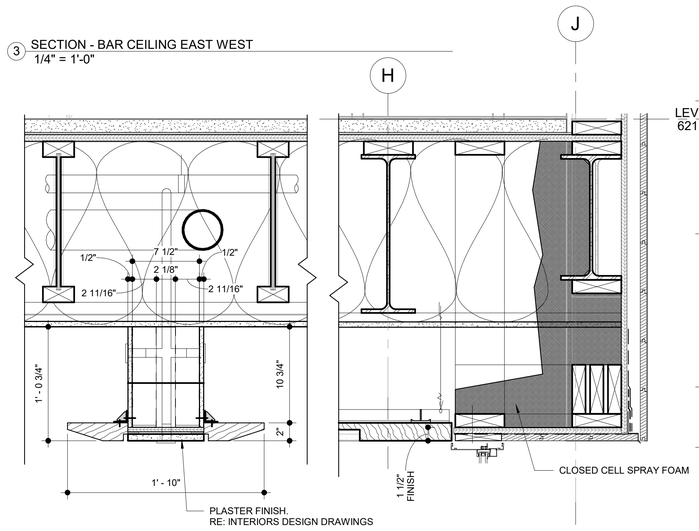

5 DETAIL - LOBBY CEILING
1 1/2" = 1'-0"

6 DETAIL - LOBBY CEILING EXT
1 1/2" = 1'-0"

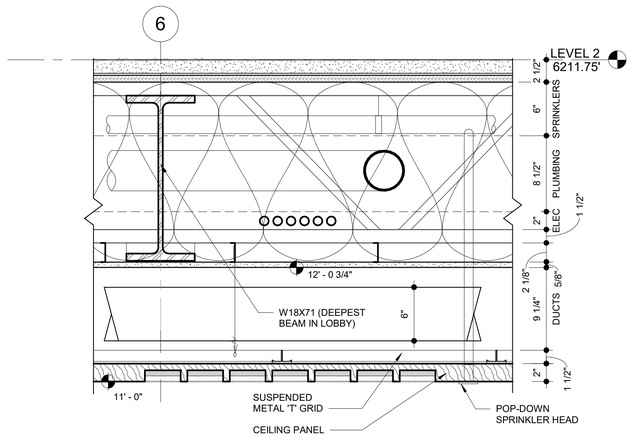

7 SECTION - LOBBY CEILING DETAIL
1 1/2" = 1'-0"

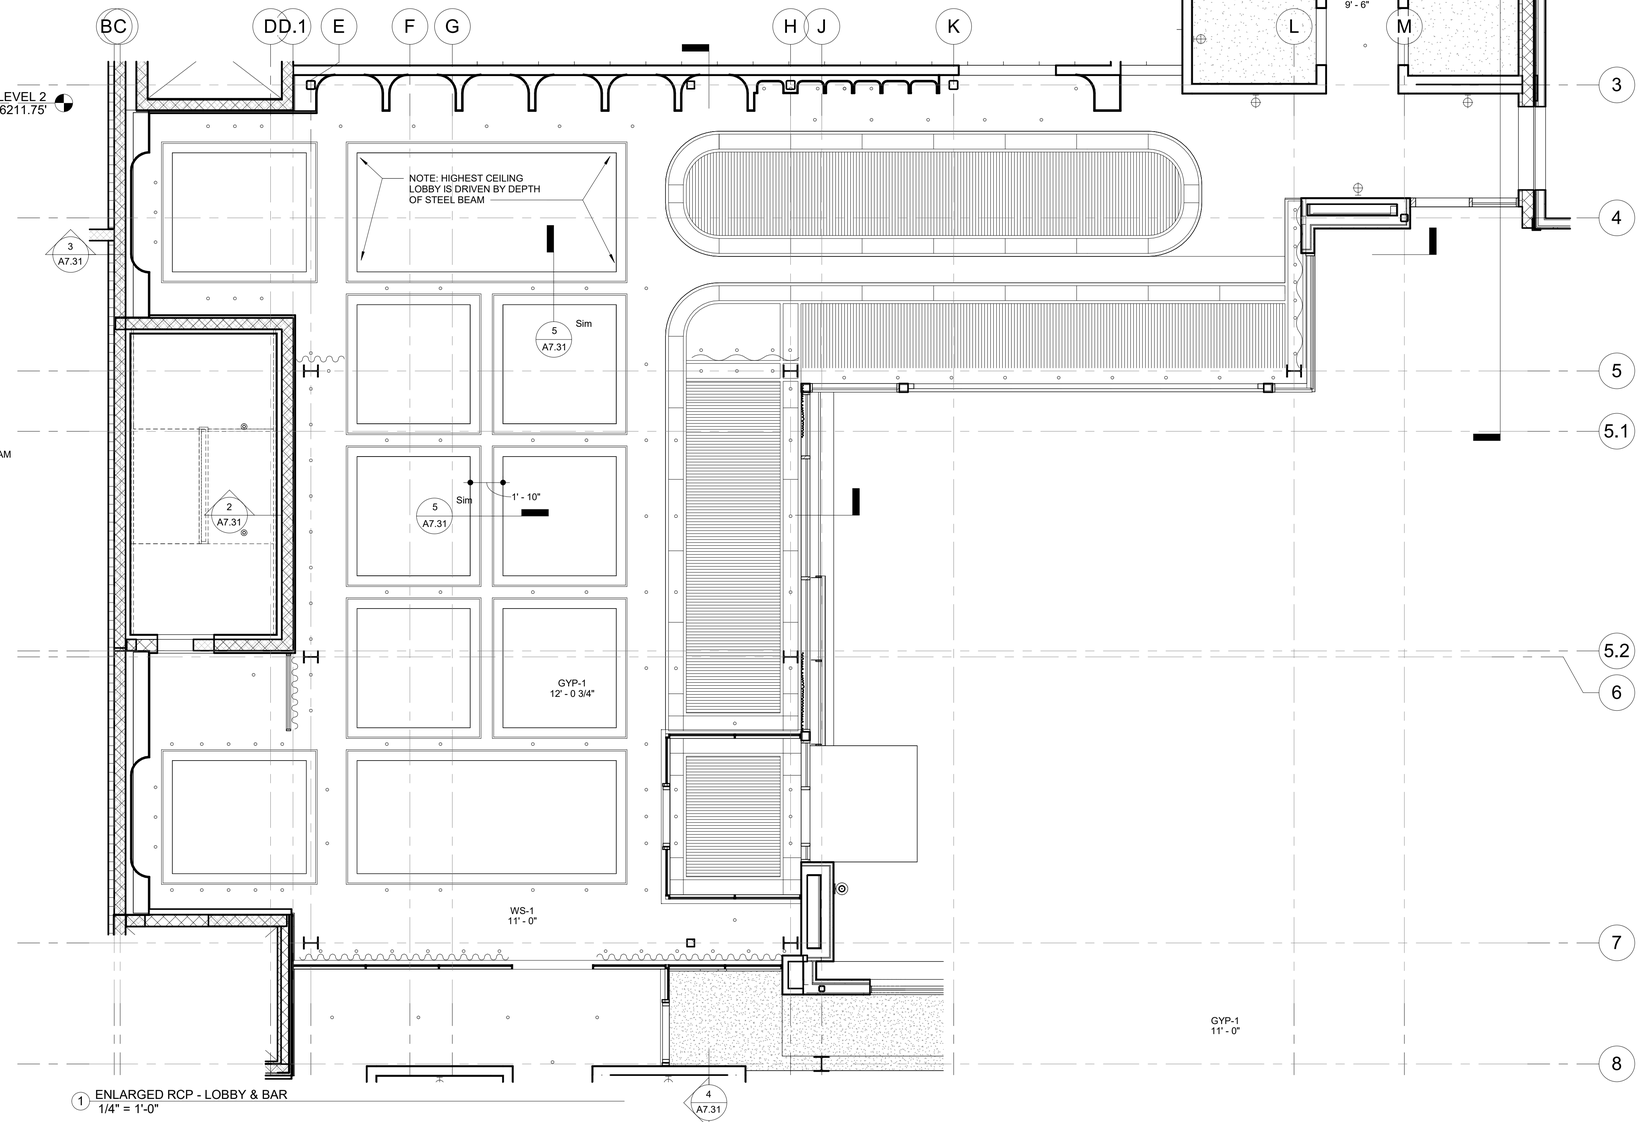

1 ENLARGED RCP - LOBBY & BAR
1/4" = 1'-0"

CEILING LEGEND

CEILING TYPES:

ACT-1: 2X4 LAY-IN CEILING, PARKING

ACT-2: 2X2 LAY-IN CEILING, KITCHEN, BACK OF HOUSE

ACT-3: 2X2 LAY-IN CEILING, KITCHEN, WITH METAL FINISH

WS-1: WOOD SLAT CEILING. PRODUCT BY USG INTERIORS 'SPECIALTY CEILING SYSTEM', TRUE WOOD. WOOD VENEER COLOR SELECTED BY ARCHITECT, WITH BLACK FELT REVEAL BACKING. MILLWORK BORDERS AND FLAT PLANAR AREAS TO MATCH FINISH, MATERIAL, AND COLOR OF SLAT PRODUCT.

GYP-1: GYPSUM BOARD ON METAL SUSPENSION SYSTEM, OR WOOD FRAMING

GYP-2: GYPSUM BOARD CEILING, RATED 2-HOURS, PER UL ASSEMBLY NO. ER-09038

NOTE: REFER TO LIGHTING PLANS FOR COMPLETE LAYOUTS AND SPECIFICATIONS OF LIGHTING FIXTURES. DIMENSIONED LOCATION TO BE PROVIDED BY ARCHITECT.

C:\Users\daniel\Documents\City Hotel-2024_1_dlipscomb74C.rvt

4/22/2026 1:09:25 PM

HELTSHE

M1A MERIDIAN 105 ARCHITECTURE

CITY HOTEL
415 PERRY STREET, CASTLE ROCK, CO.

DATE: 4.22.2026	ISSUED FOR: PERMIT	SHEET TITLE: LOBBY - ENLARGED REFLECTED CEILING PLAN	SHEET NUMBER A7.31
PROJ. NO. 2023.002			

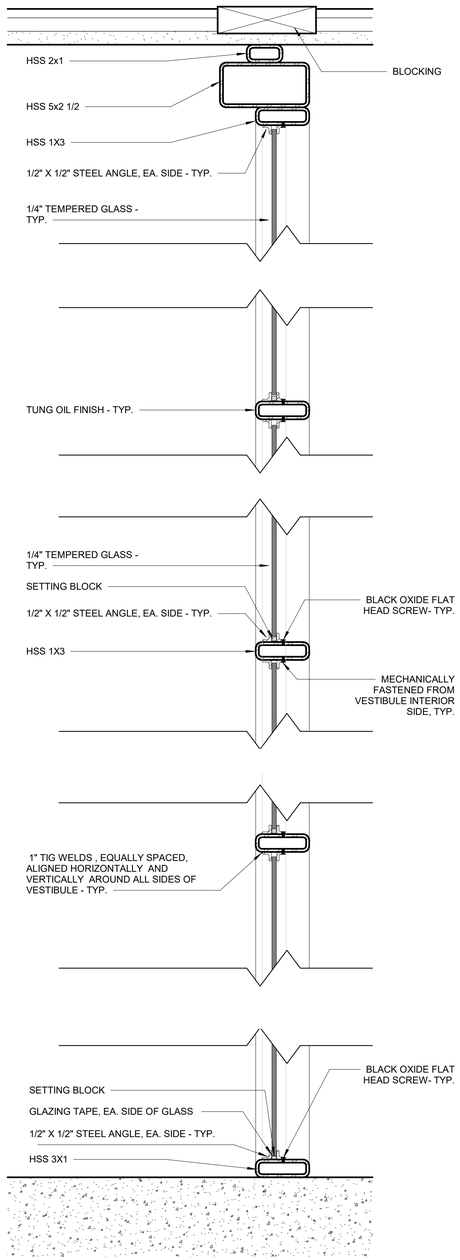

5 SECTION DETAIL - LOBBY VESTIBULE
3" = 1'-0"

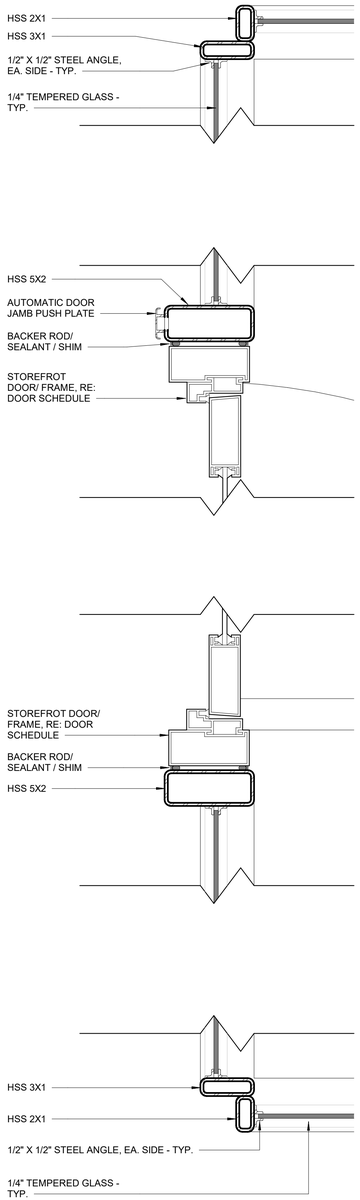

6 PLAN DETAIL - LOBBY VESTIBULE 1
3" = 1'-0"

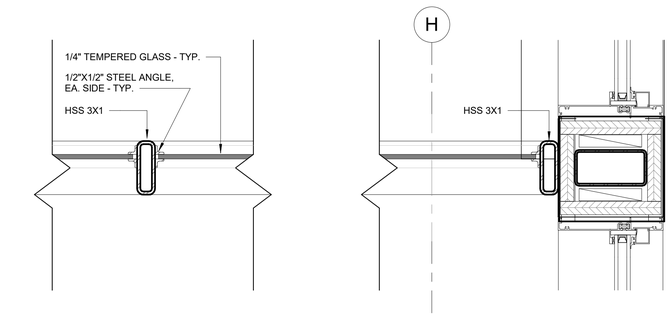

7 PLAN DETAIL - VESTIBULE FRAME
3" = 1'-0"

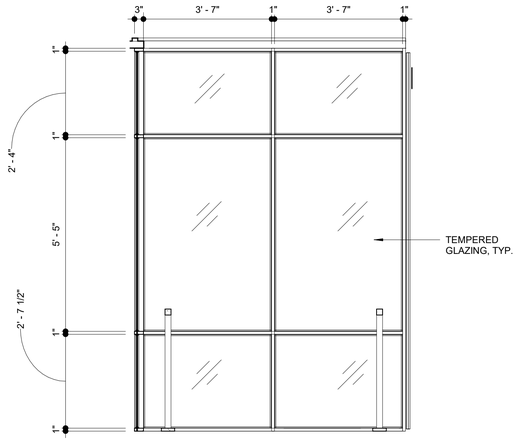

2 VESTIBULE ELEVATION - NORTH
1/2" = 1'-0"

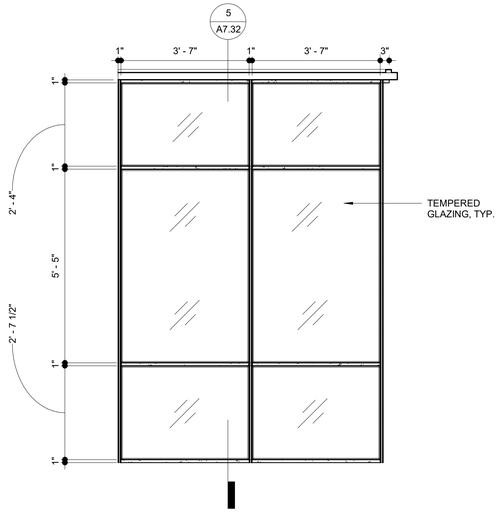

3 VESTIBULE ELEVATION - SOUTH
1/2" = 1'-0"

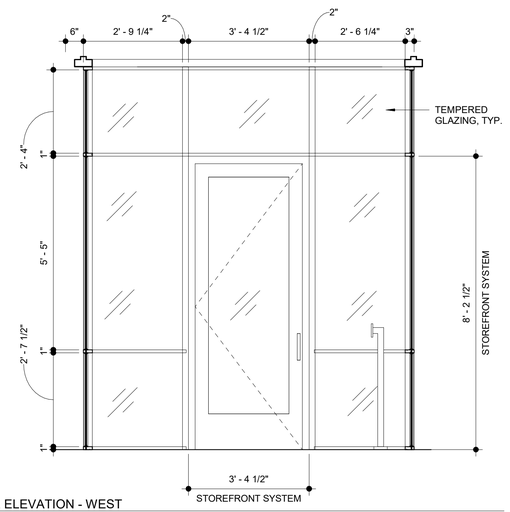

4 VESTIBULE ELEVATION - WEST
1/2" = 1'-0"

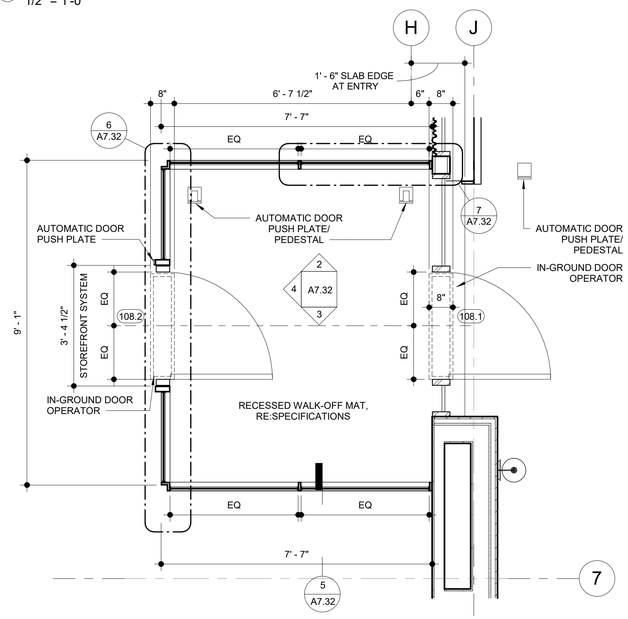

1 ENLARGED PLAN - LOBBY VESTIBULE
1/2" = 1'-0"

HELTSHE

M1A MERIDIAN 105 ARCHITECTURE

CITY HOTEL
415 PERRY STREET, CASTLE ROCK, CO.

DATE: 4.22.2026	ISSUED FOR: PERMIT	SHEET TITLE: LOBBY - VESTIBULE ELEVATIONS AND DETAILS	SHEET NUMBER A7.32
PROJ. NO. 2023.002			

C:\Users\daniel\Documents\City Hotel-2024_1_dlpscomb74Cj8.rvt

4/22/2026 1:09:29 PM

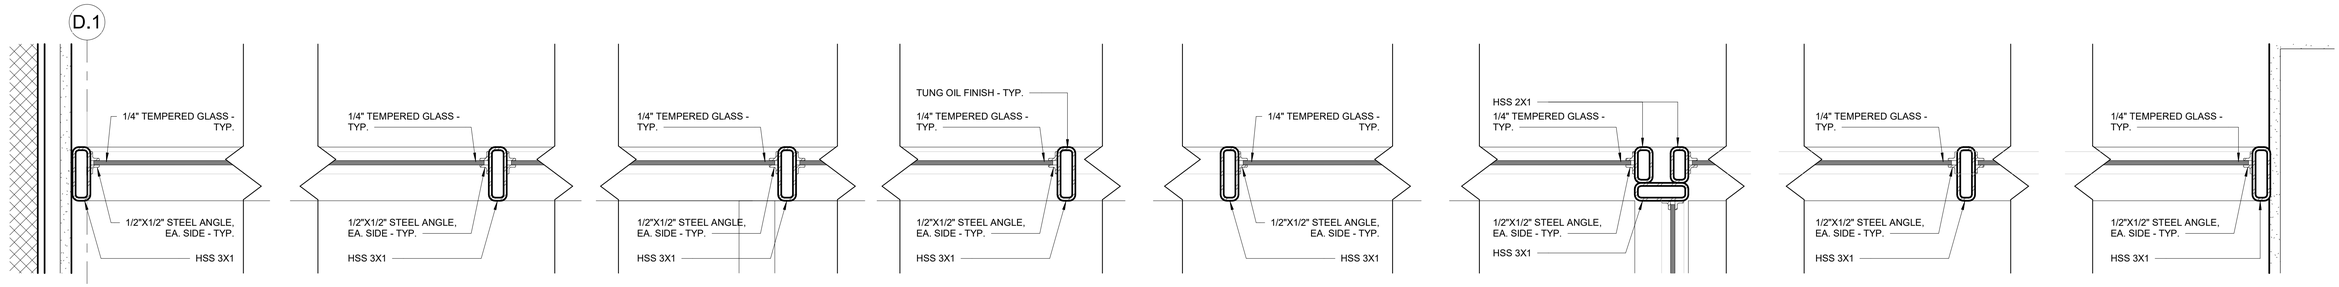

3 Detail 2
3" = 1'-0"

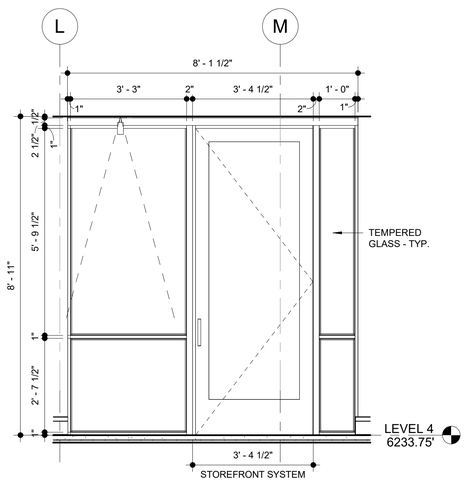

6 LVL 4 RESTAURANT ENTRY
1/2" = 1'-0"

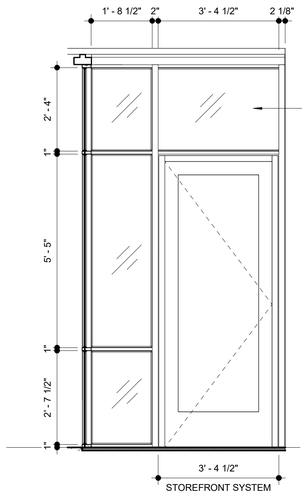

5 LOBBY / RETAIL INTERIOR ENTRY
1/2" = 1'-0"

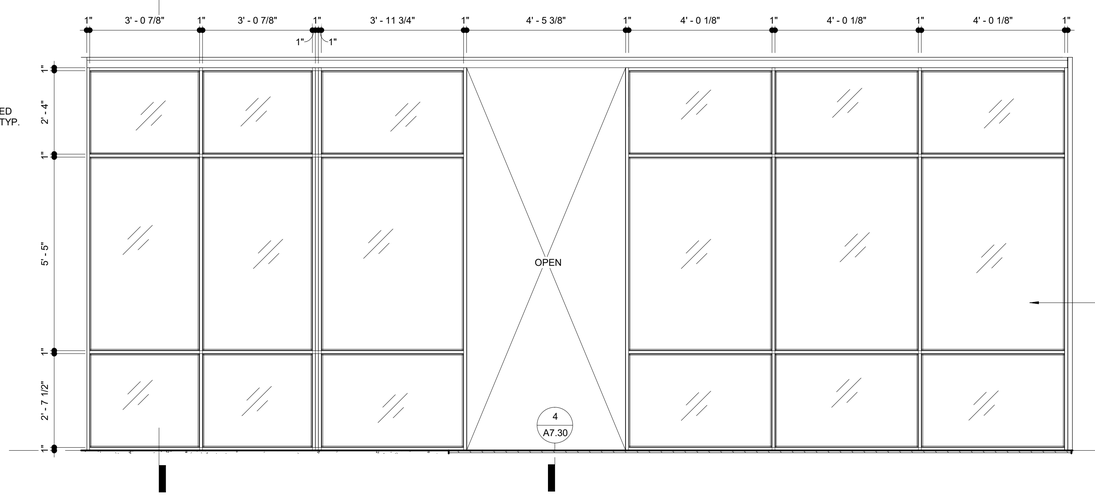

4 SOUTH LOBBY GLASS WALL
1/2" = 1'-0"

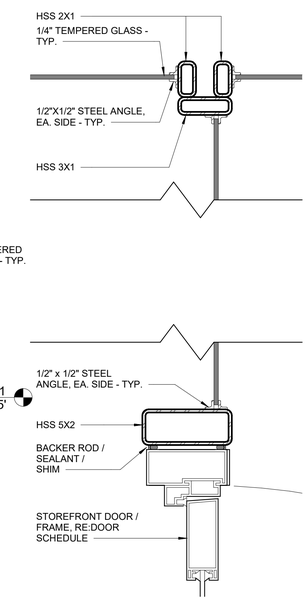

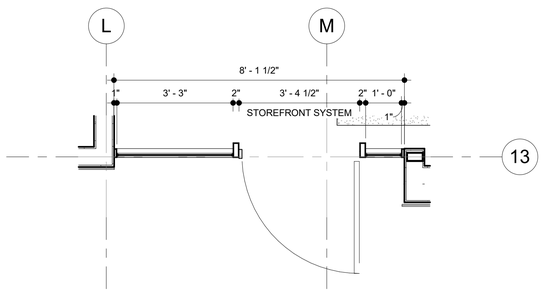

7 ENLARGED PLAN - LVL 4 RESTAURANT ENTRY
1/2" = 1'-0"

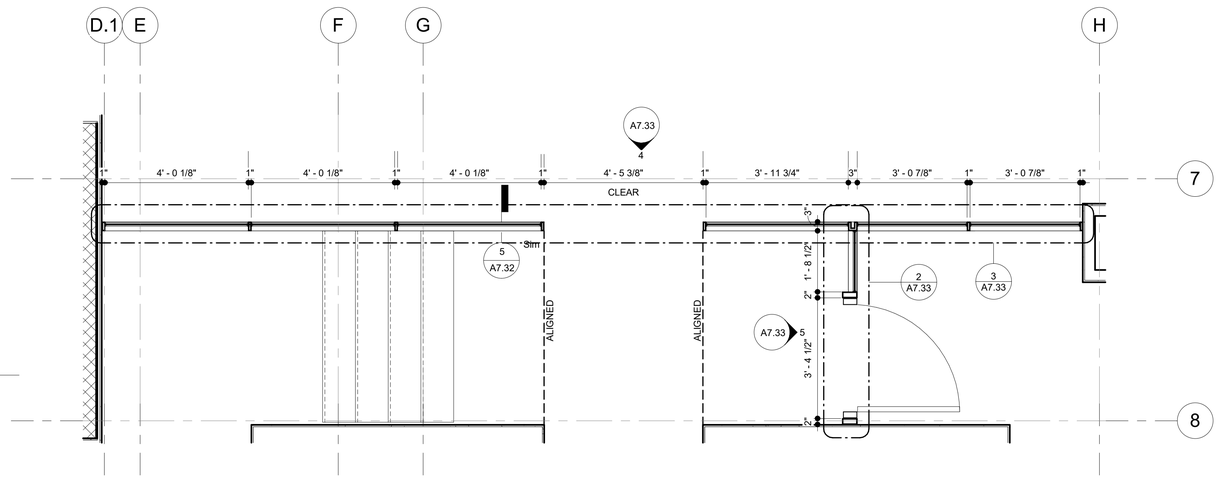

1 ENLARGED PLAN - LOBBY VESTIBULE1
1/2" = 1'-0"

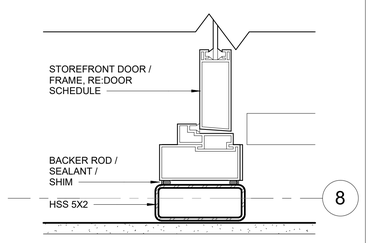

2 PLAN SECTION - LOBBY / RETAIL ENTRY
3" = 1'-0"

C:\Users\daniel\Documents\City Hotel-2024_1_dljrscomb74CJ8.rvt
4/22/2026 1:09:33 PM

HELTSHE

M1A | MERIDIAN 105 ARCHITECTURE

CITY HOTEL
415 PERRY STREET, CASTLE ROCK, CO.

DATE: 4.22.2026	ISSUED FOR: PERMIT	SHEET TITLE: LOBBY - PARTITION ELEVATIONS AND DETAILS	SHEET NUMBER A7.33
PROJ. NO. 2023.002			

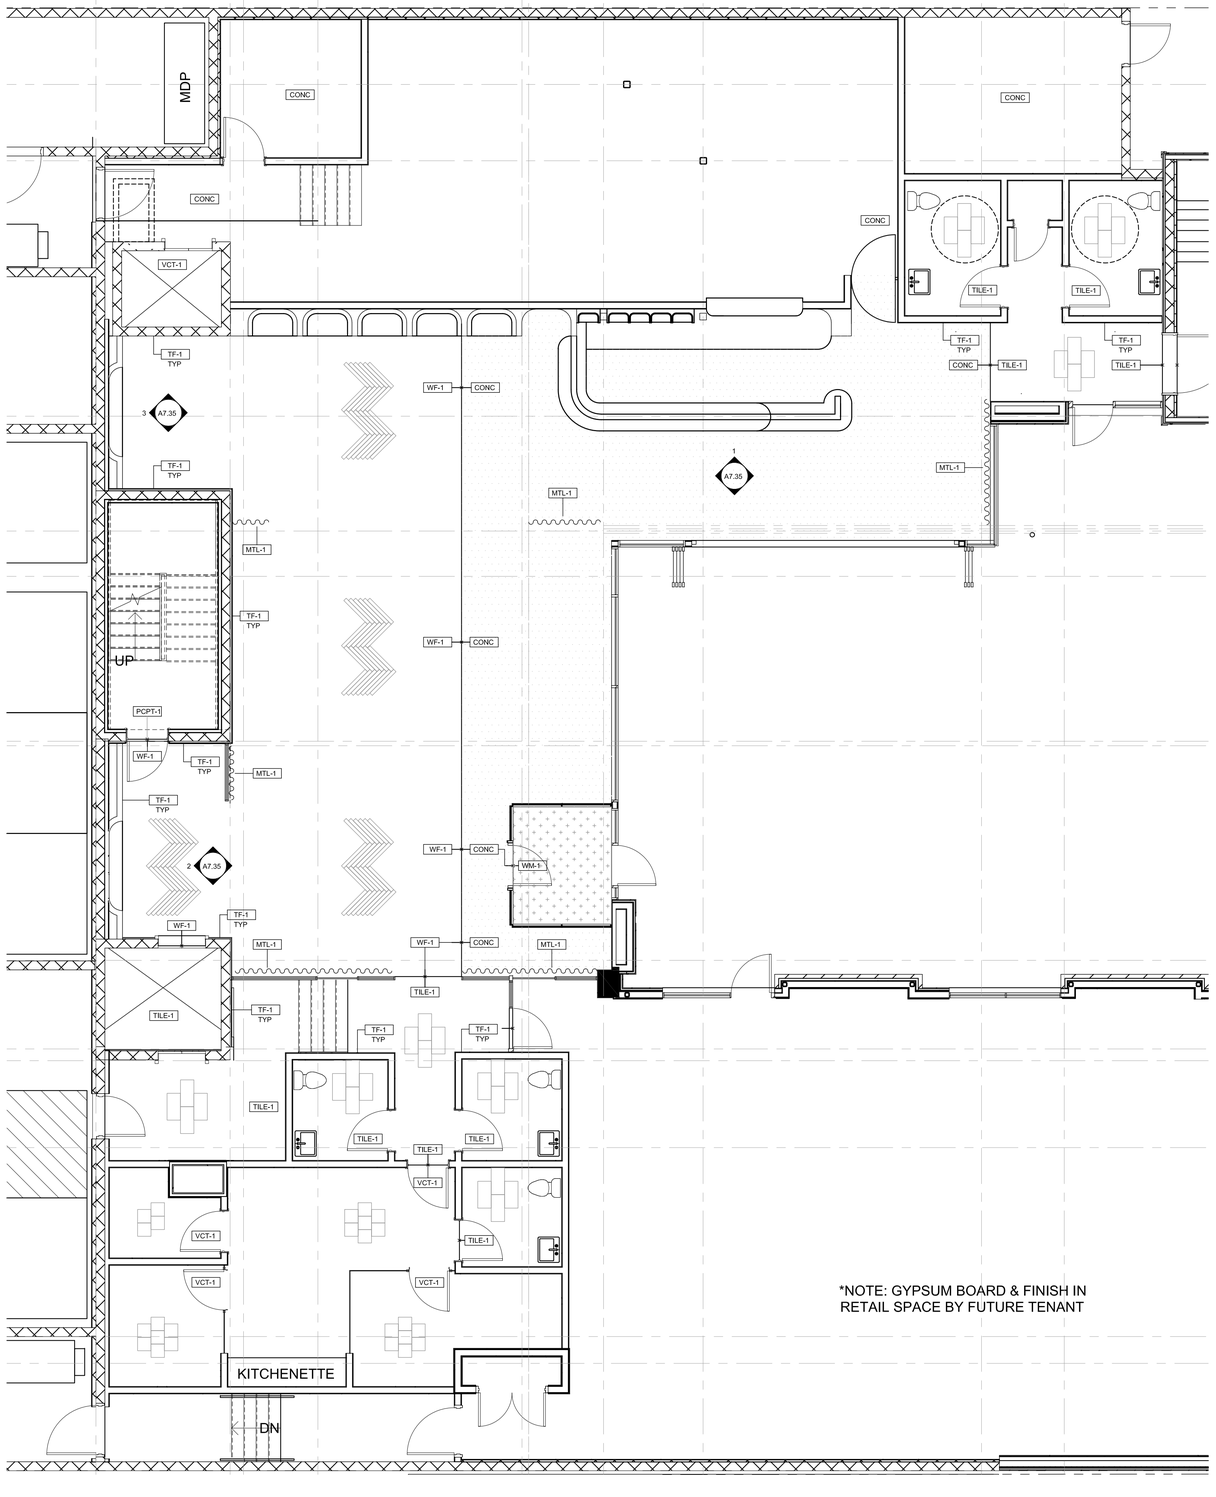

KEY NOTES

1. MTL-1 - FLOOR TO CEILING METAL BALL AND CHAIN CURTAIN MOUNTED IN CUSTOM RADIS TOP TRACK TO BE MOUNTED TO BLOCKING IN CEILING ABOVE. TRACK TO BE CONCEALED WITH FLEX TRIM MOULDING $\frac{1}{4}$" ROUND OR SIM. PAINT TO MATCH CEILING FINISH
2. PROVIDE BRASS FLOORING TRANSITION STRIPS BETWEEN DIFFERENT FLOORING MATERIALS. DESIGN INTENT - SCHLUTER JOLLY OR SIM. SEE ARCH TRANSITION DETAILS FOR MORE INFORMATION AND STR DWGS FOR RECESSED SLAB LOCATIONS TO ENSURE MATERIALS HAVE A SMOOTH TRANSITION AND NO CHANGE IN ELEVATION.

1 ENLARGED LOBBY FINISH PLAN
3/16" = 1'-0"

C:\Users\daniel\Documents\City Hotel+2024_dlipscomb74CJ8.rvt
11/13/2024 3:04:58 PM

HELTSHE

M1A MERIDIAN 105 ARCHITECTURE

CITY HOTEL
415 PERRY STREET, CASTLE ROCK, CO.

DATE: 4.22.2026	ISSUED FOR: PERMIT	SHEET TITLE: ENLARGED LOBBY FINISH PLAN	SHEET NUMBER A7.34
PROJ. NO. 2023.002			

STATE OF COLORADO · CHAD MITCHELL · 40754 · LICENSED ARCHITECT

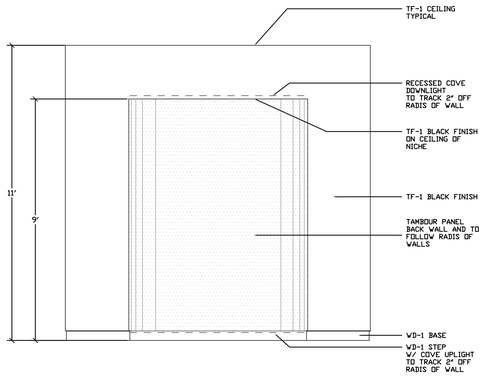

3 LOBBY BAR FEATURE NICHE ELEVATION
3/8" = 1'-0"

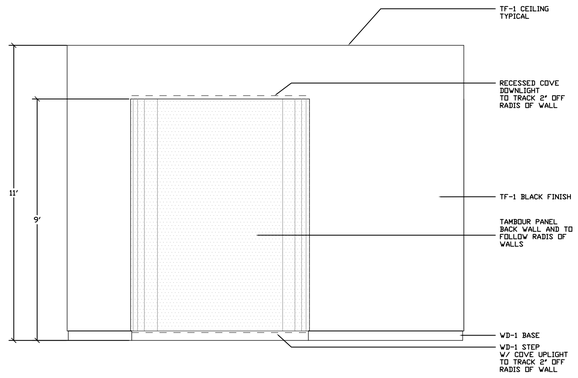

2 ELEVATOR LOBBY FEATURE NICHE ELEVATION
3/8" = 1'-0"

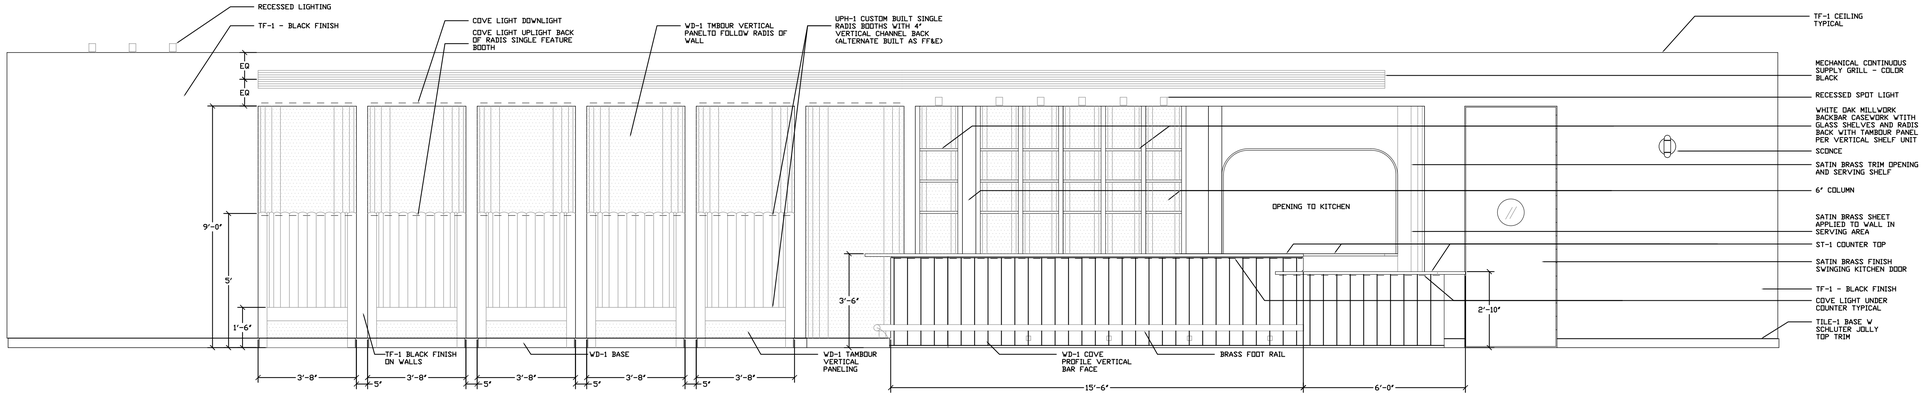

1 LOBBY BAR / BUILT IN BOOTH NICHE ELEVATION
3/8" = 1'-0"

HELTSHE

M1A | MERIDIAN 105 ARCHITECTURE

CITY HOTEL
415 PERRY STREET, CASTLE ROCK, CO.

DATE: 4.22.2026	ISSUED FOR: PERMIT	SHEET TITLE: LOBBY INTERIOR ELEVATIONS - ENLARGED	SHEET NUMBER A7.35
PROJ. NO. 2023.002			

STATE OF COLORADO · CHAD MITCHELL · 40754 · LICENSED ARCHITECT

C:\Users\danielf\Documents\City Hotel-2024_dlipscomb74CJ8.rvt

11/13/2024 3:04:58 PM

TAKE-OFF LEGEND - A7.45 (partition schedule order)

- FI.2-0 - BOARD ONLY (WOOD FRAMING EXCLUDED) - 3 wall(s) - 60.66 LF
- FI.6-0 - BOARD ONLY (WOOD FRAMING EXCLUDED) - 1 wall(s) - 8.63 LF
- W.6-0 - BOARD ONLY (WOOD FRAMING EXCLUDED) - 4 wall(s) - 53.24 LF
- W.6-1 - BOARD ONLY (WOOD FRAMING EXCLUDED) - 2 wall(s) - 21.25 LF

CEILING LEGEND

CEILING TYPES:

ACT-1: 2X4 LAY-IN CEILING, PARKING

ACT-2: 2X2 LAY-IN CEILING, KITCHEN, BACK OF HOUSE

ACT-3: 2X2 LAY-IN CEILING, KITCHEN, WITH METAL FINISH

WS-1: WOOD SLAT CEILING. PRODUCT BY USG INTERIORS 'SPECIALTY CEILING SYSTEM', TRUE WOOD. WOOD VENEER COLOR SELECTED BY ARCHITECT, WITH BLACK FELT REVEAL BACKING. MILLWORK BORDERS AND FLAT PLANAR AREAS TO MATCH FINISH, MATERIAL, AND COLOR OF SLAT PRODUCT.

GYP-1: GYPSUM BOARD ON METAL SUSPENSION SYSTEM, OR WOOD FRAMING

GYP-2: GYPSUM BOARD CEILING, RATED 2-HOURS, AER-09038

NOTE: REFER TO LIGHTING PLANS FOR COMPLETE LAYOUTS AND SPECIFICATIONS OF LIGHTING FIXTURES. DIMENSIONED LOCATION TO BE PROVIDED BY ARCHITECT.

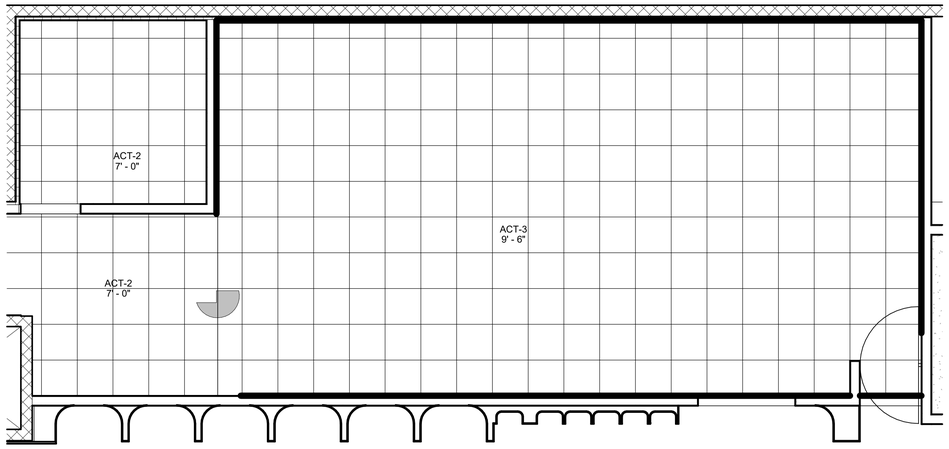

4 ENLARGED RCP - LOBBY REST ROOMS
1/4" = 1'-0"

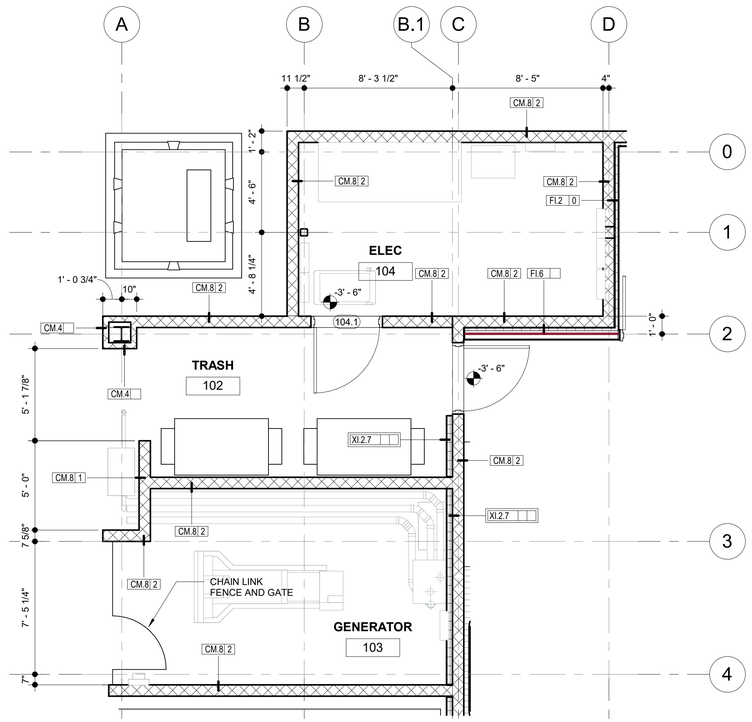

3 ENLARGED PLAN - TRASH & SERVICE ENTRANCE
1/4" = 1'-0"

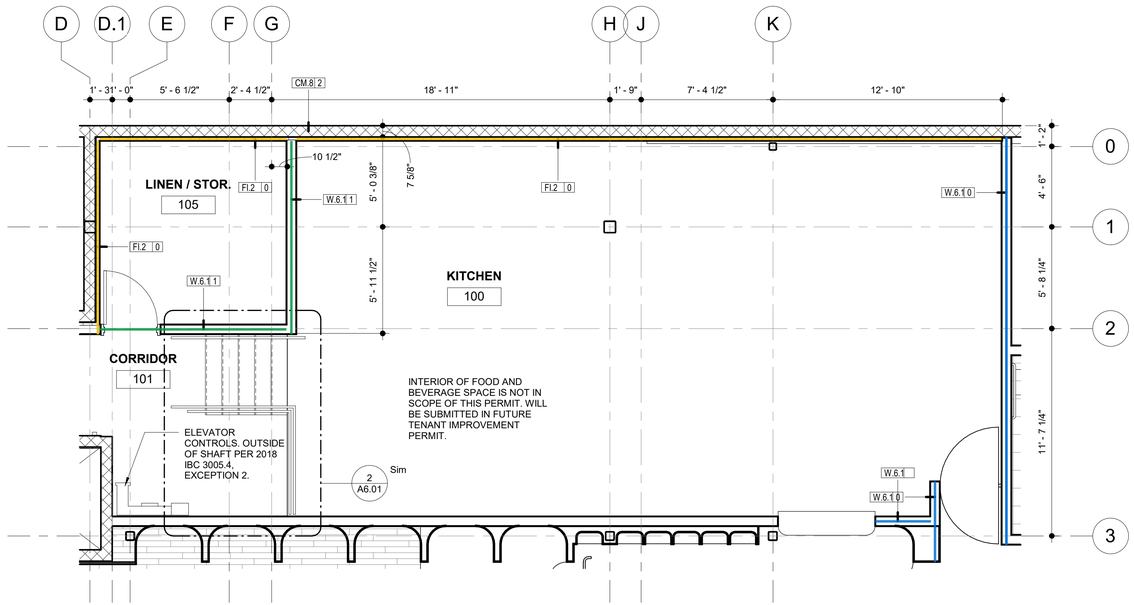

1 ENLARGED PLAN - LOBBY RESTROOMS
1/4" = 1'-0"

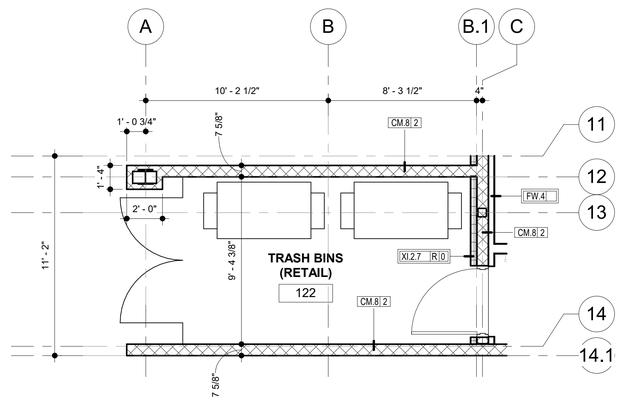

2 ENLARGED PLAN - RETAIL TRASH
1/4" = 1'-0"

HELTSHE

M1A | MERIDIAN 105 ARCHITECTURE

CITY HOTEL
415 PERRY STREET, CASTLE ROCK, CO.

DATE: 4.22.2026	ISSUED FOR: PERMIT	SHEET TITLE: KITCHEN, UTILITY, TRASH AREAS - ENLARGED PLANS AND RCPS	SHEET NUMBER A7.45
PROJ. NO. 2023.002			

C:\Users\daniel\Documents\City Hotel-2024_1_dlipscomb74C.rvt

4/22/2026 1:09:37 PM

TAKE-OFF LEGEND - A7.50 (partition schedule order)

- CH.6-2 - BOARD ONLY (WOOD FRAMING EXCLUDED) - 16 wall(s) - 51.92 LF
- DW.4-1 - BOARD ONLY (WOOD FRAMING EXCLUDED) - 2 wall(s) - 36.50 LF
- FI.6-0 - BOARD ONLY (WOOD FRAMING EXCLUDED) - 1 wall(s) - 24.62 LF
- FW.4-0 - BOARD ONLY (WOOD FRAMING EXCLUDED) - 9 wall(s) - 51.82 LF
- W.4-0 - BOARD ONLY (WOOD FRAMING EXCLUDED) - 4 wall(s) - 41.47 LF
- W.6-0 - BOARD ONLY (WOOD FRAMING EXCLUDED) - 21 wall(s) - 196.92 LF
- W.6-1 - BOARD ONLY (WOOD FRAMING EXCLUDED) - 4 wall(s) - 39.69 LF
- W.6-2 - BOARD ONLY (WOOD FRAMING EXCLUDED) - 16 wall(s) - 118.34 LF

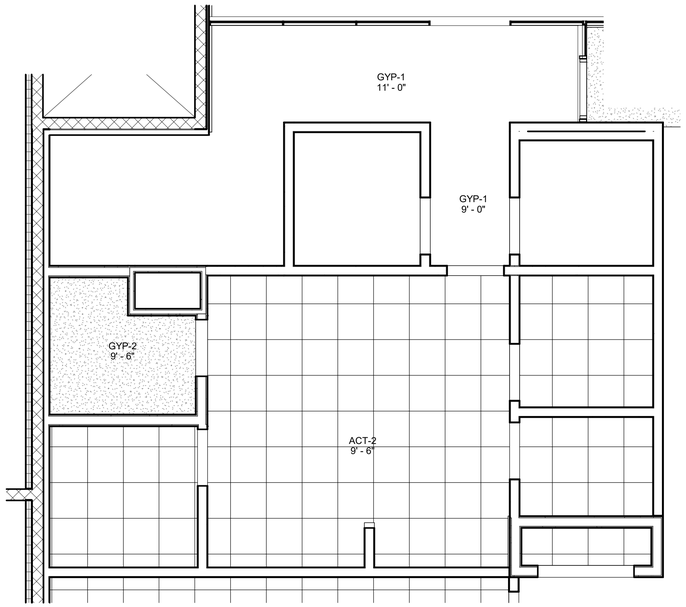

2 ENLARGED RCP -STAFF & SERVICE
1/4" = 1'-0"

CEILING LEGEND

CEILING TYPES:

ACT-1: 2X4 LAY-IN CEILING, PARKING

ACT-2: 2X2 LAY-IN CEILING, KITCHEN, BACK OF HOUSE

ACT-3: 2X2 LAY-IN CEILING, KITCHEN, WITH METAL FINISH

WS-1: WOOD SLAT CEILING. PRODUCT BY USG INTERIORS 'SPECIALTY CEILING SYSTEM', TRUE WOOD. WOOD VENEER COLOR SELECTED BY ARCHITECT, WITH BLACK FELT REVEAL BACKING. MILLWORK BORDERS AND FLAT PLANAR AREAS TO MATCH FINISH, MATERIAL, AND COLOR OF SLAT PRODUCT.

GYP-1: GYPSUM BOARD ON METAL SUSPENSION SYSTEM, OR WOOD FRAMING

GYP-2: GYPSUM BOARD CEILING, RATED 2-HOURS, AER-09038

NOTE: REFER TO LIGHTING PLANS FOR COMPLETE LAYOUTS AND SPECIFICATIONS OF LIGHTING FIXTURES. DIMENSIONED LOCATION TO BE PROVIDED BY ARCHITECT.

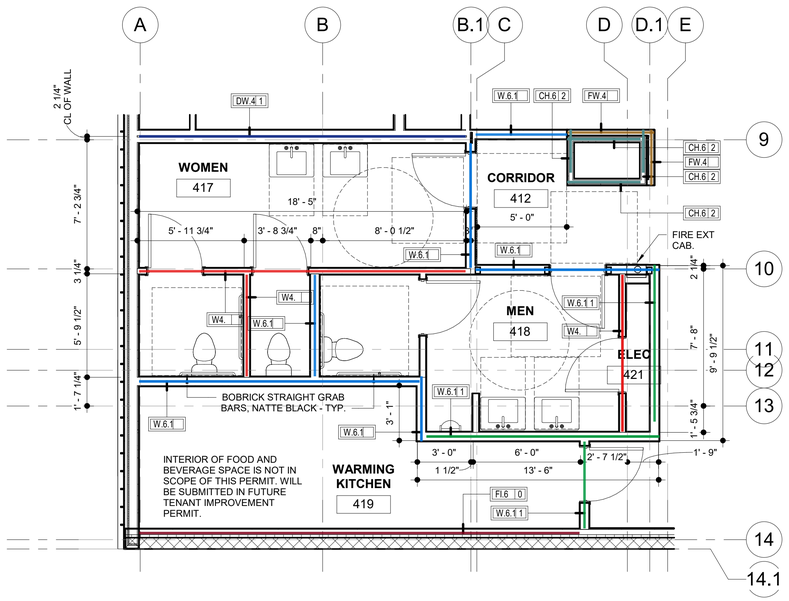

3 ENLARGED PLAN LVL 4 BATHROOMS
1/4" = 1'-0"

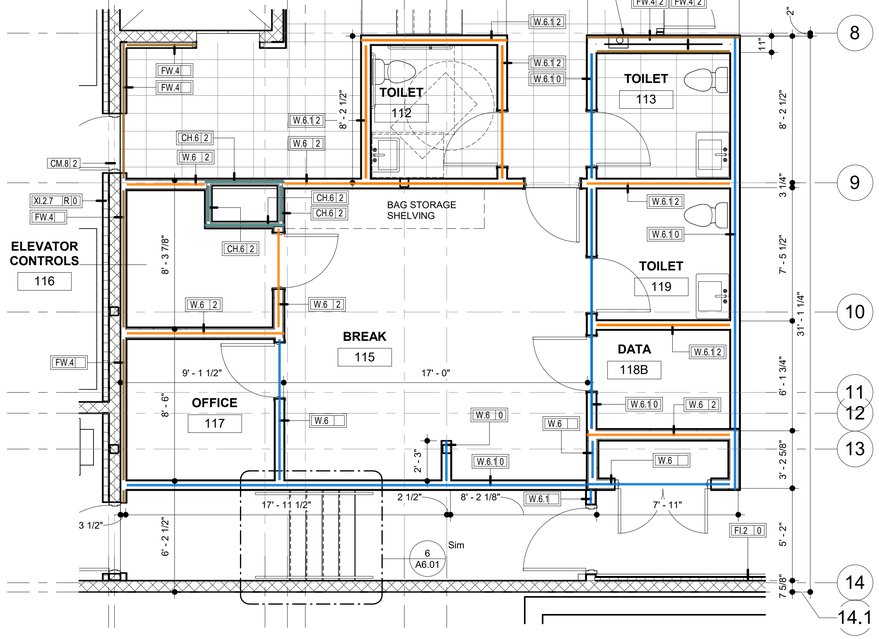

1 ENLARGED PLAN -STAFF & SERVICE
1/4" = 1'-0"

C:\Users\dsteil\Documents\City Hotel-2024_1_dlpsconb74Cj8.rvt
4/22/2026 1:09:41 PM

HELTSHE

M1A | MERIDIAN 105 ARCHITECTURE

CITY HOTEL
415 PERRY STREET, CASTLE ROCK, CO.

DATE: 4.22.2026
PROJ. NO. 2023.002

ISSUED FOR: PERMIT

SHEET TITLE: LEVEL 4 RESTROOM, LEVEL 1 STAFF AREAS, PLANS AND RCPS

SHEET NUMBER
A7.50

TAKE-OFF LEGEND - A7.55 (partition schedule order)

W.6-1 - BOARD ONLY (WOOD FRAMING EXCLUDED) - 4 wall(s) - 34.22 LF

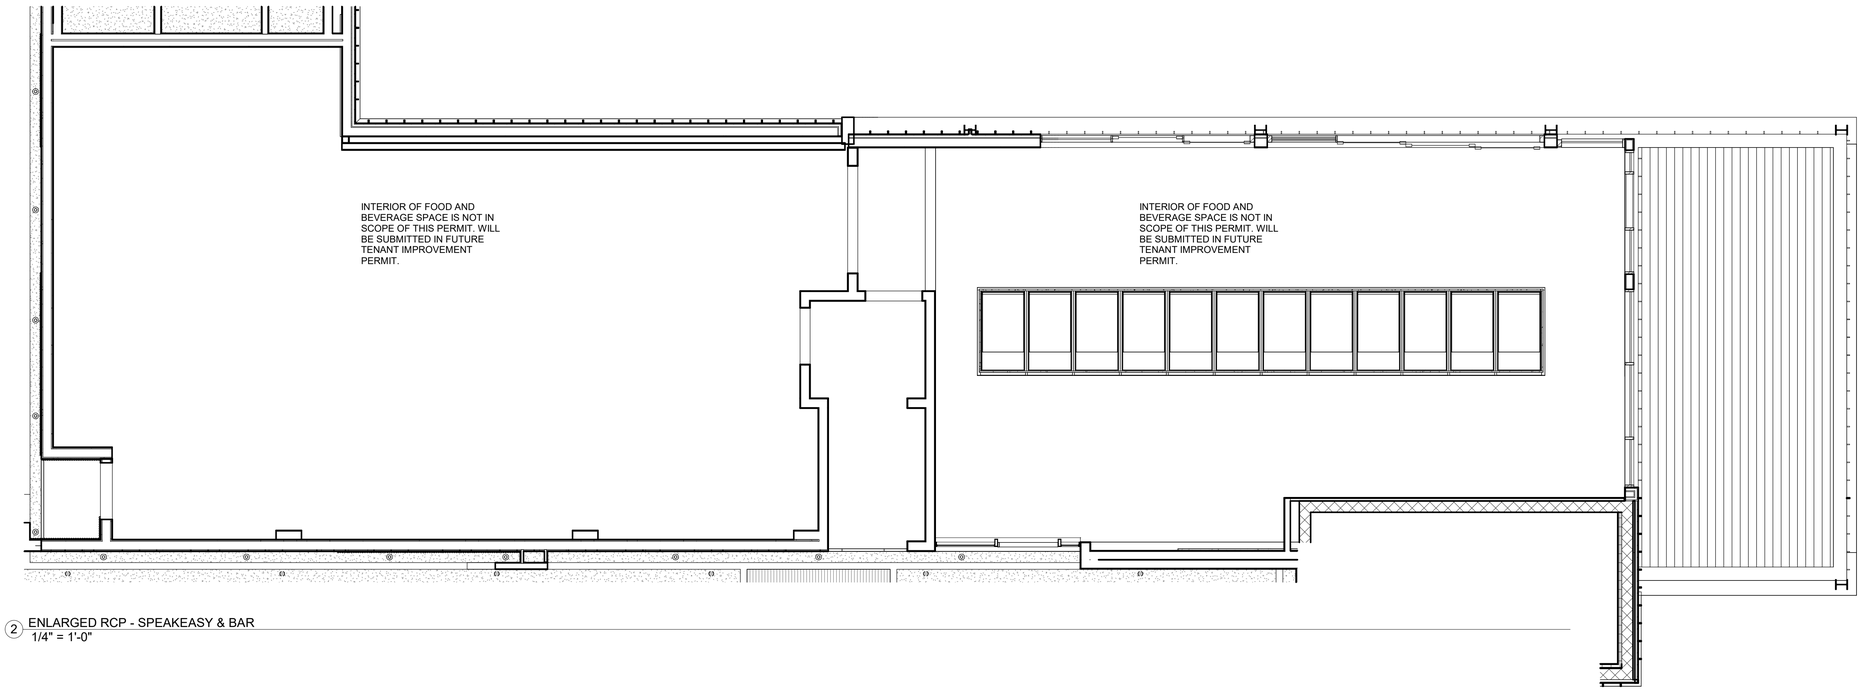

2 ENLARGED RCP - SPEAKEASY & BAR
1/4" = 1'-0"

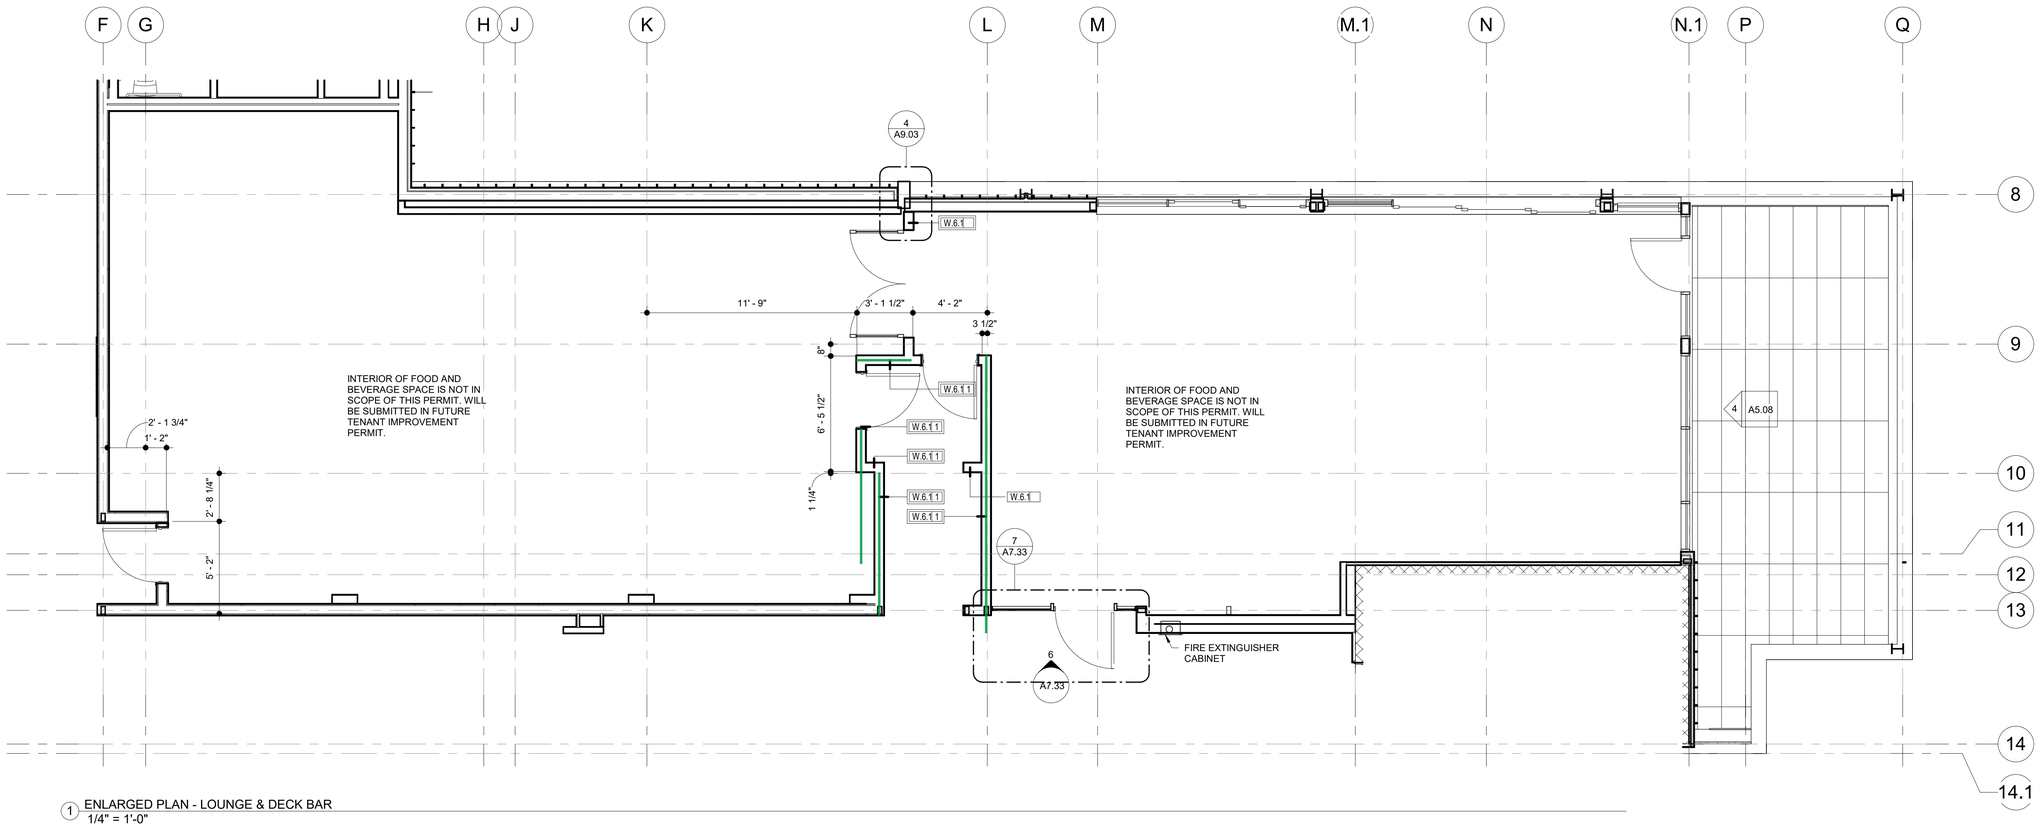

1 ENLARGED PLAN - LOUNGE & DECK BAR
1/4" = 1'-0"

HELTSHE

M1A MERIDIAN 105 ARCHITECTURE

CITY HOTEL
415 PERRY STREET, CASTLE ROCK, CO.

DATE: 4.22.2026	ISSUED FOR: PERMIT	SHEET TITLE: LEVEL 4 FOOD AND BEVERAGE SPACES - ENLARGED PLAN AND RCP	SHEET NUMBER A7.55
PROJ. NO. 2023.002			

C:\Users\daniel\Documents\City Hotel-2024_1_dlipscomb74Cj8.rvt

4/22/2026 1:09:44 PM

DOOR SCHEDULE - ALL

DOOR #	TO: ROOM	FIRE RATING	FRAME TYPE	FRAME MATERIAL	FRAME FINISH	DOOR TYPE	DOOR MATERIAL	DOOR FINISH	WIDTH	HEIGHT	COMMENTS
102.1	CORRIDOR	45 MIN.	2	HM	PTD	F	STL	PTD	3' - 8"	8' - 0"	
104.1	ELEC	90 MIN	2	HM	PTD	F	STL	PTD	3' - 8"	8' - 0"	
105.1	LINEN / STOR.	45 MIN.	2	HM	PTD	F	STL	PTD	3' - 0"	8' - 0"	
107.1	BAR					FG			3' - 0"	8' - 0"	STOREFRONT DOOR
108.1	LOBBY					FG			3' - 0"	8' - 0"	STOREFRONT DOOR
108.2	LOBBY					FG			3' - 0"	8' - 0"	STOREFRONT DOOR
109.1	JANITOR		1	WD	STD	P	SCWV	STD	2' - 6"	8' - 0"	
110.1	TOILET		1	WD	STD	P	SCWV	STD	3' - 0"	8' - 0"	
111.1	TOILET		1	WD	STD	P	SCWV	STD	3' - 0"	8' - 0"	
112.1	TOILET		1	WD	STD	P	SCWV	STD	3' - 0"	8' - 0"	
113.1	TOILET		1	WD	STD	P	SCWV	STD	3' - 0"	8' - 0"	
114.1	PARKING	90 MIN	2	HM	PTD	F	STL	PTD	3' - 0"	8' - 0"	EXIT DEVICE
115.1	BREAK		1	WD	STD	P	SCWV	STD	3' - 0"	8' - 0"	
115.2	RETAIL					FG			3' - 0"	8' - 0"	STOREFRONT DOOR
115.4			1	WD	TBD	F	TBD	TBD	3' - 0"	8' - 0"	
115.5			1	WD	TBD	F	TBD	TBD	3' - 0"	8' - 0"	
115.6									3' - 0"	8' - 0"	
115.7			1	WD	TBD	F	TBD	TBD	3' - 0"	8' - 0"	
116.1	ELEVATOR CONTROLS	90 MIN	2	WD	STD	P	SCWV	STD	3' - 0"	8' - 0"	
117.1	OFFICE		1	WD	PTD	F	SCPG	PTD	3' - 0"	8' - 0"	
118.1	DATA		1	WD	PTD	F	SCPG	PTD	3' - 0"	8' - 0"	
119.1	TOILET		1	WD	PTD	F	SCPG	PTD	3' - 0"	8' - 0"	
120.1	ELEC / TELE	90 MIN	1	HM	PTD	F	STL	PTD	5' - 0"	8' - 0"	
121.1	RETAIL		1	HM	PTD	F	STL	PTD	3' - 6"	8' - 0"	
122.1	TRASH BINS (RETAIL)	90 MIN	2	HM	PTD	F	STL	PTD	3' - 8"	8' - 0"	
124.2	RETAIL					FG			3' - 0"	9' - 1"	STOREFRONT (SEE ELEVATION)
124.3	RETAIL					FG			3' - 0"	9' - 1"	STOREFRONT (SEE ELEVATION)
125.1	FACP	90 MIN.	1	HM	PTD	F	STL	PTD	2' - 8"	6' - 8"	
126.1	STAIR 2	90 MIN	2	HM	PTD	F	STL	PTD	3' - 0"	7' - 8"	
127.1	STAIR 1	90 MIN	2	WD	STD	P	SCWV	STD	3' - 0"	8' - 0"	
128.1	WATER ENTRY	90 MIN	2	HM	PTD	F	STL	PTD	3' - 0"	7' - 8"	
129.1	DINING	180 MIN.	2	HM	PTD	F	SCWV	STD	4' - 4"	9' - 2"	MAGNETIC HOLD OPEN
201.1	GUEST ROOM TYPE 1	20 MIN	3	WD	STD	P	SCWV	STD	3' - 0"	8' - 0"	
201.2	GUEST ROOM TYPE 1		4	WD	STD	P	SCWV	STD	3' - 0"	8' - 0"	
202.1	GUEST ROOM TYPE 1	20 MIN	3	WD	STD	P	SCWV	STD	3' - 0"	8' - 0"	
202.2	GUEST ROOM TYPE 1		4	WD	STD	P	SCWV	STD	3' - 0"	8' - 0"	
203.1	GUEST ROOM TYPE 1	20 MIN	3	WD	STD	P	SCWV	STD	3' - 0"	8' - 0"	
203.2	GUEST ROOM TYPE 1		4	WD	STD	P	SCWV	STD	3' - 0"	8' - 0"	
204.1	GUEST ROOM TYPE 1	20 MIN	3	WD	STD	P	SCWV	STD	3' - 0"	8' - 0"	
204.2	GUEST ROOM TYPE 1		4	WD	STD	P	SCWV	STD	3' - 0"	8' - 0"	
205.1	GUEST ROOM TYPE 5	20 MIN	3	WD	STD	P	SCWV	STD	3' - 0"	8' - 0"	
205.2	GUEST ROOM TYPE 5		4	WD	STD	P	SCWV	STD	3' - 0"	8' - 0"	
206.1	GUEST ROOM TYPE 2	20 MIN	3	WD	STD	P	SCWV	STD	3' - 0"	8' - 0"	
206.2	GUEST ROOM TYPE 2		4	WD	STD	P	SCWV	STD	3' - 0"	8' - 0"	
207.1	GUEST ROOM TYPE 2	20 MIN	3	WD	STD	P	SCWV	STD	3' - 0"	8' - 0"	
207.2	GUEST ROOM TYPE 2		4	WD	STD	P	SCWV	STD	3' - 0"	8' - 0"	
208.1	GUEST ROOM TYPE 3	20 MIN	3	WD	STD	P	SCWV	STD	3' - 0"	8' - 0"	
208.2	GUEST ROOM TYPE 3		4	WD	STD	P	SCWV	STD	3' - 0"	8' - 0"	
209.1	GUEST ROOM TYPE 4	20 MIN	3	WD	STD	P	SCWV	STD	3' - 0"	8' - 0"	
209.2	GUEST ROOM TYPE 4		4	WD	STD	P	SCWV	STD	3' - 0"	8' - 0"	
210.1	GUEST ROOM TYPE 9	20 MIN	3	WD	STD	P	SCWV	STD	3' - 0"	8' - 0"	
210.2	GUEST ROOM TYPE 9		4	WD	STD	P	SCWV	STD	3' - 0"	8' - 0"	
211.1	GUEST ROOM TYPE 8	20 MIN	3	WD	STD	P	SCWV	STD	3' - 0"	8' - 0"	
211.2	GUEST ROOM TYPE 8		4	WD	STD	P	SCWV	STD	3' - 0"	8' - 0"	
212.1	GUEST ROOM TYPE 7	20 MIN	3	WD	STD	P	SCWV	STD	3' - 0"	8' - 0"	
212.2	GUEST ROOM TYPE 7		4	WD	STD	P	SCWV	STD	3' - 0"	8' - 0"	
213.1	GUEST ROOM TYPE 6	20 MIN	3	WD	STD	P	SCWV	STD	3' - 0"	8' - 0"	
213.2	GUEST ROOM TYPE 6		4	WD	STD	P	SCWV	STD	3' - 0"	8' - 0"	
214.1	GUEST ROOM TYPE 13	20 MIN	3	WD	STD	P	SCWV	STD	3' - 0"	8' - 0"	
214.2	GUEST ROOM TYPE 13		4	WD	STD	P	SCWV	STD	3' - 0"	8' - 0"	
215.1	CLEANING	20 MIN	3	WD	STD	P	SCWV	STD	3' - 0"	8' - 0"	
216.1	STAIR 1	90 MIN	2	WD	STD	P	SCWV	STD	3' - 0"	8' - 0"	
216.2	STAIR 2	90 MIN	2	WD	STD	P	SCWV	STD	3' - 0"	8' - 0"	
219.1	MECH & WATER HEATER MEZZANINE	90 MIN.	1	HM	PTD	F	STL	PTD	4' - 0"	5' - 6"	ACCESS PANEL - HEIGHT CONTINGENT UPON DEFERRED TRUSS SUBMITTAL
221.1	CORRIDOR	20 MIN	2	WD	STD	P	SCWV	STD	5' - 0"	8' - 0"	
222.1	LINEN	20 MIN	2	WD	STD	P	SCWV	STD	5' - 0"	8' - 0"	
223.1	CLEANING	20 MIN	1	WD	STD	P	SCWV	STD	2' - 6"	8' - 0"	
301.1	GUEST ROOM TYPE 1	20 MIN	3	WD	STD	P	SCWV	STD	3' - 0"	8' - 0"	
301.2	GUEST ROOM TYPE 1		4	WD	STD	P	SCWV	STD	3' - 0"	8' - 0"	

DOOR SCHEDULE - ALL

DOOR #	TO: ROOM	FIRE RATING	FRAME TYPE	FRAME MATERIAL	FRAME FINISH	DOOR TYPE	DOOR MATERIAL	DOOR FINISH	WIDTH	HEIGHT	COMMENTS
302.1	GUEST ROOM TYPE 1	20 MIN	3	WD	STD	P	SCWV	STD	3' - 0"	8' - 0"	
302.2	GUEST ROOM TYPE 1		4	WD	STD	P	SCWV	STD	3' - 0"	8' - 0"	
303.1	GUEST ROOM TYPE 1	20 MIN	3	WD	STD	P	SCWV	STD	3' - 0"	8' - 0"	
303.2	GUEST ROOM TYPE 1		4	WD	STD	P	SCWV	STD	3' - 0"	8' - 0"	
304.1	GUEST ROOM TYPE 1	20 MIN	3	WD	STD	P	SCWV	STD	3' - 0"	8' - 0"	
304.2	GUEST ROOM TYPE 1		4	WD	STD	P	SCWV	STD	3' - 0"	8' - 0"	
305.1	GUEST ROOM TYPE 5	20 MIN	3	WD	STD	P	SCWV	STD	3' - 0"	8' - 0"	
305.2	GUEST ROOM TYPE 5		4	WD	STD	P	SCWV	STD	3' - 0"	8' - 0"	
306.1	GUEST ROOM TYPE 2	20 MIN	3	WD	STD	P	SCWV	STD	3' - 0"	8' - 0"	
306.2	GUEST ROOM TYPE 2		4	WD	STD	P	SCWV	STD	3' - 0"	8' - 0"	
307.1	GUEST ROOM TYPE 2	20 MIN	3	WD	STD	P	SCWV	STD	3' - 0"	8' - 0"	
307.2	GUEST ROOM TYPE 2		4	WD	STD	P	SCWV	STD	3' - 0"	8' - 0"	
308.1	GUEST ROOM TYPE 3	20 MIN	3	WD	STD	P	SCWV	STD	3' - 0"	8' - 0"	
308.2	GUEST ROOM TYPE 3		4	WD	STD	P	SCWV	STD	3' - 0"	8' - 0"	
309.1	GUEST ROOM TYPE 4	20 MIN	3	WD	STD	P	SCWV	STD	3' - 0"	8' - 0"	
309.2	GUEST ROOM TYPE 4		4	WD	STD	P	SCWV	STD	3' - 0"	8' - 0"	
310.1	GUEST ROOM TYPE 9	20 MIN	3	WD	STD	P	SCWV	STD	3' - 0"	8' - 0"	
310.2	GUEST ROOM TYPE 9		4	WD	STD	P	SCWV	STD	3' - 0"	8' - 0"	
311.1	GUEST ROOM TYPE 8	20 MIN	3	WD	STD	P	SCWV	STD	3' - 0"	8' - 0"	
311.2	GUEST ROOM TYPE 8		4	WD	STD	P	SCWV	STD	3' - 0"	8' - 0"	
312.1	GUEST ROOM TYPE 7	20 MIN	3	WD	STD	P	SCWV	STD	3' - 0"	8' - 0"	
312.2	GUEST ROOM TYPE 7		4	WD	STD	P	SCWV	STD	3' - 0"	8' - 0"	
313.1	GUEST ROOM TYPE 6	20 MIN	3	WD	STD	P	SCWV	STD	3' - 0"	8' - 0"	
313.2	GUEST ROOM TYPE 6		4	WD	STD	P	SCWV	STD	3' - 0"	8' - 0"	
314.1	GUEST ROOM TYPE 13	20 MIN	3	WD	STD	P	SCWV	STD	3' - 0"	8' - 0"	
314.2	GUEST ROOM TYPE 13		4	WD	STD	P	SCWV	STD	3' - 0"	8' - 0"	
315.1	CLEANING	20 MIN	3	WD	STD	P	SCWV	STD	3' - 0"	8' - 0"	
316.1	STAIR 1	90 MIN	2	WD	STD	P	SCWV	STD	3' - 0"	8' - 0"	
316.2	STAIR 2	90 MIN	2	WD	STD	P	SCWV	STD	3' - 0"	8' - 0"	
321.1	CORRIDOR	20 MIN	2	WD	STD	P	SCWV	STD	5' - 0"	8' - 0"	
322.1	LINEN	20 MIN	2	WD	STD	P	SCWV	STD	5' - 0"	8' - 0"	
323.1	CLEANING	20 MIN	1	WD	STD	P	SCWV	STD	2' - 6"	8' - 0"	
401.1	GUEST ROOM TYPE 11	20 MIN	3	WD	STD	P	SCWV	STD	3' - 0"	8' - 0"	
401.2	GUEST ROOM TYPE 11		4	WD	STD	P	SCWV	STD	3' - 0"	8' - 0"	
401.3	GUEST ROOM TYPE 11		4	WD	STD	P	SCWV	STD	3' - 0"	8' - 0"	
402.1	GUEST ROOM TYPE 12	20 MIN	3	WD	STD	P	SCWV	STD	3' - 0"	8' - 0"	
402.2	GUEST ROOM TYPE 12		4	WD	STD	P	SCWV	STD	3' - 0"	8' - 0"	
403.1	GUEST ROOM TYPE 10	20 MIN	3	WD	STD	P	SCWV	STD	3' - 0"	8' - 0"	
403.2	GUEST ROOM TYPE 10		4	WD	STD	P	SCWV	STD	3' - 0"	8' - 0"	
403.3			1	WD	STD	P	SCWV	STD	3' - 0"	8' - 0"	
404.1	GUEST ROOM TYPE 6	20 MIN	3	WD	STD	P	SCWV	STD	3' - 0"	8' - 0"	
404.2	GUEST ROOM TYPE 6		4	WD	STD	P	SCWV	STD	3' - 0"	8' - 0"	
405.1	GUEST ROOM TYPE 13	20 MIN	3	WD	STD	P	SCWV	STD	3' - 0"	8' - 0"	
405.2	GUEST ROOM TYPE 13		4	WD	STD	P	SCWV	STD	3' - 0"	8' - 0"	
406.1	CLEANING	20 MIN	3	WD	STD	P	SCWV	STD	3' - 0"	8' - 0"	
410.1	FOOD AND BEVERAGE	20 MIN	3	WD	STD	P	SCWV	STD	3' - 0"	8' - 0"	
410.2	FOOD AND BEVERAGE								6' - 0"	8' - 0"	STOREFRONT (SEE ELEVATION)
410.3	CORRIDOR	20 MIN	3	WD	STD	P	SCWV	STD	3' - 0"	8' - 0"	
411.1	CONVERTIBLE DECK BAR	20 MIN				FG			3' - 3 3/8"	8' - 7"	STOREFRONT (SEE ELEVATION)
411.2	CORRIDOR	20 MIN	1	WD	STD	P	SCWV	STD	3' - 0"	8' - 0"	
411.3	CONVERTIBLE DECK BAR					FG			3' - 0"	8' - 0"	STOREFRONT (SEE ELEVATION)
413.1	STAIR 2	90 MIN	2	WD	STD	P	SCWV	STD	3' - 0"	8' - 0"	
414.1	STAIR 1	90 MIN	2	WD	STD	P	SCWV	STD	3' - 0"	8' - 0"	
417.1	WOMEN	20 MIN	3	WD	STD	P	SCWV	STD	3' - 0"	8' - 0"	
417.3	WOMEN		1	WD	STD	P	SCWV	STD	3' - 0"	8' - 0"	
417.4	WOMEN		1	WD	STD	P	SCWV	STD	3' - 0"	8' - 0"	
418.1	MEN	20 MIN	3	WD	STD	P	SCWV	STD	3' - 0"	8' - 0"	
418.2	MEN		1	WD	STD	P	SCWV	STD	3' - 0"	8' - 0"	
419.1	WARMING KITCHEN	20 MIN	3	WD	STD	P	SCWV	STD	3' - 0"	8' - 0"	
421.1	ELEC	20 MIN	3	WD	STD	P	SCWV	STD	3' - 0"	8' - 0"	

*NOTE: DOUBLE SWING KITCHEN DOOR DOES NOT APPEAR IN THE DOOR SCHEDULE. FIELD VERIFY R.O. DIMESIONS

*EXIT DEVICES SHALL BE PROVIDED ON EGRESS DOOR AS REQUIRED BY 2018 IBC CODE SECTION 10.10.1.10

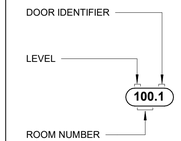

ABBREVIATIONS

F	FLUSH
FG	FULL GLASS
PTD	PAINTED
HM	HOLLOW METAL
STL	STEEL
ALUM	ALUMINUM
LVR	LOUVERED
ANO	ANODIZED
SC	SOLID CORE
STFT	STOREFRONT
WDLAM	LAMINATED WOOD
OVHD	OVERHEAD
INSUL	INSULATED
WDLAM	WOOD LAMINTED
MFS	MANFUACTURER'S SPECIFICATIONS
FGF	FULL GLASS - FRAMELESS
SCPG	SOLID CORE PAINT GRADE
MHDF	MOLDED HIGH DENSITY FIBERBOARD
IG	INTEGRAL TEMPERED GLASS LITE
PG	PLATE GLASS (TEMPERED)
STD	STAINED WITH CLEAR SEALANT
SCWV	SOLID CORE WOOD VENEER

-ALL BATHROOM DOORS TO BE UNDERCUT 1/2"

DOOR RATING REQUIREMENTS PER TABLE 716.1(2)
FIRE WALLS AND FIRE BARRIES HAVING 2HR RATING: 90 MIN

OTHER FIRE BARRIERS W/ 1 HR RATING: 45 MIN

ACOUSTICAL NOTE: ALL UNIT ENTRY/CORRIDOR DOORS TO HAVE ACOUSTICAL FILL IN DOOR JAMB AND HEAD FRAMES SO THAT THERE ARE NO AIR GAPS IN THE CAVITY. THIS SHALL NOT BE RIGID FOAM.

ACOUSTICAL NOTE: AT ALL UNIT ENTRY/CORRIDOR DOORS, ALL SEAMS BETWEEN WALLS AND DOOR JAMBS AND HEADS SHALL BE CAULKED WITH A NON-HARDENING CAULKING.

ARCHITECT TO SELECT FROM MANFACTURER'S STANDARD FINISHES WHERE "ANODIZED" FINISH IS NOTED

ARCHITECT TO SELECT PAINT COLOR WHERE PAINTED FINISH IS NOTED

FRAME TYPES

SEE SCHEDULE FOR FIRE RATINGS

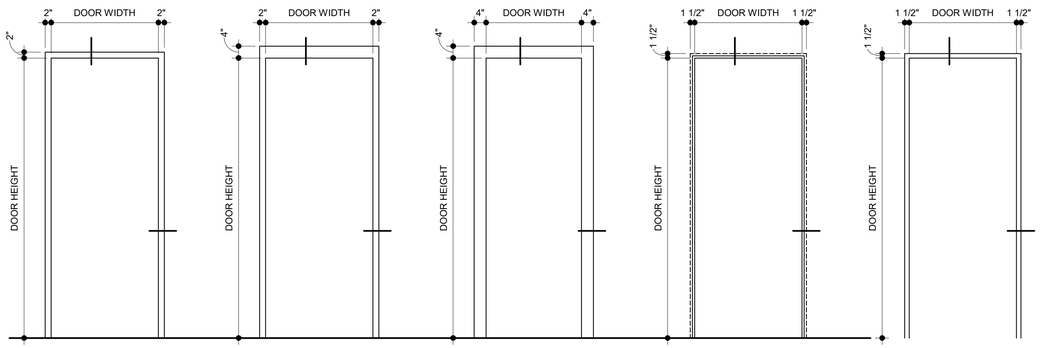

FRAME TYPE 1:

HM: HOLLOW METAL, BUTTED FRAME, FULLY WELDED, INSULATED WHERE NOTED IN SCHEDULE.

WD: WOOD FRAME AND TRIM

FRAME TYPE 2:

HM: HOLLOW METAL, BUTTED FRAME, FULLY WELDED, INSULATED WHERE NOTED IN SCHEDULE.

FRAME TYPE 2A:

HM: HOLLOW METAL, BUTTED FRAME, FULLY WELDED, INSULATED WHERE NOTED IN SCHEDULE.

FRAME TYPE 3:

TRIMLESS FRAME (ONE-SIDE WHERE TAMBOUR PANEL LAPS FRAME) WOOD TRIM ON INTERIOR SIDE, SEE DETAILS.

WD: SOLID WOOD FRAME AND TRIM, UNLESS SPECIFIED OTHERWISE.

FRAME TYPE 4:

WD: SOLID WOOD FRAME AND TRIM, UNLESS SPECIFIED OTHERWISE.

DOOR TYPES

SEE SCHEDULE FOR FIRE RATINGS

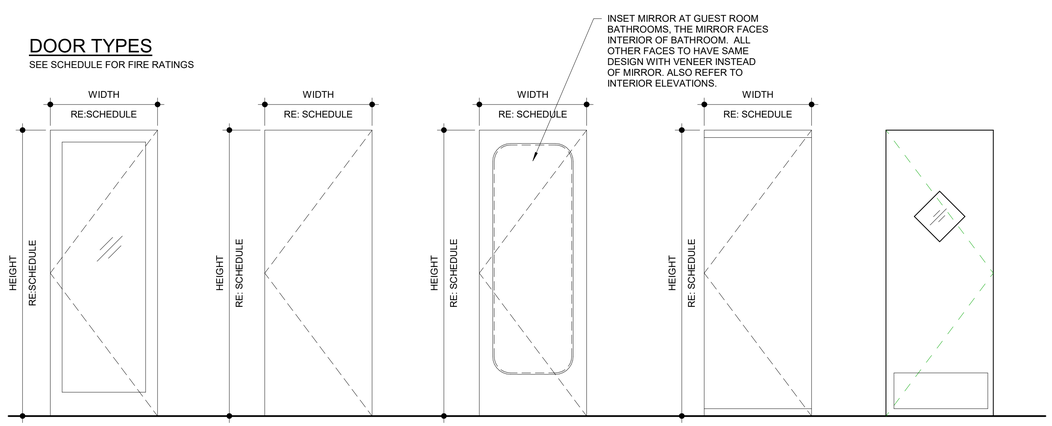

DOOR TYPE FG:
FULL GLASS

STILES & RAILS SIZES PER SPECIFICATION. GLAZING PER SPECIFICATION. MATERIAL PER SCHEDULE OR SPECIFICATION.

DOOR TYPE F:
FLUSH

MATERIAL PER SCHEDULE OR SPECIFICATION.

DOOR TYPE P:
PANEL

STILES & RAILS SIZES PER SPECIFICATION. MATERIAL PER SCHEDULE OR SPECIFICATION.

DOOR TYPE PG:
PLATE GLASS

RAIL SIZES AND MATERIALS PER SPECIFICATOIN

DOOR TYPE
DOUBLE SWING KITCHEN DOOR:DIAMOND URBAN EDGE METAL COMMERCIAL TRAFFIC DOOR, SATIN GOLD

HELTSHE

M1A | MERIDIAN 105 ARCHITECTURE

CITY HOTEL

415 PERRY STREET, CASTLE ROCK, CO.

DATE: 4.22.2026
PROJ. NO. 2023.002

ISSUED FOR: PERMIT

SHEET TITLE: DOOR SCHEDULES

SHEET NUMBER A8.00

C:\Users\daniel\Documents\City Hotel-2024_1_dljpscomb74CJ8.rvt

4/22/2026 1:09:48 PM

GRAPHIC WINDOW SCHEDULE

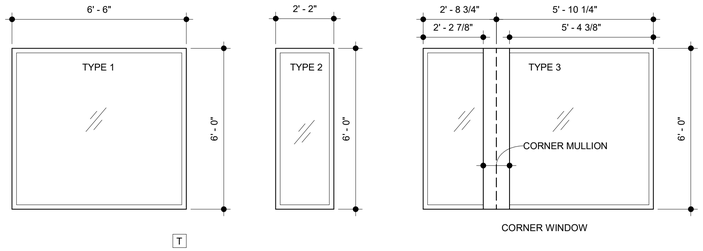

- BASIS OF DESIGN - WESTERN ALUMINUM 7600 PERFORMANCE SERIES
- DIMENSIONS SHOWN ARE ROUGH OPENNING DIMENSIONS
- WINDOW OPERATION TO BE AS SHOWN IN GRAPIC WINDOW SCHEDULE

WINDOW NOTES:

1. THE INSTALLATION REQUIREMENTS OF THE HEAD, JAMB, AND SILL FLASHINGS ARE RELATIVE TO THE WINDOW NAILING FLANGE, AND/OR RELATIVE TO THE WINDOW JAMB, WHEN A NAILING FLANGE IS NOT PRESENT, MAY VARY FROM WINDOW MANUFACTURER TO WINDOW MANUFACTURER. THE GENERAL CONTRACTOR SHALL THOROUGHLY REVIEW THE SPECIFIC LAYERING REQUIREMENTS OF THE WINDOW PRODUCT THAT IS SELECTED AND APPROVED FOR THIS SPECIFIC PROJECT AND SUBMIT SHOW DRAWINGS DEPICTING THOUSE REQUIREMETNS TO BOTH THE ARHCITECT AND OWNER'S WATERPROOFING CONSULTANT (IF APPLICABLE) PRIOR TO THE INSTALLATION OF TTHE WINDOWS.
2. GC SHALL INITIATE A PRECONSTRUCTION MEETING WITH MANUFACTURER, THE OWNER'S BUILDING ENVELOPE CONSULTANT, ARCHITECT AND GC PRIOR TO INSTALLATION.
3. ALL OPERABLE WINDOW RECEIVE INSECT SCREENS.

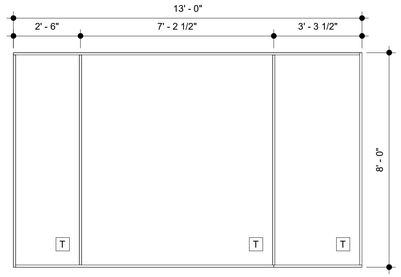

TYPE S-A

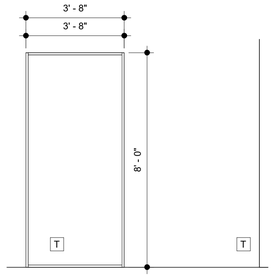

TYPE S-G

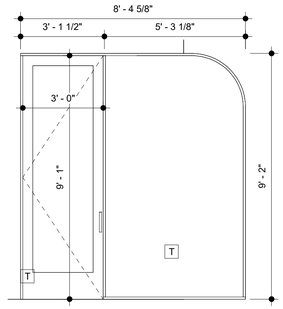

TYPE S-G1

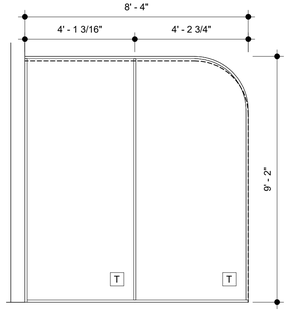

TYPE S-G2

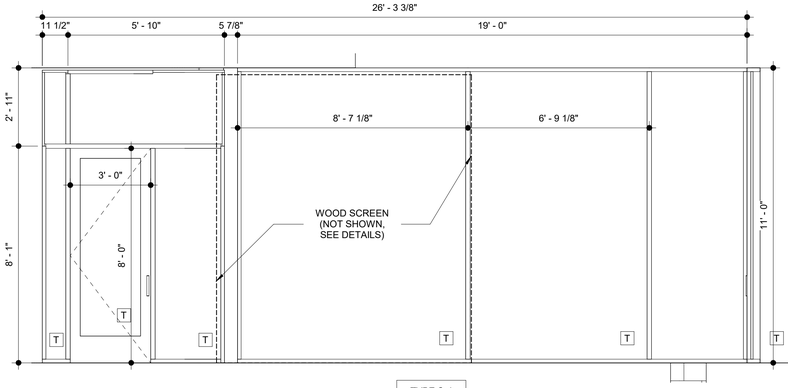

TYPE S-J

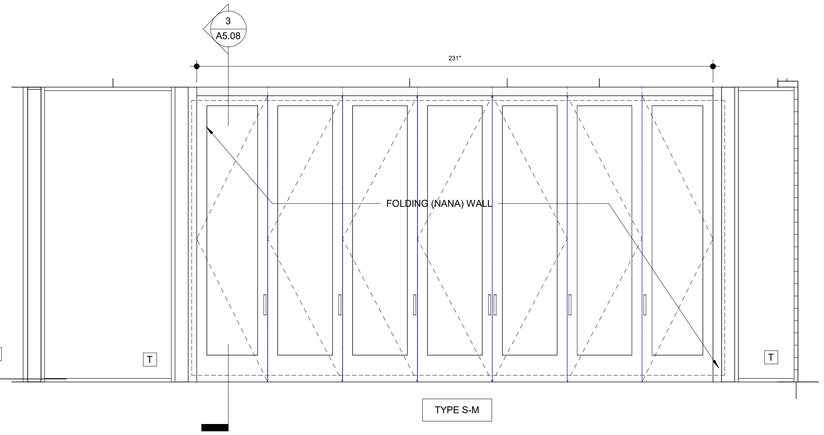

TYPE S-M

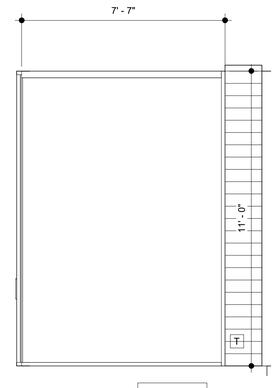

TYPE S-O

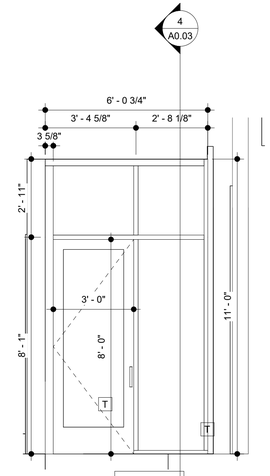

TYPE S-N

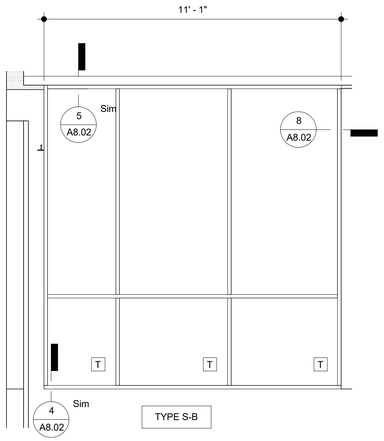

TYPE S-B

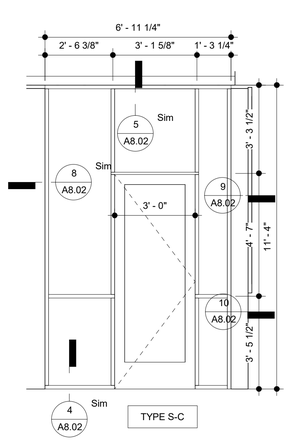

TYPE S-C

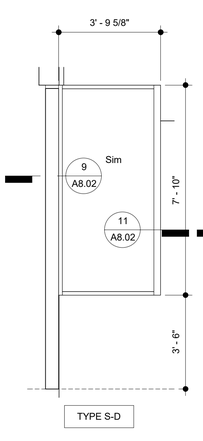

TYPE S-D

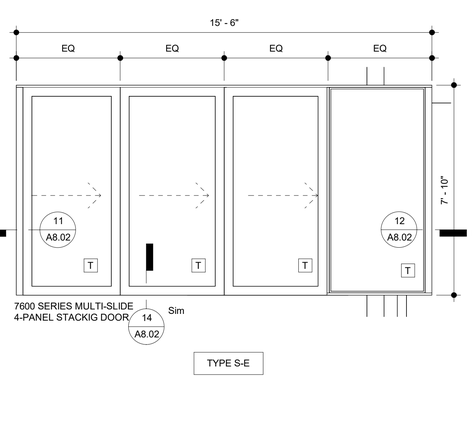

TYPE S-E

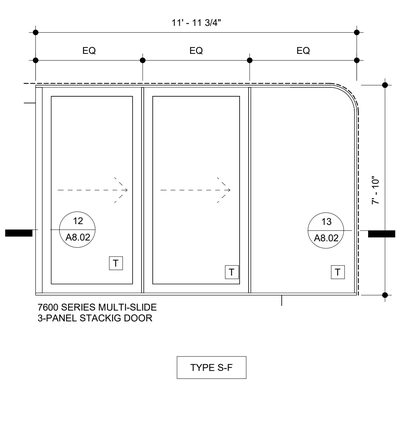

TYPE S-F

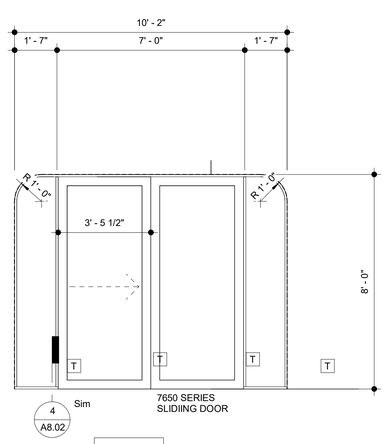

TYPE S-K

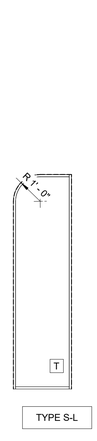

TYPE S-L

C:\Users\daniel\Documents\City Hotel-2024_1_dljpscomb74Cdl8.rvt
4/22/2026 1:09:52 PM

HELTSHE

M1A | MERIDIAN 105 ARCHITECTURE

CITY HOTEL
415 PERRY STREET, CASTLE ROCK, CO.

DATE: 4.22.2026
PROJ. NO. 2023.002

ISSUED FOR: PERMIT

SHEET TITLE: WINDOW SCHEDULE

SHEET NUMBER
A8.01

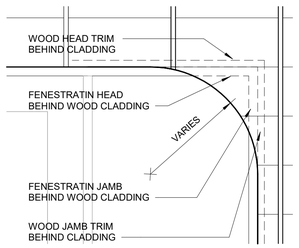

16 TYPICAL CLADDING RADIUS AT FENESTRATION
1 1/2" = 1'-0"

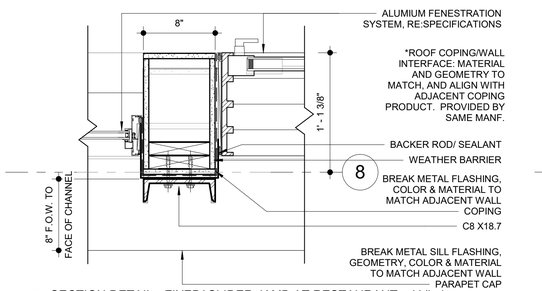

11 SECTION DETAIL - FIXED/ SLIDER JAMB AT RESTAURANT - LVL 4
1 1/2" = 1'-0"

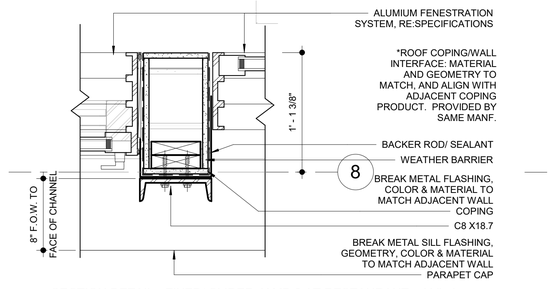

12 SECTION DETAIL - FIXED/ SLIDER JAMB 2 AT RESTAURANT - LVL 4
1 1/2" = 1'-0"

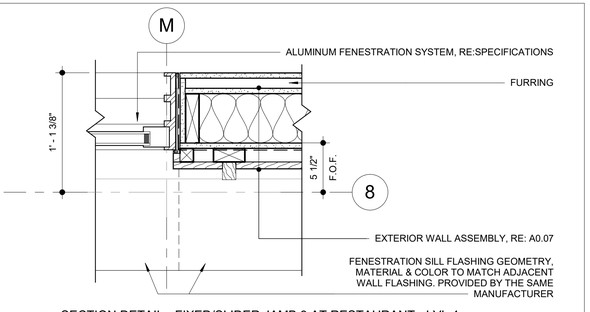

13 SECTION DETAIL - FIXED/SLIDER JAMB 3 AT RESTAURANT - LVL 4
1 1/2" = 1'-0"

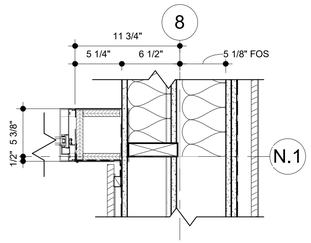

10 SECTION DETAIL - WINDOW JAMB 2 AT RESTAURANT ROOF DECK - LVL 4
1 1/2" = 1'-0"

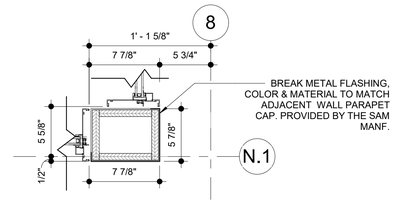

9 SECTION DETAIL - WINDOW JAMB 3 AT RESTAURANT ROOF DECK - LVL 4
1 1/2" = 1'-0"

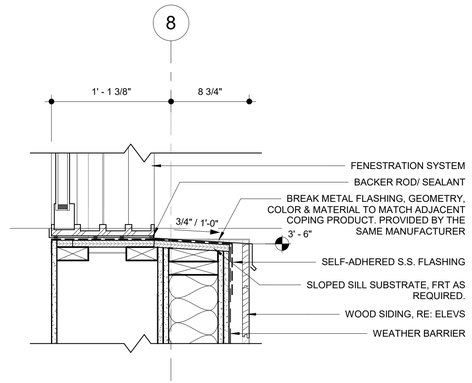

14 SECTION DETAIL - SLIDING SILL AT RESTAURANT - LVL 4
1 1/2" = 1'-0"

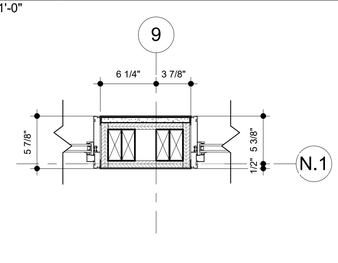

8 SECTION DETAIL - WINDOW JAMB 1 AT RESTAURANT ROOF DECK - LVL 4
1 1/2" = 1'-0"

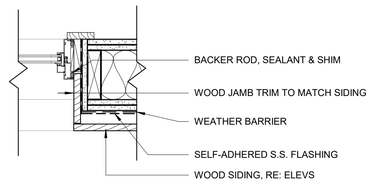

3 PLAN DETAIL - TYPICAL WINDOW JAMB, WOOD CLADDING
1 1/2" = 1'-0"

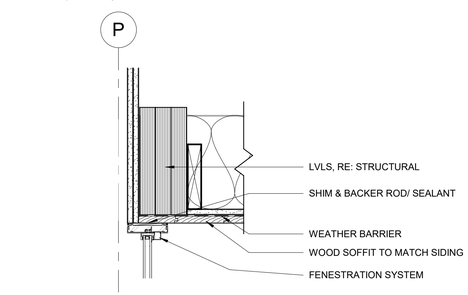

7 SECTION DETAIL - WINDOW HEAD AT PLASTER SOFFIT
1 1/2" = 1'-0"

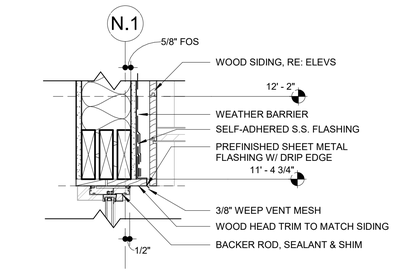

5 SECTION DETAIL - WINDOW HEAD AT RESTAURANT ROOF DECK - LVL 4
1 1/2" = 1'-0"

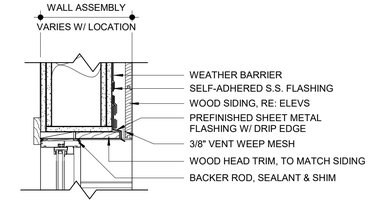

2 TYPICAL WINDOW HEAD DETAIL - WOOD SIDING
1 1/2" = 1'-0"

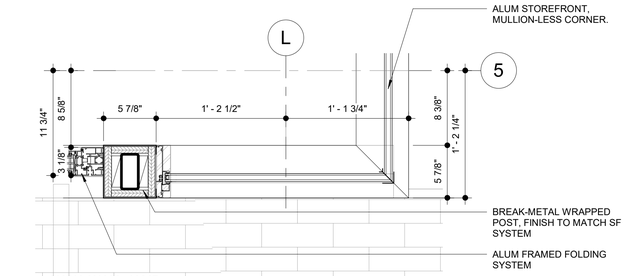

15 NANA WALL JAMB
1 1/2" = 1'-0"

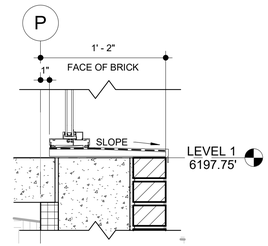

6 SECTION DETAIL - WINDOW SILL AT BRICK
1 1/2" = 1'-0"

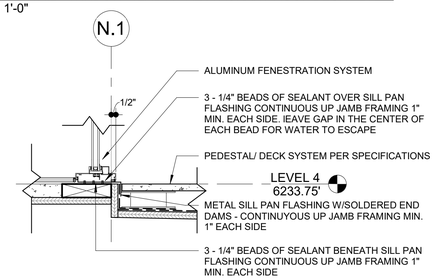

4 SECTION DETAIL - WINDOW SILL AT RESTAURANT ROOF DECK - LVL 4
1 1/2" = 1'-0"

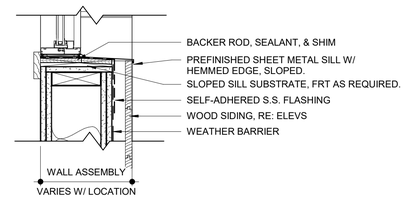

1 SECTION DETAIL - TYPICAL WIDOW SILL - WOOD SIDING
1 1/2" = 1'-0"

HELTSHE

M1A | MERIDIAN 105 ARCHITECTURE

CITY HOTEL
415 PERRY STREET, CASTLE ROCK, CO.

DATE: 4.22.2026	ISSUED FOR: PERMIT	SHEET TITLE: FENESTRATION DETAILS	SHEET NUMBER A8.02
PROJ. NO. 2023.002			

C:\Users\daniel\Documents\City Hotel-2024_1_dlipscomb74C.J8.rvt

4/22/2026 1:09:58 PM

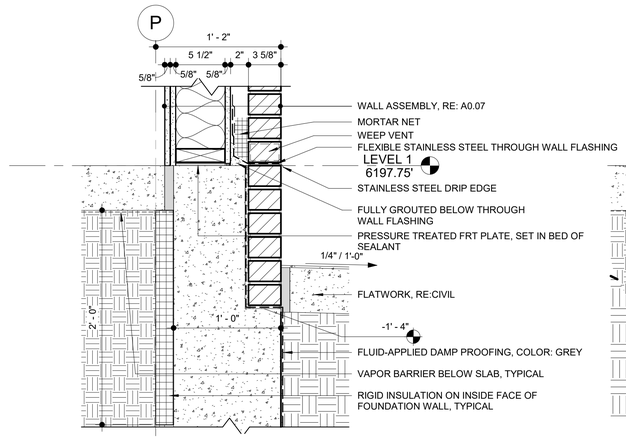

9 SECTION DETAIL - FOUNDATION AT BRICK, GRID G
1 1/2" = 1'-0"

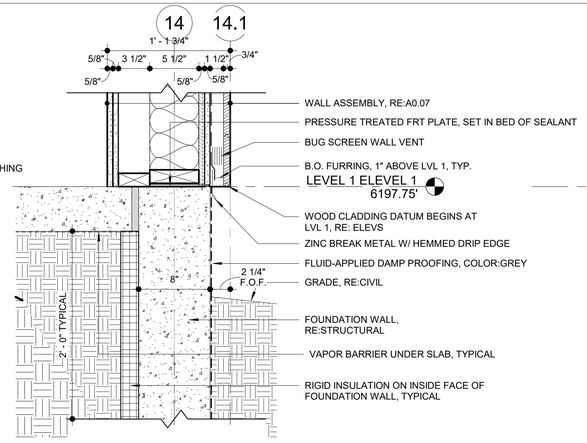

10 SECTION DETAIL - FOUNDATION AT WOOD WALL, GRID 11.1
1 1/2" = 1'-0"

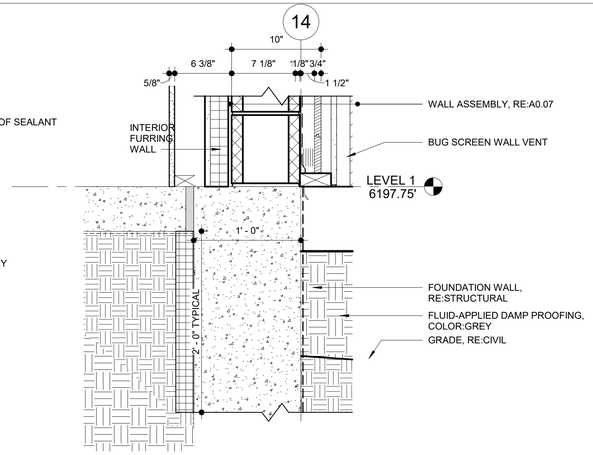

11 SECTION DETAIL - FOUNDATION AT SOUTH STAIR CORE
1 1/2" = 1'-0"

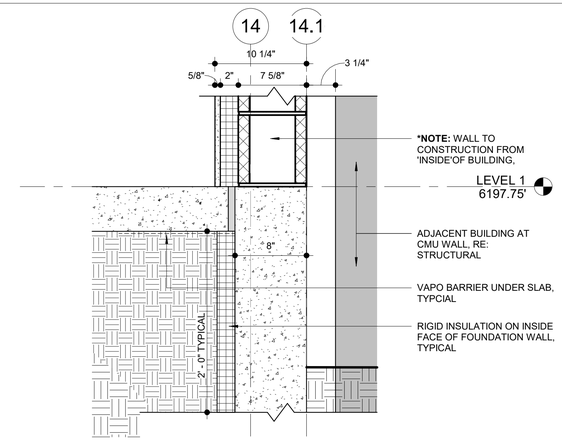

12 SECTION DETAIL - FOUNDATION ADJACENT TO SOUTH BUILDING
1 1/2" = 1'-0"

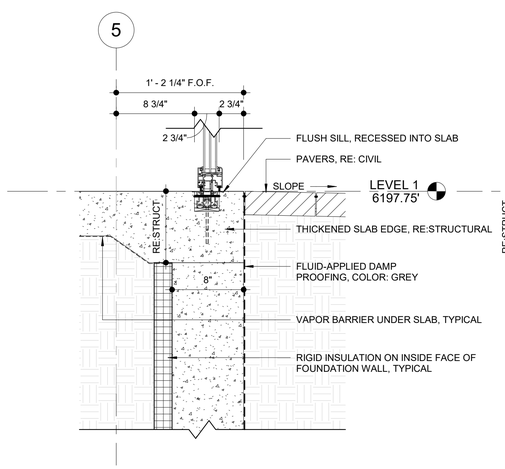

1 SECTION DETAIL - FOLDING DOOR THRESHOLD
1 1/2" = 1'-0"

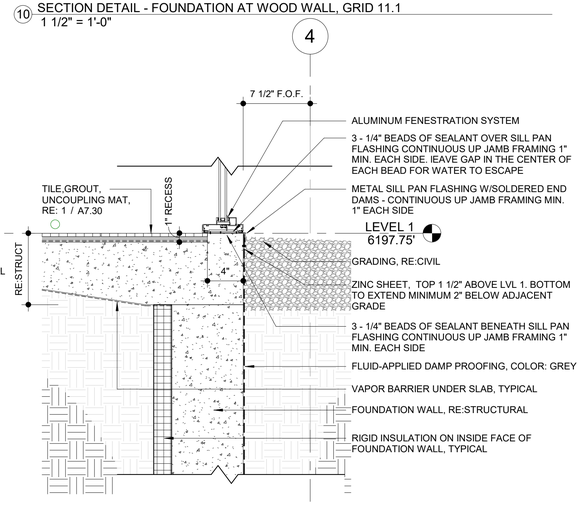

5 SECTION DETAIL - FIXED FENESTRATION AT BAR
1 1/2" = 1'-0"

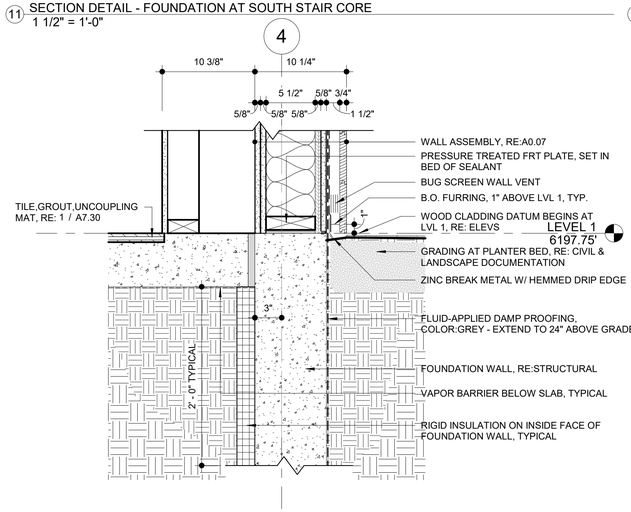

7 SECTION DETAIL -BAR
1 1/2" = 1'-0"

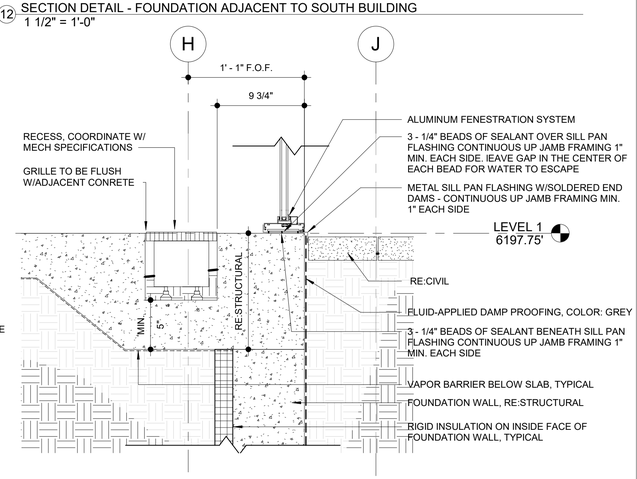

8 SECTION DETAIL - FIXED FENESTRATION AT LOBBY
1 1/2" = 1'-0"

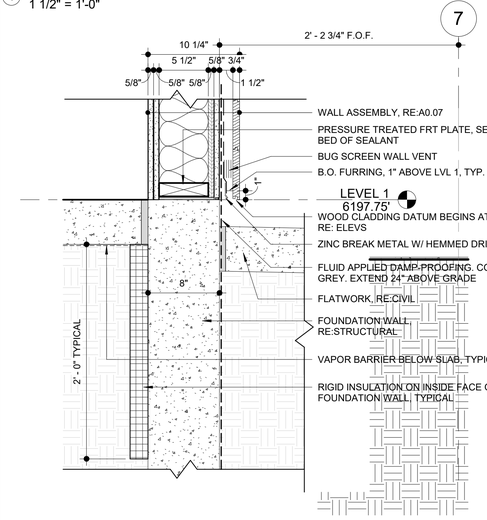

3 SECTION DETAIL - FOUNDATION AT WOOD CLADDING
1 1/2" = 1'-0"

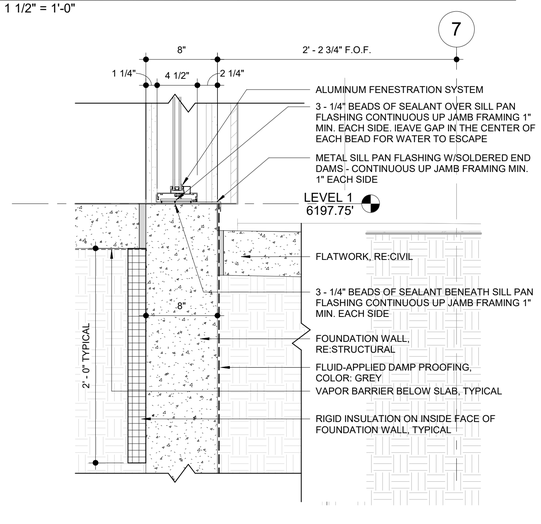

4 SECTION DETAIL - FOUNDATION AT FENESTRATION
1 1/2" = 1'-0"

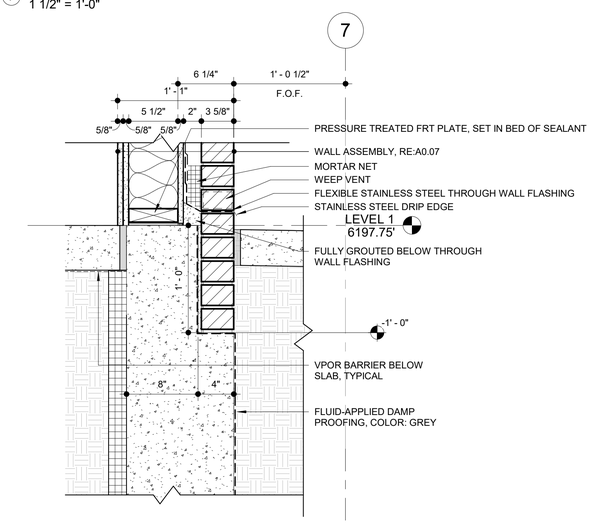

6 FOUNDATION DETAIL - BRICK WALL
1 1/2" = 1'-0"

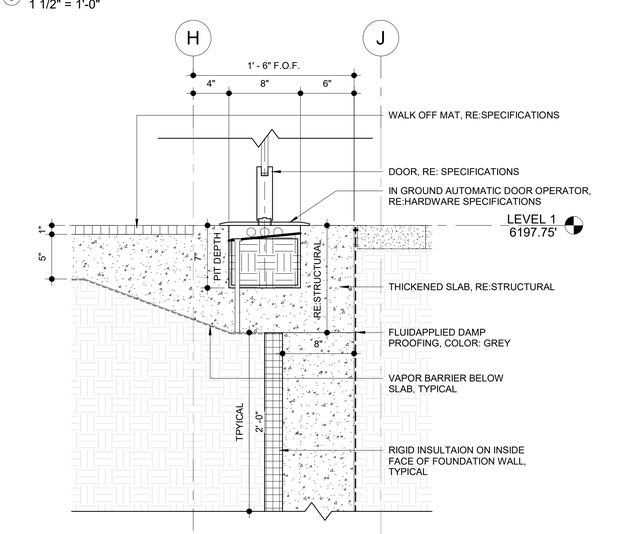

2 SECTION DETAIL - VESTIBULE ENTRY THRESHOLD
1 1/2" = 1'-0"

HELTSHE

M1A | MERIDIAN 105 ARCHITECTURE

CITY HOTEL
415 PERRY STREET, CASTLE ROCK, CO.

DATE: 4.22.2026	ISSUED FOR: PERMIT	SHEET TITLE: FOUNDATION DETAILS	SHEET NUMBER A9.01
PROJ. NO. 2023.002			

C:\Users\daniel\Documents\City Hotel-2024_1_dljpscomb74CJ8.rvt

4/22/2026 1:10:03 PM

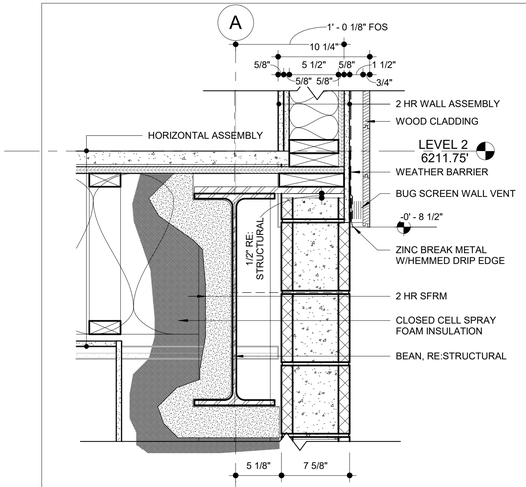

8 WALL DETAIL - WEST FACADE AT T.O. CMU
1 1/2" = 1'-0"

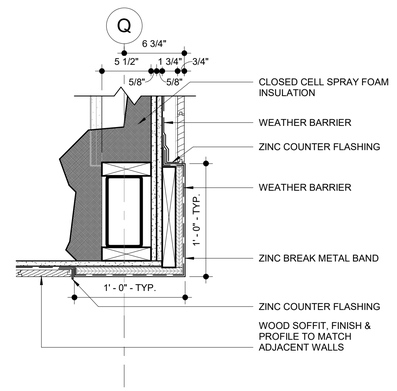

6 WALL DETAIL EAST FACADE SOFFIT/WALL INTERSECTION
1 1/2" = 1'-0"

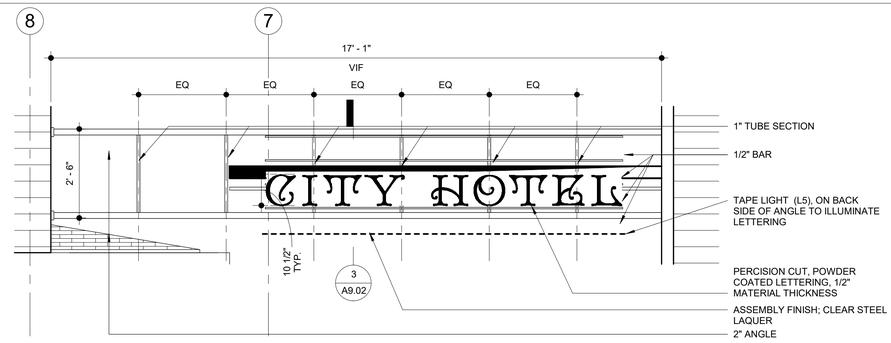

2 WALL DETAIL - SIGNAGE ELEVATION
1/2" = 1'-0"

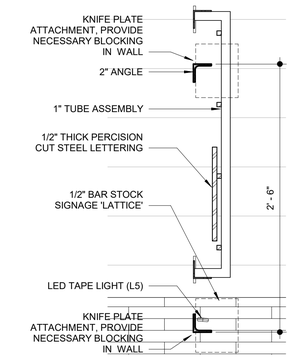

3 WALL DETAIL - SIGNAGE SECTION
1 1/2" = 1'-0"

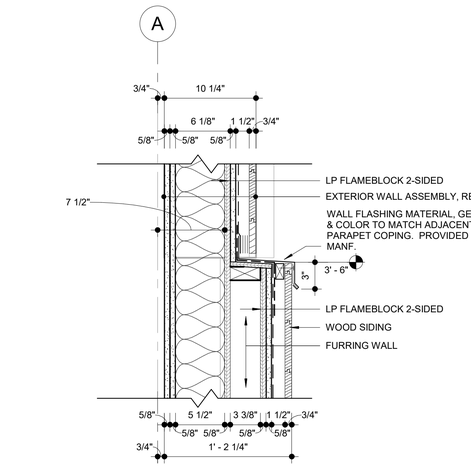

7 WALL DETAIL - LEVEL 4 WALL TRANSITION
1 1/2" = 1'-0"

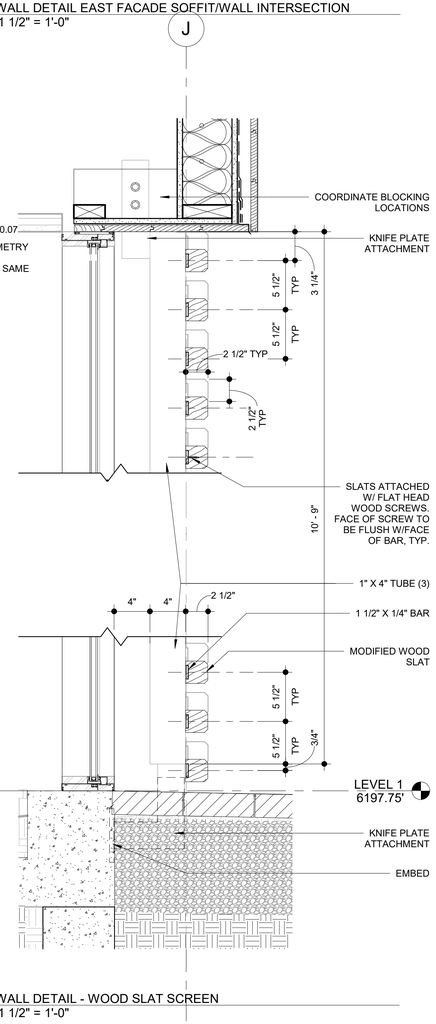

9 WALL DETAIL - WOOD SLAT SCREEN
1 1/2" = 1'-0"

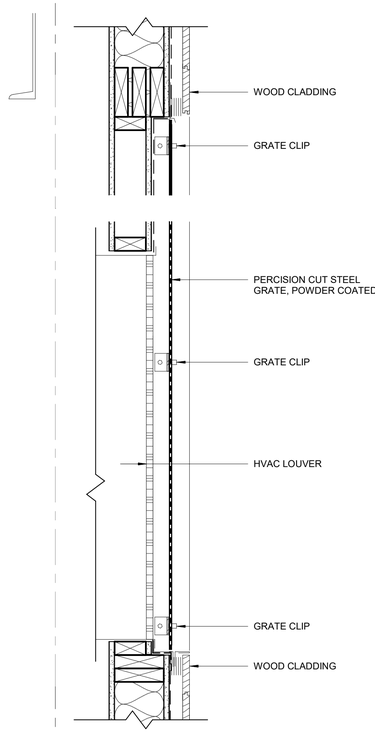

5 WALL DETAIL - VTAC SECTION LEVELS 2 & 3
1 1/2" = 1'-0"

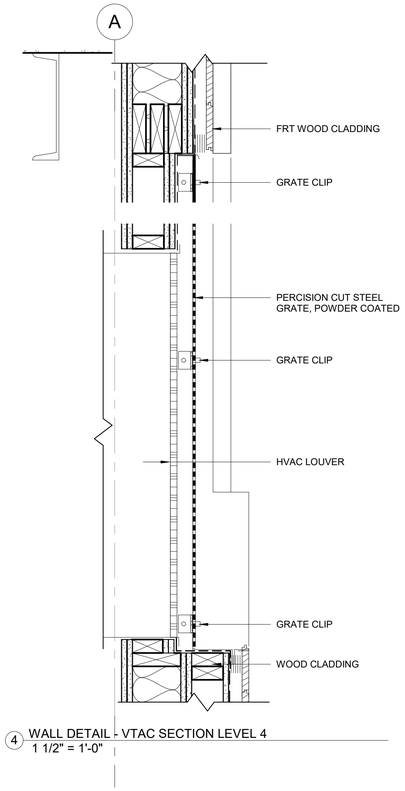

4 WALL DETAIL - VTAC SECTION LEVEL 4
1 1/2" = 1'-0"

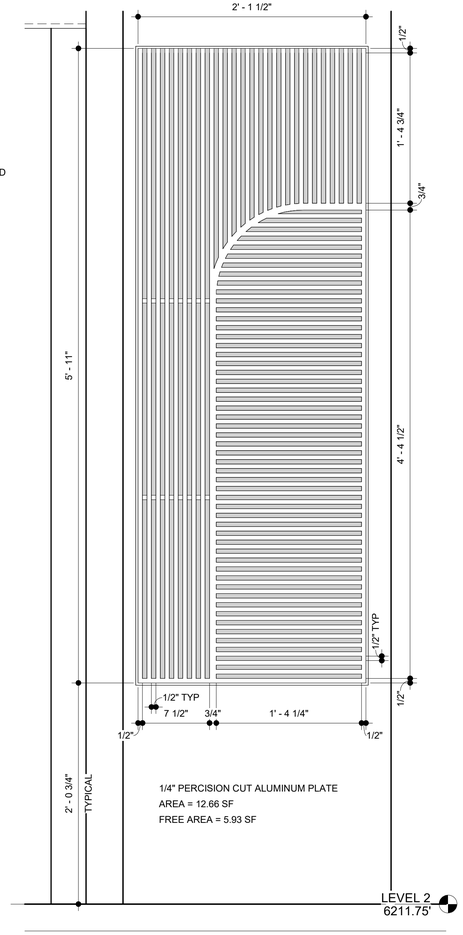

1 WALL DETAIL - VTAC DECORATIVE PANEL
1 1/2" = 1'-0"

C:\Users\daniel\Documents\City Hotel-2024_1_dlipscomb74CJB.rvt

4/22/2026 1:10:08 PM

HELTSHE

M1A | MERIDIAN 105 ARCHITECTURE

CITY HOTEL
415 PERRY STREET, CASTLE ROCK, CO.

DATE: 4.22.2026	ISSUED FOR: PERMIT	SHEET TITLE: WALL DETAILS	SHEET NUMBER A9.02
PROJ. NO. 2023.002			

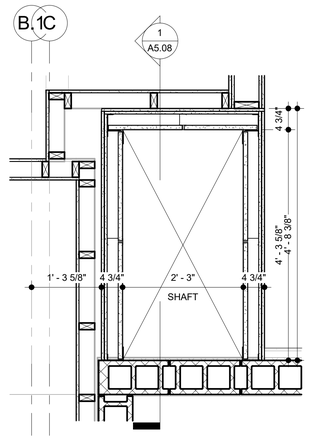

8 WALL DETAIL - PLAN OF NORTH SHAFT
3/4" = 1'-0"

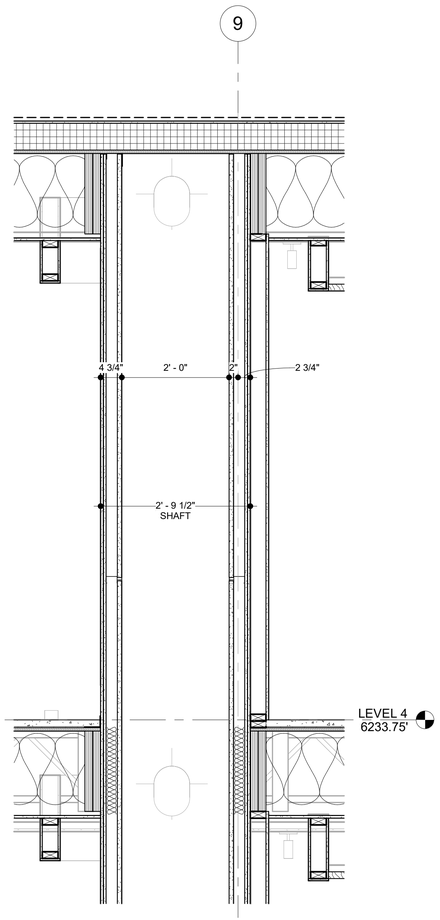

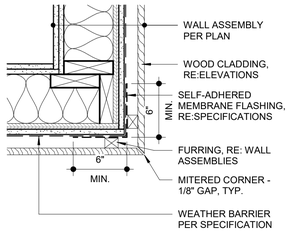

9 WALL DETAIL - PLAN AT WOOD CLADDING CORNER
1 1/2" = 1'-0"

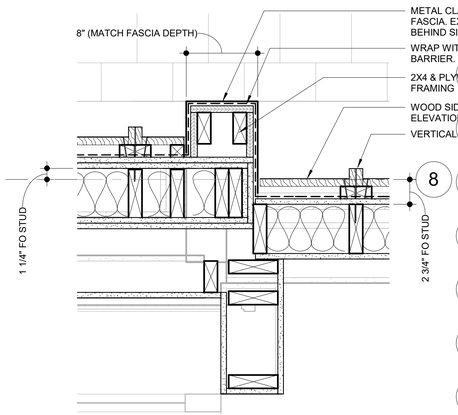

4 WALL DETAIL - PLAN AT LEVEL 6 WALL TRANSITION
1 1/2" = 1'-0"

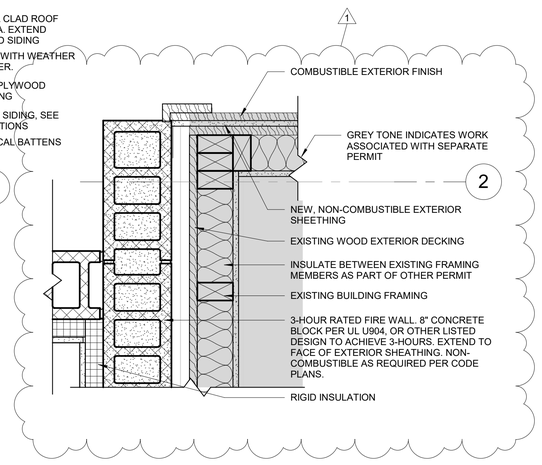

2 WALL DETAIL - PLAN OF NORTH FIREWALL CORNER
1 1/2" = 1'-0"

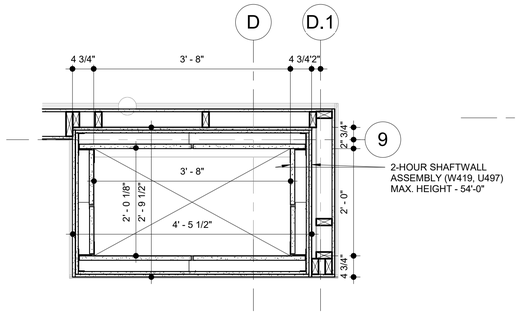

7 WALL DETAIL - PLAN OF SOUTH SHAFT
3/4" = 1'-0"

10 WALL SECTION - HEAD OF SHAFT
3/4" = 1'-0"

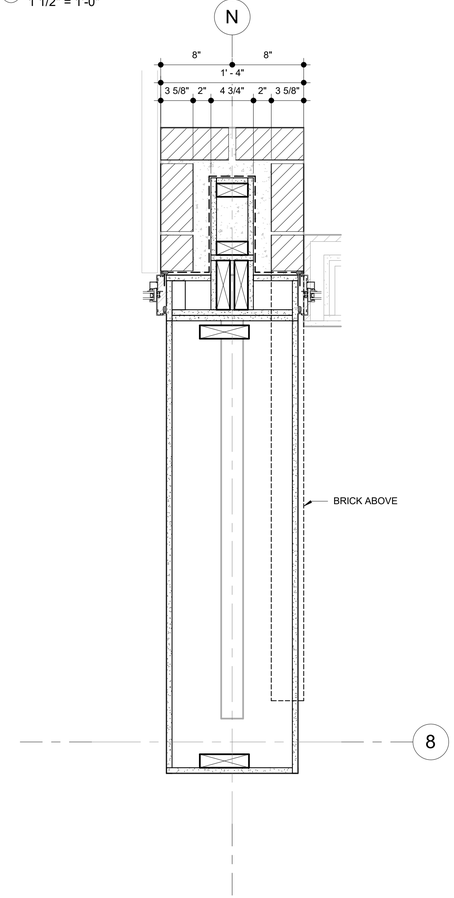

5 WALL DETAIL - PLAN OF BRICK PILASTER
1 1/2" = 1'-0"

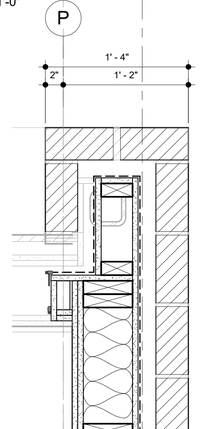

6 WALL DETAIL - BRICK PILASTER AT G
1 1/2" = 1'-0"

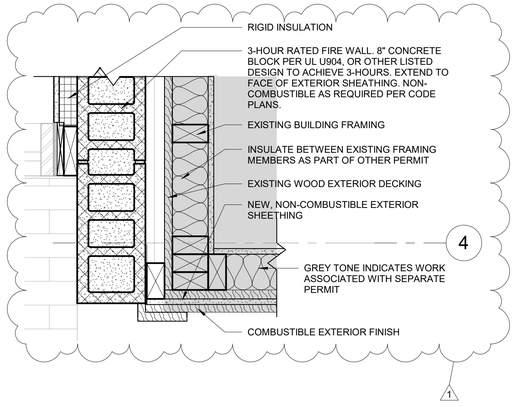

1 WALL DETAIL - PLAN OF SOUTH FIREWALL CORNER
1 1/2" = 1'-0"

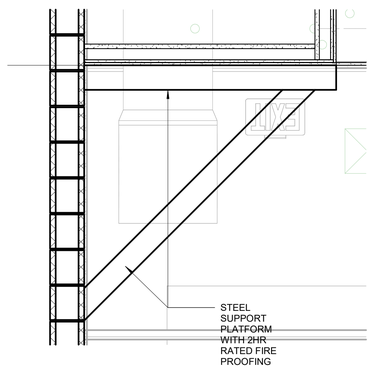

11 WALL SECTION - BASE OF NORTH SHAFT
3/4" = 1'-0"

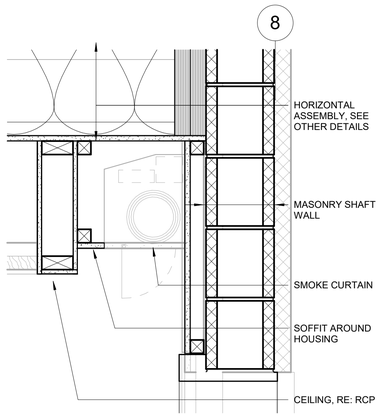

12 WALL DETAIL - SMOKE CURTAIN
1 1/2" = 1'-0"

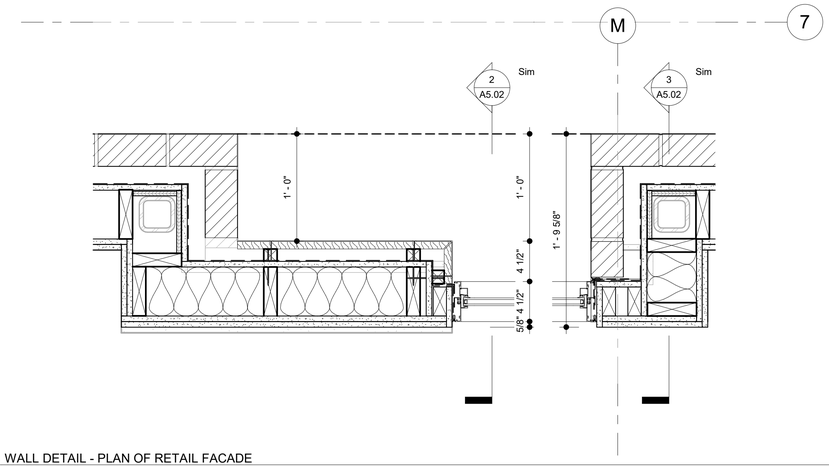

3 WALL DETAIL - PLAN OF RETAIL FACADE
1 1/2" = 1'-0"

C:\Users\daniel\Documents\City Hotel-2024_1_dlipscomb74C.J8.rvt
4/22/2026 1:10:13 PM

HELTSHE

M1A MERIDIAN 105 ARCHITECTURE

CITY HOTEL
415 PERRY STREET, CASTLE ROCK, CO.

DATE: 4.22.2026	ISSUED FOR: PERMIT	SHEET TITLE: WALL DETAILS	SHEET NUMBER A9.03
PROJ. NO. 2023.002			

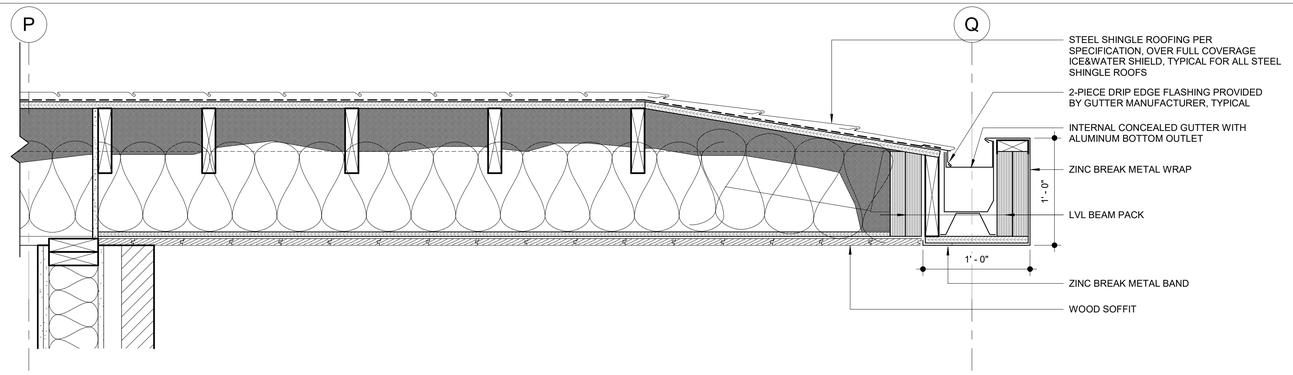

7 ROOF DETAIL - SLOPED ROOF OVER RETAIL EXTERIOR 2
1 1/2" = 1'-0"

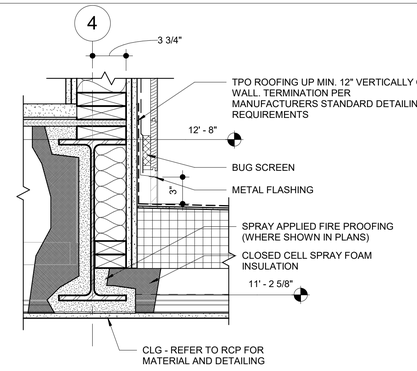

1 ROOF DETAIL - FLAT ROOF/WALL INTERSECTION
1 1/2" = 1'-0"

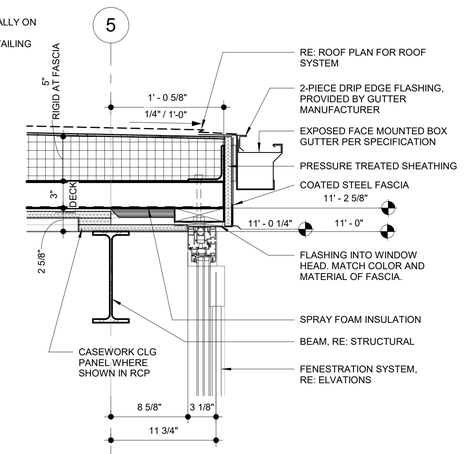

13 ROOF DETAIL - LOW ROOF OVER BAR, SOUTH FACING
1 1/2" = 1'-0"

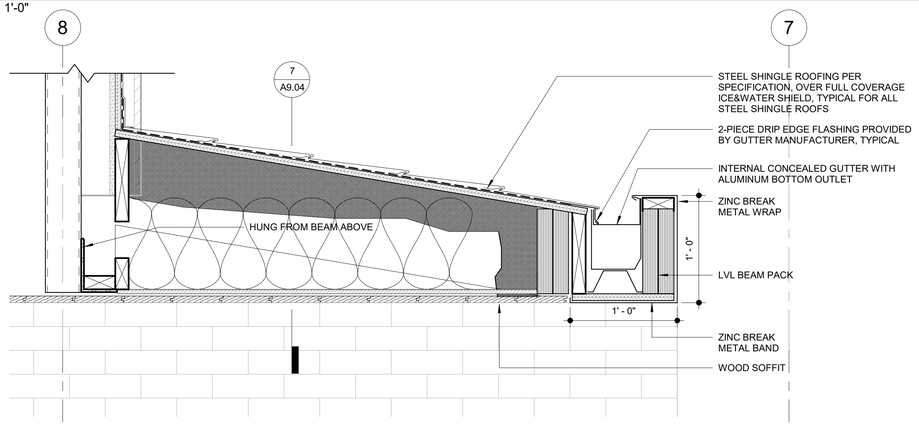

6 ROOF DETAIL - SLOPED ROOF OVER RETAIL EXTERIOR
1 1/2" = 1'-0"

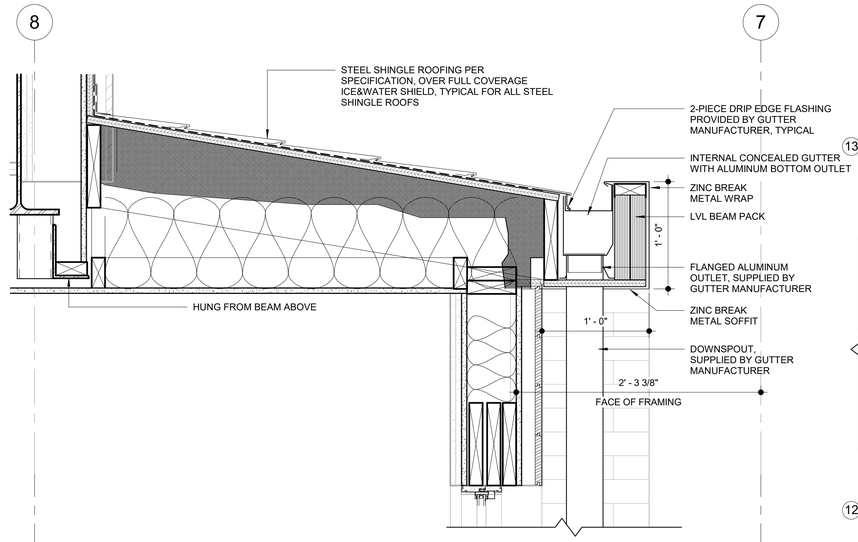

9 ROOF DETAIL - SLOPED ROOF OVER RETAIL/FRAMED WALL
1 1/2" = 1'-0"

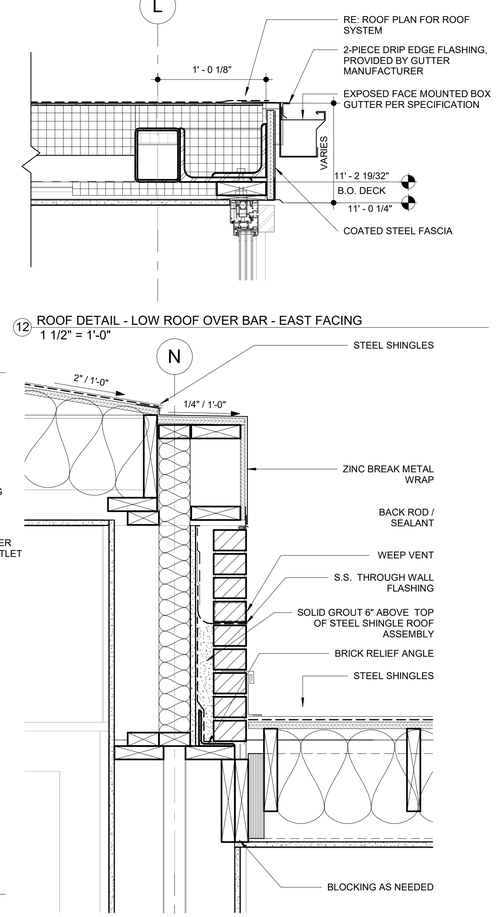

12 ROOF DETAIL - LOW ROOF OVER BAR - EAST FACING
1 1/2" = 1'-0"

11 ROOF DETAIL - LOW ROOF TRANSITION
1 1/2" = 1'-0"

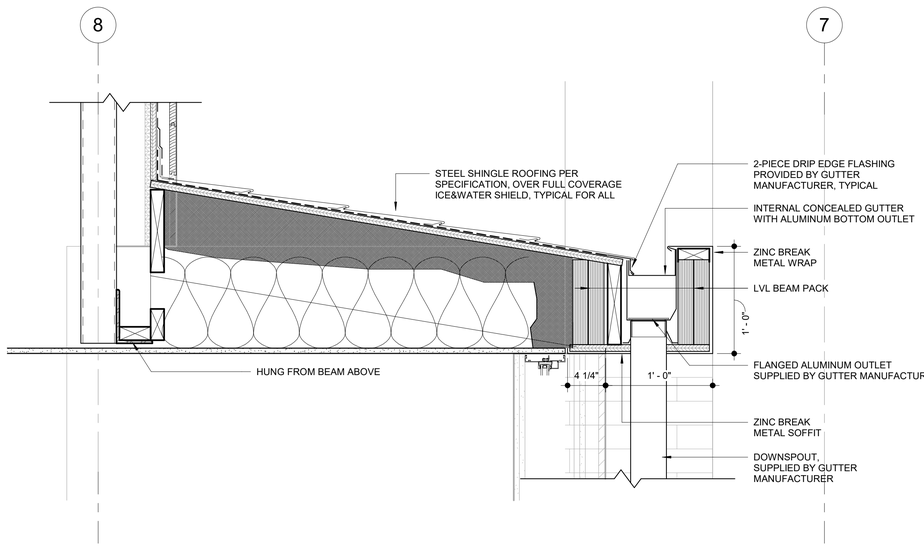

10 ROOF DETAIL - SLOPED ROOF OVER RETAIL/STOREFRONT
1 1/2" = 1'-0"

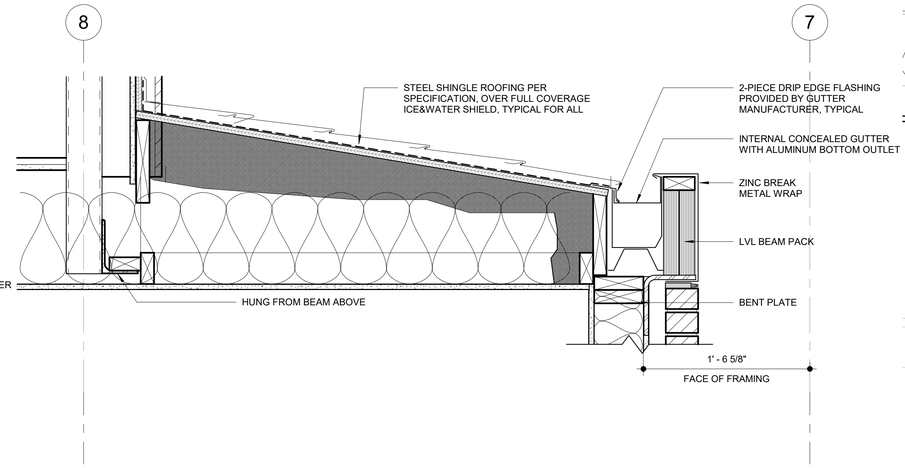

8 ROOF DETAIL - SLOPED ROOF OVER RETAIL/BRICK
1 1/2" = 1'-0"

C:\Users\daniel\Documents\City Hotel-2024_1_dlipscomb74CJ8.rvt
4/22/2026 1:10:17 PM

HELTSHE

M1A | MERIDIAN 105 ARCHITECTURE

CITY HOTEL
415 PERRY STREET, CASTLE ROCK, CO.

DATE: 4.22.2026	ISSUED FOR: PERMIT	SHEET TITLE: ROOF DETAILS - ROOFS	SHEET NUMBER A9.04
PROJ. NO. 2023.002			

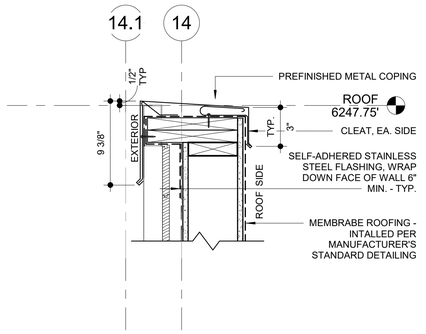

10 ROOF DETAIL - PARAPET CAP AT SOUTH FACADE
1 1/2" = 1'-0"

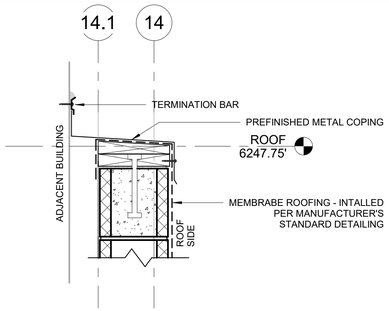

12 ROOF DETAIL - PARAPET CAP AT SOUTH FACADE CMU/ADJACENT BUILDING
1 1/2" = 1'-0"

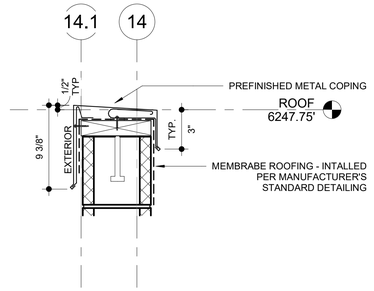

11 ROOF DETAIL - PARAPET CAP AT CMU
1 1/2" = 1'-0"

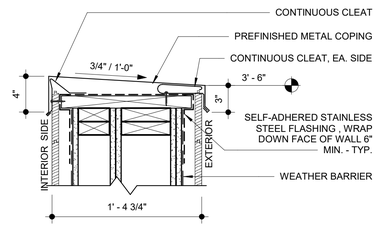

9 ROOF DETAIL - PARAPET CAP AT BAR DECK
1 1/2" = 1'-0"

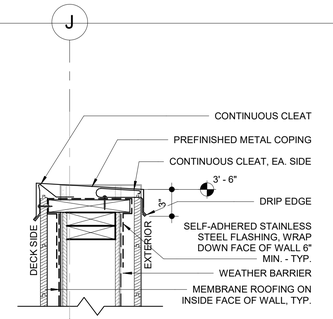

13 ROOF DETAIL - TYPICAL PARAPET CAP
1 1/2" = 1'-0"

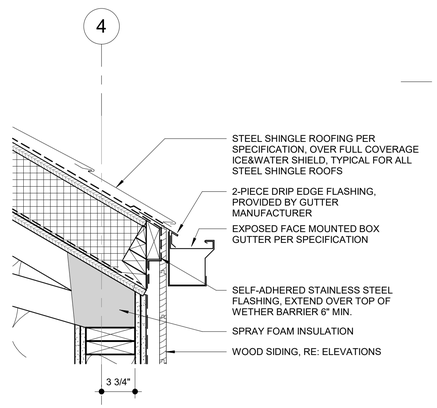

01 ROOF DETAIL - PITCHED ROOF OF NEW STRUCTURE
1 1/2" = 1'-0"

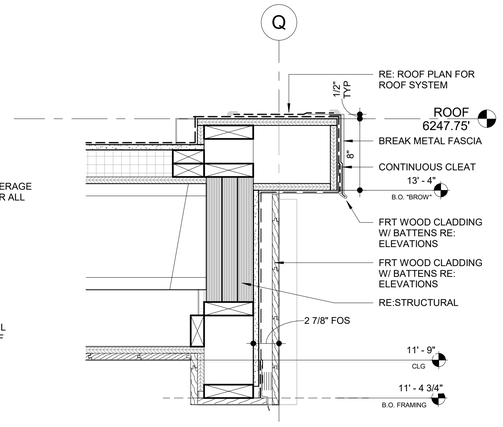

02 ROOF DETAIL - EAST FACADE OVER DECK
1 1/2" = 1'-0"

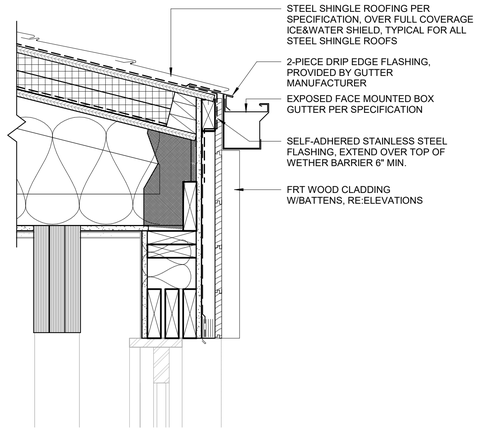

04 ROOF DETAIL - PITCHED LEVEL 4 ROOF
1 1/2" = 1'-0"

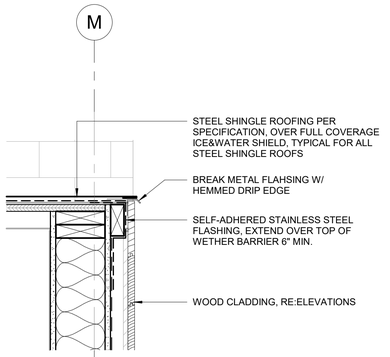

3 ROOF DETAIL - EAST AND WEST EAVE OF NEW STRUCTURE
1 1/2" = 1'-0"

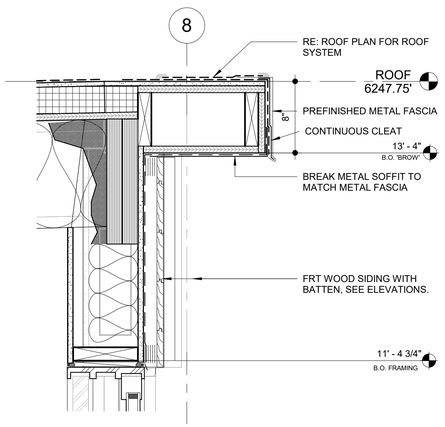

07 ROOF DETAIL - LEVEL 4 NORTH FACING
1 1/2" = 1'-0"

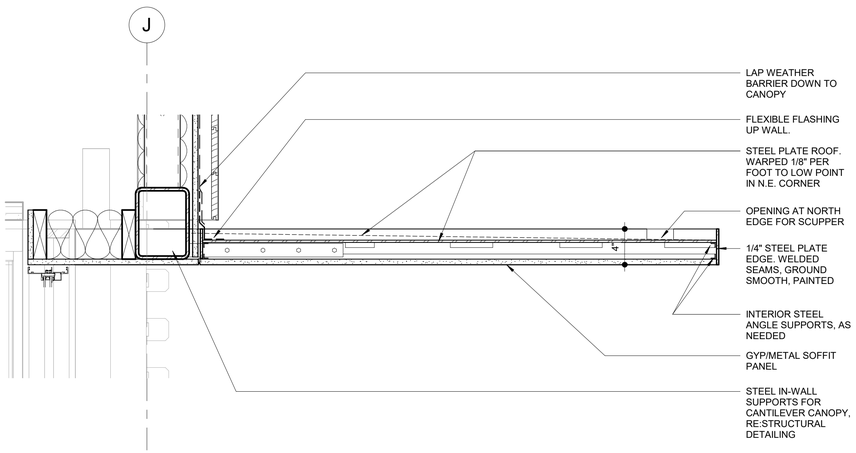

08 ROOF DETAIL - ENTRY CANOPY
1 1/2" = 1'-0"

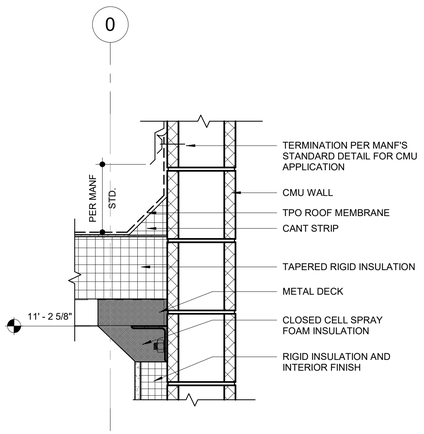

5 ROOF DETAIL - NORTH PARAPET LEVEL 1
1 1/2" = 1'-0"

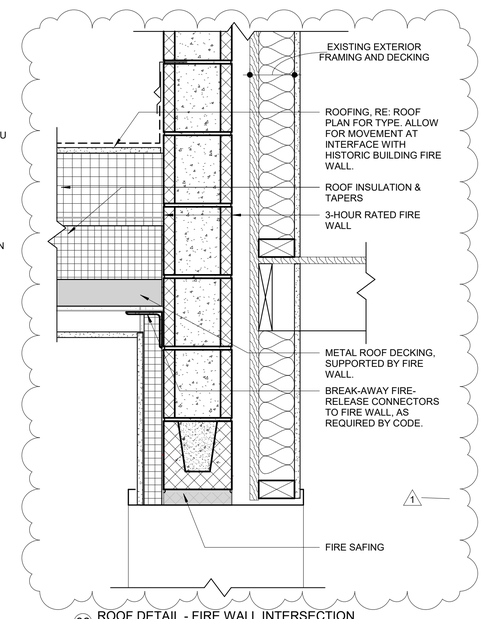

06 ROOF DETAIL - FIRE WALL INTERSECTION
1 1/2" = 1'-0"

C:\Users\daniel\Documents\City Hotel-2024_1_dljpscomb74CJ8.rvt
4/22/2026 1:10:23 PM

HELTSHE

M1A | MERIDIAN 105 ARCHITECTURE

CITY HOTEL
415 PERRY STREET, CASTLE ROCK, CO.

DATE: 4.22.2026	ISSUED FOR: PERMIT	SHEET TITLE: ROOF DETAILS	SHEET NUMBER A9.05
PROJ. NO. 2023.002			

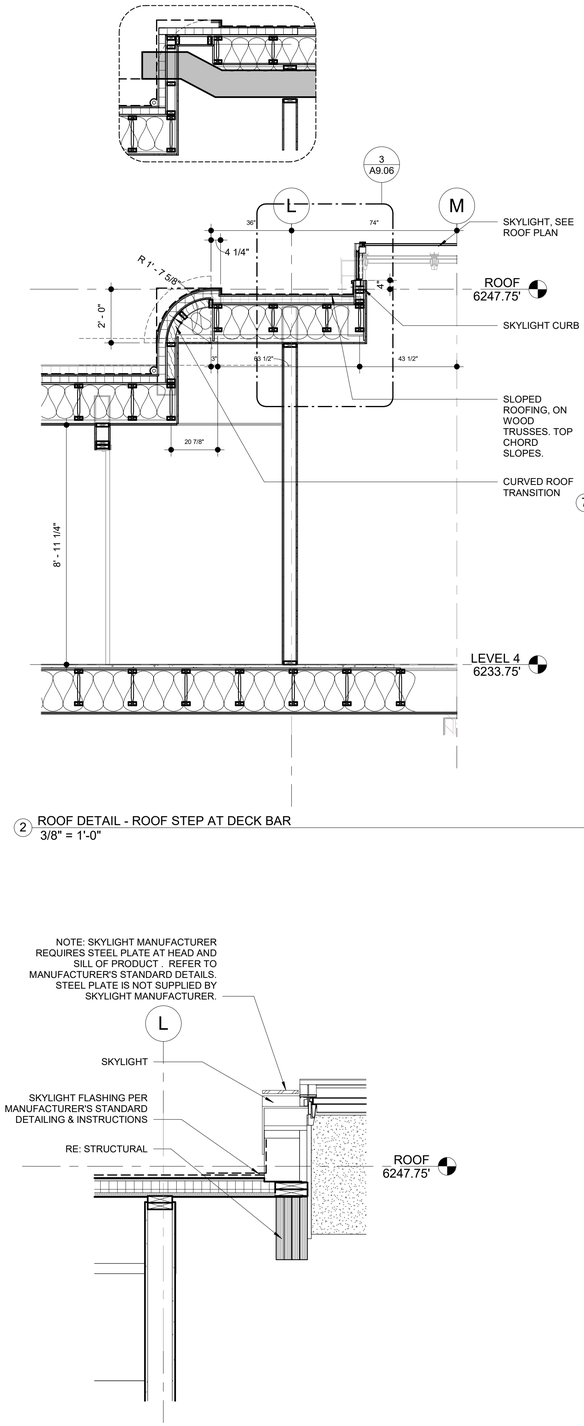

2 ROOF DETAIL - ROOF STEP AT DECK BAR
3/8" = 1'-0"

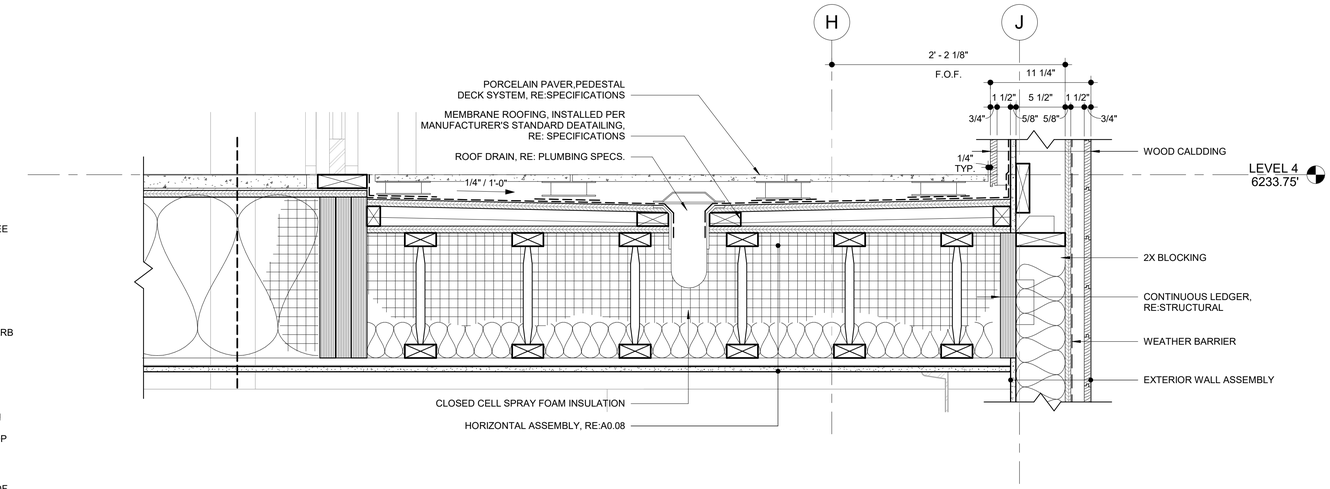

7 ROOF DETAIL - DECK AT HOTEL ROOMS
1 1/2" = 1'-0"

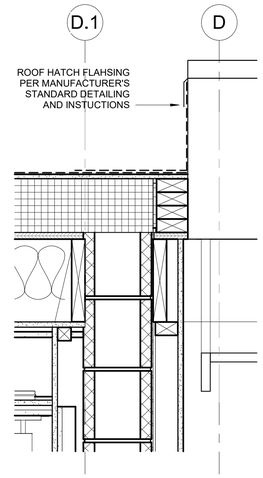

4 ROOF DETAIL - HATCH
1 1/2" = 1'-0"

3 SECTION - ROOFTOP SKYLIGHT
3/4" = 1'-0"

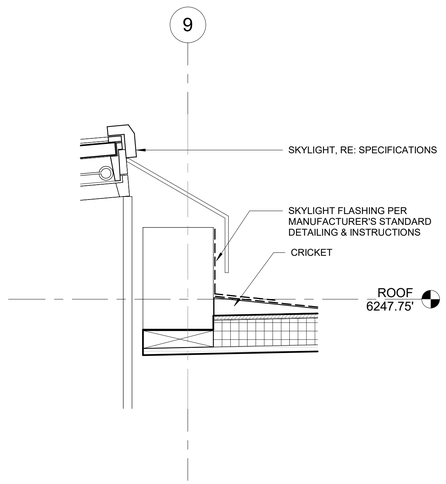

6 ROOF DETAIL - SKYLIGHT EDGE
1 1/2" = 1'-0"

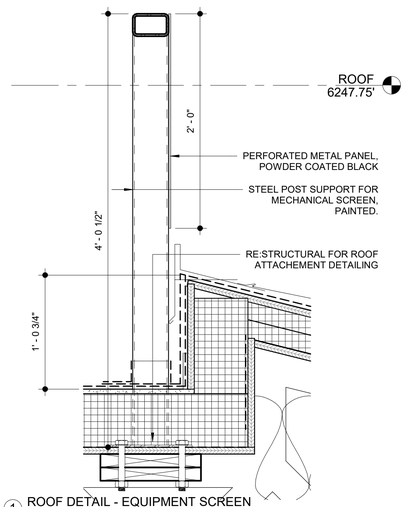

1 ROOF DETAIL - EQUIPMENT SCREEN
1 1/2" = 1'-0"

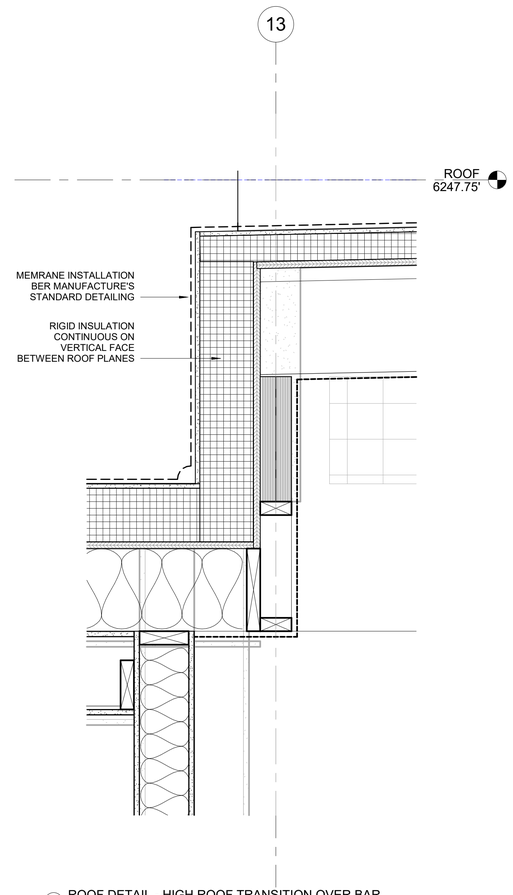

5 ROOF DETAIL - HIGH ROOF TRANSITION OVER BAR
1 1/2" = 1'-0"

C:\Users\daniel\Documents\City Hotel-2024_1_dlipscomb74CJ8.rvt

4/22/2026 1:10:27 PM

HELTSHE

M1A MERIDIAN 105 ARCHITECTURE

CITY HOTEL
415 PERRY STREET, CASTLE ROCK, CO.

DATE: 4.22.2026	ISSUED FOR: PERMIT	SHEET TITLE: ROOF DETAILS	SHEET NUMBER A9.06
PROJ. NO. 2023.002			

General Notes:

1 The purpose of these drawings is to show the structural work associated with the building at 415 Perry Street in Castle Rock, CO

2 The work shown on these drawings has been designed in accordance with the structural requirements of the 2018 International Building Code with Town of Castle Rock Amendments.

3 The structural components have been designed for the following loads:

A. Uniform live load:

Lobbies	100 psf
Other assembly areas	100 psf
Dining rooms and restaurants	100 psf
Hotels and multifamily dwellings	
Private rooms and corridors serving them	40 psf
Public rooms and corridors serving them	100 psf
Roofs (occupiable)	
Assembly areas	100 psf
Stairs and exits	
All other	100 psf
Retail	
First floor	100 psf

Live load has been reduced on girders, columns and footings in accordance with the building code

B. Roof loads:

Snow:

Ground snow load, p_g	35 psf
Flat roof snow load, p_f	35 psf (Elev. = 6,198ft)
Exposure factor, C_e	1.0
Importance factor, I_s	1.0
Thermal factor, C_t	1.0
Slope Factor(s), C_s	1.0
Drift surcharge load, p_d	See plan
Width of snow drift, W	See plan
Rain loads: in accordance with Section 1611	
Roof live load:	20 psf min
Rainfall intensity is required by the 2018 IBC code. See Section 1603.1.9.	
Rainfall intensity (15-min. duration/100 year avg. interval)	6.00 in./hr.

C. Wind design data:

Wind loads have been determined based on Section 1609.1.1 in accordance with ASCE 7-16, Chapters 26, 27, 29 and 30, Directional Procedure

Risk category	II
Basic wind speed (3-second gust):	
Ultimate design wind speed, Vult	115 mph
Nominal design wind speed, Vasd	90 mph
Exposure	C
Internal pressure coefficient	0.18

Design wind pressure (Nominal design wind pressures) for components and cladding on building walls (use Zone 4 generally; use Zone 5 within "a" of building wall corners):

	Surface pressure (psf)			
Area	10 sq.ft	20 sq. ft.	50 sq. ft.	100 sq. ft.
Negative Zone 4	-29.1	-28.2	-27.0	-26.1
Negative Zone 5	-34.2	-32.4	-30.0	-28.2
Positive Zones 4 & 5	27.4	26.5	25.3	24.4

Design wind pressure (Nominal design wind pressures) for components and cladding on building roofs (for locations of zones 1, 2 and 3, refer to building code):

	Surface pressure (psf)			
Area	10 sq.ft	20 sq. ft.	50 sq. ft.	100 sq.ft.
Negative Zone 1	-31.2	-31.2	-31.2	-31.2
Negative Zone 2	-34.9	-34.4	-33.6	-33.1
Negative Zone 3	-44.4	-41.0	-36.5	-33.1
Positive all zones	16.1	15.5	14.7	14.2

D. Earthquake design data:

Risk category	II
Seismic importance factor, I_e:	1.0
Mapped short period spectral response accelerations, S_s:	0.214g
Mapped 1 second period spectral response accelerations, S_1:	0.058g
Site class:	D
Design short period spectral response accelerations, S_{DS}:	0.229g
Design 1 second period spectral response accelerations, S_{D1}:	0.093g
Seismic design category:	B
Analysis procedure: Equivalent Lateral Force	
Seismic force resisting system: Intermediate Reinforced Masonry Shear Walls, Light-Framed wood walls sheathed with wood structural panels rated for shear resistance, Steel Systems not Specifically Detailed for Seismic Resistance	
Controlling System for Design: Steel Systems not Specifically Detailed for Seismic Resistance	
Seismic response coefficient, C_s:	0.049
Response modification factor, R:	3.0
Deflection amplification factor, C_d:	3.0
Design base shear:	52 KIPS

E. Other loads:

Concentrated loads:	
Stair treads (on 4 inches square)	300 lb
Elevator machine room grating (on 4 inches square)	300 lbs
All roof members	300 lbs
Impact loads	
Loads increased as follows:	
Elevator machinery	100%

F. Special loads:

Retaining walls	
Lateral equivalent fluid pressure	35 pcf
Seismic load (h = height of wall)	5.5 h^2
Vertical live load surcharge	100 psf

G. Guardrails (load applied in any direction):

Top rail concentrated	200 lbs
or	
Top rail uniform load	50 plf
Intermediate rail concentrated load	50 lbs

4 This structure has been designed to be self-supporting and stable after the construction of the building has been completed. The stability of the structure prior to completion is solely the responsibility of the contractor. This responsibility extends to all related aspects of the construction activity including, but not limited to, erection methods, erection sequence, temporary bracing, forms, shoring, use of equipment, and similar construction procedures. Review of the construction by the engineer is for conformance with design aspects only, not to review the contractor's construction procedures. Lack of comment on the part of the engineer with regard to construction procedures is not to be interpreted as approval of those procedures.

5 This structure utilizes plywood shear walls, bracing elements, and moment frames to provide lateral stability. Therefore, temporary bracing, guys, etc., must be maintained until all plywood shear walls have been erected and attached to the steel framing and bracing and moment frames have been erected.

6 Jobsite safety and construction procedures are solely the responsibility of the contractor. Review of the construction by the engineer is for conformance with design aspects only, not to review the contractor's provisions for job site safety. Lack of comment by the engineer is not to be interpreted as approval of those aspects of work.

7 PDF digital files of all erection and detail shop drawings for steel reinforcing bars (concrete and concrete -masonry construction), structural steel, wood trusses, indicating the fabricator, manufacturer, finish, layout, and all accessories, must be submitted to and be checked by the contractor and subcontractor and bear the checker's initials before submission to the architect for review prior to fabrication. Fabrication and/or delivery to the site of components prior to receiving approved shop drawings shall be at the fabricator's own risk.

8 Deferred submittals: Deferred submittals are those portions of the design that are not submitted at the time of application and are to be submitted to the building official within a specified period. The following deferred submittals shall be submitted to the engineer for approval.

A. Prefabricated wood trusses

After approval by the engineer, the deferred submittal documents shall be submitted to the building official for approval. Deferred submittal items shall not be installed until the deferred submittal documents have been approved by the building official.

9 Testing and inspection of concrete, steel reinforcing bars (concrete and concrete masonry construction), concrete masonry, structural steel, steel deck, wood framing, wood trusses, wood sheathing, and other work are described in the project "Statement of Special Inspections". The contractor shall review the "Statement of Special Inspections" and coordinate the scheduling of inspections with the special inspector. Uninspected work that required inspections may be rejected solely on that basis.

10 If faulty construction procedures, or material, result in defective work that requires additional engineering time to devise corrective measures, professional fees may be charged to the contractor at the standard hourly rate of additional services. Such fees may be withheld from the contractor's payment.

11 Loads, openings and structure in any way related to requirements of other (non-structural) disciplines are shown for bidding purposes only. However, these plans do not show the full scope of openings, in roofs, floors and walls. For size and location of all openings, see architectural and mechanical drawings. Do not scale openings. The contractor shall obtain from the heating and ventilating, electrical, plumbing and other trades the final approved size and location of all openings, equipment and work to be provided for their trade for roofs, floors and walls, whether shown or not shown on structural drawings. Excess cost related to variation in requirements or equipment are not to be borne by the owner.

12 For any mechanical equipment weights used in design of supporting elements that are indicated on the drawings. Contractor shall notify the architect prior to installation of equipment if actual weight exceeds weight shown on drawings.

13 The contractor shall verify all dimensions, elevations and angles with architectural drawings and existing conditions before proceeding with any work.

14 The contractor shall field verify existing conditions before proceeding with any work. The contractor shall field verify all dimensions noted "±" that are indicated on the drawings.

15 The contractor and subcontractors shall obtain the latest copies of approved plans and surveys and they shall familiarize themselves thoroughly with these plans before commencing any work.

16 Work shown as "Typical Details" apply throughout the project as required. Work shown as "Sections" shall be considered to apply for the same and similar conditions in the building.

17 Some details of the work are shown on the architectural drawings. A careful review and study of these details are necessary before the full scope of the work can be comprehended.

18 Do not scale drawings.

Codes and Standards References

1 Concrete:
Concrete work shall conform to all the requirements of:
ACI 301-16, "Specifications for Structural Concrete in Buildings" and
ACI 318-19, "Building Code Requirements for Structural Concrete".

2 Concrete masonry:
Concrete masonry work shall conform to the requirements of TMS 402-16, "Building Code Requirements for Masonry Structures" and TMS 602-16, "Specifications for Masonry Structures".

3 Structural steel:
Design, fabrication and erection of structural steel shall conform to the "Specification for Structural Steel for Buildings" as adopted on July 7, 2016, by the American Institute of Steel Construction (AISC) and the 15th Edition of the AISC Steel Construction Manual.

4 Wood:
Wood construction shall conform to the ANSI/AWC NDS-2018, "National Design Specification for Wood Construction" with the 2018 supplement.
Wood Trusses shall conform to TPI 1 -2014, "National Design Standard for Metal-plate-connected Wood Truss Construction".

Foundation notes:

1 Recommendations for the site preparation and earthwork within the perimeter of the proposed new structure, preparation of soil bearing surfaces, material specification and placement of structural backfill for support of foundations and slabs-on-grade, and drainage are stated in the geotechnical engineering report prepared for this project by Kumar & Associates, Inc. and dated October 24,2023. The geotechnical report is a reference document, not a contract document, and the design team is not responsible or liable for the accuracy of the information contained in the report.

2 The foundations have been designed to rest on inorganic, undisturbed soil or compacted granular fill having a bearing value of 2500 psf as recommended in the geotechnical engineering report referenced above. Such bearing strata are anticipated at the bottom of footing elevations noted on the foundation plan. All bearing strata shall be reviewed by the geotechnical engineer prior to placing concrete in order to verify the bearing value.

3 The slab-on-grade sub-base shall be a crusher run stone free from soft disintegrated pieces, mud, dirt, or other injurious material. The material shall have no sone greater than 2 inches in any one dimension and with less than 10 percent by weight passing a No.100 sieve.

4 The bottom of exterior footings not on solid rock shall be at least 3' - 0" below finished grade.

5 All soil surrounding and under footings shall be protected from freezing and frost action during the course of construction.

6 Step footings where elevations change at a maximum slope of one vertical on two horizontal and place lower footings first.

7 Foundation walls shall not be backfilled before they are temporarily braced or before the concrete has attained its specified compressive strength and the framed floor system at the top of the wall is in place.

8 Foundation walls shall be backfilled by placing fill on both sides simultaneously and to the same level.

9 Minimum anchor bolt requirements for attachment of superstructure to foundation shall be 3/4" diameter at 4'-0" o.c. spacing for full height basements and 1/2" diameter at 6'-0" o.c. spacing for crawl spaces and slabs on grade. Embed anchor bolts a minimum of 15" into masonry, and 7" into cast concrete. Anchor bolts are to be placed within 1'-0" of all corners on all exterior walls. All pieces of sill plate shall have a minimum of two anchor bolts.

10 Keep foundation excavations free of water at all times.

11 Use crushed stone backfill or controlled compacted fill or lean concrete (f'c=1500 psi) for over-excavation of footings.

12 Existing utilities: locate existing underground utilities in areas of excavation work. Provide adequate means of support and protection during earthwork operations.

13 Where footings are in close proximity to sub-surface piping bottom of footings shall be at least 8" below elevation of piping unless otherwise shown on the drawings.

14 Filter fabrics/geotextile fabrics: where indicated on the drawings, provide a filtration type geotextile between crushed stone and the surrounding soil. Fabric shall be TenCate Mirafi 140N or Propex Geotex 401.

15 Submittals to the engineer are required for structural fill and slab sub-base.

Concrete Notes:

1 All concrete work shall conform to all the requirements of ACI 301, "Specifications for Structural Concrete in Buildings" and ACI 318 "Building Code Requirements for Structural Concrete", as specified in the code reference section of these general notes.

2 Concrete shall be the specified weight and develop a minimum compressive strength in 28 days as follows:

Location indicated)	Weight	Minimum Strength	Maximum W/C Ratio (or slump where
Footings	Normal	3,000 psi	0.55
Walls and piers:			
Interior	Normal	3,000 psi	0.55
Exterior	Normal	4,000 psi	0.45
Exterior exposed	Normal	5,000 psi	0.40
Slabs-on-grade -interior	Normal	4,000 psi	0.45

3 All detailing fabrication, and erection of reinforcing bars, unless otherwise noted, must follow the latest ACI code and the latest ACI "Manual of Standard Practice for Detailing Reinforced Concrete Structures".

4 Concrete design mix will be submitted to the engineer for review, together with laboratory reports attesting that the mixes can attain the minimum strength required in accordance with ACI 301 indicated above.

5 Portland cement shall be Type I or Type II and conform to ASTM C 150.

6 Other cementitious material such as flyash or ground granulated blast- furnace slag may be blended with cement for use in the concrete mix. Flyash shall conform to ASTM C 618 and may replace cement if the following ranges for the 2 classes of flyash; Class C, 20 to 35%; Class F, 15 to 25%. Ground granulated blast- furnace slag shall conform to ASTM C 989 and may not exceed 50% of total weight of cementitious materials.

7 For normal weight concrete: coarse aggregate shall be 3/4" and conform to ASTM C 33. Fine aggregate shall be manufactured or natural sand from the same source for the entire project and shall conform to ASTM C 33.

8 No admixtures are permitted without the engineer's written permission other than entrained air. Concrete exposed to the weather, such as that used in foundation walls, shall contain 5% +/- 1 1/2% entrained air. Concrete exposed to the weather and to de-icing compounds shall contain 6% +/- 1 1/2% entrained air. Do not use air entrainment admixture for interior normal weight concrete slabs.

9 Limit water-soluble, chloride-ion content in hardened concrete to the following percent by weight of cement: 1.00 for reinforced concrete that will be dry and protected from moisture, 0.30 for reinforced concrete that will exposed to moisture but not exposed to chlorides, 0.15 for reinforced concrete exposed to moisture and chlorides from deicing chemicals and salt/seawater, and 0.06 for prestressed (post-tensioned) concrete.

10 Reinforcing steel shall conform to ASTM A 615, Grade 60.

11 Welded wire fabric shall conform to ASTM A 1064 with a minimum yield strength of 65 ksi. Lap one mesh size at sides and ends, and wire together.

12 Vapor retarder shall be Stego Wrap (15 mil) vapor retarder by Stego Industries LLC and shall have a water vapor permeance after conditioning (ASTM E 1745, Paragraphs 7.1.2 – 7.1.5) that is less than 0.01 perms and meets the requirements of Class A. Place as per ASTM E 1643 and manufacturer's written instructions.

13 The following concrete cover shall be provided for reinforcement:

Location	Cover (inches)
Concrete cast against and Permanently exposed to earth	3
Concrete exposed to earth or weather:	
#6 through #18 bars	2
#5 bar and smaller	1 1/2
Concrete not exposed to weather or in contact with ground:	
Slabs, walls, joists:	
#14 and #18 bars	1 1/2
#11 bar and smaller	3/4
Beams, columns	
Primary reinforcement, ties, stirrups, spirals	1 1/2

14 The conveyance, placement and protection of the concrete shall conform to the requirements of ACI 318, indicated above, and ACI 304R, "Guide for Measuring, Mixing, Transporting and Placing Concrete". Mechanical vibrators are to be used to consolidate the freshly cast concrete around the reinforcing and against form surfaces and to prevent the formation of air or stone pockets, honeycombing, pitting or planes of weakness. However, care must be used to avoid over vibration that can lead to aggregate segregation.

15 No welding of reinforcing will be permitted.

16 All lap splices shall be Class B, in accordance with ACI 318 indicated above.

17 Concrete piers: Place concrete piers and walls together. Set pier reinforcing and set wall reinforcing through pier vertical bars. Provide dowels with standard hook from footing at all piers. Size and quantity of dowels to match vertical pier reinforcing (Class "B" splice).

18 The contractor shall be responsible for limiting pours to minimize shrinkage cracking. In general, walls shall not be poured in continuous lengths exceeding 30 feet without providing construction joints or control joints. The location and configuration of joints exposed to view shall be coordinated with the architect.

19 The installation of slabs shall conform to the requirements of ACI 302.1R, "Guide to Concrete Floor and Slab Construction". Interior finish slab surfaces are to have a steel trowel finish. Exterior slab surfaces are to have a broom finish unless specified on the architectural drawings.

20 Expansion and isolation-joints:
Filler strips: ASTM D 1751, asphalt-saturated cellulosic fiber or ASTM D 1752, cork or self expanding cork
Sealant at top of joint: Sika's Sikaflex 2c SL poly urethane elastomeric sealant. Provide cap to separate sealant from filler.

21 Waterstops: Flexible polyvinyl chloride (PVC) waterstop conforming to Corp of Engineers Specification CRD-C 572, with flat dumbbell and center bulb.

22 The curing and protection of concrete shall conform to the requirements of ACI 318 and ACI 308R, "Guide to Curing Concrete". Concrete slabs shall be protected from loss of surface moisture for not less than 7 days using a curing compound conforming to ASTM C 309 or constantly wetted burlap. Curing compounds shall be compatible with any intended flooring overlay. Do not install finish flooring until slab has adequately dried per the flooring manufacturer's specifications.

23 Cold weather concrete placement: If cold weather concreting conditions exist as defined by a period of more than three days when the average outdoor temperature, (high + low)/2, is less than 40 deg. F. the procedures outlined in ACI 306.1, "Standard Specification for Cold Weather Concreting" and ACI 306R, "Guide to Cold Weather Concreting" shall be utilized.

24 Hot weather concrete placement: Maintain concrete temperature below 90 deg. F. at time of placement and comply with ACI 301 and ACI 305R, "Guide to Hot Weather Concreting".

25 Accurately position, support, and secure reinforcement and anchors against displacement. Locate and support reinforcement with bar supports to maintain minimum concrete cover. Do not tack weld crossing reinforcing bars. Provide bar supports as follows:

A. Bolsters, chairs, spacers, and other devices for spacing, supporting, and fastening reinforcing bars and welded wire reinforcement in place. Do not "wet stick" reinforcement or anchors. Manufacture bar supports from steel wire, plastic, or precast concrete according to CRSI's "Manual of Standard Practice," of greater compressive strength than concrete.

26 Sizes and locations of all required embedded items, such as anchor bolts, piping sleeves, holdown anchors, etc., for all trades shall be coordinated by the general contractor with other trades.

27 Submittals to the engineer are required for concrete mix designs, cement, reinforcing bars, admixtures, and aggregates.

Concrete Masonry Notes:

1 All concrete masonry work shall conform to the requirements of the "Building Code Requirements for Masonry Structures (ACI 530/ ASCE 5/ TMS 402)" and the "Specifications for Masonry Structures (ACI 530.1/ASCE 6/ TMS 602, as specified in the code reference section of these general notes.

2 The compressive masonry strength, f'm, shall be 2,000 psi minimum. System components have been selected based on the unit strength method.

3 Concrete block shall be lightweight hollow load bearing masonry units conforming to ASTM C 90, with a minimum ultimate compressive strength of 2,000 psi on the net area of the units. Units shall be protected from moisture absorption.

4 Portland cement used in the mortar and grout shall conform to ASTM C 150. **Masonry cement or mortar cement shall not be used.**

5 Mortar shall be Type S conforming to the volumetric proportions set forth in ASTM C 270. Use 1 part Portland cement; 0.25 to 0.5 parts hydrated lime or lime putty; and aggregate proportioned to 2.25 to 3 times the sum of the separate volumes of cementitious materials (i.e. Portland cement plus lime). Provide aggregate in loose, damp condition. Add water to produce a workable mix.

6 Coarse grout used in pilasters and walls shall conform to the volumetric proportions set forth in ASTM C 476. Use one part Portland cement, 2.25 to 3 parts damp, loose sand, 1 to 2 parts 3/8" pea gravel. Add water to produce a flowable mix with an 8 to 11 inch slump. Alternatively, fine grout may be used that conforms to the volumetric proportions set forth in ASTM C 476 using one part Portland cement, 2.25 to 3 parts damp loose sand and adding water to produce a flowable mix with an 8 to 11 inch slump.

7 Steel reinforcing bars shall conform to ASTM A 615, Grade 60. Reinforcing bars to be lapped 48 bar diameters at splices. Reinforcement to be secured against displacement at spacing not exceeding 200 bar diameters.

8 Joint (horizontal) reinforcement shall be hot-dipped galvanized W1.7 (9 gage) steel wire, ASTM A 951 with ASTM A 153 Class B-2 coating, Ladder type, by Hohmann & Barnard, Inc., or an approved equal. Place joint reinforcing in every second course (16"o.c.). Joint reinforcement shall be lapped 6 inches at splices.

9 Place units while mortar is soft and plastic. Remove and relay in fresh mortar any unit disturbed to the extent that initial bond is broken after initial positioning.

10 Fully bed units in all shear walls including cross webs.

11 All cells with reinforcing bars or bolts shall be grouted solid.

12 Vertical cells to be grouted solid shall have a minimum clear opening of 3"x2-1/2". The entire perimeter of the cell shall be fully bedded with mortar.

13 Consolidate grout pours exceeding 12 inches in height by mechanical vibration and reconsolidate by mechanical vibration after initial water absorption and settlement has occurred. Grout pours exceeding 5.33 feet are high lift pours and shall require cleanouts. High lift grouting shall not be used unless high lift grout procedures are submitted to the engineer for review and approved by the engineer.

14 The structural plans do not show the full extent of masonry lintels that may be required for doors, windows, ducts, louvers, etc. For those openings that require masonry lintels and are not shown on the structural plans, see architectural drawings for location and size of openings. Do not scale openings. For masonry lintel size for corresponding masonry opening size, see "Typical Masonry Lintels in Non-Load Bearing Walls Detail". Note, if architectural drawings do not indicate a masonry lintel for a particular opening, then provide a steel lintel as per lintel notes, unless otherwise directed by the engineer.

15 Masonry opening lintels have been designed on the basis of arching action of the completed wall. Lintels require temporary support until the mortar has achieved the specified strength.

16 Cover the tops of all masonry construction to protect against precipitation.

17 Masonry shall not be constructed in temperatures below 40 F. Provide a heat source and protection as required to maintain temperature above 40 F in accordance with ACI 530.1.

18 Hot weather construction techniques shall be in accordance with ACI 530.1 and shall be implemented when the ambient air temperature exceeds 100 F, or 90 F if the wind speed exceeds 8 mph.

19 Unless otherwise shown on architectural or structural drawings provide vertical control joints through concrete masonry unit walls for full wall height as follows:

A Distance between joints should not exceed the lesser of length to height ratio of 1.5, or 25 feet
B At changes in wall height
C At changes in wall thickness – including pipe and duct chases and pilasters
D At and above expansion joints in foundations and floors
E At and below expansion joints in roofs and floors that bear on the wall
F For openings, do not locate control joints within 32 inches of openings
G Adjacent to corners of walls or at wall intersections within a distance equal to half the control joint spacing.

20 Submittals to the engineer are required for certificates of compliance for block grade and strength, grout, mortar, and reinforcing bars prior to delivery to the site.

Structural Steel Notes:

1 Design fabrication and erection of structural steel shall conform to the American Institute of Steel Construction's "Specification for Structural Steel for Buildings", as specified in the code reference section of these general notes.

2 Materials:

Wide flange shapes:	ASTM A 992 Grade 50
American standard shapes, angles, Plates and bars:	ASTM A 36
Structural steel tubing, Rectangular and square	ASTM A 500, Grade C (Fy=50 ksi)
Structural steel pipe:	ASTM A 53, Grade B (Fy=35 ksi)
Bolts	ASTM F3125, Grade A 325
Anchor rods	ASTM F 1554, Grade 36
Welding electrode	ASTM E 70xx, low hydrogen

3 All welding shall conform to American Welding Society's AWS D1.1 "Structural Welding Code-Steel" code for arc and gas welding and be performed by a certified welder in accordance with A.W.S. standards.

4 High strength bolts: install high-strength bolts according to Research Council on Structural Connections' (RCSC's) "Specification for Structural Joints Using High-Strength Bolts" for type of bolt and type of joint specified.
Joint type: Snug tightened unless otherwise noted.

5 Beam reactions are indicated on the plans, refer to the typical beam legend for reaction designations. Beams with shear reactions not shown shall be designed for a 12 kip reaction (service loads for allowable stress design).

6 The fabricator is responsible for designing connections for the reactions shown on these plans and submitting these design calculations, signed and sealed by a qualified professional engineer registered in the state of jurisdiction who is responsible for their preparation, for review by the structural engineer of record through the architect. The reactions shown are "service" loads for "Allowable Stress Design" (ASD). Connections may be designed for these values using the conventional "Allowable Stress Design" method, as specified in the AISC Steel Construction Manual indicated in the code reference section of these general notes.

7 For moment connections, notch-tough welding electrodes, complying with AWS requirements, shall be used for full penetration welds. Also for full penetration welds, provide welding tabs at beam flange edges to allow welding of full beam width.

8 For moment connections, backing bars and weld tabs for welds need not be removed, unless testing agency requires removal to facilitate testing and inspection or weld tabs interfere with architectural finishes.

9 All moment connections utilizing full or partial penetration groove welds, shall be ultrasonic tested, as indicated in the Statement of Special Inspections, and shall be detailed to allow for such ultrasonic testing.

10 Where slotted hole connections are shown, nuts shall be fastened snug tight, then untightened by one-half turn. Peen threads to prevent further loosening of the nut.

11 Grout shall be nonmetallic, shrinkage-resistant grout conforming to ASTM C 1107, Grade B or C, factory-packaged, nonmetallic aggregate grout, noncorrosive, nonstaining, mixed with water to consistency suitable for application and a 30-minute working time.

12 Structural steel shall be cleaned in accordance with the Steel Structures Painting Council Specification SP 3 for Power Tool Cleaning (except for steel exposed to weather).

13 All steel members and bolting exposed to weather shall be cleaned in accordance with the Steel Structures Painting Council Specification SP 6 for Commercial Blast Cleaned and hot-dipped galvanized in accordance with ASTM A 123 and ASTM A 153. Minimum acceptable zinc coating weight shall be 2 oz./sq. Ft. See architectural specifications for finished paint if required. Clean areas where galvanizing is damaged or missing and repair galvanizing to comply with ASTM A 780.

14 Provide bitumastic protection coating for all structural steel below grade.

15 Continuous members, where indicated on the drawings, shall require either 1) the member to be furnished as one piece, or 2) if individual pieces are to be provided, then they shall be connected by either welding or bolting to develop the full strength of the continuous member.

16 Split cantilevers for steel beams shall be designed for the full moment capacity of the beam unless otherwise noted.

17 Unless otherwise noted, at cantilever beam connection to top of columns, provide welded 3/4" cap plate with (4)-3/4" diameter A 325 bolts on beam gage. Provide 1/2" minimum fitted stiffeners welded at both sides of beam web. Locate stiffeners over column flange on cantilever side.

18 Provide 1/4" closure plates with seal weld at ends of all HSS members.

19 Fabricator shall hold a current AISC certification for "Certified Building Fabricator (BU)", (formerly known as "Standard for Steel Building Structures (STD)".)

20 For miscellaneous steel, see architectural drawings.

The Di Salvo Engineering Group
Structural Engineers
405 S. Wilcox Street, Ste 210
Castle Rock, CO 80104
[720] 667-3388 | www.tdeg.com

COLORADO LICENSED STEPHEN GLENN TERCHEK 53653 PROFESSIONAL ENGINEER

HELTSHE

M1A | MERIDIAN 105 ARCHITECTURE

CITY HOTEL
415 PERRY STREET, CASTLE ROCK, CO.

DATE: 4/22/26
PROJ. NO. 24603.00

ISSUED FOR:
1 Re-Issued for Permit

SHEET TITLE:
GENERAL NOTES AND MATERIAL SPECIFICATIONS

SHEET NUMBER
S0.00

C:\Users\james\Documents\24603_City Hotel_struct_tdeg.rvt

4/22/2026 1:15:06 PM

21 Provide 9/16" holes for wood nailers as required by architectural drawings. For beams supporting wood framing at top flange, provide 2x wood nailers fastened to top flange with (2) rows 1/2" diameter A 307 bolts at 6'-0" o.c., staggered at 3'-0" o.c.
22 Submittals to the engineer are required for certificates of compliance for structural steel, bolts, nuts, washers, and weld filler material prior to the fabrication of any steel
23 At the completion of fabrication, the fabricator shall submit a certificate of compliance stating that the work was performed in accordance with the approved contract documents, as required by Section 1704.2 of the building code indicated at the beginning of these General Notes.

Steel Deck Notes:

1 Steel deck shall be designed, fabricated, and erected in accordance with the current specification of the Steel Deck Institute.
2 Formed steel roof deck to be 3" deep, 20 gage (uncoated steel thickness = 0.0358"), galvanized (G60 coating), wide rib, United Steel Deck "N" Deck profile, as manufactured by Canam Steel Deck, Incorporated or an approved equal.
3 The steel deck shall be supplied in minimum lengths as required to provide a "3-span" condition. Column closures, end closures, z-closures, cover plates, roof sumps, and closures at penetrations of same material, finish, and thickness as deck and all other accessories necessary for a complete installation are required. Provide additional reinforcement and closure pieces at edges and openings as required for strength, continuity of deck, and support of other work.
4 Formed steel roof deck shall be welded to supporting steel with 5/8" diameter puddle welds at all edge ribs plus a sufficient number of interior ribs to limit the spacing between adjacent points of attachment to 6" on center.. Intermediate side connections shall be made with No.10 self-tapping screws at mid-span or 3'-0" on center, whichever is smaller. Deck perimeter edge connections between supports (parallel to supports) shall be made with No.12 self-tapping screws at mid-span or 3'-0" on center, whichever is smaller. Install deck ends over supporting frame with a minimum end bearing of 1-1/2 inches. End laps of sheets shall be a minimum of 2" and shall occur over supports.
5 Steel deck must be protected before and after erection and all debris cleaned from its surface where concrete will be poured or roofing is to be placed.

Lintel Notes:

1 Unless otherwise noted, for lintels over doors, windows, ducts, and miscellaneous openings in non-bearing 4", 8" and 12" CMU walls and brick walls use for each 4" of masonry:

Angle size	Max. M.O.	Bearing each end
3 1/2" x 3/8" flat plate	2'-0"	6"
3 1/2" x 4" x 5/16" (LLV)	3'-6"	6"
3 1/2" x 5" x 5/16" (LLV)	5'-0"	6"
3 1/2" x 6" x 5/16" (LLV)	6'-0"	8"
3 1/2" x 6" x 3/8" (LLV)	8'-0"	8"

2 Openings in non-bearing walls masonry where no specific lintels or lintel sizes are indicated shall have 8" bearing at each end and shall have the following sizes:

Max. M.O.	Wall thickness	Lintel size
9'-0"	8"	W8x24
9'-0"	9"-13"	W8x31 + 5/16" plate
12'-0"	8"	W8x28
12'-0"	9"-13"	W8x35 + 5/16" plate

Plates indicated in above lintels shall have a width 1" less than the wall thickness and a length 1" less than the masonry opening.
Provide 7 1/2" x 5/8" x 0'-7 1/2" bearing plates on 3/4" grout bed with (2)-5/8" diameter x 6" long welded anchor studs at 3" o.c. unless otherwise noted. Field weld bottom flange of beam to bearing plate with 1/4" weld at each side of flange.
3 For 6" masonry partitions use WT 7x13 for spans up to 7'-0" with 6" bearing each end.
4 For 10" masonry partitions use WT 7x21.5 for spans up to 7'-0" with 8" bearing each end.
5 Fill the first two courses directly under bearing with grout for 16" length.
6 See architectural and mechanical drawings for size and location of openings.
7 When openings occur in bearing walls or the height of masonry above the lintel is less than the opening width or when a control joint is located directly above or within 16" of the jamb opening and drawings do not otherwise indicate a specific lintel design, consult with the architect to confirm lintel requirements.
8 Lintels over adjacent openings with piers between less than 2'-8" wide shall be continuous over piers. Masonry units of such piers shall be filled with grout for full story height.
9 Connect lintel to structural steel columns when there is less than 16" of masonry between the masonry opening and the outermost face of column.
10 Lintels supporting exterior masonry shall be hot-dipped galvanized. See structural steel notes.
11 Lintels for openings in walls: These plans do not show the full scope of steel lintels required for new wall openings for doors, windows, ducts, louvers, etc.. For masonry opening size and location of all wall openings, see architectural and mechanical drawings. Do not scale openings. For steel lintel size for corresponding masonry opening size, see notes, above, unless otherwise noted on plans.

General Wood Notes:

1 Wood design is based on the AF&PA NDS, "National Design Specification for Wood Construction with Supplement", as specified in the code reference section of these general notes.
2 Stud bearing walls, shear walls, and roof and floor decks shall be framed with the member sizes and/or types at the spacings shown on plan. The contractor shall coordinate locations of all plumbing piping, HVAC ducting and recessed lighting fixtures, etc prior to layout to minimize interference that may require the altering or strengthening of the installed framing.
3 All wood framing is to be stored on site above the ground on "stickers" indoors or under tarps with adequate clearances to allow air circulation.
4 Walls shall be installed straight and plumb. Floors shall be installed level at the proper elevation. Roofs shall be installed at the pitches indicated on the architectural drawings.
5 Joists and rafters shall be installed directly over bearing studs unless otherwise detailed.
6 At bearing walls above floor joists where the joists span perpendicular to the bearing wall above, provide blocking between the joists. Blocking width shall match bearing wall width above. Blocking shall be LVL material where joists are I-joists or LVL joists and shall be dimensioned lumber where joists are dimensioned wood framing, unless otherwise noted.
7 Joists and rafters shall be supported laterally at each support by full depth solid blocking two inches in thickness, except where joists are supported by a flush header or nailed to a rim joist.
8 Provide a minimum of two studs under each end of all flush framed headers or beam, unless more are indicated on plan. Provide one jack stud and one full king stud at each end of all dropped headers or beams, unless more jack and king studs are indicated on plan. Posts shall be solidly blocked through all intervening framed decks down to supporting girder/beams or top of foundation.
9 Flush framed connections shall be made with prefabricated galvanized steel hangers made by Simpson Strong-Tie, Co., Inc. or Kant-Sag connectors by United Steel Products Co. of width and depth appropriate for the supported member. Install with the type and quantity of fasteners recommended by the manufacturer. Prefabricated steel hangers used in contact with preservative pressure treated wood shall be hot dipped galvanized in accordance with ASTM A 123 or stainless steel, Type 316, or have a "Triple Zinc" (ASTM G 185) coating. Fasteners in contact with preservative pressure treated wood shall be hot dipped galvanized in accordance with ASTM A 153 or stainless steel, Type 316. Do not mix stainless steel and galvanized fasteners and connectors.
10 Contractor shall choose metal connector (Simpson, USP, or approved equal) based on member reactions shown on drawings and/or connection configuration and provide product data to the engineer for approval. Metal connections are required at flush framed conditions, roof rafter hold-downs, post caps and bases, and where indicated on plan.
11 Structural wood framing used in exterior applications or in contact with concrete or masonry shall be Southern Yellow Pine No. 2 or better, ACQ (Alkaline Copper Quaternary) or CA (Copper Azole) preservative pressure treated wood with a retention appropriate for end use.
12 Built-up members of three plies or less shall have adjacent plies nailed together with two rows of nails at 12" o.c. (10d common nails for 1-1/2" plies, 12d common nails for 1-3/4" plies). Built-up members of more than 3 plies shall be assembled with 1/2" diameter thru bolts at 16" o.c. staggered up and down with 2 inch clearance at top and bottom edges.
13 Exterior end walls of cathedral ceiling spaces shall be framed with studs running continuously (not spliced) from floor to roof.
14 Walls not indicated as load bearing on the plans shall not be constructed tight to the bottom of wood trusses, allowing for 3/8" truss deflection and secured to the trusses with deflection clips or deflection tracks.

Dimensioned Wood Framing Notes:

1 The structural wood stress grade stamped lumber shall be graded as follows:
Joists, rafters and studs:
Hem-Fir No. 2.
F_b (base) = 850 psi
F_c (parallel to grain) = 1300 psi
F_c (perpendicular to grain) = 405 psi
F_v (base) = 150 psi
E (base) = 1,300,000 psi
2 The design of the dimensional lumber members and their connections is based on the lumber having a moisture content at the time of installation of 19% or less.
3 Joists or rafters are to be installed with "crown" up (i.e. positive camber) and within 1/4 inch in 10 feet straight, end-to-end alignment.
4 Severely distorted (twisted, bowed, cupped, checked, etc.) lumber shall not be used.
5 Notches in the top or bottom of dimensioned lumber joists or rafters shall not exceed one-sixth the member depth and shall not be located in the middle third of the span. End notches shall not exceed one-fourth the member depth. Bored holes shall not be within two inches of the top and bottom of the member and their diameter shall not exceed one-third the member depth, unless otherwise noted on plans.

Wood Structural Panels:

1 Wood Structural Panels commonly referred to as sheathing panels, plywood or oriented strand board ("OSB"), shall conform to U.S. Product Standard DOC PS 1 or PS 2, and bear the APA grade-trademark of the American Plywood Association.
2 Sheathing panels for floors, roof, and walls shall be APA rated sheathing, Exposure 1, with a minimum span index rating of 32/16.
3 Sheathing panels on flat surfaces shall be installed with face grain or panel long dimension perpendicular across supports and continuous over two or more spans. Provide 1/8" space between panel edges parallel to face grain or panel long dimension, 1/16" space between panel edges over supporting members.
4 Floor sheathing shall be glued to supporting members with construction adhesive such as PL 200, laid in a continuous 1/4 inch wide bead along the member length.
5 At designated shear walls, horizontal edges of wall sheathing shall be backed by solid blocking between studs to provide backing for specified panel edge nailing.
6 At panel edges, nails are to be 3/8" from edge of panel.
7 The heads of nails shall be driven flush to the surface of the panel and not break the surface.

Laminated Veneer Lumber, Laminated Structural Lumber, Parallel Strand Lumber

1 Laminated Veneer Lumber (LVL) shall be "Micro-Lam" as manufactured by Weyerhaeuser, "G-P Lam" as manufactured by the Georgia Pacific Corporation or "Gang-Lam" as manufactured by the Louisiana Pacific Corporation.
Parallel Strand Lumber (PSL) shall be "Parallam" as manufactured by Weyerhaeuser.
Solid glued laminated (glulam) lumber shall be "Power Beam" and "Power Column" as manufactured by Anthony Forest Products.
Laminated Structural Lumber (LSL) shall be "Timberstrand" as manufactured by Weyerhaeuser.
2 Minimum allowable stress and stiffness characteristics of LVL and PSL material shall be as follows:

	LVL	PSL
F_b =	2600 psi	2900 psi
F_c (parallel to grain) =	2510 psi	2900 psi
F_c (perpendicular to grain) =	750 psi	750 psi
F_v =	285 psi	290 psi
E =	1,900,000 psi	2,000,000 psi

Member sizes shown on plan (width x depth) specified as LVL may be constructed of multiple LVL plies or PSL of the specified depth, fastened together by nailing or bolting as required. Member sizes followed only by PSL or solid glulam must be installed as a solid member, not built-up.
3 Minimum allowable stress and stiffness characteristics of members designated as LSL material shall be as follows:

	1.55E LSL
F_b =	2325 psi
F_c (parallel to grain) =	2050 psi
F_c (perpendicular to grain) =	800 psi
F_v =	310 psi
E =	1,550,000 psi

4 Members may not be bored or notched without written permission from the engineer.

Composite Wood "I"-Joist Notes:

1 I-joists shall be manufactured of laminated veneer lumber top and bottom flanges and Oriented Strand Board webs bonded together with an exterior adhesive. Approved manufacturers are Weyerhaeuser, ("TJI" joists), Georgia Pacific ("GPI" joists), Louisiana Pacific ("LPI" joists), and Anthony Forest Products ("PJI" joists).
2 Joists sizes are indicated generically on plan, width x depth in inches.
I-joist manufacturer's series designations

Depth	Width 1-3/4"	2-1/4" Min.	2 1/2"	3-1/2"
9-1/2"	TJI 110 GPI 20	TJI 230 GPI 40	PJI 40 LPI 20 Plus	
11-7/8"	TJI 110 GPI 20	TJI 360 GPI 40	PJI 60 LPI 32 Plus	TJI 560 LPI 56 PJI 80
14"	TJI 110 GPI 40	TJI 360 LPI 32 Plus	PJI 60 LPI 56	TJI 560 PJI 80
16"	-----	TJI 360 LPI 32 Plus	PJI 60 PJI 80	TJI 560 LPI 42 Plus

Selected joist sizes have been designed with Weyerhaeuser software for a TJ–Pro™ rating system of 50 or higher. If joists other than TJI's are used, they shall have a similar demonstrated performance.
3 I-joists are to be stored on site above the ground on "stickers" under tarps with adequate clearances to allow air circulation. I -joists are to be handled in the upright position. Do not walk on joists until manufacturer's recommended temporary top flange bracing or permanent sheathing is installed.
4 Joists of the proper size are to be installed at the spacings indicated on the drawings using the manufacturer's recommended details unless otherwise noted on plans.
5 Edge joists/box nailers are to be 1-3/4 inch minimum thick matching the joist depth made of LVL material.
6 Do not cut or notch flanges. Webs opening may be cut only as recommended in the manufacturer's literature and then only after consultation with the engineer. Do not bevel cut the top end of the joist beyond the edge of bearing.
7 Provide single "squash blocks" under bearing walls from above nailed to the joist flanges. Match the dimensions and material of the supporting stud below. "Squash blocks" are to be cut 1/16" longer than depth of joist and are to be installed with grain vertical.
8 Install joist web stiffeners as specified by the joist manufacturer and the metal connector manufacturer in addition to locations shown on the plans.
9 Rim boards: provide 1.3E laminated structural lumber (LSL), "Timberstrand" as manufactured by Weyerhaeuser, with the following allowable stress and stiffness characteristics:

F_b =	1700 psi
F_c (parallel to grain) =	1400 psi
F_c (perpendicular to grain) =	680 psi
F_v =	400 psi
E =	1,300,000 psi

Wood Fasteners Notes:

1 Wood components are to be fastened together with common nails as indicated in the following schedule unless specifically indicated otherwise on the plans.

Nailing schedule

Connection location	Nail size/type	Quantity or spacing and
Floor construction		
Built up girder/beam (3 plies or less):	10d common - 1.50" plies	2 horiz. rows
	16d common - 1.75" plies	(top & bot)
		12" o.c. direct
Floor joists to Sill or girder:	10d common	4 toe-nail
Rim/box joist to Joist end:	16d common	3 end direct
Bridging to joists:	8d common	3 toe-nail or
	10d common	2 direct
Floor truss chord to sill or girder:	16d common	3 direct
Band joist to truss end:	10d common	3 direct
Edge floor truss bottom chord to sill:	16d common	8" o.c. direct
Edge floor joist/ truss to sill:	10d common	8" o.c. toe-nail
Floor sheathing:	8d common	6" o.c. edges
	10" o.c. other	
Wall construction		
Stud to sole plate:	8d common	4 toe-nail or
	16d common	2 end direct
Top plate to stud:	16d common	2 end direct
Double studs:	10d common	9" o.c. direct
Corner studs:	16d common	16" o.c. direct
Sole plate to joist or blocking:	16d common	8" o.c. direct
Blocking between joist to top plate:	10d common	2" o.c. toe-nail
Rim/box joist to top plate:	16d common	8" o.c. toe-nail
Double cap plate:	16d common	16" o.c. direct
Double cap plate laps at end joints (24" min. offset):	16d common	8 direct
Double cap plate laps at corners and intersections:	16d common	2 direct
Header end to trimmer:	8d common	2" o.c. toe-nail or
	10d common	3" o.c. direct
Wall sheathing unless identified as a shear wall:	8d common	4" o.c. at edges
		8" o.c. other
Roof & ceiling construction		
Ceiling joist to plate:	16d common	4 toe-nail
Ceiling joists laps (over partition):	10d common	4 direct
Ceiling joists to rafter:	10d common	5 direct
Collar tie to rafter:	10d common	5 direct
Roof rafter to plate:	10d common	4 toe-nail
Roof rafter to ridge:	16d common	4 toe-nail or
	16d common	3 end direct
Valley/hip rafter to ridge, header or trimmer:	16d common	2" o.c. toe-nail or
	16d common	3" o.c. end direct
Jack rafter to hip:	10d common	3 toe-nail or
	16d common	2 direct
Blocking between rafters to top plate:	10d common	2" o.c. toe-nail
Roof sheathing:	8d common	6" o.c. edges
		10" o.c. other

2 Nails and spikes shall conform to the nominal sizes specified in Federal Specifications FF-N-105B and as noted below:

Type		Pennyweight 8d	10d	12d	16d	20d
Common	Shank diameter	0.131"	0.148"	0.148"	0.162"	0.192"
	Length	2.50"	3.00"	3.25"	3.50"	4.00"
	Head diameter	0.281"	0.312"	0.12"	0.344"	0.406"

Pneumatic or electric powered hammers often use fasteners of same length as common nails but of lesser gage or diameter; use fastener of the diameter or gage equal to or greater than the common nail specified. Fastener specifications must be submitted to the engineer for approval prior to installation if powered hammers are to be used.
3 Bolts shall conform to ASTM A 307 or ASTM A 36.
4 Lag and wood screws shall conform to ANSI/ASME standard B18.6.1 - 19.81.
5 All fasteners used in contact with preservative pressure treated wood shall be hot dipped galvanized in accordance with ASTM A 153 or stainless steel, Type 316. Do not mix stainless steel and galvanized fasteners and connectors.
6 Bored lead holes for fasteners shall be as follows:
A Nail and spike lead holes are not required unless to prevent splitting of wood. If required, lead hole diameter shall not exceed 75% of nail/spike diameter.
B Wood screws - lead hole diameter equals 7/8 of unthreaded shank diameter in connected wood part and 7/8 of diameter at root of thread in wood receiving thread.
C Lag screws - lead hole diameter equals shank diameter for extent of unthreaded shank, and 60% of shank diameter for threaded portion of shank.
D Thru bolts - lead hole diameter 1/32" to 1/16" larger than nominal bolt diameter.
7 Insert threaded screw type fasteners by turning with screwdriver or wrench. Do not drive by hammering. Facilitate installation by placing soap or other lubricant on threads.
8 Provide standard round washers under the heads of all thru bolts and lag screws and under all nuts unless otherwise indicated on the plans. Tighten fasteners without crushing wood fibers under washers.

Prefabricated Wood Truss Notes:

1 Prefabricated wood trusses shall be designed, in accordance with the current edition of the "Design Specification for Metal Plate Connected Wood Trusses" by the Truss Plate Institute.
2 Truss fabricator shall be a member of the Truss Plate Institute (TPI) and shall participate in the "Truss Plate Institute's Quality Assurance Inspection Program".
3 The manufacturer shall design the roof trusses for the following loads and in accordance with the Building Code referenced at the beginning of the General Notes, unless otherwise noted:

Top chord live load	See this sheet for roof live loads.
Top chord snow load	See this sheet for snow load criteria.
Top chord wind load	See this sheet for wind load criteria.
Top chord dead load	15 psf
Bottom chord live load	10 psf
Bottom chord dead load	10 psf
Seismic loads	See this sheet for seismic load criteria.
Mechanical equipment loads	See structural, architectural and mechanical drawings.

Maximum allowable deflections:
Roofs: Snow/live load - Vertical: L/360 or 1.00"; Horizontal: 0.375"
Total load - Vertical: L/240 or 1.50"; Horizontal: 0.500"
4 The manufacturer shall design the floor trusses for the following loads and in accordance with the building code referenced at the beginning of the General Notes, unless otherwise noted:

Top chord live load	40 psf (U.O.N. on plan)
Top chord dead load	20 psf
Bottom chord dead load	12 psf
Seismic loads	See this sheet for seismic load criteria.
Mechanical equipment loads	See structural, architectural and mechanical drawings.

Maximum allowable deflections:
floors: Live load - Vertical: L/480 or 0.5"
Total load - Vertical: L/360 or 1.00"
5 Spacing, and depth, specified on the framing plans shall not be exceeded.
6 All lumber used in the fabrication of trusses shall be stress graded and shall be of the specie, size, and grade specified in the truss design.
7 Connector plates shall be stamped from 16, 18, or 20 gauge, Grade A, galvanized structural steel. Both plate width and plate length must equal or exceed that specified in the truss design.
8 Trusses shall be fabricated in accordance with the truss design from accurately cut wood members clamped in rigid fixtures during assembly to insure tight fitting joints and uniformity in completed truss units.
9 Connector plates are to be pressed into the wood members on both sides of the truss at each joint so that full penetration of the teeth is obtained without crushing the outer surface of the wood.
10 Truss fabricator shall furnish all required hangers, holddown straps and other prefabricated fastening or connection devices indicated on the approved truss shop drawings.
11 Trusses shall be installed plumb, adequately braced, in the proper orientation, and at the spacing specified on the approved erection plan and in accordance with BCSI-1-03. Permanent web member bracing/web reinforcement shall be installed as noted on the approved shop drawings in accordance with BCSI-1-03.
12 Cutting of truss members or field alteration of any truss is not permitted without a revised design drawing from the truss supplier bearing the certification of a professional engineer registered in the jurisdiction of the project.
13 Differential deflections between adjacent trusses or bearing walls shall not exceed 1/4 inch.
14 Shop drawings and design calculations submittals bearing the certification of a professional engineer registered in the jurisdiction of the project shall be submitted to the engineer for approval. Shop drawings shall contain the following information for each type and size of truss assembly to be provided: detail of truss; species, size, grade and working stresses of lumber used; calculated force for each member; connector plate sizes and orientation; anchorages to supporting walls/members; connections for assembling multiple ply trusses and permanent bracing members and their locations for compression members. Include in this submission the following:
a) typical gable end truss details
b) overbuild truss details
c) piggyback truss details
d) erection plan indicating location and quantity of each truss type
e) erection details
f) building component and safety information (BCSI-1-03) booklet – "Guide to Good Practice for Handling, Installing and Bracing of Metal Plate Connected Wood Trusses".
15 Trusses to be supplied for the building require special inspections and must be inspected during fabrication at the fabrication plant by the inspector designated on the Statement of Special Inspections. Trusses delivered to the site prior to receiving such inspection may be rejected solely for that reason.
16 At the completion of fabrication, the fabricator shall submit a certificate of compliance stating that the work was performed in accordance with the approved contract documents, as required by Section 1704.2 of the building code indicated at the beginning of these general notes.

The Di Salvo Engineering Group
Structural Engineers
405 S. Wilcox Street, Ste 210
Castle Rock, CO 80104
[720] 667-3388 | www.tdeg.com

COLORADO LICENSED STEPHEN GLENN VERHEIJEN 53653 PROFESSIONAL ENGINEER

HELTSHE

M1A | MERIDIAN 105 ARCHITECTURE

CITY HOTEL
415 PERRY STREET, CASTLE ROCK, CO.

DATE: 4/22/26
PROJ. NO. 24603.00

ISSUED FOR:
1 Re-Issued for Permit

SHEET TITLE: GENERAL NOTES AND MATERIAL SPECIFICATIONS

SHEET NUMBER S0.01

C:\Users\james\Documents\24603_City Hotel_struct_tdeg.rvt
4/22/2026 1:15:09 PM

FOUNDATION AND LEVEL 1 SLAB-ON-GRADE PLAN

NORTH:

1/8"=1'-0"

- TOP OF LEVEL 1 FLOOR CONCRETE SLAB ON GRADE ELEVATION = DATUM ELEVATION 0'-0" = TOPOGRAPHICAL ELEVATION = 6197'-9"
- FLOOR CONSTRUCTION: 5" CONCRETE SLAB ON GRADE, REINFORCED WITH 6x6 - W2.0xW2.0 WELDED WIRE FABRIC, UNLESS OTHERWISE NOTED. FOR DETAILS, SEE "TYPICAL SLAB ON GRADE DETAILS".
- FOR FOUNDATION CONDITION AT EXTERIOR DOORS, SEE "TYPICAL DETAIL AT EXTERIOR DOORS".
- COORDINATE ALL PITS, SLAB STEPS, TRENCHES, POCKETS, BRICK SHELVES, SLEEVES, PENETRATIONS AND INSERTS IN CONCRETE WALLS AND SLABS WITH ARCHITECTURAL AND MECHANICAL DRAWINGS.
- FOR MASONRY SHEAR WALL FOUNDATION INFORMATION, INCLUDING DOWELS BETWEEN FOUNDATIONS AND MASONRY WALLS, SEE "TYPICAL CONCRETE MASONRY WALL REINFORCEMENT DETAIL". PROVIDE DOWELS BETWEEN FOUNDATIONS AND MASONRY WALLS EQUAL TO SIZE AND SPACING OF MASONRY WALL VERTICAL REINFORCEMENT.
- CONTRACTOR SHALL FIELD VERIFY EXISTING CONDITIONS BEFORE PROCEEDING WITH ANY WORK.
- SEE GENERAL NOTES, FOR ADDITIONAL INFORMATION.
- * INDICATES BOTTOM OF FOOTING ELEVATION IS APPROXIMATE. BOTTOM OF NEW FOOTING SHALL MATCH BOTTOM OF EXISTING FOOTING, UNLESS EXISTING FOOTING ELEVATION IS ABOVE FROST DEPTH IN WHICH CASE CONTRACTOR SHALL NOTIFY ARCHITECT AND ENGINEER PRIOR TO PROCEEDING WITH ANY WORK AND SHALL UNDERPIN EXISTING FOUNDATIONS AS REQUIRED TO COMPLY WITH THE BUILDING CODE. SEE "TYPICAL UNDERPINNING DETAIL".

LEGEND:

- [+/- ....] INDICATES BOTTOM OF FOOTING ELEVATION FROM TOP OF FIRST FLOOR CONCRETE SLAB DATUM ELEVATION.
- (+/-....) INDICATES TOP OF WALL ELEVATION FROM TOP OF FIRST FLOOR CONCRETE SLAB DATUM ELEVATION.
- +/..... INDICATES TOP OF CONCRETE SLAB ELEVATION FROM TOP OF FIRST FLOOR CONCRETE SLAB DATUM ELEVATION. MAINTAIN FULL SLAB THICKNESS AT SLOPED AND DEPRESSED AREAS. SEE ARCHITECTURAL DRAWINGS FOR LOCATION AND EXTENT.
- "SF" INDICATES APPROXIMATE LOCATION OF STEPS IN FOOTINGS ON PLAN. COORDINATE LOCATION AND ELEVATION WITH SITE GRADING AND MECHANICAL, ELECTRICAL AND PLUMBING DRAWINGS. FOR DETAILS, SEE "TYPICAL STEPPED FOOTING DETAIL".
- "CJ" INDICATES APPROXIMATE LOCATION OF CONTROL/CONSTRUCTION JOINTS IN SLABS ON GRADE. FOR DETAILS, SEE "TYPICAL SLAB ON GRADE DETAILS".
- F-## INDICATES FOOTING TYPE. SEE "FOOTING SCHEDULE AND FOOTING DETAIL".
- P-# INDICATES PIER TYPE. SEE "PIER SCHEDULE AND PIER DETAILS".

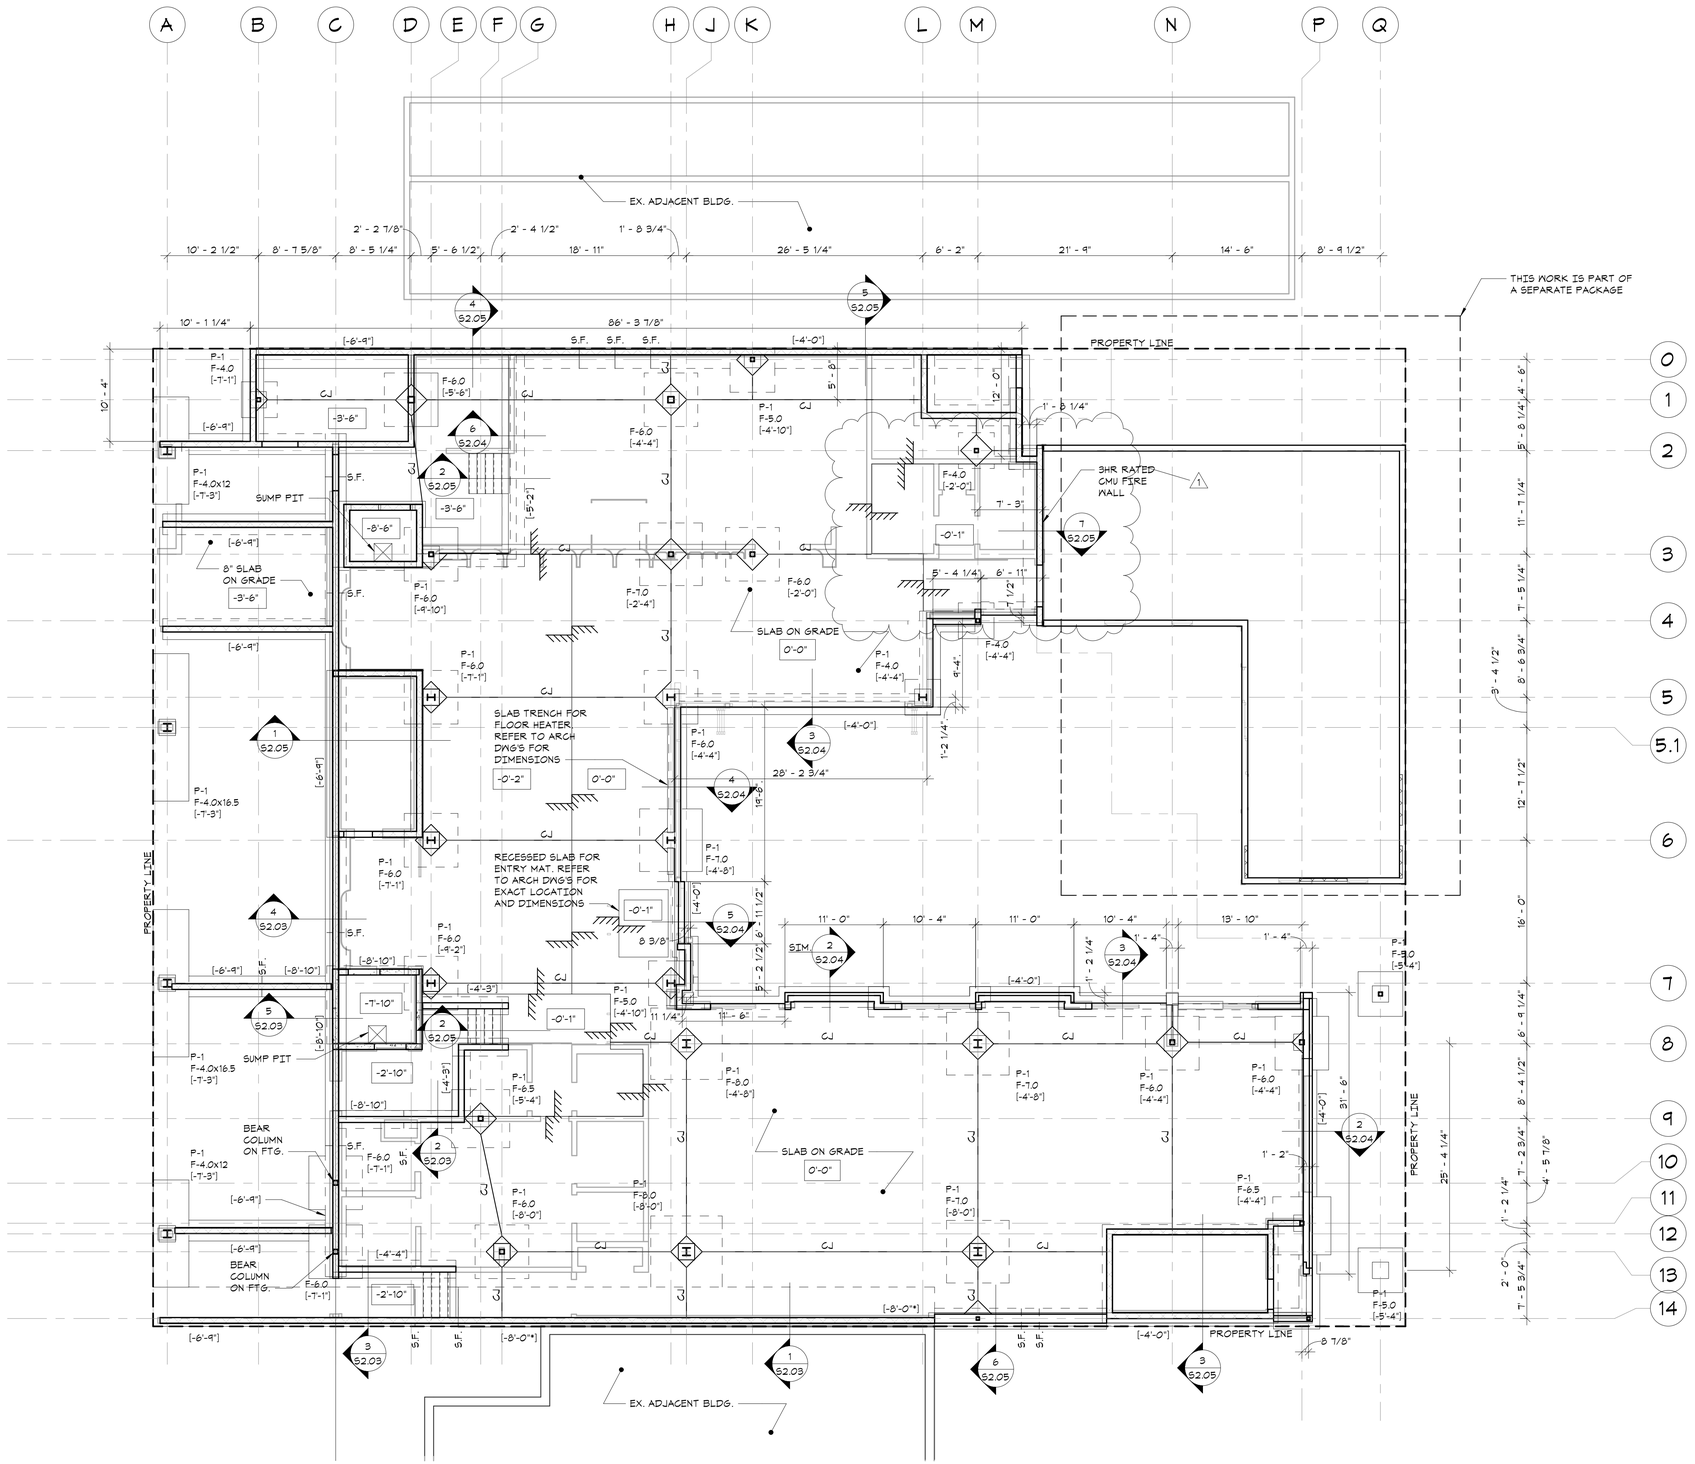

The Di Salvo Engineering Group
Structural Engineers
405 S. Wilcox Street, Ste 210
Castle Rock, CO 80104
[720] 667-3388 | www.tdeg.com
COLORADO LICENSED STEPHEN GLENN LEE 53653 PROFESSIONAL ENGINEER

HELTSHE

M1A | MERIDIAN 105 ARCHITECTURE

CITY HOTEL
415 PERRY STREET, CASTLE ROCK, CO.

DATE: 4/22/26
PROJ. NO. 24603.00

ISSUED FOR:
1 Re-Issued for Permit

SHEET TITLE: FOUNDATION & LEVEL 1 SLAB-ON-GRADE PLAN

SHEET NUMBER S1.01

C:\Users\james\Documents\24603_City Hotel_struct_tdeg.rvt
4/22/2026 1:15:10 PM

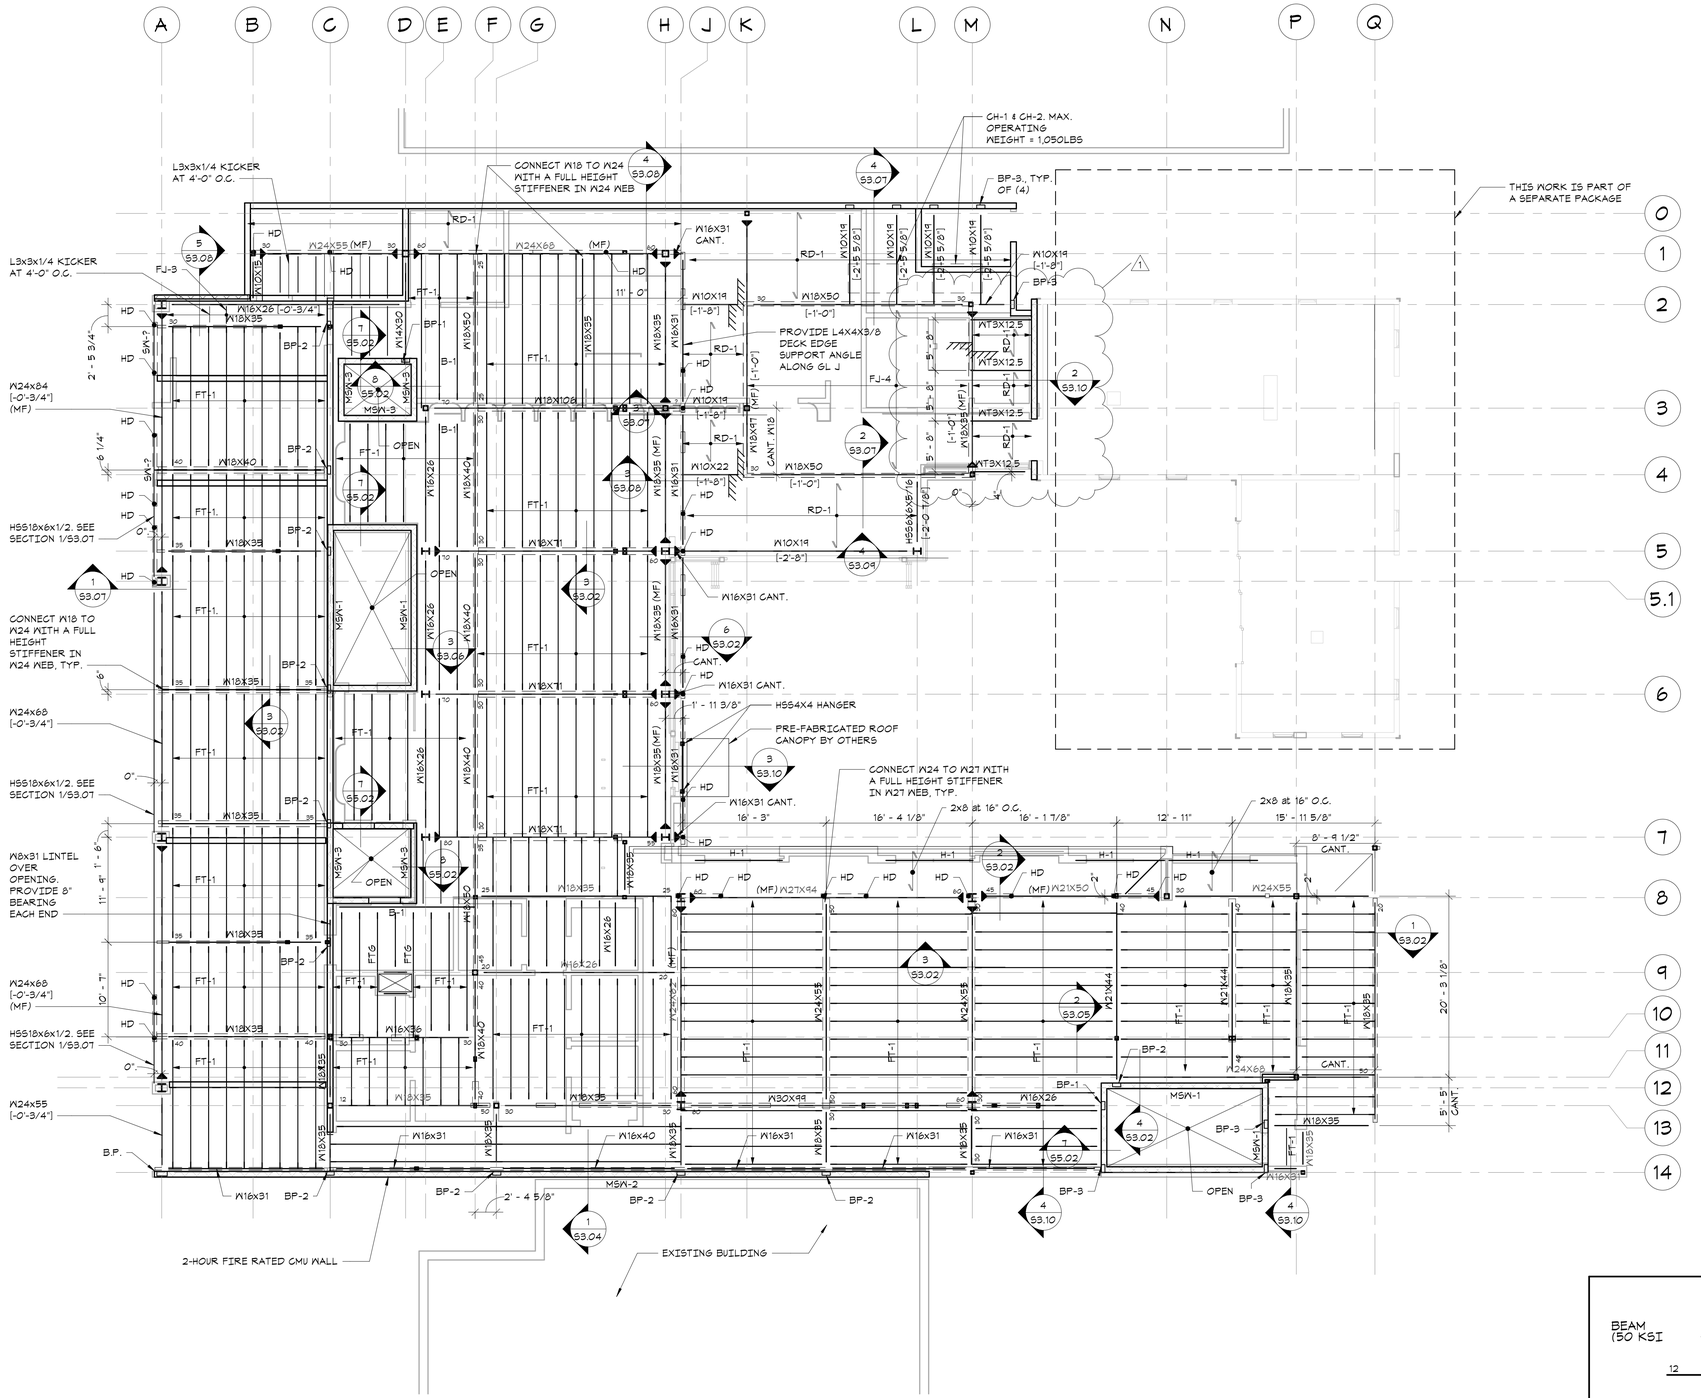

LEVEL 2 FRAMING PLAN

1/8"=1'-0"

NORTH:

- TOP OF LEVEL 2 FLOOR ELEVATION: 14'-0" ABOVE DATUM.
- TOP OF STEEL ELEVATION: 13'-8" UNLESS OTHERWISE NOTED THUS [+/-X'-XX"] FROM ELEVATION 13'-8".
- FLOOR CONSTRUCTION: 18" PRE-ENGINEERED OPEN WEB WOOD TRUSSES (DELEGATED DESIGN). FLOOR SHEATHING SHALL BE 3/4" TONGUE AND GROOVE WOOD SHEATHING PANELS. FOLLOW ALL MANUFACTURER'S RECOMMENDATIONS FOR BLOCKING, BRIDGING AND CANTILEVER ENDS.
- COORDINATE SIZE AND LOCATION OF ALL FLOOR PENETRATIONS WITH ARCHITECTURAL, MECHANICAL, AND ELECTRICAL DRAWINGS. ALL FLOOR PENETRATIONS SHALL BE REVIEWED BY THE ENGINEER PRIOR TO FABRICATION AND INSTALLATION OF PENETRATION FRAMING ELEMENTS. PROVIDE FRAMING AS INDICATED IN "TYPICAL ROOF/FLOOR OPENING DETAIL". DO NOT SCALE OPENINGS.
- "MSW" INDICATES CMU SHEARWALL. SEE PLAN FOR SIZE.
- "RD-1" INDICATES 3" DEEP, 20GA ROOF DECK. REFER TO GENERAL NOTES FOR MORE INFORMATION.
- "BP-#" INDICATES STEEL BEARING PLATE. REFER TO "STEEL BEARING PLATE SCHEDULE" ON DWG. S4.02
- FOR MASONRY SHEARWALL INFORMATION, SEE "TYPICAL CONCRETE MASONRY DETAILS" DRAWING.
- "MF" INDICATES MOMENT FRAME.
- ⊏ ⚌ ⊐ INDICATES BEARING/SHEAR WALL ABOVE
- SEE GENERAL NOTES FOR ADDITIONAL INFORMATION.

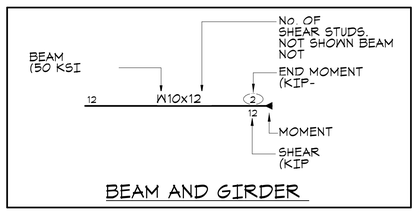

BEAM AND GIRDER

The Di Salvo Engineering Group
Structural Engineers
405 S. Wilcox Street, Ste 210
Castle Rock, CO 80104
[720] 667-3388 | www.tdeg.com
COLORADO LICENSED STEPHEN GLENN DISALVO 53653 PROFESSIONAL ENGINEER

HELTSHE

M1A | MERIDIAN 105 ARCHITECTURE

CITY HOTEL

415 PERRY STREET, CASTLE ROCK, CO.

DATE: 4/22/26
PROJ. NO. 24603.00

ISSUED FOR:
1 Re-Issued for Permit

SHEET TITLE: LVL2 FRAMING PLAN

SHEET NUMBER
S1.02

4/22/2026 1:15:13 PM
C:\Users\james\Documents\24603_City Hotel_struct_tdeg.rvt

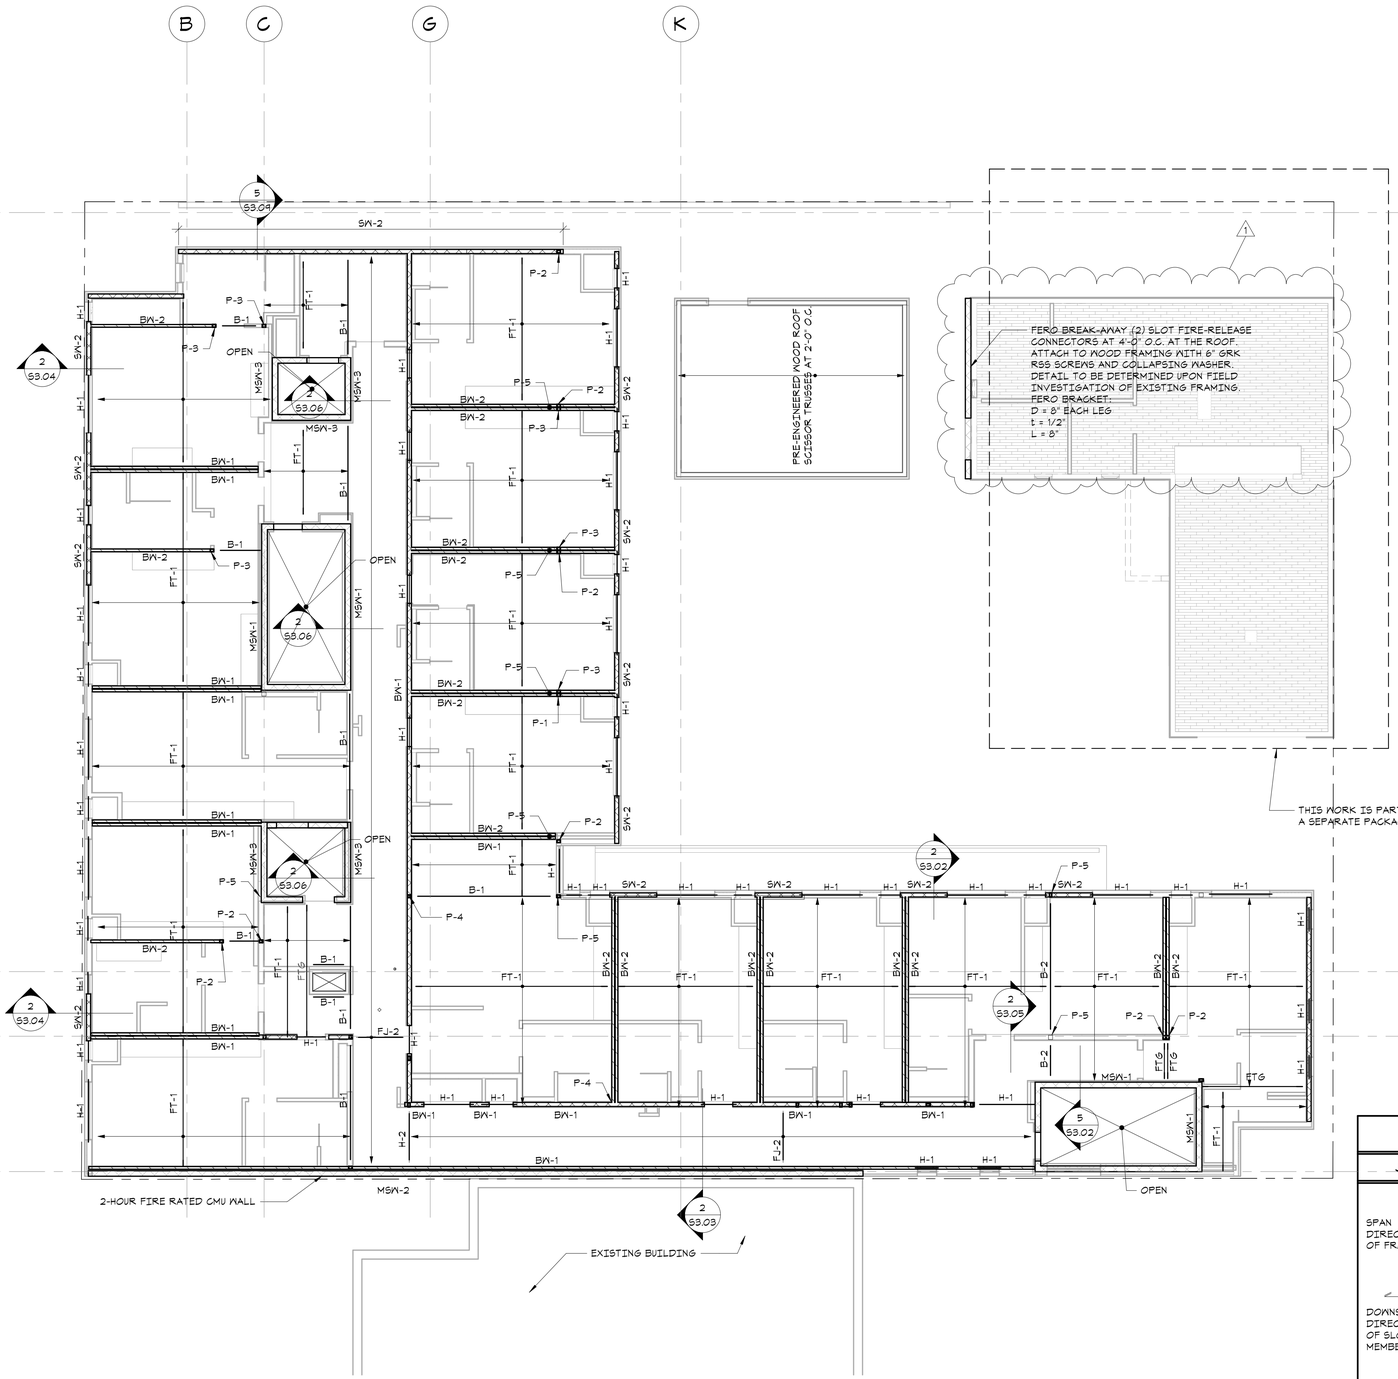

LEVEL 3 FRAMING PLAN

1/8"=1'-0"

NORTH:

- TOP OF LEVEL 3 FINISHED FLOOR ELEVATION: 25'-0" ABOVE DATUM.
- FLOOR CONSTRUCTION: 18" PRE-ENGINEERED OPEN WEB WOOD TRUSSES (DELEGATED DESIGN). FLOOR SHEATHING SHALL BE 3/4" TONGUE AND GROOVE WOOD SHEATHING PANELS. FOLLOW ALL MANUFACTURER'S RECOMMENDATIONS FOR BLOCKING, BRIDGING AND CANTILEVER ENDS.
- COORDINATE SIZE AND LOCATION OF ALL FLOOR PENETRATIONS WITH ARCHITECTURAL, MECHANICAL, AND ELECTRICAL DRAWINGS. ALL FLOOR PENETRATIONS SHALL BE REVIEWED BY THE ENGINEER PRIOR TO FABRICATION AND INSTALLATION OF PENETRATION FRAMING ELEMENTS. PROVIDE FRAMING AS INDICATED IN "TYPICAL ROOF/FLOOR OPENING DETAIL". DO NOT SCALE OPENINGS.
- "MSW" INDICATES CMU SHEARWALL. SEE PLAN FOR SIZE.
- FOR MASONRY SHEARWALL INFORMATION, SEE "TYPICAL CONCRETE MASONRY DETAILS" DRAWING.
- TRUSS MANUFACTURER TO DESIGN & SUPPLY ALL TRUSS-TO-TRUSS, TRUSS-TO-BEAM, & TRUSS-TO-GIRDER CONNECTIONS, TYP.
- REFER TO ARCH. DWG'S FOR BOTTOM CHORD OF ROOF SCISSOR TRUSS PROFILE.
- REFER TO GENERAL NOTES ON S0.00 FOR TRUSS DESIGN LOADS.
- BEARING WALL SCHEDULE:
  "BW-1" WALL FRAMING BELOW LEVEL. PROVIDE (1) 2X4 STUD ALIGNED WITH TRUSS BEARING.
  "BW-2" WALL FRAMING BELOW LEVEL. PROVIDE (2) 2X4 STUDS ALIGNED WITH TRUSS BEARING.
- SEE GENERAL NOTES FOR ADDITIONAL INFORMATION.

WOOD JOIST/HEADER SCHEDULE	
MARK	SIZE/SPACING
FT-1	18" DEEP PRE-ENGINEERED TRUSSES SPACED PER MANUF. (24" O.C. MAX.)
FTG	18" DEEP PRE-ENGINEERED GIRDER TRUSS
FJ-1	18" TJI 560 @ 12" O.C.
FJ-2	9 1/2" TJI 210 @ 16" O.C.
FJ-3	11 7/8" TJI 210 @ 16" O.C.
FJ-4	16" TJI 360 @ 12" O.C.
H-1	(2) 9 1/2" LVL HEADER
H-2	(3) 9 1/2" LVL HEADER
B-1	(2) - 1 3/4x18 LVL
B-2	(4) - 1 3/4x18 LVL
B-3	(3) - 1 3/4x18 LVL
DJ-1	14" TJI 210 @ 16" O.C
RT-1	18" DEEP PRE-ENGINEERED TRUSSES SPACED PER MANUF. (24" O.C. MAX.)
RTG	18" DEEP PRE-ENGINEERED GIRDER TRUSS
RJ-1	11 7/8" TJI 230 @ 16" O.C
RJ-2	11 7/8" TJI 230 @ 12" O.C
RJ-3	9 1/2" TJI 110 @ 16" O.C
RB-1	(2) - 1 3/4x11 7/8" LVL
RB-2	(3) - 1 3/4x11 7/8" LVL
RB-3	(4) - 1 3/4x14" LVL
RB-4	(3) - 1 3/4x16" LVL
RB-5	(4) - 1 3/4x16" LVL
RB-6	(2) - 1 3/4x16" LVL
RB-7	(2) - 1 3/4x9 1/2" LVL
RB-8	(2) - 1 3/4x9 1/2" LVL
RB-9	(4) - 1 3/4x11 7/8" LVL
RB-10	(3) - 1 3/4x14" LVL
	WOOD POST SCHEDULE
P-1	(2) - 2x4 STUDS
P-2	(3) - 2x4 STUDS
P-3	(4) - 2x4 STUDS
P-4	5 1/4" x 5 1/4" PSL POST
P-5	HSS4x4x1/4
P-6	5"x5" WOOD POST
P-7	(2) - 2x6 STUDS
P-8	(3) - 2x6 STUDS

FRAMING LEGEND		
JOISTS/RAFTERS	BEAM/HEADER	WOOD POSTS
SPAN DIRECTION OF FRAMING; EXTENT OF FRAMING; FRAMING MARK, SEE SCHED.; H-1; DOWNSLOPE DIRECTION OF SLOPING MEMBERS; DASHED WHERE BUILT OVER BY OTHER FRAMING	NO. OF PLIES IN BUILT-UP BEAM; BEAM SIZE { (3)-2x10 NBx10 9 1/2x11 7/8 LVL * }; TABS; 2B-# BEAM I.D.; BEAM REACTION (LBS); * SEE LAMINATED VENEER LUMBER (LVL) AND PARALLEL STRAND LUMBER (PSL) NOTE No.3.	■ POST DOWN ⊠ POST UP AND DOWN □ POST UP POST SHALL BE: (3)-2x4 MIN. IN 2x4 STUD WALL, U.O.N. IN SCHEDULE (2)-2x'S MATCHING STUD WALL THICKNESS MIN. IN STUD WALLS GREATER THAN 2x4, U.O.N.

The Di Salvo Engineering Group
Structural Engineers
405 S. Wilcox Street, Ste 210
Castle Rock, CO 80104
[720] 667-3388 | www.tdeg.com

COLORADO LICENSED STEPHEN GLENN FEHRIG 53653 PROFESSIONAL ENGINEER

HELTSHE

M1A | MERIDIAN 105 ARCHITECTURE

CITY HOTEL
415 PERRY STREET, CASTLE ROCK, CO.

DATE: 4/22/26
PROJ. NO. 24603.00

ISSUED FOR:
1 Re-Issued for Permit

SHEET TITLE: LVL3 FRAMING PLAN

SHEET NUMBER S1.03

C:\Users\james\Documents\24603_City Hotel_struct_tdeg.rvt
4/22/2026 1:15:16 PM

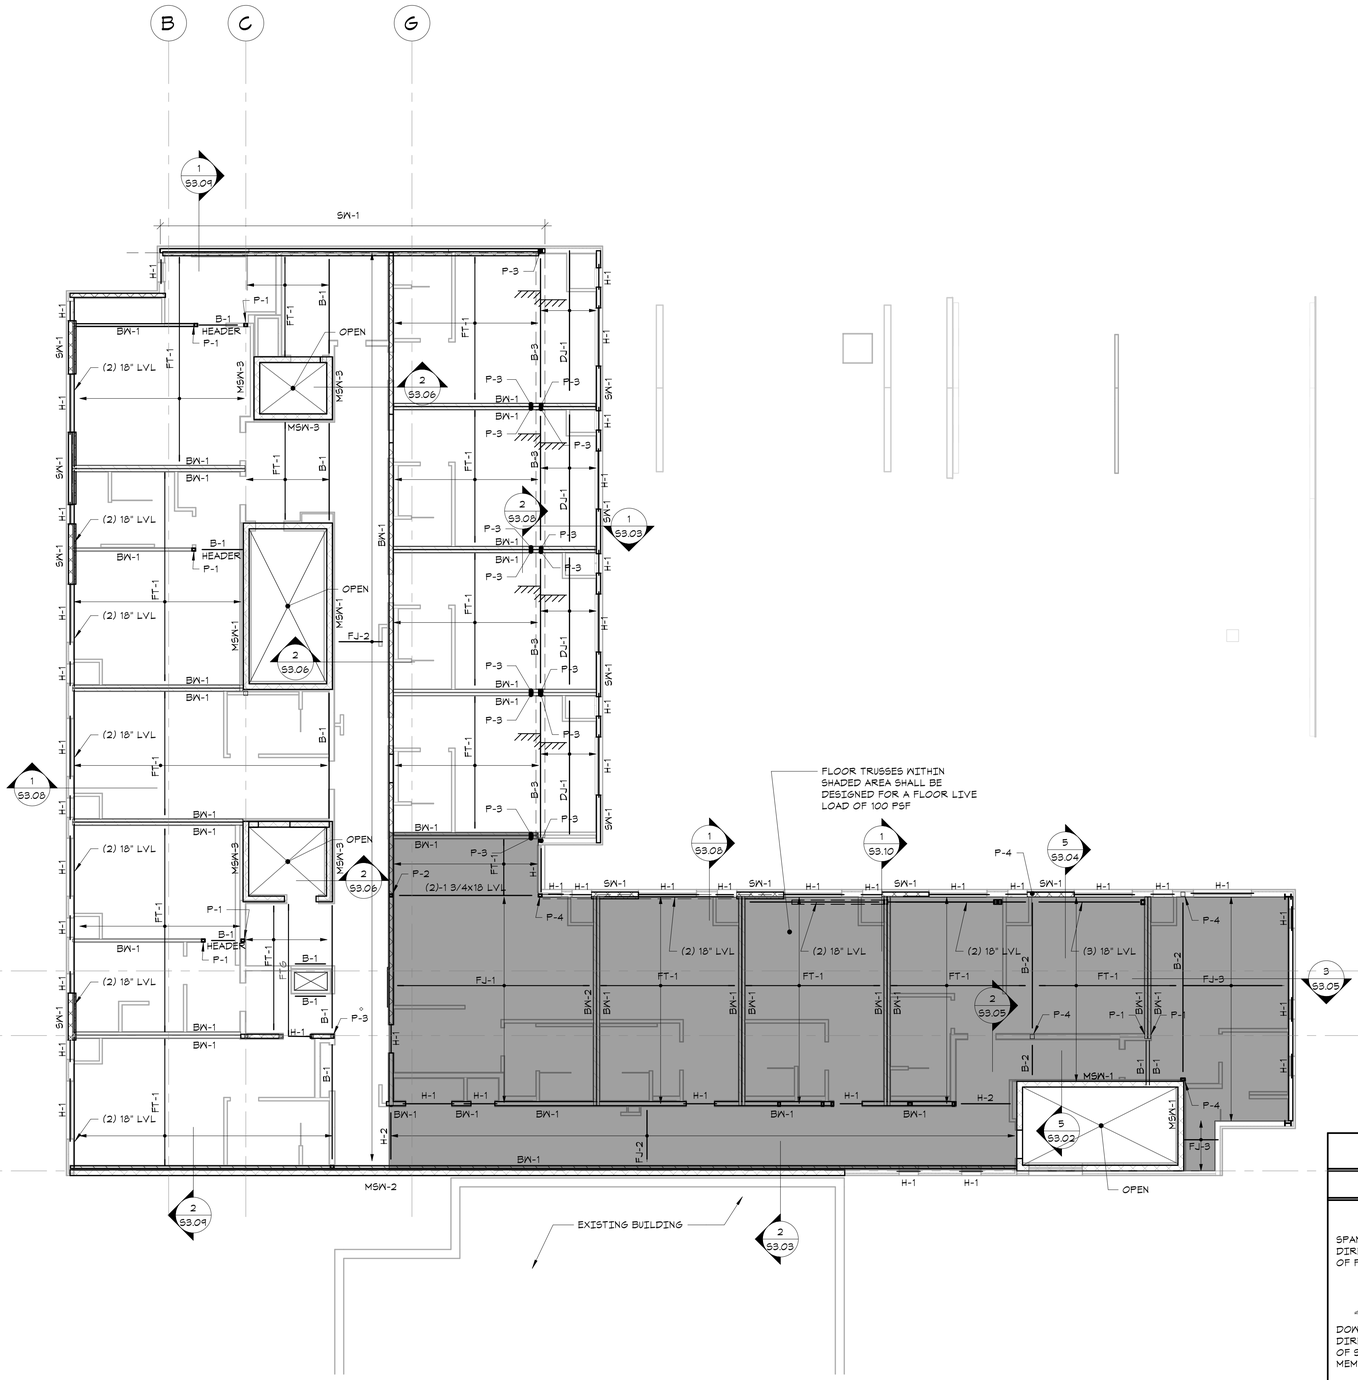

LEVEL 4 FRAMING PLAN

1/8"=1'-0"

NORTH:

- TOP OF LEVEL 4 FINISHED FLOOR ELEVATION: 36'-0" ABOVE DATUM.
- FLOOR CONSTRUCTION: 18" PRE-ENGINEERED OPEN WEB WOOD TRUSSES (DELEGATED DESIGN). FLOOR SHEATHING SHALL BE 3/4" TONGUE AND GROOVE WOOD SHEATHING PANELS. FOLLOW ALL MANUFACTURER'S RECOMMENDATIONS FOR BLOCKING, BRIDGING AND CANTILEVER ENDS.
- COORDINATE SIZE AND LOCATION OF ALL FLOOR PENETRATIONS WITH ARCHITECTURAL, MECHANICAL, AND ELECTRICAL DRAWINGS. ALL FLOOR PENETRATIONS SHALL BE REVIEWED BY THE ENGINEER PRIOR TO FABRICATION AND INSTALLATION OF PENETRATION FRAMING ELEMENTS. PROVIDE FRAMING AS INDICATED IN "TYPICAL ROOF/FLOOR OPENING DETAIL". DO NOT SCALE OPENINGS.
- "MSW" INDICATES CMU SHEARWALL. SEE PLAN FOR SIZE.
- FOR MASONRY SHEARWALL INFORMATION, SEE "TYPICAL CONCRETE MASONRY DETAILS" DRAWING.
- TRUSS MANUFACTURER TO DESIGN & SUPPLY ALL TRUSS-TO-TRUSS, TRUSS-TO-BEAM, & TRUSS-TO-GIRDER CONNECTIONS, TYP.
- REFER TO ARCH. DWG'S FOR BOTTOM CHORD OF ROOF TRUSS PROFILE.
- REFER TO GENERAL NOTES ON S0.00 FOR TRUSS DESIGN LOADS.
- BEARING WALL SCHEDULE:
  "BW-1" WALL FRAMING BELOW LEVEL. PROVIDE (1) 2X4 STUD ALIGNED WITH TRUSS BEARING.
  "BW-2" WALL FRAMING BELOW LEVEL. PROVIDE (2) 2X4 STUDS ALIGNED WITH TRUSS BEARING.
- ⊏ ⊐ ⊐ INDICATES BEARING/SHEAR WALL ABOVE
- SEE GENERAL NOTES FOR ADDITIONAL INFORMATION.

WOOD JOIST/HEADER SCHEDULE

MARK	SIZE/SPACING
FT-1	18" DEEP PRE-ENGINEERED TRUSSES SPACED PER MANUF. (24" O.C. MAX.)
FTG	18" DEEP PRE-ENGINEERED GIRDER TRUSS
FJ-1	18" TJI 560 @ 12" O.C.
FJ-2	9 1/2" TJI 210 @ 16" O.C.
FJ-3	11 7/8" TJI 210 @ 16" O.C.
FJ-4	16" TJI 360 @ 12" O.C.
H-1	(2) 9 1/2" LVL HEADER
H-2	(3) 9 1/2" LVL HEADER
B-1	(2) - 1 3/4x18 LVL
B-2	(4) - 1 3/4x18 LVL
B-3	(3) - 1 3/4x18 LVL
DJ-1	14" TJI 210 @ 16" O.C
RT-1	18" DEEP PRE-ENGINEERED TRUSSES SPACED PER MANUF. (24" O.C. MAX.)
RTG	18" DEEP PRE-ENGINEERED GIRDER TRUSS
RJ-1	11 7/8" TJI 230 @ 16" O.C
RJ-2	11 7/8" TJI 230 @ 12" O.C
RJ-3	9 1/2" TJI 110 @ 16" O.C
RB-1	(2) - 1 3/4x11 7/8" LVL
RB-2	(3) - 1 3/4x11 7/8" LVL
RB-3	(4) - 1 3/4x14" LVL
RB-4	(3) - 1 3/4x16" LVL
RB-5	(4) - 1 3/4x16" LVL
RB-6	(2) - 1 3/4x16" LVL
RB-7	(2) - 1 3/4x9 1/2" LVL
RB-8	(2) - 1 3/4x9 1/2" LVL
RB-9	(4) - 1 3/4x11 7/8" LVL
RB-10	(3) - 1 3/4x14" LVL
	WOOD POST SCHEDULE
P-1	(2) - 2x4 STUDS
P-2	(3) - 2x4 STUDS
P-3	(4) - 2x4 STUDS
P-4	5 1/4" x 5 1/4" PSL POST
P-5	HSS4x4x1/4
P-6	5"x5" WOOD POST
P-7	(2) - 2x6 STUDS
P-8	(3) - 2X6 STUDS

9

10

14

FRAMING LEGEND

JOISTS/RAFTERS

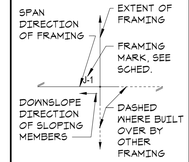

BEAM/HEADER

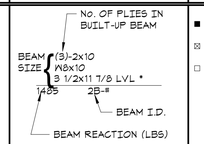

* SEE LAMINATED VENEER LUMBER (LVL) AND PARALLEL STRAND LUMBER (PSL) NOTE No.3.

WOOD POSTS

- ■ POST DOWN
- ⊠ POST UP AND DOWN
- □ POST UP

POST SHALL BE:

(3)-2x4 MIN. IN 2x4 STUD WALL, U.O.N. IN SCHEDULE

(2)-2x6 MATCHING STUD WALL THICKNESS MIN. IN STUD WALLS GREATER THAN 2x4, U.O.N.

The Di Salvo Engineering Group
Structural Engineers
405 S. Wilcox Street, Ste 210
Castle Rock, CO 80104
[720] 667-3388 | www.tdeg.com

COLORADO LICENSED STEPHEN GLENN TEHLIGH 53653 PROFESSIONAL ENGINEER

HELTSHE

M1A | MERIDIAN 105 ARCHITECTURE

CITY HOTEL

415 PERRY STREET, CASTLE ROCK, CO.

DATE: 4/22/26
PROJ. NO. 24603.00

ISSUED FOR:
1 Re-Issued for Permit

SHEET TITLE: LVL4 FRAMING PLAN

SHEET NUMBER S1.04

C:\Users\jamest\Documents\24603_City Hotel_struct_tdeg.rvt

4/22/2026 1:15:19 PM

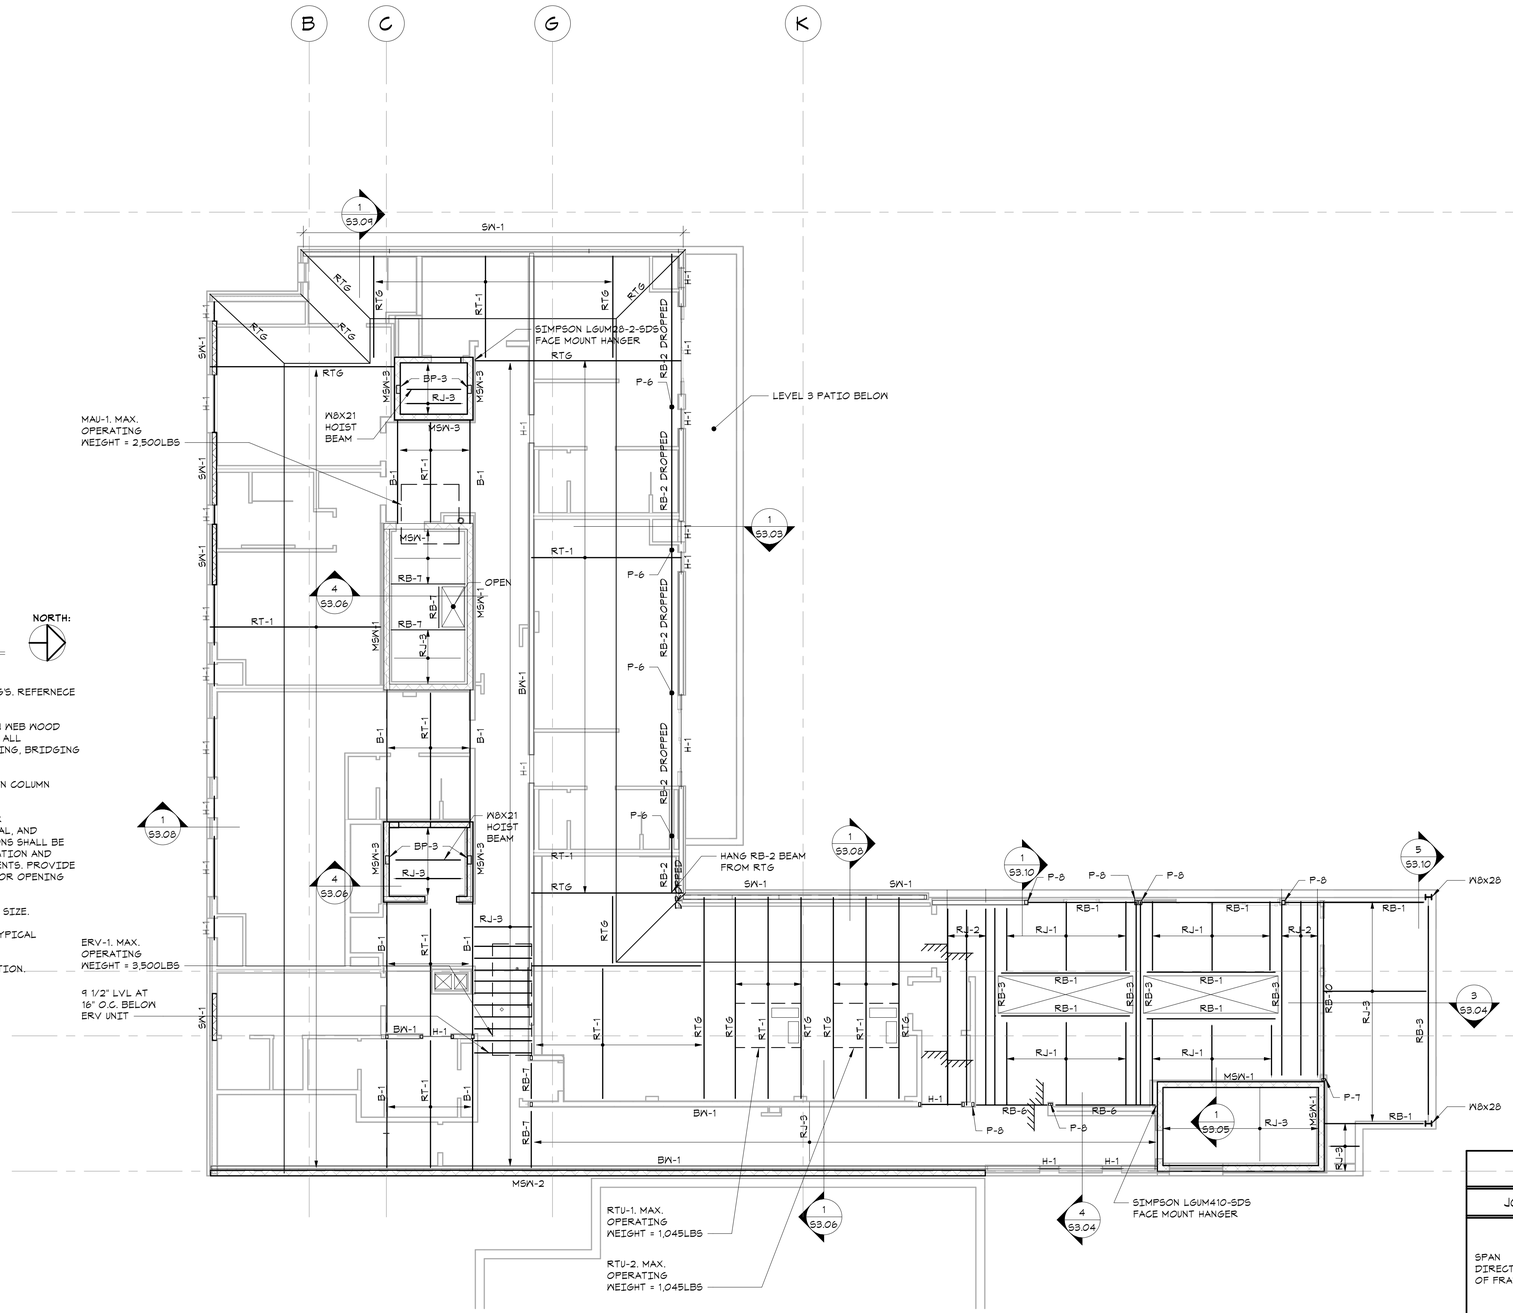

ROOF FRAMING PLAN

1/8"=1'-0"

NORTH:

- TOP OF ROOF ELEVATION VARIES: SEE ARCH DWG'S. REFERNECE IS 50'-0" ABOVE DATUM.
- ROOF CONSTRUCTION: 18" PRE-ENGINEERED OPEN WEB WOOD TRUSSES W/ 3/4" WOOD ROOF SHEATING. FOLLOW ALL MANUFACTURERS RECOMMENDATIONS FOR BLOCKING, BRIDGING AND CANTILEVER ENDS.
- ALL FRAMING SHALL BE EQUALLY SPACED BETWEEN COLUMN LINES, UNLESS OTHERWISE INDICATED.
- COORDINATE SIZE AND LOCATION OF ALL FLOOR PENETRATIONS WITH ARCHITECTURAL, MECHANICAL, AND ELECTRICAL DRAWINGS. ALL FLOOR PENETRATIONS SHALL BE REVIEWED BY THE ENGINEER PRIOR TO FABRICATION AND INSTALLATION OF PENETRATION FRAMING ELEMENTS. PROVIDE FRAMING AS INDICATED IN "TYPICAL ROOF/FLOOR OPENING DETAIL". DO NOT SCALE OPENINGS.
- "MSW" INDICATES CMU SHEARWALL. SEE PLAN FOR SIZE.
- FOR MASONRY SHEARWALL INFORMATION, SEE "TYPICAL CONCRETE MASONRY DETAILS" DRAWING.
- SEE GENERAL NOTES FOR ADDITIONAL INFORMATION.

WOOD JOIST/HEADER SCHEDULE	
MARK	SIZE/SPACING
FT-1	18" DEEP PRE-ENGINEERED TRUSSES SPACED PER MANUF. (24" O.C. MAX.)
FTG	18" DEEP PRE-ENGINEERED GIRDER TRUSS
FJ-1	18" TJI 560 @ 12" O.C.
FJ-2	9 1/2" TJI 210 @ 16" O.C.
FJ-3	11 7/8" TJI 210 @ 16" O.C.
FJ-4	16" TJI 360 @ 12" O.C.
H-1	(2) 9 1/2" LVL HEADER
H-2	(3) 9 1/2" LVL HEADER
B-1	(2) - 1 3/4x18 LVL
B-2	(4) - 1 3/4x18 LVL
B-3	(3) - 1 3/4x18 LVL
DJ-1	14" TJI 210 @ 16" O.C
RT-1	18" DEEP PRE-ENGINEERED TRUSSES SPACED PER MANUF. (24" O.C. MAX.)
RTG	18" DEEP PRE-ENGINEERED GIRDER TRUSS
RJ-1	11 7/8" TJI 230 @ 16" O.C
RJ-2	11 7/8" TJI 230 @ 12" O.C
RJ-3	9 1/2" TJI 110 @ 16" O.C
RB-1	(2) - 1 3/4x11 7/8" LVL
RB-2	(3) - 1 3/4x11 7/8" LVL
RB-3	(4) - 1 3/4x14" LVL
RB-4	(3) - 1 3/4x16" LVL
RB-5	(4) - 1 3/4x16" LVL
RB-6	(2) - 1 3/4x16" LVL
RB-7	(2) - 1 3/4x9 1/2" LVL
RB-8	(2) - 1 3/4x9 1/2" LVL
RB-9	(4) - 1 3/4x11 7/8" LVL
RB-10	(3) - 1 3/4x14" LVL
	WOOD POST SCHEDULE
P-1	(2) - 2x4 STUDS
P-2	(3) - 2x4 STUDS
P-3	(4) - 2x4 STUDS
P-4	5 1/4" x 5 1/4" PSL POST
P-5	HSS4x4x1/4
P-6	5"x5" WOOD POST
P-7	(2) - 2x6 STUDS
P-8	(3) - 2X6 STUDS

9

14 FRAMING LEGEND		
JOISTS/RAFTERS	BEAM/HEADER	WOOD POSTS
SPAN DIRECTION OF FRAMING EXTENT OF FRAMING FRAMING MARK, SEE SCHED. A-1 DASHED WHERE BUILT OVER BY OTHER FRAMING DOWNSLOPE DIRECTION OF SLOPING MEMBERS	No. OF PLIES IN BUILT-UP BEAM BEAM SIZE (3)-2x10 W8x10 3 1/2x11 7/8 LVL * 1@5 2@* BEAM I.D. BEAM REACTION (LBS) * SEE LAMINATED VENEER LUMBER (LVL) AND PARALLEL STRAND LUMBER (PSL) NOTE No.3.	■ POST DOWN ⊠ POST UP AND DOWN □ POST UP POST SHALL BE: (3)-2x4 MIN. IN 2x4 STUD WALL, U.O.N. IN SCHEDULE (2)-2X'S MATCHING STUD WALL THICKNESS MIN. IN STUD WALLS GREATER THAN 2x4, U.O.N.

The Di Salvo Engineering Group
Structural Engineers
405 S. Wilcox Street, Ste 210
Castle Rock, CO 80104
[720] 667-3388 | www.tdeg.com
COLORADO LICENSED
STEPHEN GLENN DISALVO
53653
PROFESSIONAL ENGINEER

HELTSHE

M1A | MERIDIAN 105 ARCHITECTURE

CITY HOTEL

415 PERRY STREET, CASTLE ROCK, CO.

DATE: 4/22/26
PROJ. NO. 24603.00

ISSUED FOR:
1 Re-Issued for Permit

SHEET TITLE: ROOF FRAMING PLAN

SHEET NUMBER S1.05

C:\Users\james\Documents\24603_City Hotel_struct_tdeg.rvt
4/22/2026 1:15:21 PM

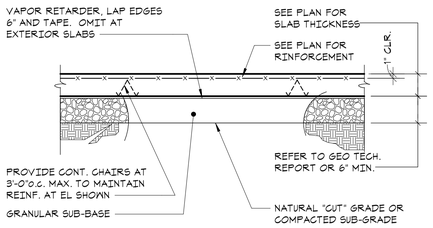

SLAB ON GRADE DETAIL

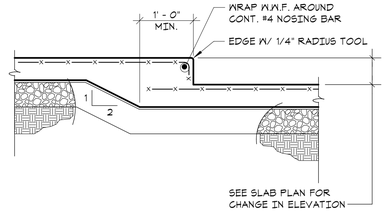

STEPPED SLAB DETAIL

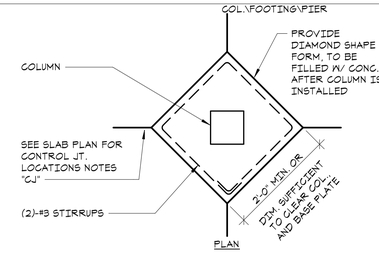

SLAB AT COLUMN DETAIL

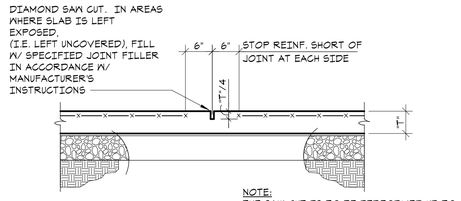

CONTROL JOINT DETAIL

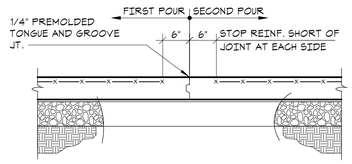

SLAB ON GRADE CONSTRUCTION JOINT DETAIL

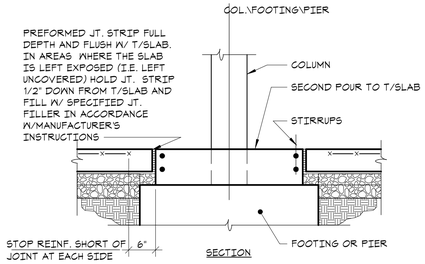

SLAB AT COLUMN DETAIL

① TYPICAL SLAB ON GRADE DETAIL

NO SCALE

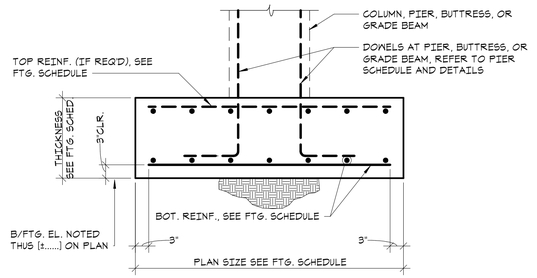

FOOTING SCHEDULE

(ALLOWABLE BEARING PRESSURE: 2500 PSF)

MARK	PLAN SIZE		THICKNESS	BOTTOM REINF.		REMARKS
	N-S	E-W		N-S	E-W	
F-4.0	4'-0"	4'-0"	1'-4"	(5)-#5	(5)-#5	
F-5.0	5'-0"	5'-0"	1'-4"	(6)-#5	(6)-#5	
F-6.0	6'-0"	6'-0"	1'-4"	(7)-#5	(7)-#5	
F-6.5	6'-6"	6'-6"	1'-4"	(8)-#5	(8)-#5	
F-7.0	7'-0"	7'-0"	1'-8"	(10)-#5	(10)-#5	
F-8.0	8'-0"	8'-0"	1'-8"	(7)-#7	(7)-#7	
F-4.0x14.0	14'-0"	4'-0"	1'-8"	(8)-#7	(10)-#7	
F-4.0x16.5	16'-6"	4'-0"	1'-8"	(8)-#7	(12)-#7	

NOTES:

1. REFER TO FOOTING DETAILS AND FOUNDATION NOTES IN USING THIS SCHEDULE.
2. "*" PROVIDE TOP REINFORCING IN ADDITION TO BOTTOM REINFORCING. TOP REINFORCING SHALL BE PLACED 2" CLEAR FROM TOP OF FOOTING AND SHALL BE EQUAL TO SIZE AND SPACING OF BOTTOM REINFORCING.

⑤ FOOTING SCHEDULE AND DETAIL

NO SCALE

The Di Salvo Engineering Group
Structural Engineers
405 S. Wilcox Street, Ste 210
Castle Rock, CO 80104
[720] 667-3388 | www.tdeg.com

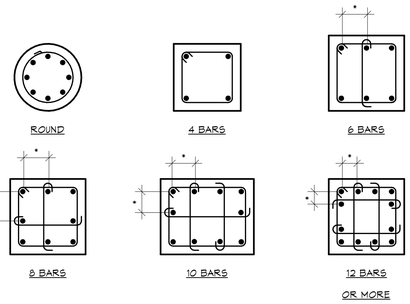

TYPICAL TIE ARRANGEMENT

"*" INDICATES WHEN 6" OR LESS OMIT INTERIOR TIE.

MAXIMUM SPACING OF TIES

VERTICAL BAR SIZE	SIZE AND SPACING OF TIES		
	#3	#4	#5
#5	10"	-	-
#6	12"	-	-
#7	14"	-	-
#8	16"	16"	-
#9	18"	18"	-
#10	18"	20"	-
#11	†	22"	22"
#14	†	24"	27"
#18	†	24"	30"

"*" INDICATES MAX. SPACING NOT TO EXCEED LEAST DIMENSION OF COMPRESSION MEMBER.

†INDICATES #3 TIES NOT PERMITTED.

NOTES:

1. THE VERTICAL BARS SHALL BE SPACED AROUND THE PERIMETER SO AS TO ACHIEVE APPROXIMATELY EQUAL SPACING.
2. SEE ARCHITECTURAL DRAWINGS FOR LOCATION AND EXTENT OF EXTERIOR DOORS.
3. TIES SHALL BE ARRANGED SUCH THAT EVERY CORNER AND ALTERNATE VERTICAL BAR SHALL HAVE LATERAL SUPPORT PROVIDED BY THE CORNER OF A TIE WITH AN INCLUDED ANGLE OF NOT MORE THAN 135 DEGREES AND NO BAR SHALL BE FURTHER THAN 6" CLEAR ON EACH SIDE ALONG THE TIE FROM SUCH A LATERALLY SUPPORTED BAR.
4. TIES SHALL BE LOCATED VERTICALLY NOT MORE THAN ONE-HALF A TIE SPACING ABOVE THE TOP OF FOOTING OR SLAB IN ANY STORY, AND SHALL BE SPACED AS PROVIDED HEREIN TO NOT MORE THAN ONE-HALF A TIE SPACING BELOW THE LOWEST HORIZONTAL REINFORCEMENT IN SLAB OR DROP PANEL ABOVE.
5. WHERE BEAMS OR BRACKETS FRAME FROM FOUR DIRECTIONS INTO A COLUMN, PIER OR BUTRESS, TERMINATION OF TIES NOT MORE THAN 3" BELOW REINFORCEMENT IN SHALLONEST OF SUCH BEAMS OR BRACKETS SHALL NOT BE PERMITTED.
6. SEE THE GENERAL NOTES ON DRAWING S1 FOR THE MINIMUM CONCRETE COVER REQUIREMENTS FOR REINFORCEMENT.
7. WHERE PIERS ARE ADJACENT TO FOUNDATION WALLS, PIERS ARE TO BE POURED MONOLITHICALLY WITH WALLS, PIER REINFORCING SHALL EXTEND WITHIN 2" OF OPPOSITE FACE WALL.

④ TYPICAL COLUMN, PIER AND BUTTRESS TIE DETAILS

NO SCALE

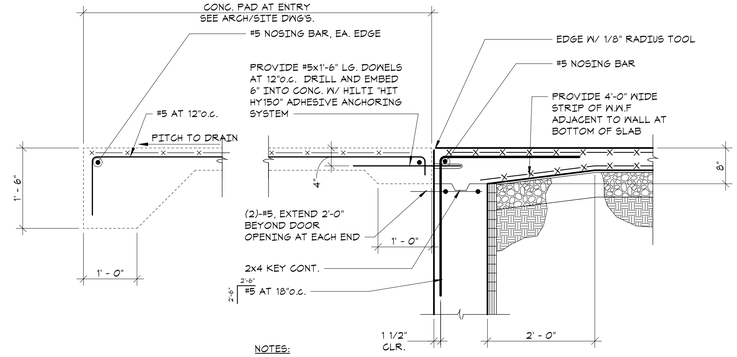

② TYPICAL FOUNDATION WALL DETAIL AT EXTERIOR DOORS

NO SCALE

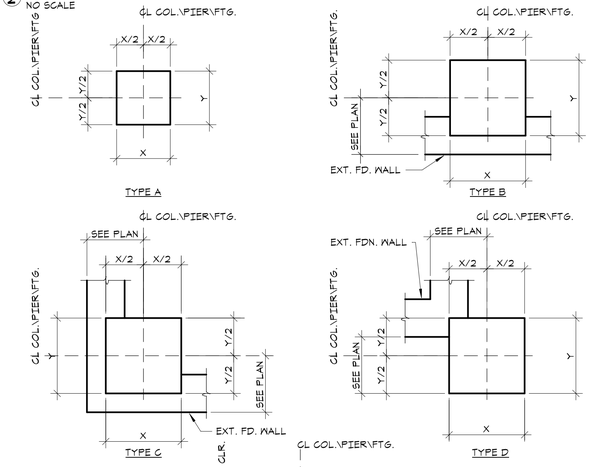

PIER SCHEDULE

MARK	TYPE	"X" E-W DIR.	"Y" N-S DIR.	VERTICAL REINF.	REMARKS
P-1	A	22"	1'-10"	(8)-#6	

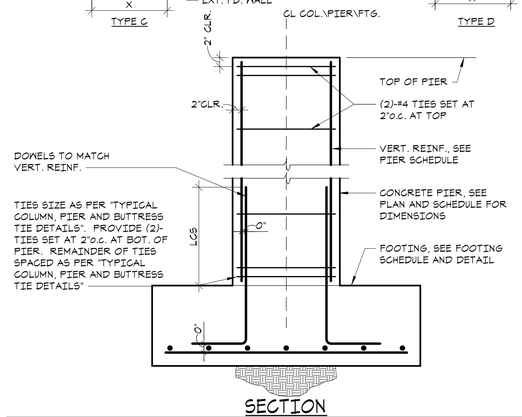

SECTION

③ TYPICAL PIER SCHEDULE AND PIER DETAILS

NO SCALE

HELTSHE

M1A | MERIDIAN 105 ARCHITECTURE

CITY HOTEL

415 PERRY STREET, CASTLE ROCK, CO.

DATE: 4/22/26

PROJ. NO. 24603.00

ISSUED FOR:
1 Re-Issued for Permit

SHEET TITLE: FOUNDATION SCHEDULES AND TYPICAL DETAILS

SHEET NUMBER S2.01

C:\Users\james\Documents\24603_City Hotel_struct_tdeg.rvt

4/22/2026 1:15:23 PM

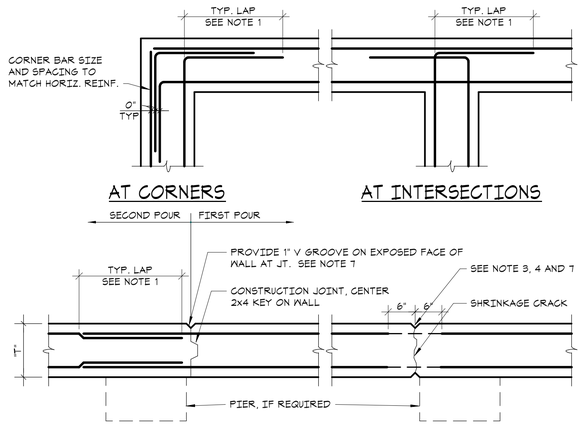

NOTES:

1. ALL BAR SPLICES SHALL BE CLASS "B" LAP SPLICES WITH 56 BAR DIAMETERS MINIMUM.
2. PROVIDE CONSTRUCTION JOINT AT END OF EACH DAY'S POUR. WALLS SHALL NOT BE POURED IN CONTINUOUS LENGTHS EXCEEDING 30 FEET WITHOUT PROVIDING CONSTRUCTION JOINTS OR CONTROL JOINS.
3. PROVIDE CONSTRUCTION/CONTROL JOINTS AT FACE OF PIERS UNLESS OTHERWISE NOTED ON PLAN.
4. AT CONTROL JOINT, PROVIDE BEVEL JOINT "T"/10 INTO WALL SURFACE BOTH SIDES. STOP ALTERNATING HORIZONTAL REINFORCING BARS 6" SHORT OF CONTROL JOINT.
5. SEE APPROPRIATE SECTION FOR WALL REINFORCEMENT.
6. VERTICAL REINFORCING AND/OR SUPPORT BARS NOT SHOWN FOR CLARITY.
7. PROVIDE CAULKING AT JOINT IF REQUIRED. SEE SPECIFICATIONS.

1 TYPICAL CONCRETE WALL CONSTRUCTION DETAIL

NO SCALE

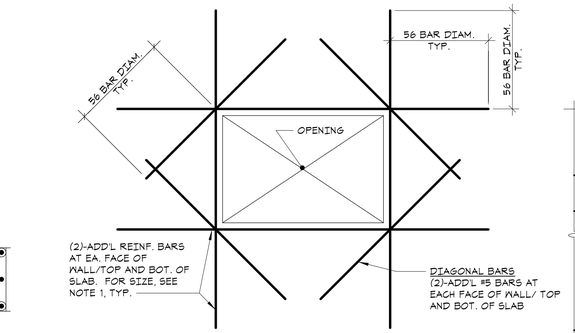

NOTES:

1. AT WALLS, ADDITIONAL REINFORCING SIZE SHALL MATCH HORIZONTAL AND VERTICAL REINFORCING. AT SLABS USE #5 BARS.
2. THIS DETAIL APPLIES AT ALL OPENINGS 12"X12" AND LARGER. DETAIL IS SIMILAR AT ALL CIRCULAR OPENINGS 12" AND LARGER.
3. COORDINATE ALL OPENING SIZES AND LOCATIONS WITH ARCHITECTURAL AND MECHANICAL DRAWINGS.

2 TYPICAL SLAB/WALL PENETRATION REINFORCING DETAIL

NO SCALE

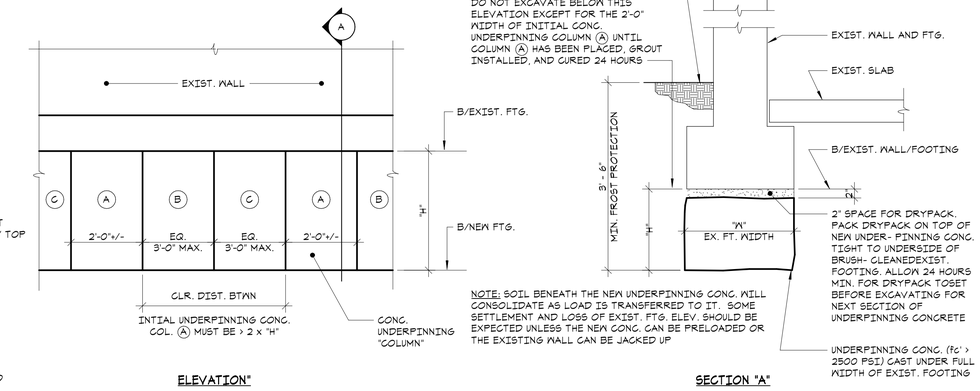

NOTE: SOIL BENEATH THE NEW UNDERPINNING CONC. WILL CONSOLIDATE AS LOAD IS TRANSFERRED TO IT. SOME SETTLEMENT AND LOSS OF EXIST. FTG. ELEV. SHOULD BE EXPECTED UNLESS THE NEW CONC. CAN BE PRELOADED OR THE EXISTING WALL CAN BE JACKED UP

ELEVATION" SECTION "A"

ADDITIONAL CONCRETE "COLUMN" "D, E, F..." MAY BE REQUIRED DEPENDING ON HEIGHT "H".

UNDERPINNING NOTES:

1. THIS DETAIL IS INTENDED TO BE USED WHEN SOIL CONDITIONS ARE CONDUCIVE TO UNDERPINNING, i.e. DENSE GRANULAR OR GRAVELLY SOILS OR STIFF COHESIVE SOILS. IF SOILS OTHER THAN THESE, SUCH AS LOOSE SANDS, SOFT CLAYS, OR FILL ARE ENCOUNTERED, CONTACT THE ENGINEER FOR ALTERNATE INSTRUCTIONS TO BE TAILORED TO THE SPECIFIC CONDITIONS ENCOUNTERED.
2. THE TECHNIQUE CONSISTS OF DIGGING SOIL FROM BENEATH THE EXISTING WALL/FOOTING AND REPLACING IT WITH CONCRETE IN SECTIONS OR COLUMNS, ONE AT A TIME, IN SEQUENCE "A", THEN "B", THEN "C"...; DOWN TO THE NEW PROPOSED BOTTOM OF FOOTING ELEVATION.
3. INITIAL EXCAVATION IS DOWN TO BOTTOM OF EXISTING FOUNDATION. EXCAVATION FOR UNDERPINNING COLUMN (A) MAY THEN BEGIN. ONCE THE UNDERPINNING CONCRETE IS CAST AND DRYPACKEDSOLID TO BOTTOM OF EXISTING FOOTING, AND CURED 24 HOURS, THEN EXCAVATION FOR COLUMN B MAY COMMENCE, ETC.
4. JACKING TO A TBD PROOF LOAD AND SHIMMING WITH STEEL SHIMS MAY BE REQUIRED AS DETERMINED BY THE ENGINEER AT THE TIME OF CONSTRUCTION. THIS DETAIL IS PRELIMINARY, CONSULT ENGINEER PRIOR TO UNDERPINNING FOR FINAL UNDERPINNING DESIGN AND SEQUENCE.

6 TYPICAL UNDERPINING DETAIL AND PROCEDURE

NO SCALE

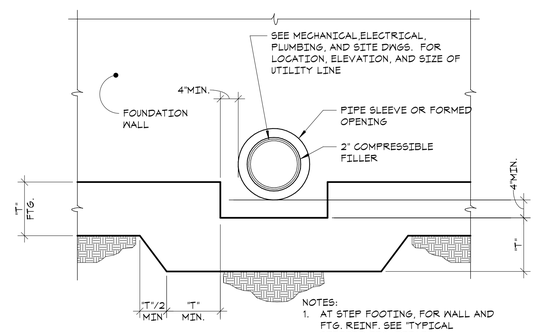

NOTES:

1. AT STEP FOOTING, FOR WALL AND FTG. REINF. SEE "TYPICAL STEPPED FTG. DETAIL.
2. IF REQUIRED, FOR ADD'L WALL REINF. SEE "TYPICAL SLAB/WALL PENETRATION REINF. DETAIL.

4 TYPICAL STEP FOOTING DETAIL AT WALL PIPE PENETRATION

NO SCALE

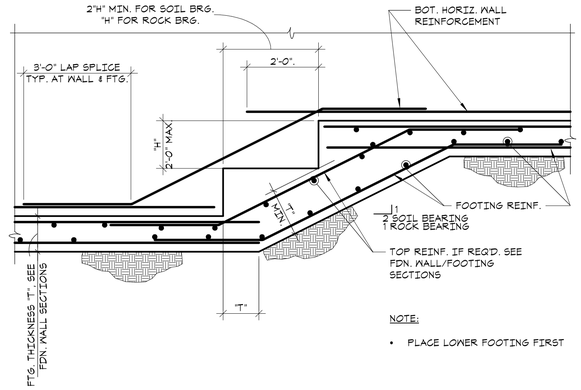

NOTE:

- PLACE LOWER FOOTING FIRST

3 TYPICAL STEPPED FOOTING DETAIL

NO SCALE

SCHEDULE OF EMBEDMENT AND SPLICE LENGTH

BAR SIZE	COMPRESSION		TENSION (f'c = 3000 psi)								TENSION (f'c = 4000 psi)							
	EMBED. LENGTH	LAP SPLICE LENGTH	EMBEDMENT LENGTH				LAP SPLICE LENGTH				EMBEDMENT LENGTH				LAP SPLICE LENGTH			
			TOP BARS		OTHER BARS		TOP BARS		OTHER BARS		TOP BARS		OTHER BARS		TOP BARS		OTHER BARS	
			CATEGORY SEE NOTE 1		CATEGORY SEE NOTE 1		CATEGORY SEE NOTE 1		CATEGORY SEE NOTE 1		CATEGORY SEE NOTE 1		CATEGORY SEE NOTE 1		CATEGORY SEE NOTE 1		CATEGORY SEE NOTE 1	
			I	II	I	II	I	II	I	II	I	II	I	II	I	II	I	II
#3	9"	12"	22"	33"	17"	25"	29"	43"	23"	33"	19"	28"	15"	22"	25"	37"	20"	29"
#4	11"	15"	29"	43"	22"	33"	38"	56"	29"	43"	25"	37"	19"	29"	33"	49"	25"	38"
#5	14"	19"	36"	54"	28"	42"	47"	71"	37"	55"	31"	47"	24"	36"	41"	62"	32"	47"
#6	17"	23"	43"	65"	33"	50"	56"	85"	43"	65"	37"	56"	29"	43"	49"	73"	38"	56"
#7	20"	27"	63"	94"	48"	72"	82"	123"	63"	94"	54"	81"	42"	63"	71"	106"	55"	82"
#8	22"	30"	72"	107"	55"	83"	94"	140"	72"	108"	62"	93"	48"	72"	81"	121"	63"	94"
#9	25"	34"	81"	121"	62"	93"	106"	158"	81"	121"	70"	105"	54"	81"	91"	137"	71"	106"
#10	28"	38"	91"	136"	70"	105"	118"	177"	91"	137"	78"	118"	61"	91"	103"	154"	80"	119"
#11	31"	43"	101"	151"	78"	116"	132"	197"	102"	151"	87"	131"	67"	101"	114"	171"	88"	132"
#14	38"	NP	121"	181"	93"	140"	NP	NP	NP	NP	105"	157"	81"	121"	NP	NP	NP	NP
#18	50"	NP	161"	242"	124"	186"	NP	NP	NP	NP	140"	209"	108"	161"	NP	NP	NP	NP
SEE NOTE 2	LCE	LCS	LTE				LTS				LTE				LTS			

NOTES:

1. THIS SCHEDULE INCLUDES EMBEDMENT AND SPLICE LENGTHS AS PER ACI 318-02 AND SATISFY THE PROJECT REQUIREMENTS AND THE FOLLOWING CRITERIA. SPECIFIED YIELD STRENGTH OF REINFORCEMENT, f_y = 60,000 psi NORMAL WEIGHT CONCRETE, w_c = 150 pcf. TENSION EMBEDMENT AND LAP SPLICE LENGTHS ARE DIVIDED INTO TWO CATEGORIES WHICH SHALL BE APPLIED AS FOLLOWS: CATEGORY 1: CLEAR SPACING OF BARS BEING DEVELOPED OR SPLICED NOT LESS THAN THE BAR DIAMETER, CLEAR COVER NOT LESS THAN THE BAR DIAMETER, AND STIRRUPS OR TIES THROUGHOUT THE DEVELOPMENT NOT LESS THAN THE CODE MINIMUM; OR, CLEAR SPACING OF BARS BEING DEVELOPED OR SPLICED, NOT LESS THAN 2x THE BAR DIAMETER AND CLEAR COVER NOT LESS THAN THE BAR DIAMETER. CATEGORY 2: ALL OTHER CASES.
2. NOTATION USED IN SECTION AND DETAILS FOR VARIOUS EMBEDMENT AND SPLICE LENGTH REREQUIREMENTS.
3. USE COMPRESSION LAP SPLICE LENGTH (LCS) AT ALL COMPRESSION MEMBER SPLICE LOCATIONS NOT SPECIFICALLY DETAILED AND UNLESS INDICATED OTHERWISE ON PLANS OR DETAILS. USE TENSION SPLICE FOR ALL OTHER SPLICES (UNLESS OTHERWISE NOTED ON DWGS).
4. THE STANDARD COMPRESSION LAP SPLICE IS (0.0005 x REINFORCED YIELD STRENGTH x THE BAR DIAMETER). THE STANDARD TENSION LAP SPLICE CLASS B IS 1.3 x THE DEVELOPMENT LENGTH. THE CONTRACTOR MAY SUBMIT LESSER SPLICE LENGTHS FOR REVIEW AND APPROVAL AT THE SAME TIME PROVIDING THE FOLLOWING INFORMATION.
   A DETAILS PREPARED AND SUBMITTED BY THE CONTRACTOR INDICATING LOCATION AND PROPOSED LAYOUT OF REBARS AND LENGTH OF SPLICES.
   B WHERE THE SIZE AND NUMBER OF TIES OR SPIRALS PERMITS THE REDUCTION OF LAP LENGTH, THOSE BARS SHALL BE INDICATED ON THE DETAILS.
   C WHERE COMPUTED STRESS VALUES PERMIT THE REDUCTION OF LAP LENGTH, COMPUTATIONS SHALL BE SUBMITTED FOR REVIEW.
   D THE APPLICABLE SECTION OF THE ACI 318-95 CODE PERMITTING THE LESSER SPLICE LENGTH SHALL BE INDICATED ON THE SUBMITTED MATERIAL.
5. TOP BARS ARE HORIZONTAL BARS PLACED SO THAT MORE THAN 12" OF CONCRETE IS CAST ON THE MEMBER BELOW THE BAR.
6. WHERE BARS OF DIFFERENT SIZE ARE TO BE SPLICED, THE SPLICE LENGTH FOR ALL BARS SHALL BE THAT REQUIRED FOR THE LARGEST.
7. "NP" INDICATES NOT PERMITTED. BARS LARGER THAN NO. 11 SHALL NOT BE SPLICED EXCEPT AS FOLLOWS: TO #11 BARS IN COMPRESSION. USE LARGER OF THE DEVELOPMENT LENGTH OF THE LARGER BAR OR THE SPLICE LENGTH OF THE SMALLER BAR (51" FOR #14 AND 68" FOR #18).

7 SCHEDULE OF EMBEDMENT AND SPLICE LENGTH

NO SCALE

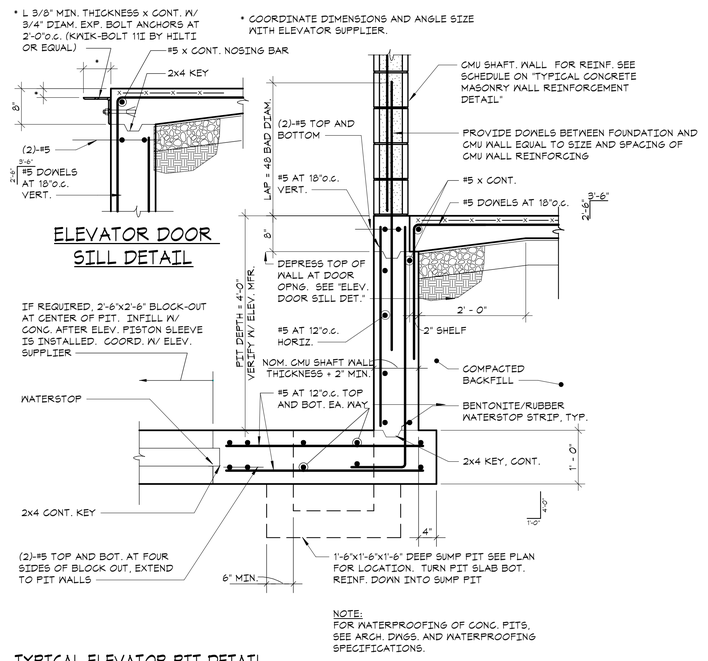

NOTE:
FOR WATERPROOFING OF CONC. PITS, SEE ARCH. DWGS. AND WATERPROOFING SPECIFICATIONS.

5 TYPICAL ELEVATOR PIT DETAIL

NO SCALE

The Di Salvo Engineering Group
Structural Engineers
405 S. Wilcox Street, Ste 210
Castle Rock, CO 80104
[720] 667-3388 | www.tdeg.com

COLORADO LICENSED STEPHEN GLENN HELTSHE 53653 PROFESSIONAL ENGINEER

HELTSHE

M1A | MERIDIAN 105 ARCHITECTURE

CITY HOTEL

415 PERRY STREET, CASTLE ROCK, CO.

DATE: 4/22/26
PROJ. NO. 24603.00

ISSUED FOR:
1 Re-Issued for Permit

SHEET TITLE: FOUNDATION SCHEDULES AND TYPICAL DETAILS

SHEET NUMBER
S2.02

C:\Users\james\Documents\24603_City Hotel_struct_tdeg.rvt
4/22/2026 1:15:25 PM

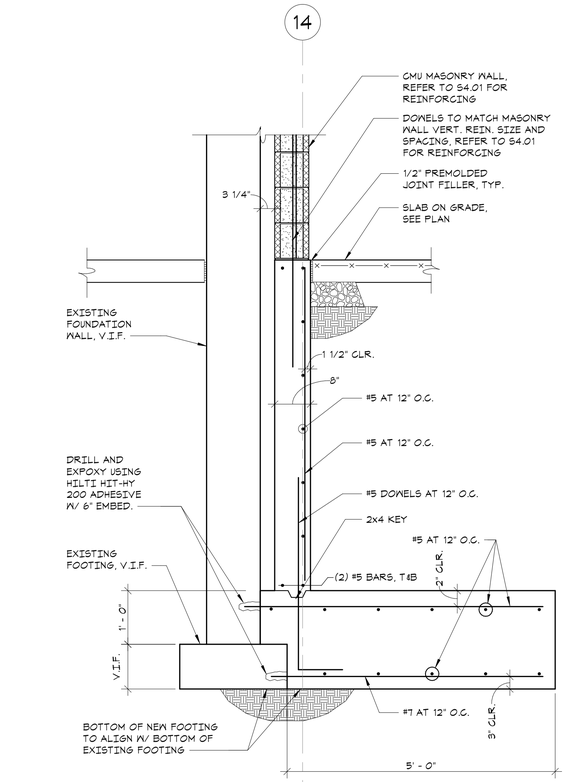

1 SECTION
3/4" = 1'-0"

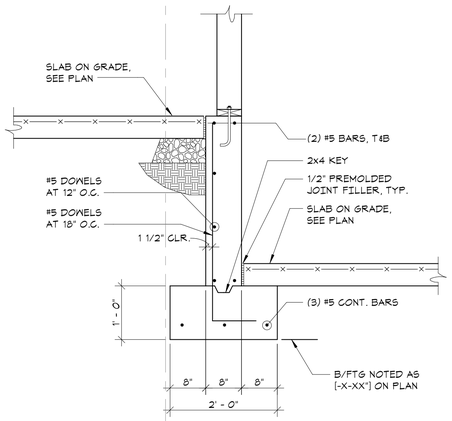

2 SECTION
3/4" = 1'-0"

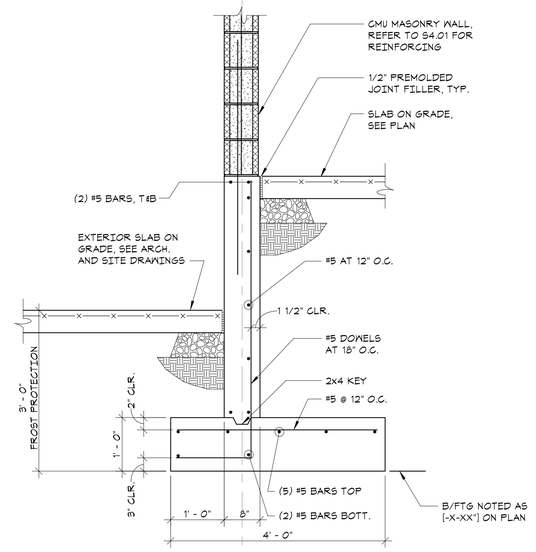

4 SECTION
3/4" = 1'-0"

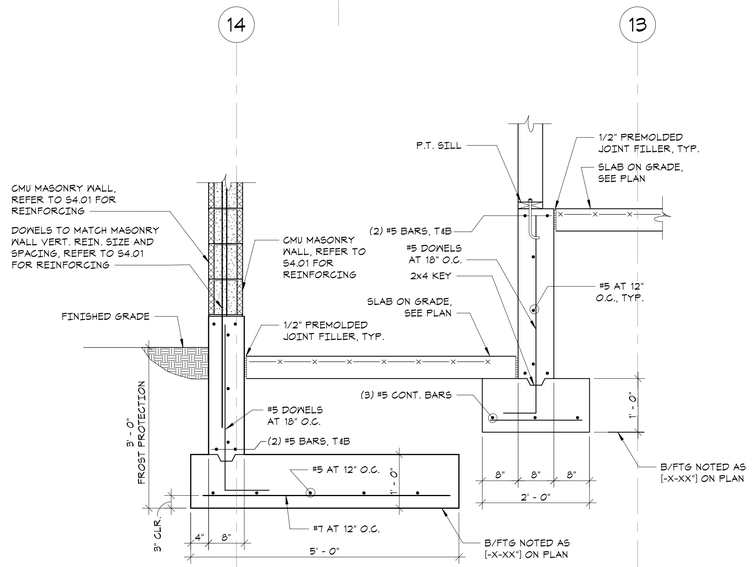

3 SECTION
3/4" = 1'-0"

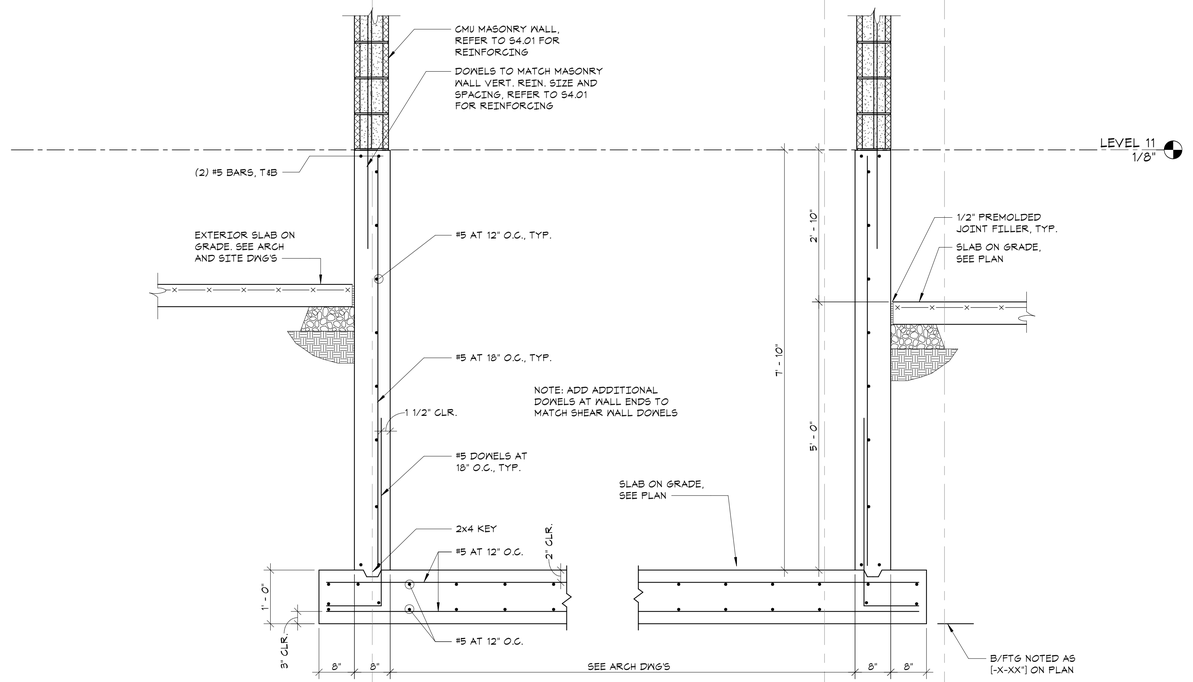

5 SECTION
3/4" = 1'-0"

The Di Salvo Engineering Group
Structural Engineers
405 S. Wilcox Street, Ste 210
Castle Rock, CO 80104
[720] 667-3388 | www.tdeg.com

COLORADO LICENSED STEPHEN GLENN LEE PROFESSIONAL ENGINEER

HELTSHE

M1A | MERIDIAN 105 ARCHITECTURE

CITY HOTEL
415 PERRY STREET, CASTLE ROCK, CO.

DATE: 4/22/26
PROJ. NO. 24603.00

ISSUED FOR:
1 Re-Issued for Permit

SHEET TITLE: FOUNDATION SECTIONS

SHEET NUMBER
S2.03

C:\Users\james\Documents\24603_City Hotel_struct_tdeg.rvt
4/22/2026 1:15:27 PM

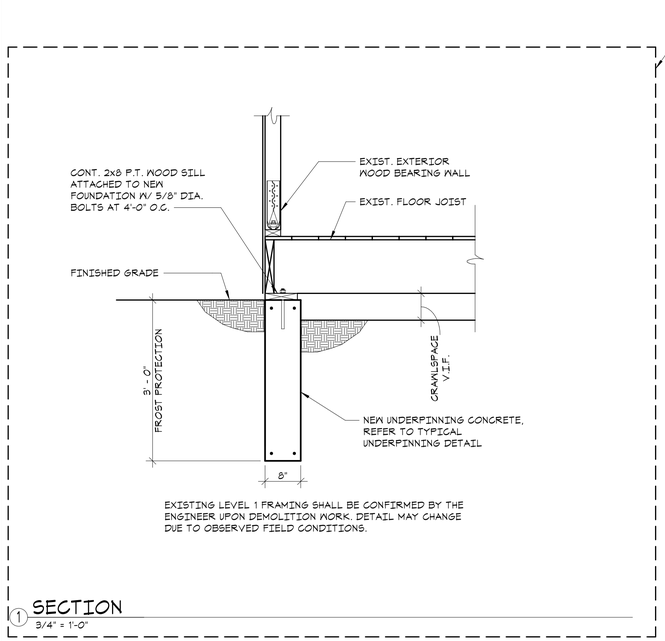

1 SECTION
3/4" = 1'-0"

P

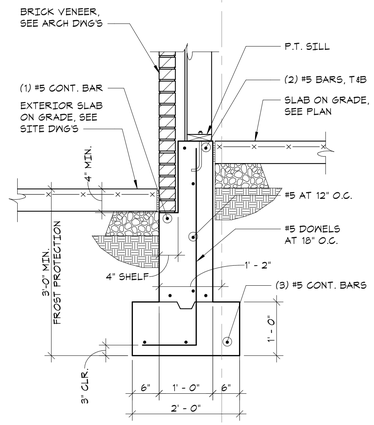

2 SECTION
3/4" = 1'-0"

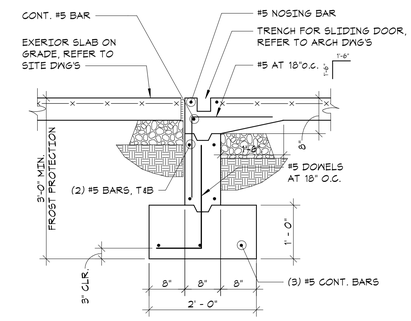

3 SECTION
3/4" = 1'-0"

H

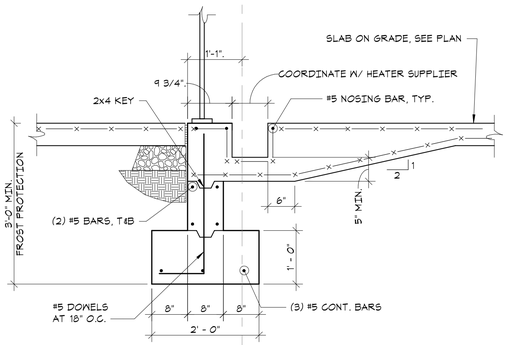

4 SECTION
3/4" = 1'-0"

H

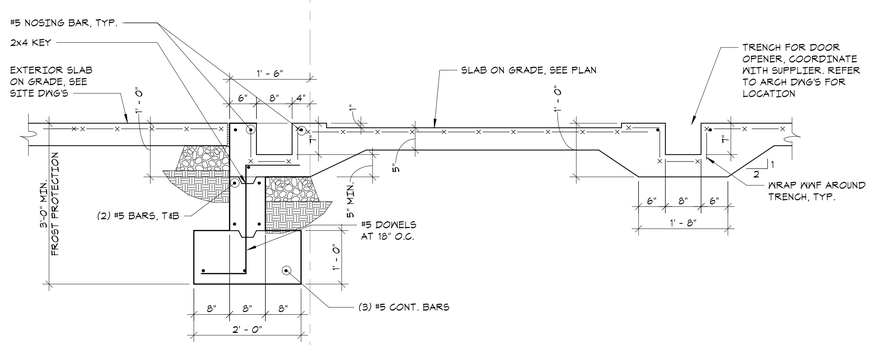

5 SECTION
3/4" = 1'-0"

G

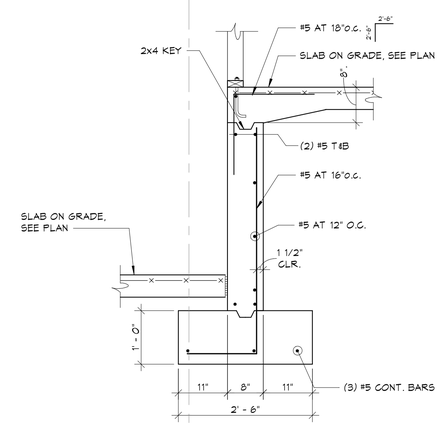

6 SECTION
3/4" = 1'-0"

The Di Salvo Engineering Group
Structural Engineers
405 S. Wilcox Street, Ste 210
Castle Rock, CO 80104
[720] 667-3388 | www.tdeg.com

COLORADO LICENSED STEPHEN GLENN LEHIGH 53653 PROFESSIONAL ENGINEER

HELTSHE

M1A | MERIDIAN 105 ARCHITECTURE

CITY HOTEL
415 PERRY STREET, CASTLE ROCK, CO.

DATE: 4/22/26
PROJ. NO. 24603.00

ISSUED FOR:
1 Re-Issued for Permit

SHEET TITLE: FOUNDATION SECTIONS

SHEET NUMBER
S2.04

C:\Users\james\Documents\24603_City Hotel_struct_tdeg.rvt
4/22/2026 1:15:28 PM

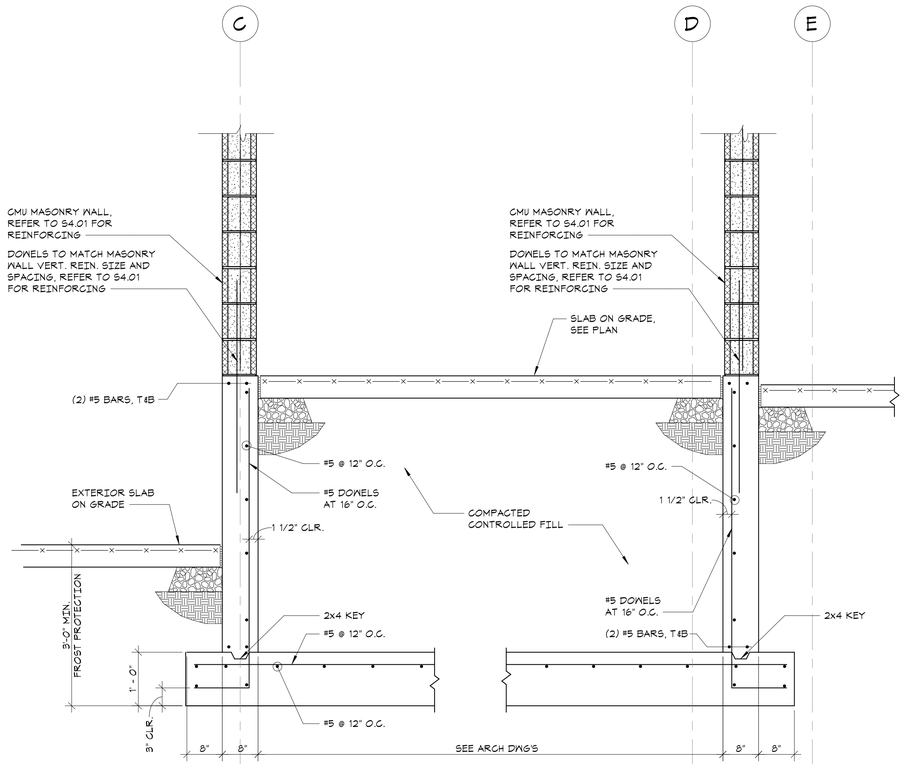

1 SECTION
3/4" = 1'-0"

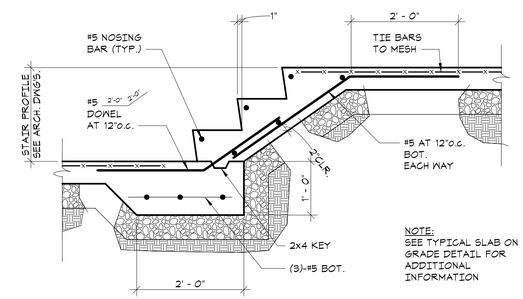

2 SECTION
3/4" = 1'-0"

NOTE:
SEE TYPICAL SLAB ON GRADE DETAIL FOR ADDITIONAL INFORMATION

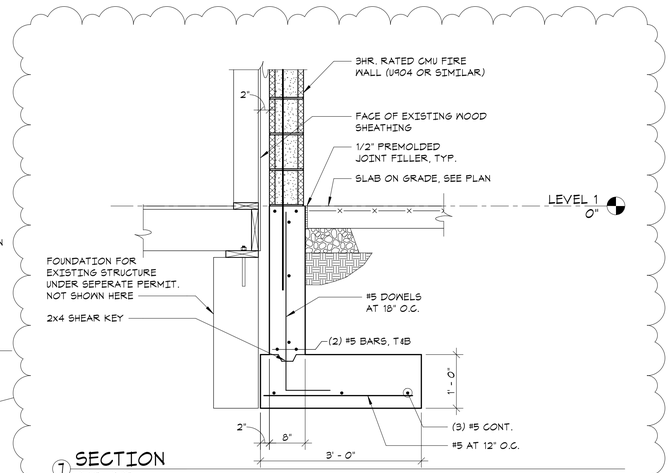

7 SECTION
3/4" = 1'-0"

14

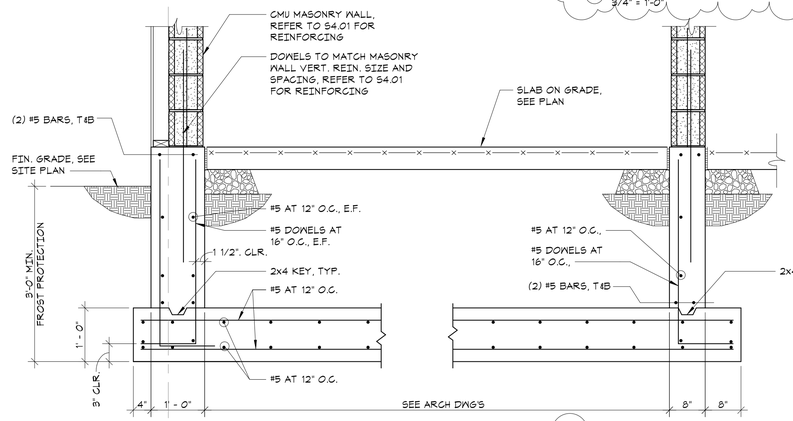

3 SECTION
3/4" = 1'-0"

14

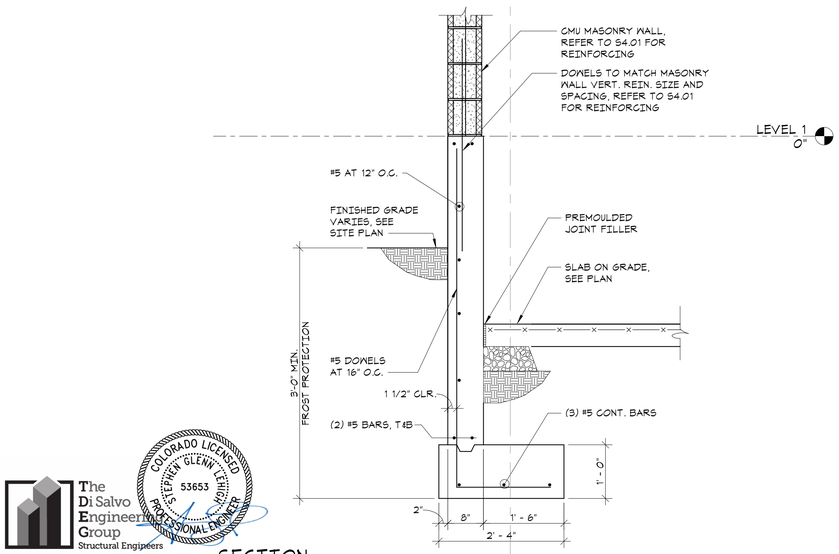

4 SECTION
3/4" = 1'-0"

0

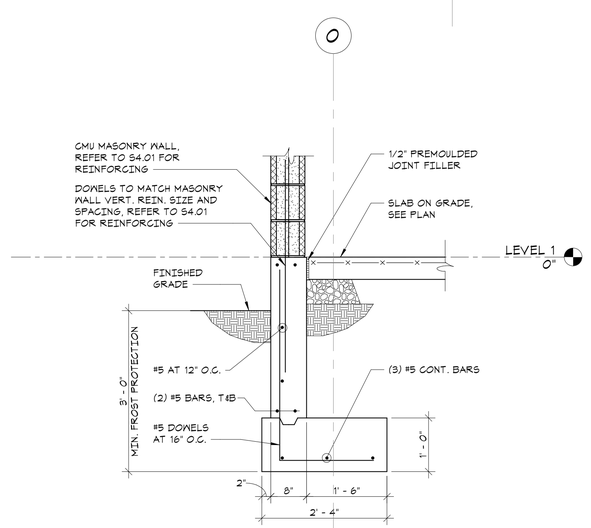

5 SECTION
3/4" = 1'-0"

14

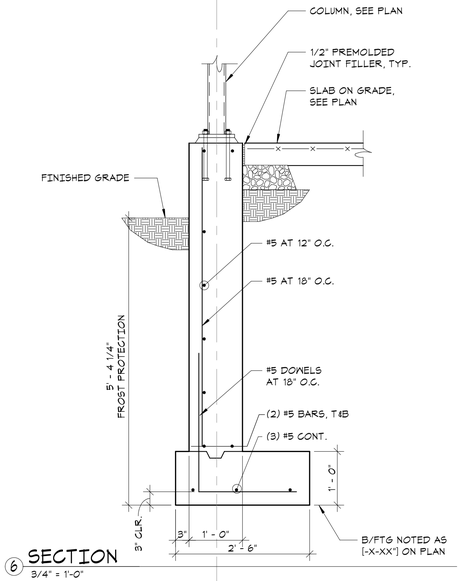

6 SECTION
3/4" = 1'-0"

The Di Salvo Engineering Group
Structural Engineers
405 S. Wilcox Street, Ste 210
Castle Rock, CO 80104
[720] 667-3388 | www.tdeg.com

COLORADO LICENSED
STEPHEN GLENN LEHIGH
53653
PROFESSIONAL ENGINEER

HELTSHE

M1A | MERIDIAN 105 ARCHITECTURE

CITY HOTEL
415 PERRY STREET, CASTLE ROCK, CO.

DATE: 4/22/26
PROJ. NO. 24603.00

ISSUED FOR:
1 Re-Issued for Permit

SHEET TITLE:
FOUNDATION SECTIONS

SHEET NUMBER
S2.05

C:\Users\james\Documents\24603_City Hotel_struct_tdeg.rvt
4/22/2026 1:15:30 PM

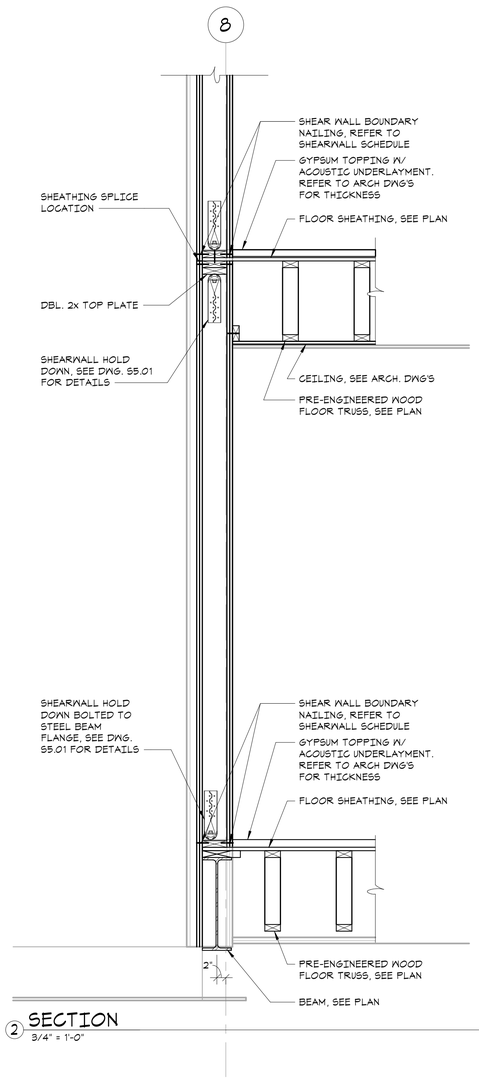

2 SECTION
3/4" = 1'-0"

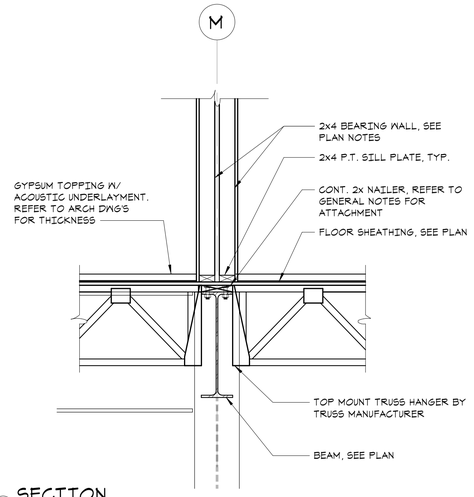

3 SECTION
3/4" = 1'-0"

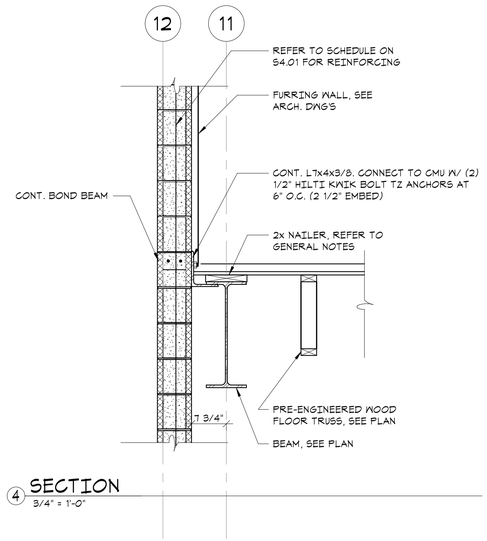

4 SECTION
3/4" = 1'-0"

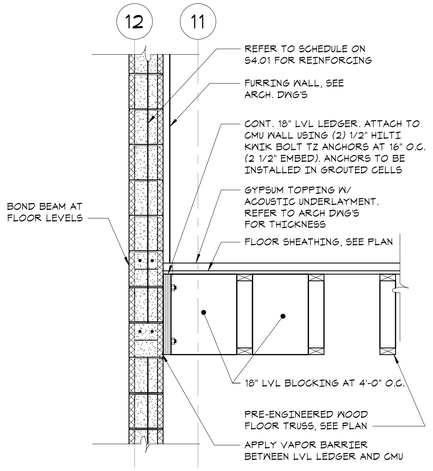

5 SECTION
3/4" = 1'-0"

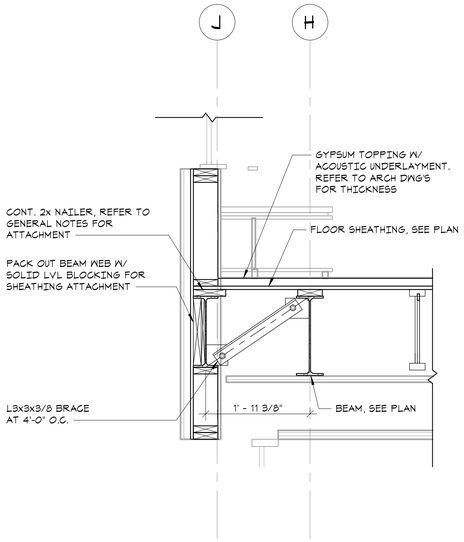

6 SECTION
3/4" = 1'-0"

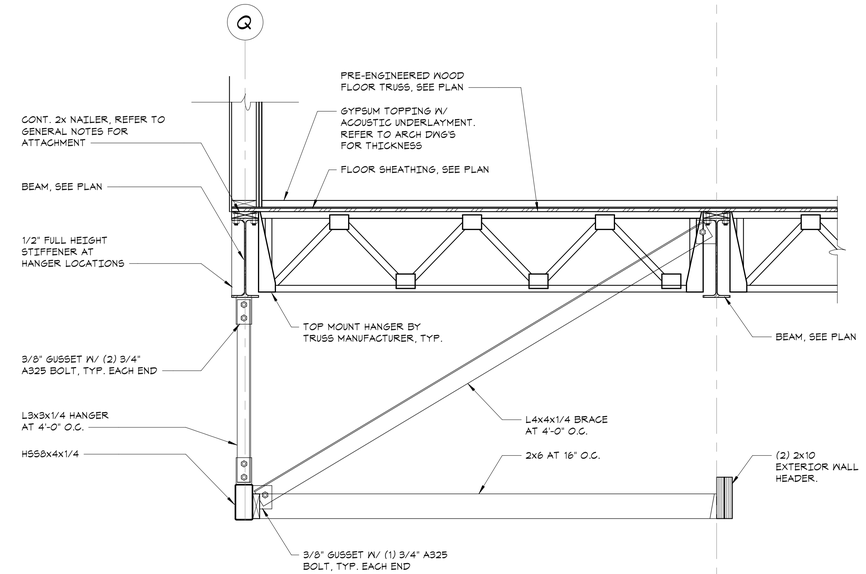

1 SECTION
3/4" = 1'-0"

The Di Salvo Engineering Group
Structural Engineers
405 S. Wilcox Street, Ste 210
Castle Rock, CO 80104
[720] 667-3388 | www.tdeg.com

COLORADO LICENSED STEPHEN GLENN TERHUNE 53653 PROFESSIONAL ENGINEER

HELTSHE

M1A | MERIDIAN 105 ARCHITECTURE

CITY HOTEL
415 PERRY STREET, CASTLE ROCK, CO.

DATE: 4/22/26	ISSUED FOR: 1 Re-Issued for Permit	SHEET TITLE: FRAMING SECTIONS	SHEET NUMBER S3.02
PROJ. NO. 24603.00			

C:\Users\james\Documents\24603_City Hotel_struct_tdeg.rvt
4/22/2026 1:15:32 PM

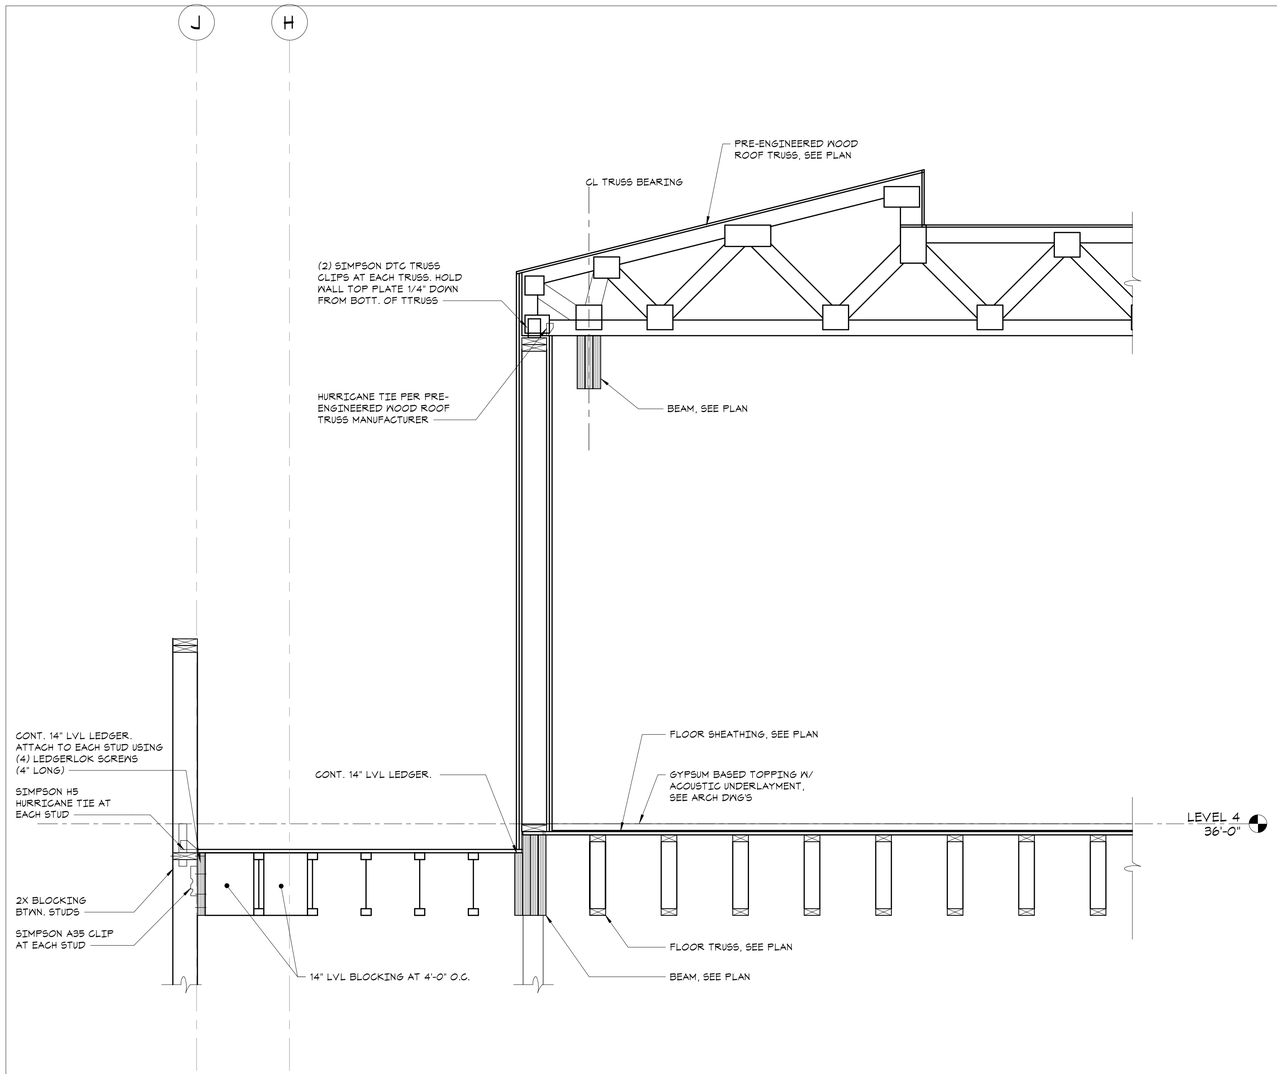

1 SECTION
3/4" = 1'-0"

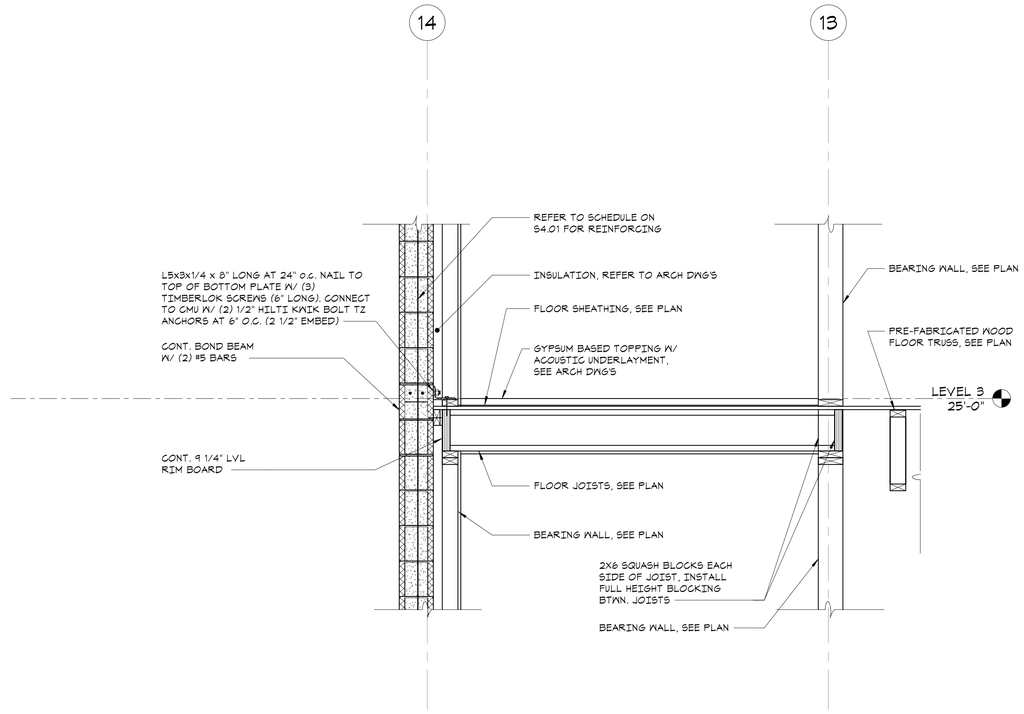

2 SECTION
3/4" = 1'-0"

The Di Salvo Engineering Group
Structural Engineers
405 S. Wilcox Street, Ste 210
Castle Rock, CO 80104
[720] 667-3388 | www.tdeg.com

COLORADO LICENSED STEPHEN GLENN LEHIGH 53653 PROFESSIONAL ENGINEER

HELTSHE

M1A | MERIDIAN 105 ARCHITECTURE

CITY HOTEL
415 PERRY STREET, CASTLE ROCK, CO.

DATE: 4/22/26
PROJ. NO. 24603.00

ISSUED FOR:
1 Re-Issued for Permit

SHEET TITLE: FRAMING SECTIONS

SHEET NUMBER
S3.03

C:\Users\james\Documents\24603_City Hotel_struct_tdeg.rvt
4/22/2026 1:15:33 PM

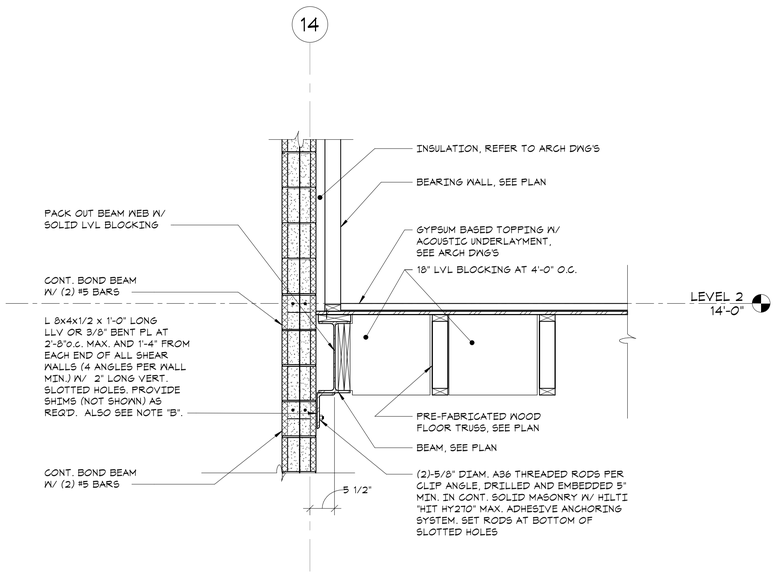

1 SECTION
3/4" = 1'-0"

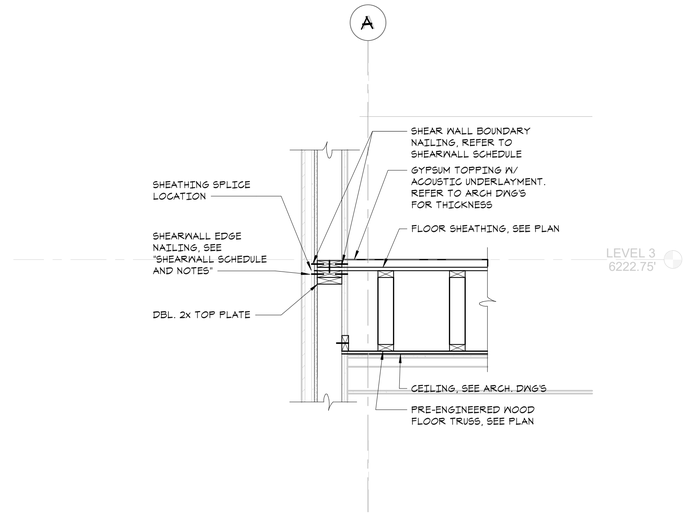

2 SECTION
3/4" = 1'-0"

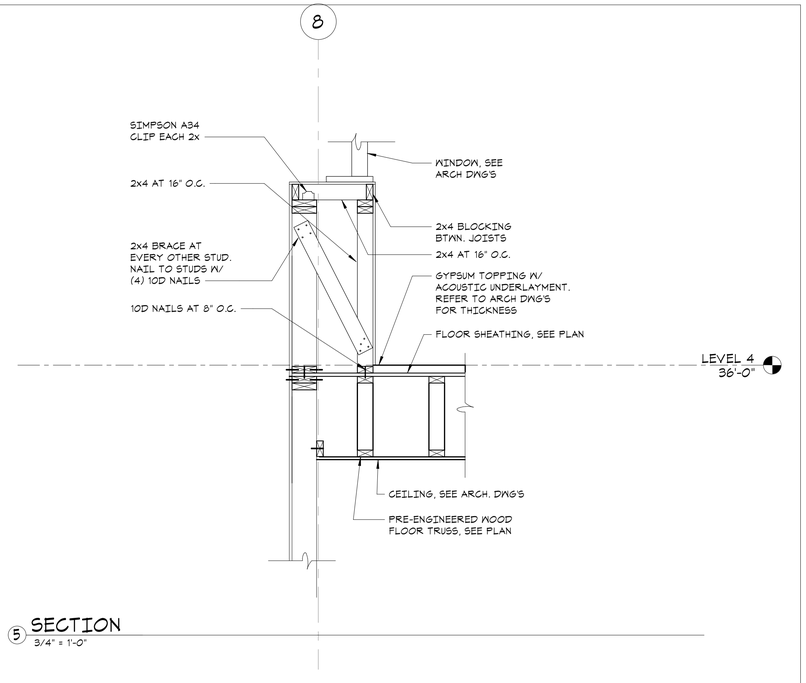

5 SECTION
3/4" = 1'-0"

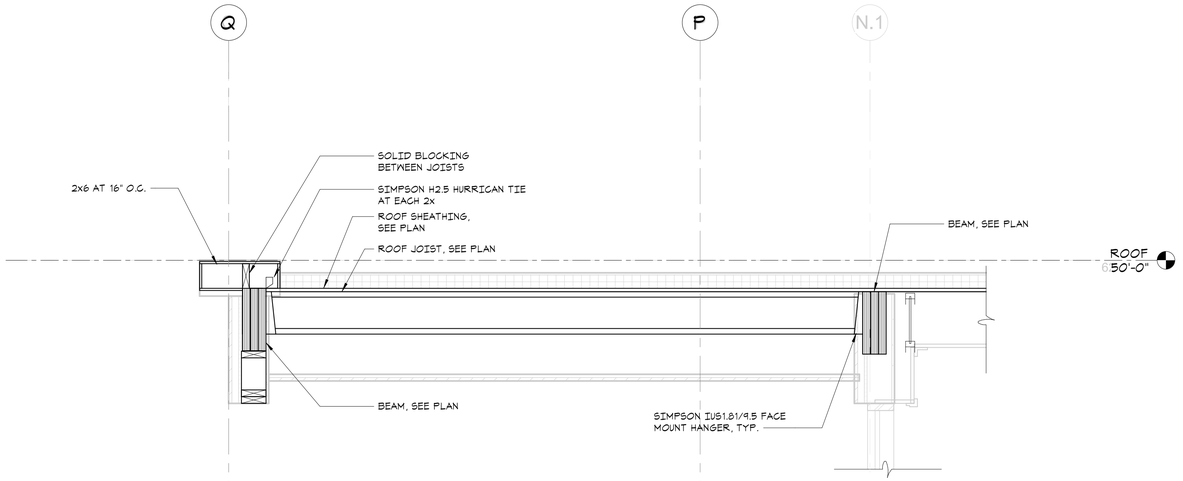

3 SECTION
3/4" = 1'-0"

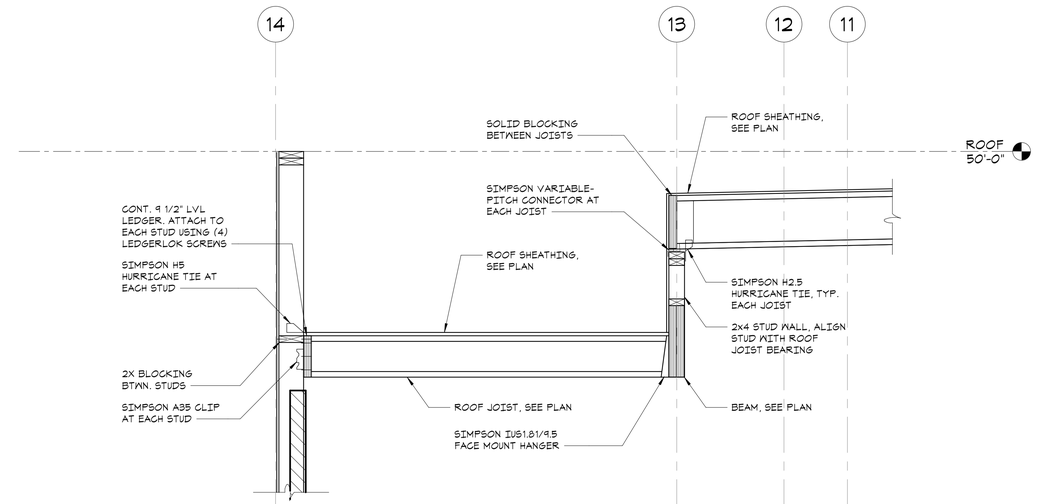

4 SECTION
3/4" = 1'-0"

The Di Salvo Engineering Group
Structural Engineers
405 S. Wilcox Street, Ste 210
Castle Rock, CO 80104
[720] 667-3388 | www.tdeg.com

COLORADO LICENSED STEPHEN GLENN LEWIS 53653 PROFESSIONAL ENGINEER

HELTSHE

M1A | MERIDIAN 105 ARCHITECTURE

CITY HOTEL
415 PERRY STREET, CASTLE ROCK, CO.

DATE: 4/22/26
PROJ. NO. 24603.00

ISSUED FOR:
1 Re-Issued for Permit

SHEET TITLE:
FRAMING SECTIONS

SHEET NUMBER
S3.04

C:\Users\james\Documents\24603_City Hotel_struct_tdeg.rvt
4/22/2026 1:15:35 PM

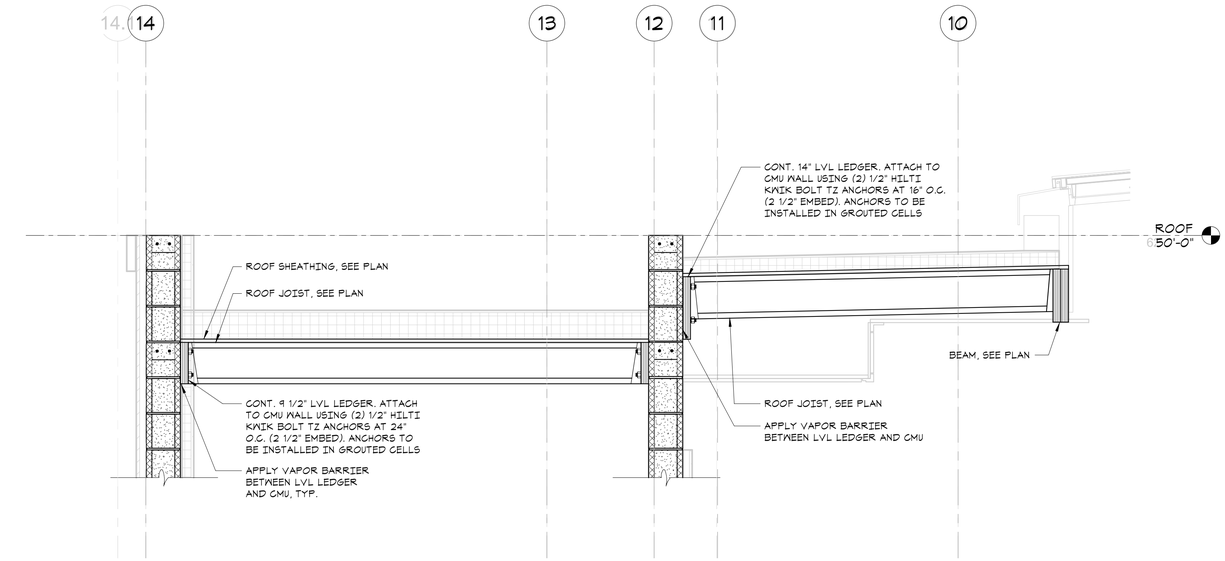

1 SECTION
3/4" = 1'-0"

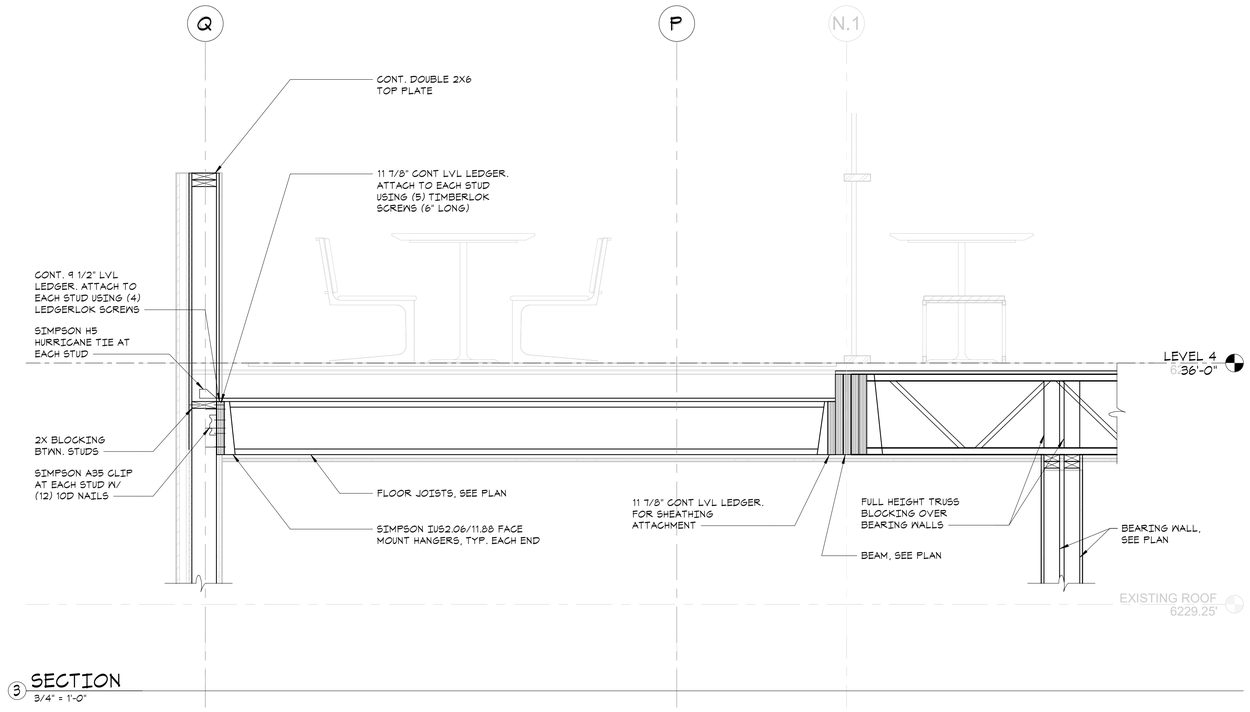

3 SECTION
3/4" = 1'-0"

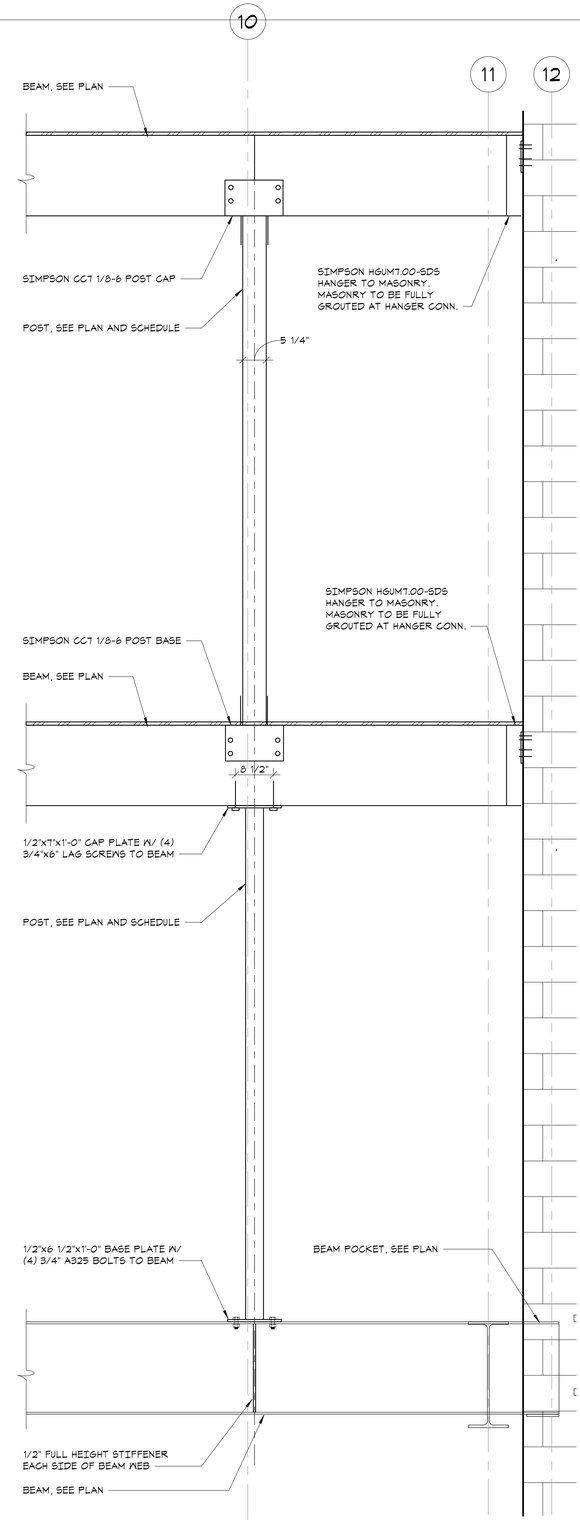

2 SECTION
3/4" = 1'-0"

The Di Salvo Engineering Group
Structural Engineers
405 S. Wilcox Street, Ste 210
Castle Rock, CO 80104
[720] 667-3388 | www.tdeg.com

COLORADO LICENSED
STEPHEN GLENN TEHIGH
53653
PROFESSIONAL ENGINEER

HELTSHE

M1A | MERIDIAN 105 ARCHITECTURE

CITY HOTEL
415 PERRY STREET, CASTLE ROCK, CO.

DATE: 4/22/26
PROJ. NO. 24603.00

ISSUED FOR:
1 Re-Issued for Permit

SHEET TITLE:
FRAMING SECTIONS

SHEET NUMBER
S3.05

C:\Users\james\Documents\24603_City Hotel_struct_tdeg.rvt
4/22/2026 1:15:36 PM

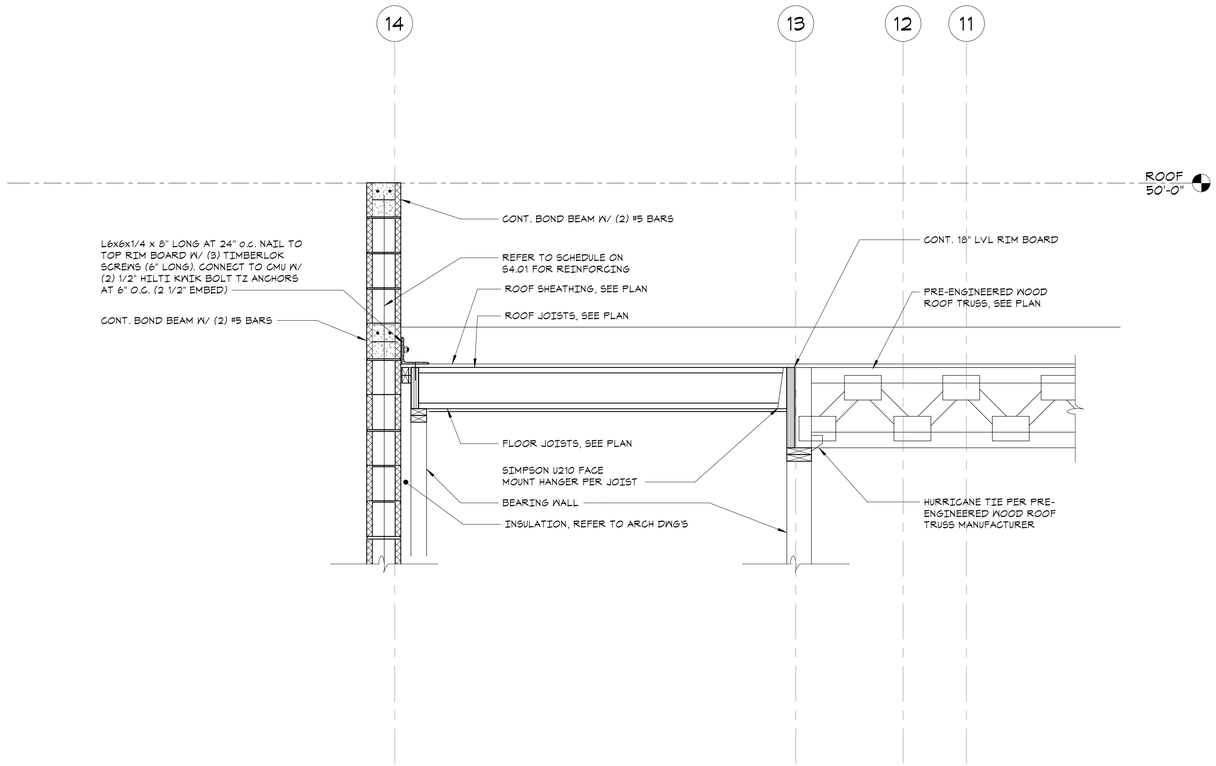

1 SECTION
3/4" = 1'-0"

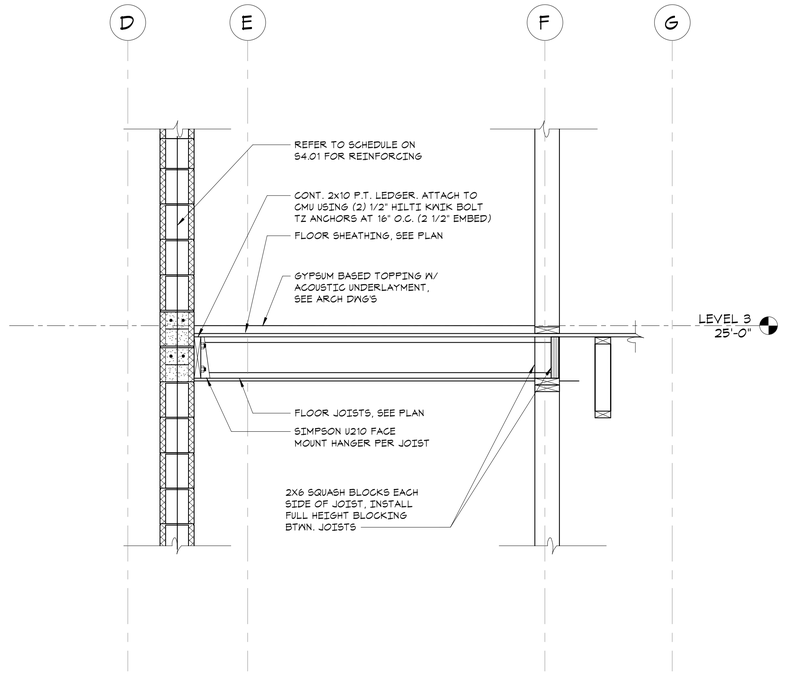

2 SECTION
3/4" = 1'-0"

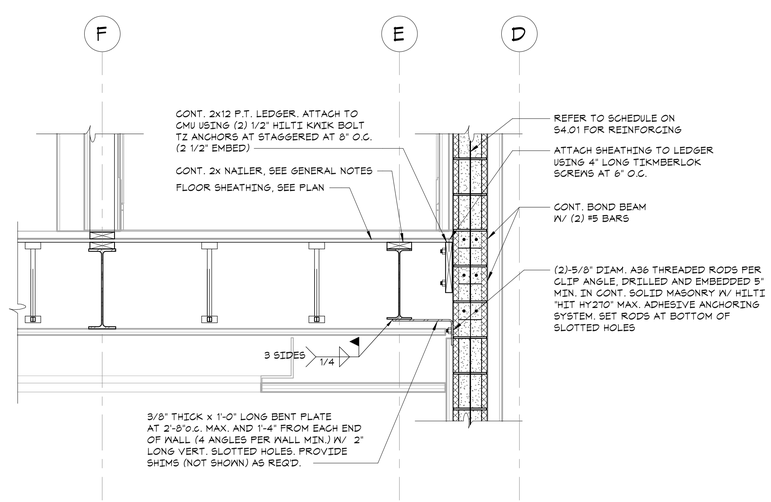

3 SECTION
3/4" = 1'-0"

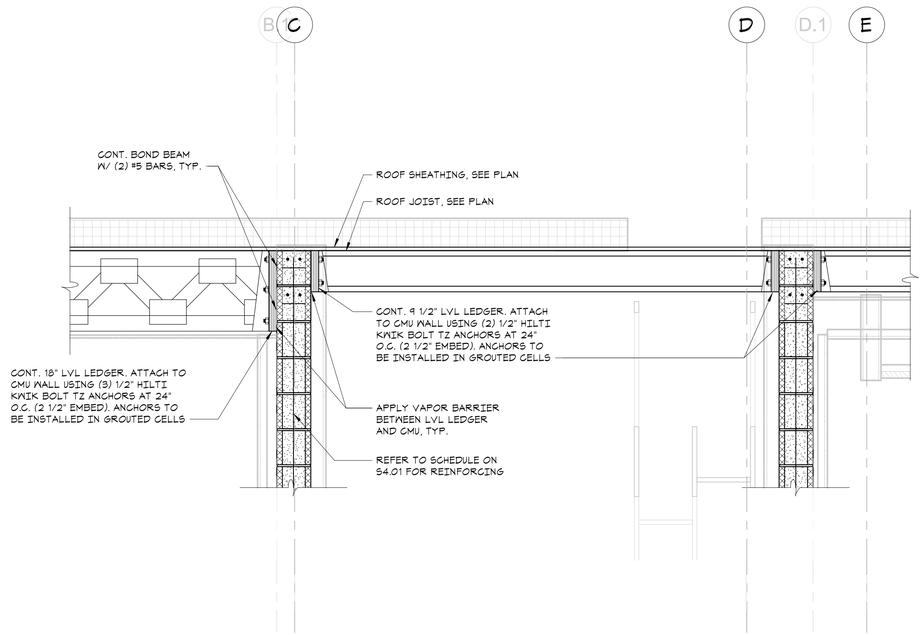

4 SECTION
3/4" = 1'-0"

The Di Salvo Engineering Group
Structural Engineers
405 S. Wilcox Street, Ste 210
Castle Rock, CO 80104
[720] 667-3388 | www.tdeg.com

COLORADO LICENSED
STEPHEN GLENN LEHRER
53653
U.S. PROFESSIONAL ENGINEER

HELTSHE

M1A | MERIDIAN 105 ARCHITECTURE

CITY HOTEL
415 PERRY STREET, CASTLE ROCK, CO.

DATE: 4/22/26
PROJ. NO. 24603.00

ISSUED FOR:
1 Re-Issued for Permit

SHEET TITLE:
FRAMING SECTIONS

SHEET NUMBER
S3.06

C:\Users\james\Documents\24603_City Hotel_struct_tdeg.rvt
4/22/2026 11:15:38 PM

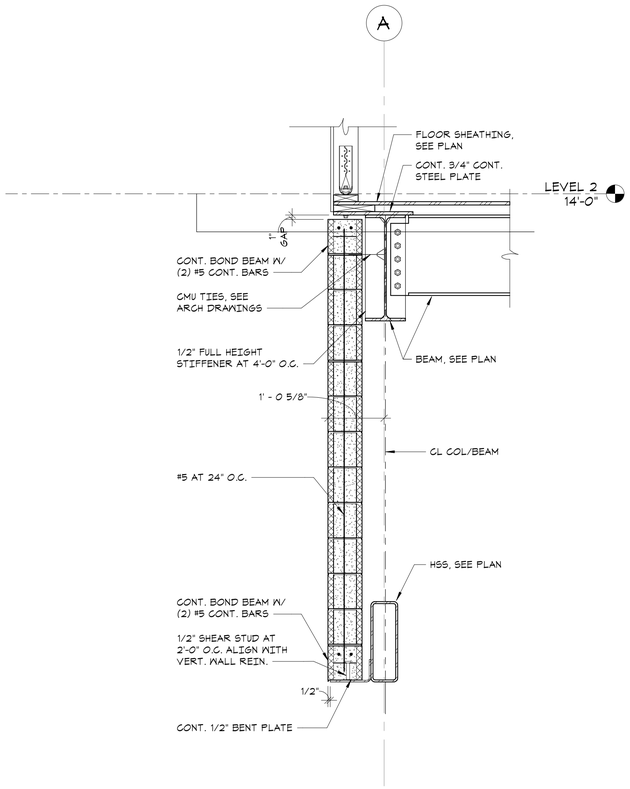

1 SECTION
3/4" = 1'-0"

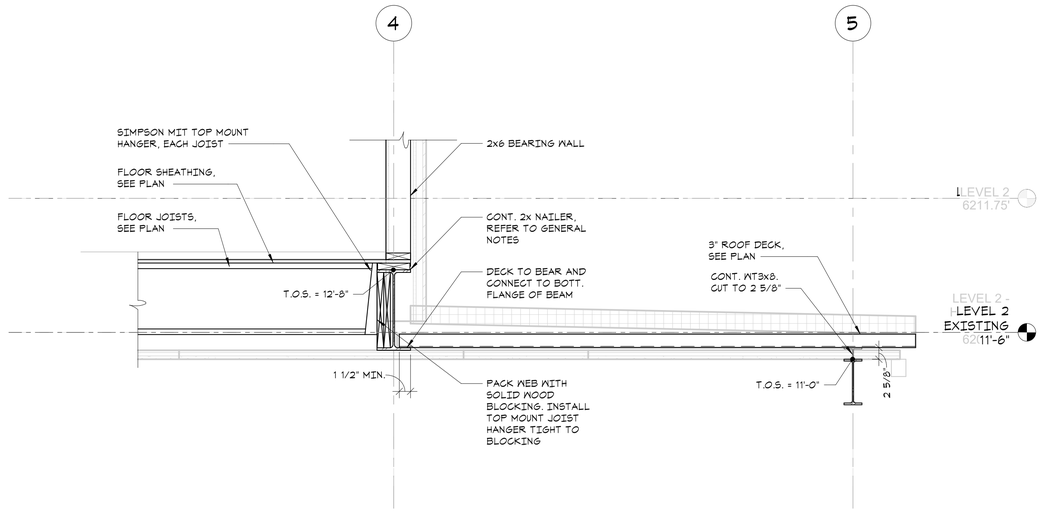

2 SECTION
3/4" = 1'-0"

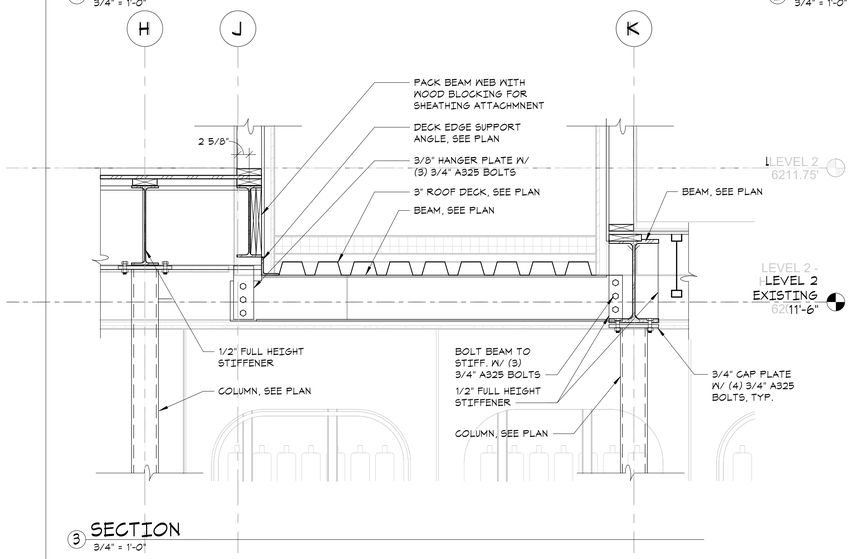

3 SECTION
3/4" = 1'-0"

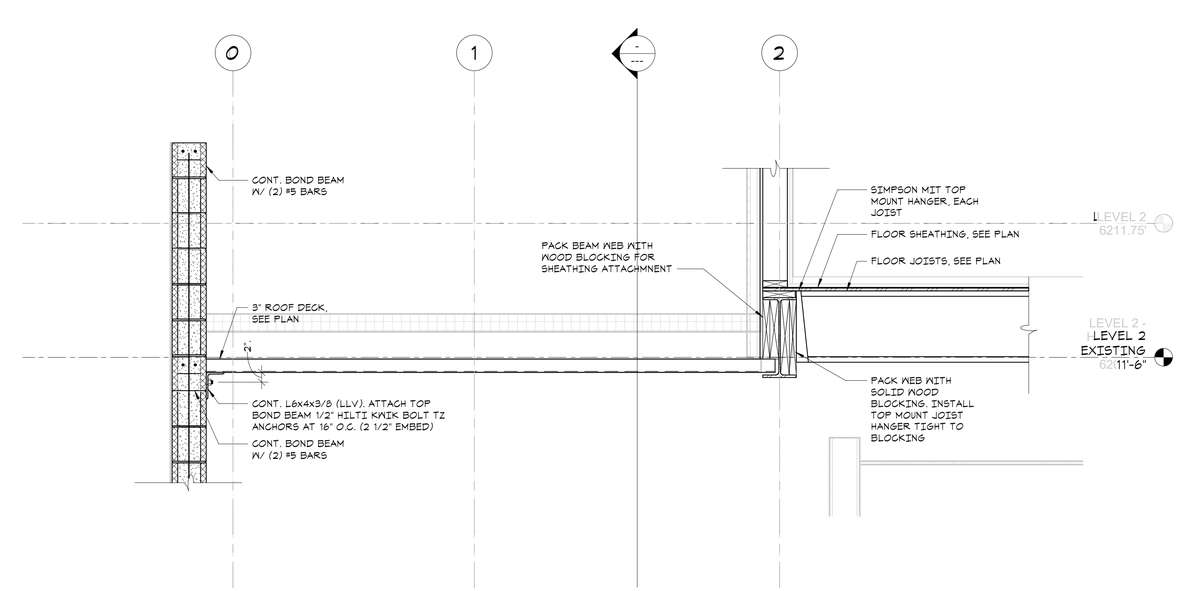

4 SECTION
3/4" = 1'-0"

The Di Salvo Engineering Group
Structural Engineers
405 S. Wilcox Street, Ste 210
Castle Rock, CO 80104
[720] 667-3388 | www.tdeg.com

COLORADO LICENSED STEPHEN GLENN FERGUSON 53653 PROFESSIONAL ENGINEER

HELTSHE

M1A | MERIDIAN 105 ARCHITECTURE

CITY HOTEL
415 PERRY STREET, CASTLE ROCK, CO.

DATE: 4/22/26
PROJ. NO. 24603.00

ISSUED FOR:
1 Re-Issued for Permit

SHEET TITLE:
FRAMING SECTIONS

SHEET NUMBER
S3.07

C:\Users\james\Documents\24603_City Hotel_struct_tdeg.rvt
4/22/2026 1:15:40 PM

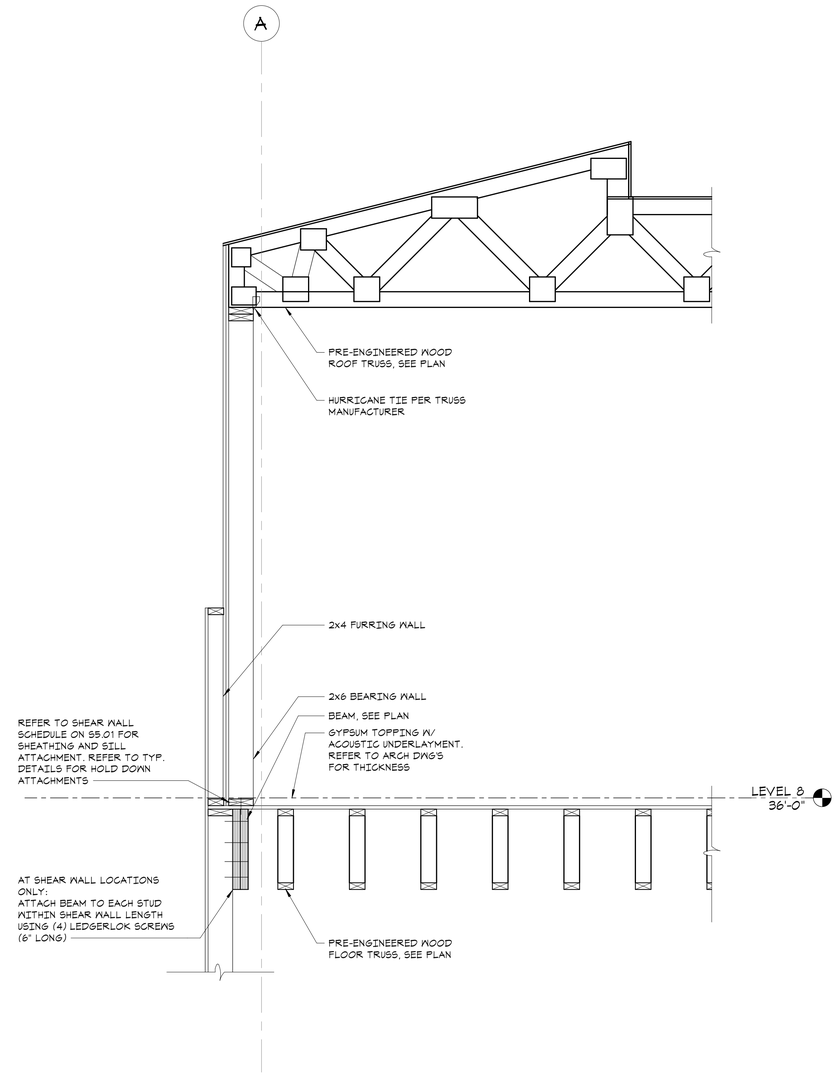

1 SECTION
3/4" = 1'-0"

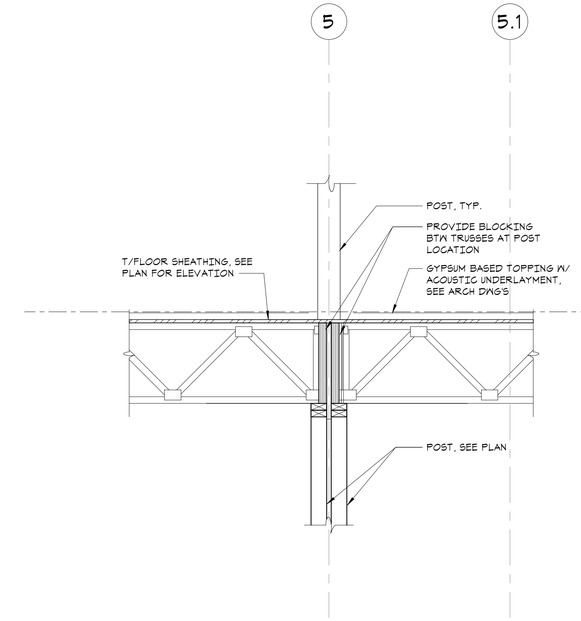

2 SECTION
3/4" = 1'-0"

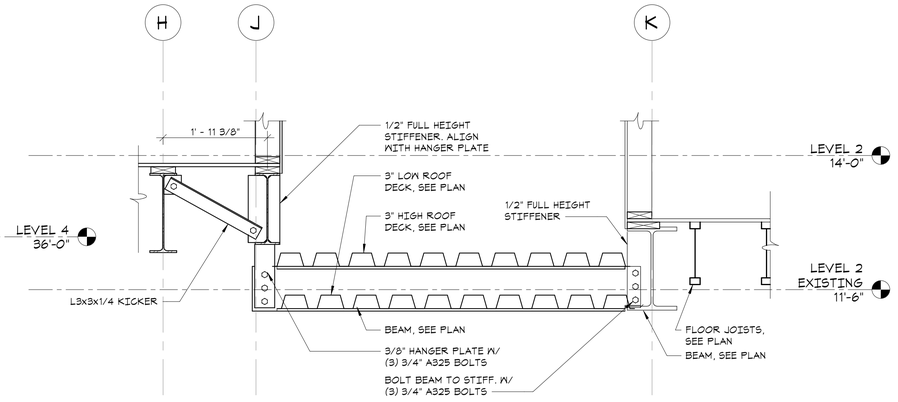

3 SECTION
3/4" = 1'-0"

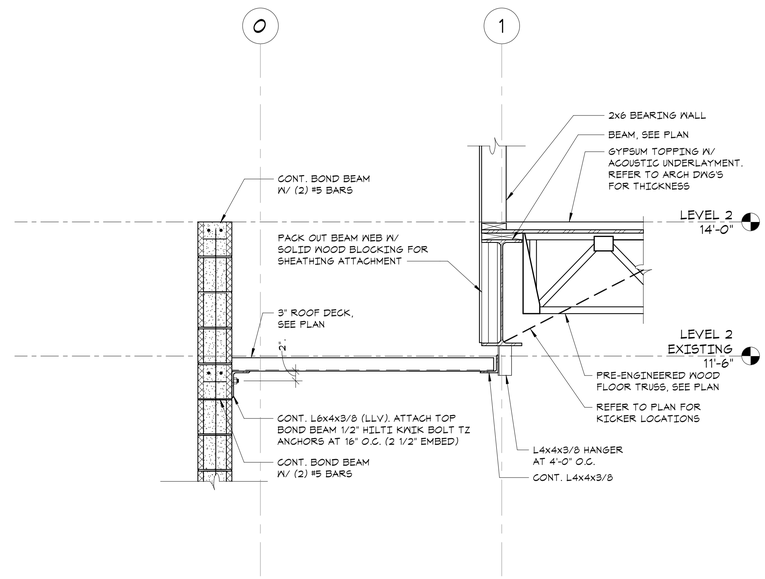

4 SECTION
3/4" = 1'-0"

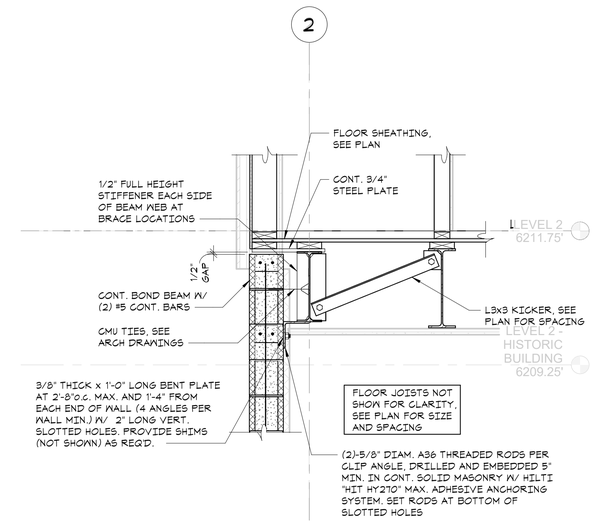

5 SECTION
3/4" = 1'-0"

The Di Salvo Engineering Group
Structural Engineers
405 S. Wilcox Street, Ste 210
Castle Rock, CO 80104
[720] 667-3388 | www.tdeg.com

COLORADO LICENSED
STEPHEN GLENN TEHIGH
53653
PROFESSIONAL ENGINEER

HELTSHE

M1A | MERIDIAN 105 ARCHITECTURE

CITY HOTEL
415 PERRY STREET, CASTLE ROCK, CO.

DATE: 4/22/26	ISSUED FOR: 1 Re-Issued for Permit	SHEET TITLE: FRAMING SECTIONS	SHEET NUMBER S3.08
PROJ. NO. 24603.00			

C:\Users\james\Documents\24603_City Hotel_struct_tdeg.rvt

4/22/2026 1:15:42 PM

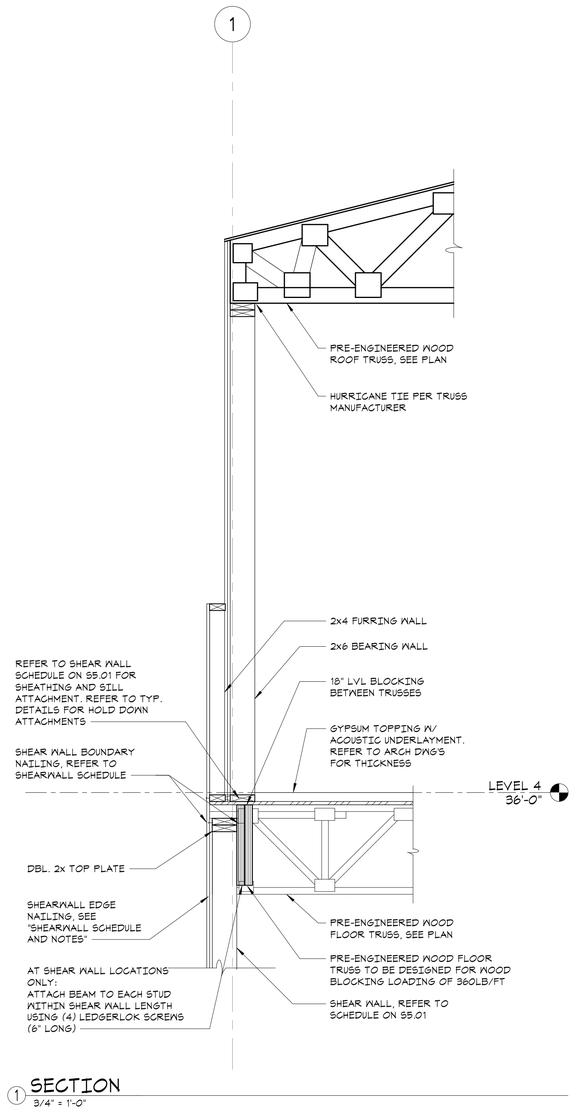

1 SECTION
3/4" = 1'-0"

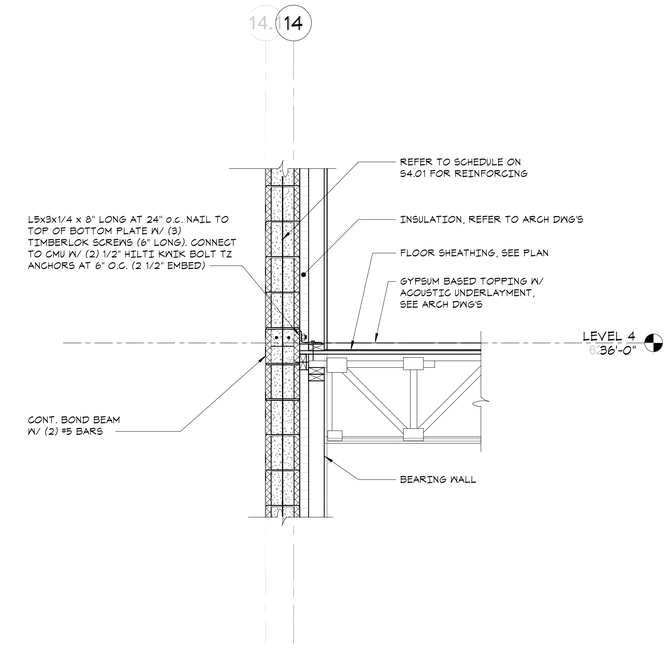

2 SECTION
3/4" = 1'-0"

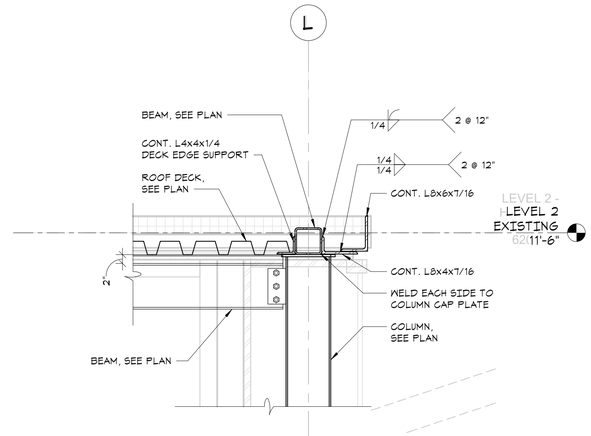

4 SECTION
3/4" = 1'-0"

3 SECTION
3/4" = 1'-0"

5 SECTION
3/4" = 1'-0"

The Di Salvo Engineering Group
Structural Engineers
405 S. Wilcox Street, Ste 210
Castle Rock, CO 80104
[720] 667-3388 | www.tdeg.com

COLORADO LICENSED
STEPHEN GLENN TEPPER
53653
PROFESSIONAL ENGINEER

HELTSHE

M1A | MERIDIAN 105 ARCHITECTURE

CITY HOTEL
415 PERRY STREET, CASTLE ROCK, CO.

DATE: 4/22/26	ISSUED FOR: 1 Re-Issued for Permit	SHEET TITLE: FRAMING SECTIONS	SHEET NUMBER S3.09
PROJ. NO. 24603.00			

C:\Users\james\Documents\24603_City Hotel_struct_tdeg.rvt
4/22/2026 1:15:44 PM

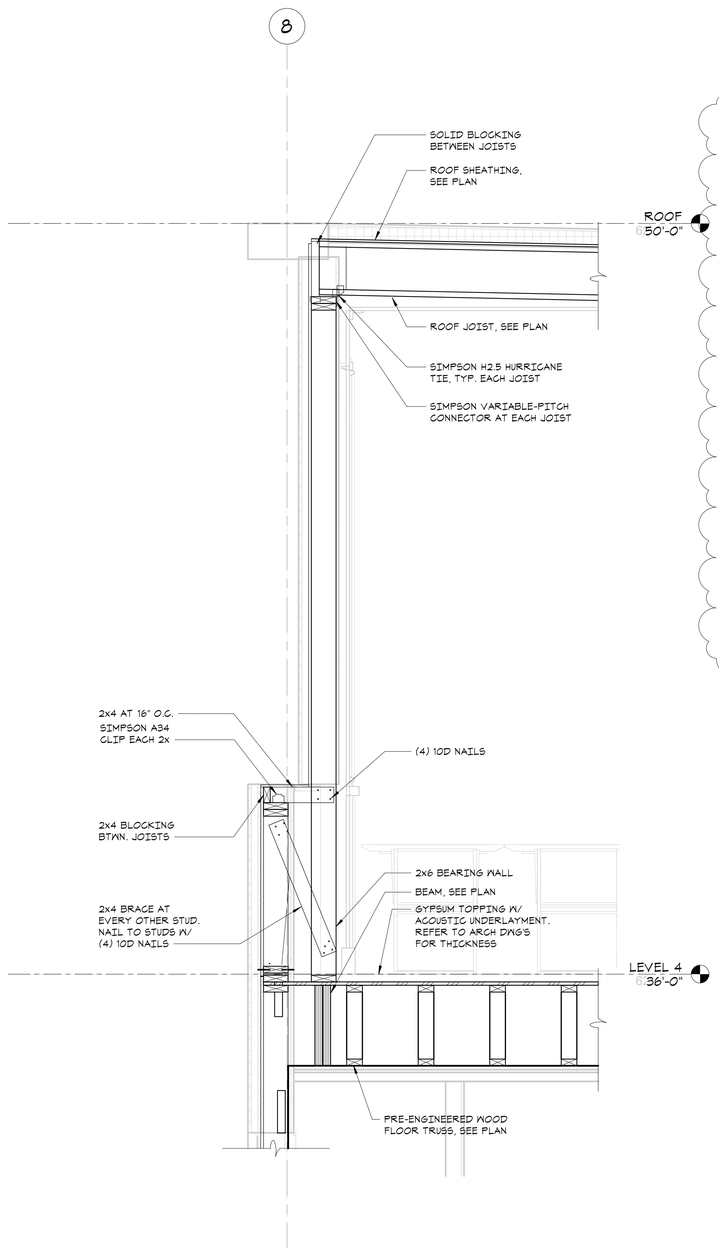

1 SECTION
3/4" = 1'-0"

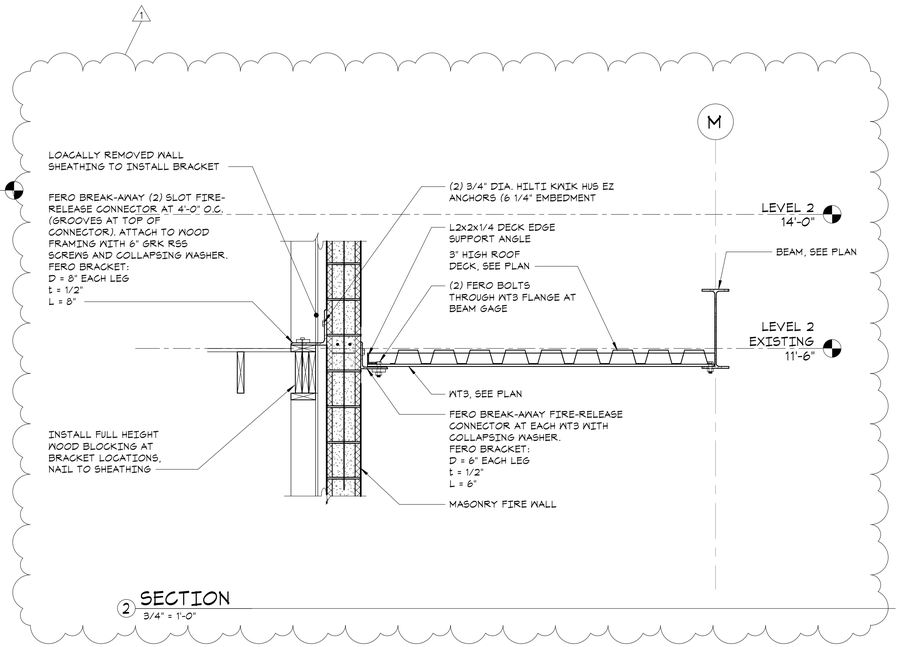

2 SECTION
3/4" = 1'-0"

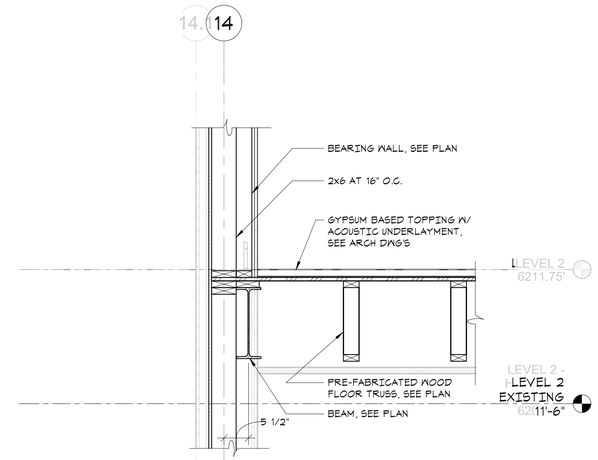

4 SECTION
3/4" = 1'-0"

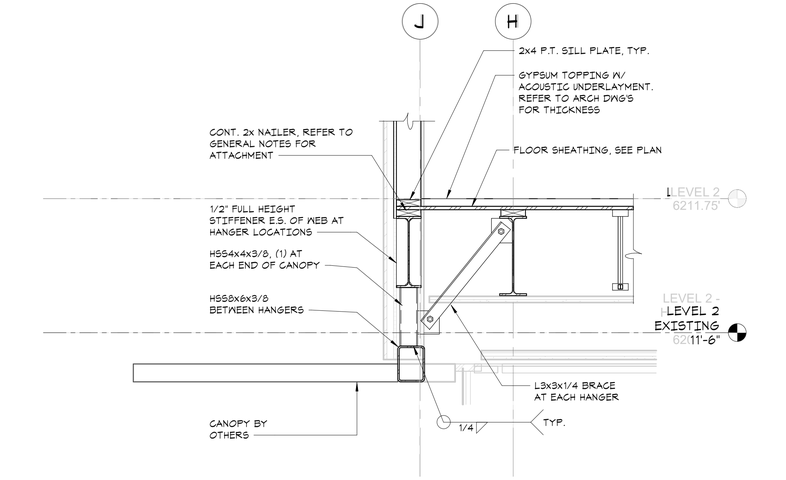

3 SECTION
3/4" = 1'-0"

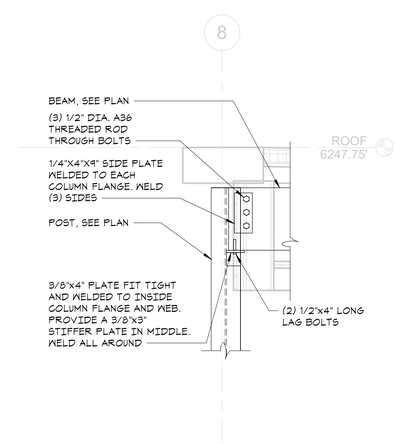

5 SECTION
3/4" = 1'-0"

The Di Salvo Engineering Group
Structural Engineers
405 S. Wilcox Street, Ste 210
Castle Rock, CO 80104
[720] 667-3388 | www.tdeg.com

COLORADO LICENSED STEPHEN GLENN TERHUNE 53653 PROFESSIONAL ENGINEER

HELTSHE

M1A | MERIDIAN 105 ARCHITECTURE

CITY HOTEL
415 PERRY STREET, CASTLE ROCK, CO.

DATE: 4/22/26
PROJ. NO. 24603.00

ISSUED FOR:
1 Re-Issued for Permit

SHEET TITLE: FRAMING SECTIONS

SHEET NUMBER
S3.10

C:\Users\james\Documents\24603_City Hotel_struct_tdeg.rvt
4/22/2026 1:15:46 PM

ROOF																													ROOF
50'-0" **LEVEL 10**																													50'-0" **LEVEL 10**
36'-0" 1/2" LEVEL 3																													**36'-0" 1/2"** LEVEL 3
25'-0" LEVEL 2																													25'-0" LEVEL 2
14'-0" **LEVEL 11**	W10X49	W10X49	W10X49	W10X49	HSS5X5X3/8	HSS6X6X3/8	HSS6X6X3/8	HSS6X6X3/8	HSS6X6X1/2	W10X39	W10X39	W10X39	HSS6X6X5/8	HSS6X6X5/8	HSS6X6X3/8	HSS6X6X3/8	HSS6X6X3/8	W10X39	W10X39	H(1'-10 3/4")-6(-5'-6 5/8")-1	W10X39	H(1'-10 3/4")-7(5'-1 3/8")-1	W10X49	W10X49	HSS5X5X3/8	HSS6X6X3/8	W10X39	HSS5X5X3/8	HSS5X5X3/8	W10X49	W10X49	14'-0" **LEVEL 11**
0'8"																													0'8"
Column Locations	A-2	A-5.1	A-7	A-12	B-1	C-10	C-13	D-1	E-3	E-5	E-6	E-7	F-9	G-13	H-1	H-3	H-5	H-6	H(1'-10 3/4")-6(-5'-6 5/8")	H-7	H(1'-10 3/4")-7(5'-1 3/8")	J-8	J-13	K-0	K-3	L-5	M-2	M-4	M-8	M-13	

ROOF										ROOF
50'-0" **LEVEL 10**								W8X28	W8X28	50'-0" **LEVEL 10**
36'-0" 1/2" LEVEL 3										**36'-0" 1/2"** LEVEL 3
25'-0" LEVEL 2			HSS4X4X3/8							25'-0" LEVEL 2
14'-0" **LEVEL 11**	HSS4X4X3/8	HSS6X6X3/8		HSS6X6X3/8	HSS5X5X3/8	HSS4X4X3/8	HSS5X5X3/8			14'-0" **LEVEL 11**
0'8"										0'8"
Column Locations	M-14	N-8	N(-5'-7 1/4")-10	P-8	P-11	P(8 7/8")-14	Q-7(-1'-2 1/2")	Q-8	Q-13(-2'-1 3/4")	

Graphical Column Schedule
NO SCALE

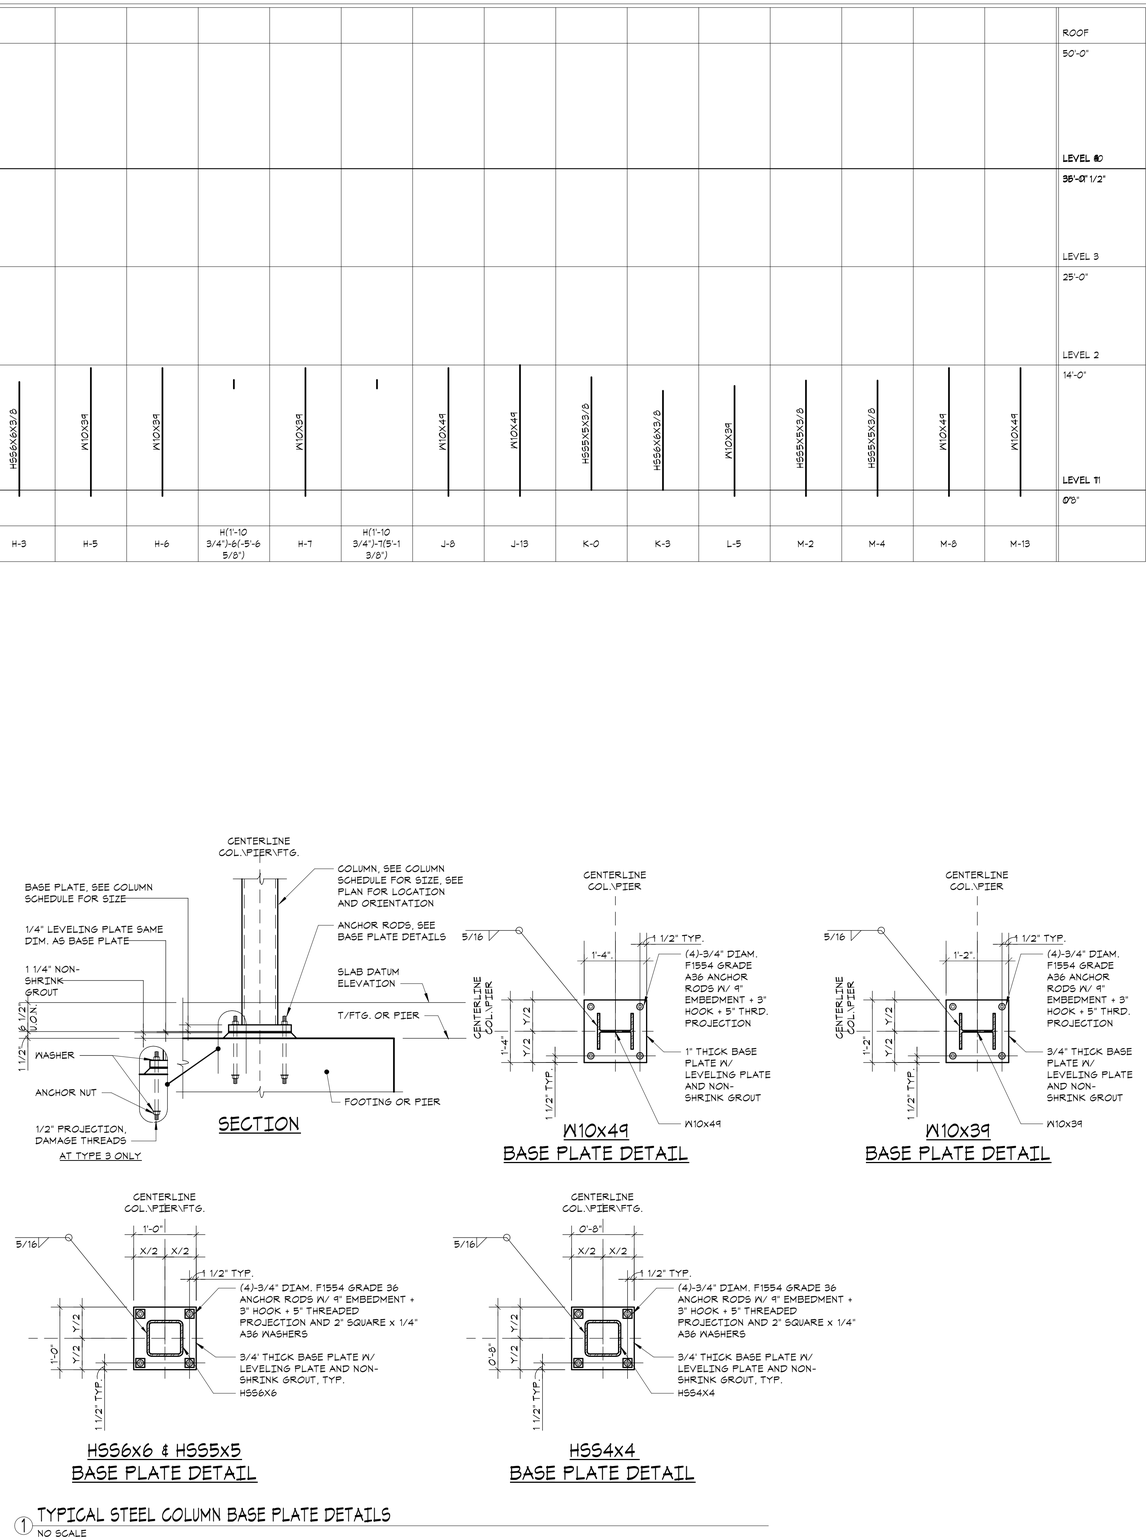

1 TYPICAL STEEL COLUMN BASE PLATE DETAILS
NO SCALE

The Di Salvo Engineering Group
Structural Engineers
405 S. Wilcox Street, Ste 210
Castle Rock, CO 80104
[720] 667-3388 | www.tdeg.com
COLORADO LICENSED 53653 STEPHEN GLENN TEHRANI PROFESSIONAL ENGINEER

HELTSHE

M1A MERIDIAN 105 ARCHITECTURE

CITY HOTEL
415 PERRY STREET, CASTLE ROCK, CO.

DATE: 4/22/26
PROJ. NO. 24603.00

ISSUED FOR:
1 Re-Issued for Permit

SHEET TITLE:
STEEL COLUMN SCHEDULE

SHEET NUMBER
S3.11

C:\Users\james\Documents\24603_City Hotel_struct_tdeg.rvt
4/22/2026 1:15:48 PM

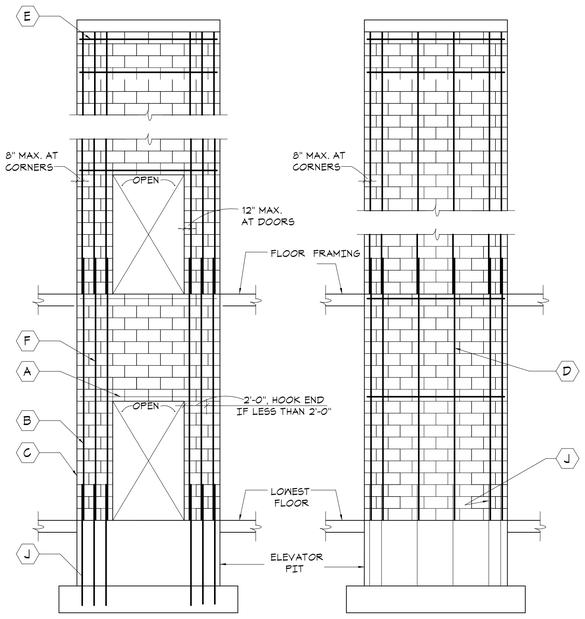

ELEVATION "A"

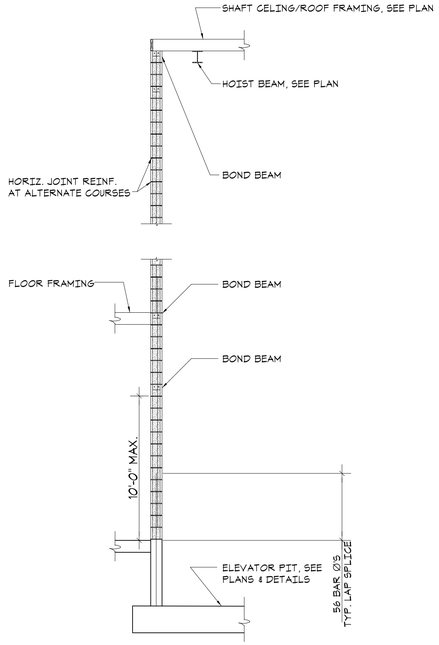

SECTION

KEYNOTES

A	(2)-#5 HORIZ. REINF. GROUTED SOLID IN BOND BEAMCOURSE TYP. ABOVE AND BELOW ALL OPENINGS. FOR HORIZONTAL REINFORCING IN MASONRY LINTELS SEE "TYPICAL MASONRY LINTEL IN NON-LOAD BEARING WALL DETAIL"
B	VERT. FULL HEIGHT REINF. IN SOLID GROUT, TYP. AT WALL ENDS, CORNERS, AND EACH SIDE OF CJ'S,SEE REINFORCEMENT SCHEDULE
C	CMU WALL. FOR SIZE, SEE PLANS AND REINFORCEMENT SCHEDULE.
D	TYP. VERTICAL REINF., SEE REINFORCEMENT SCHEDULE (U.O.N. BY SECTION). FILL CELLS CONTAINING REINF. SOLID W/ GROUT .
E	(2)-#5 HORIZ. REINF. AT TOP OF WALL GROUTED SOLID IN BOND BEAM COURSE. PLACE REINF. ONE COURSE LOWER WHERE WALL ABUTS FLOOR ABOVE.
F	VERT. FULL HEIGHT REINF. IN SOLID GROUT, TYP. AT BOTH SIDES OF ALL WALL OPENINGS, SEE REINFORCEMENT SCHEDULE.
G	HORIZ. JOINT REINFORCING, SEE GENERAL NOTES.
H	PROVIDE REINFORCING DOWELS BETWEEN FDN. AND MASONRY WALL EQUAL TO SIZE AND SPACING OF MASONRY VERT. WALL REINFORCING (MAX. SPACING = 4'-0"O.C.). REINFORCING DOWELS SHALL EXTEND INTO MASONRY WALLS AND SHALL BE LAPPED 48 BAR DIAM.
J	PROVIDE REINFORCING DOWELS BETWEEN FTG. AND FDN WALL EQUAL TO SIZE AND SPACING OF MASONRY VERT. WALL REINFORCING (MAX. SPACING = 4'-0"O.C.). REINFORCING DOWELS SHALL EXTEND INTO MASONRY WALLS AND SHALL BE LAPPED 48 BAR DIAM.

REINFORCEMENT SCHEDULE

WALL DESCRIPTION	WALL ELEVATION TYPE	VERTICAL REINFORCEMENT
8" CMU STAIR SHAFTS (MSN-1)		D #5 AT 16"O.C. B (4)-#9 F (1)-#5
8" CMU EXTERIOR WALLS (MSN-2)		D #5 AT 32"O.C. B (2)-#5 F (1)-#5
8" CMU ELEVATOR SHAFTS (MSN-3)		D #5 AT 16"O.C. B (4)-#8 F (1)-#4
8" CMU PARTITIONS		D #4 AT 48"O.C. B (1)-#4 F (1)-#4 NOTE: ALL 8" CMU PARTITIONS MUST BE BRACED AT FLOOR LEVEL.
8" CMU FIRE WALL		D #5 AT 32"O.C. B (2)-#5 F (1)-#5 WALL TO BE FULLY GROUTED

- SEE WALL ELEVATIONS (A) AND (B) FOR PLACEMENT OF REINFORCEMENT AND ADDITIONAL REQUIREMENTS.
- ALL WALLS SHALL HAVE HORIZ. JOINT REINFORCEMENT AS PER GENERAL NOTES. AT SHEAR WALLS PROVIDE ADDITIONAL HORIZ. JOINT REINFORCEMENT AS PER "TYP. REINF. ARRANGEMENTS AT CMU SHEAR WALL ENDS, CORNERS, AND INTERSECTIONS."

NOTES:
1. FOR SHEAR WALL LOCATIONS AND EXTENT, SEE FRAMING AND FDN. PLANS.
2. FOR CMU WALL LOCATIONS AND EXTENT, SEE ARCH. DWGS.
3. SEE ARCH. DWGS. FOR LOCATIONS OF CONTROL JOINTS. DO NOT LOCATE CONTROL JOINTS WITHIN 32" OF MASONRY OPENINGS.
4. ALL CMU CELLS CONTAINING VERTICAL REINFORCEMENT SHALL BE GROUTED SOLID.
5. ALL GROUTED CELLS SHALL BE MECHANICALLY VIBRATED IN ACCORDANCE WITH ACI 530. IN ADDITION, AFTER 10 MINUTES, MECHANICALLY VIBRATE GROUTED CELLS A SECOND TIME.
6. BOND BEAM AT SLOPING STEEL BEAMS/ROOFS/CEILINGS: ELEVATION OF CONTINUOUS BOND BEAM MUST VARY W/ SLOPING STL. BM./ROOF/CEILING. WHERE CHANGES COURSE, RUN BOND BEAM IN BOTH COURSES FOR A MINIMUM OF 6'-0"

5 TYPICAL CONCRETE MASONRY WALL REINFORCEMENT DETAIL
NO SCALE

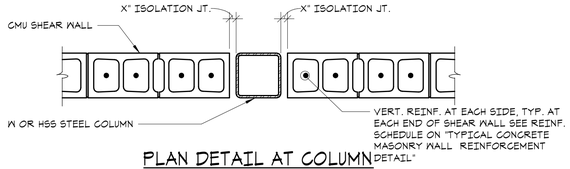

PLAN DETAIL AT COLUMN

- TYPICAL HORIZONTAL JOINT REINFORCING NOT SHOWN FOR CLARITY.

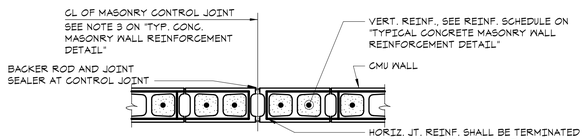

PLAN DETAIL AT WALL ENDS AND CONTROL JOINTS

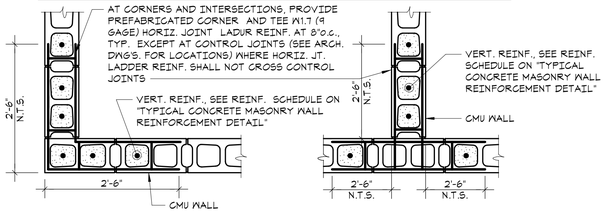

PLAN DETAIL AT CORNERS AND INTERSECTIONS

- TYPICAL HORIZONTAL JOINT REINFORCING (NOT SHOWN FOR CLARITY).

4 TYPICAL MASONRY WALL PLAN DETAILS
NO SCALE

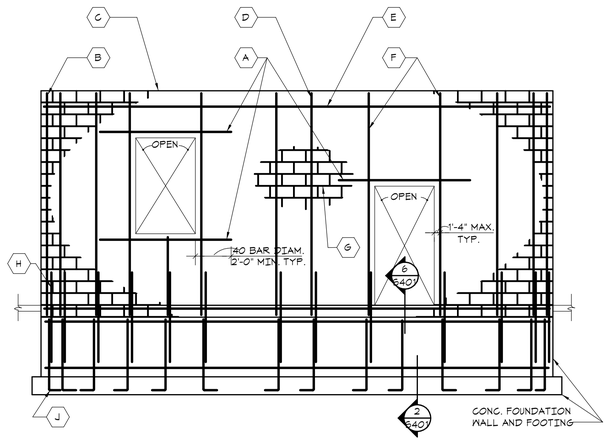

ELEVATION AT SHEAR WALLS AND EXTERIOR WALLS (A)

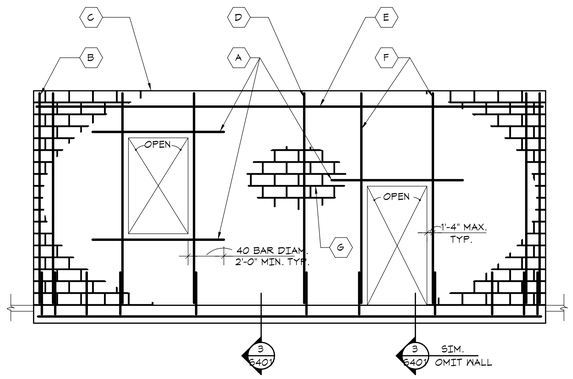

ELEVATION AT PARTITION WALLS (B)

- PARTITIONS ARE WALLS OTHER THAN SHEAR WALLS, EXTERIOR WALLS, AND BEARING WALLS

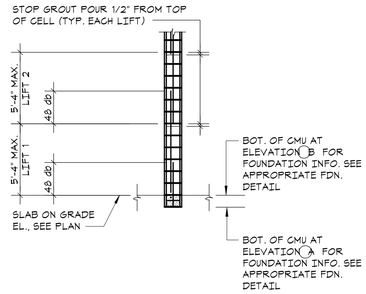

SECTION - LOW LIFT WALL GROUTING DETAIL (C)

- FOR ADDITIONAL GROUTING REQUIREMENTS, SEE NOTE 4 AND GENERAL NOTES.

2 SECTION
NO SCALE

The Di Salvo Engineering Group
Structural Engineers
405 S. Wilcox Street, Ste 210
Castle Rock, CO 80104
[720] 667-3388 | www.tdeg.com
COLORADO LICENSED STEPHEN GLENN TEHIGH 53653 PROFESSIONAL ENGINEER

HELTSHE

M1A MERIDIAN 105 ARCHITECTURE

CITY HOTEL
415 PERRY STREET, CASTLE ROCK, CO.

DATE: 4/22/26
PROJ. NO. 24603.00

ISSUED FOR:
1 Re-Issued for Permit

SHEET TITLE: MASONRY SCHEDULE AND TYPICAL DETAILS

SHEET NUMBER S4.01

C:\Users\jsamet\Documents\24603_City Hotel_struct_tdeg.rvt
4/22/2026 1:15:50 PM

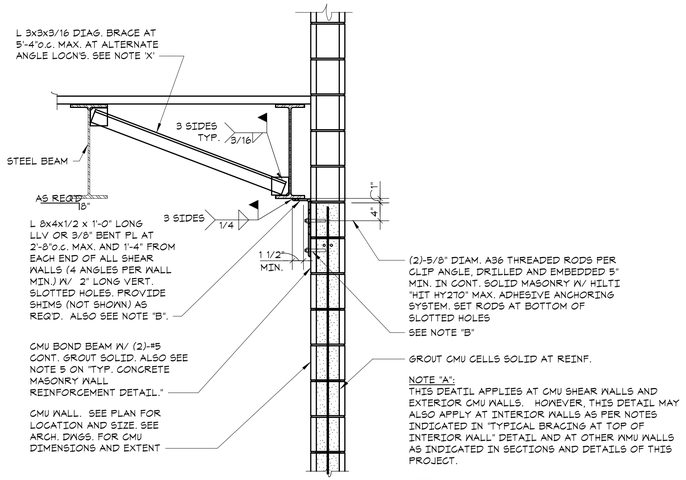

1 TYPICAL CONNECTION DETAIL AT TOP OF SHEAR/EXTERIOR WALLS
NO SCALE

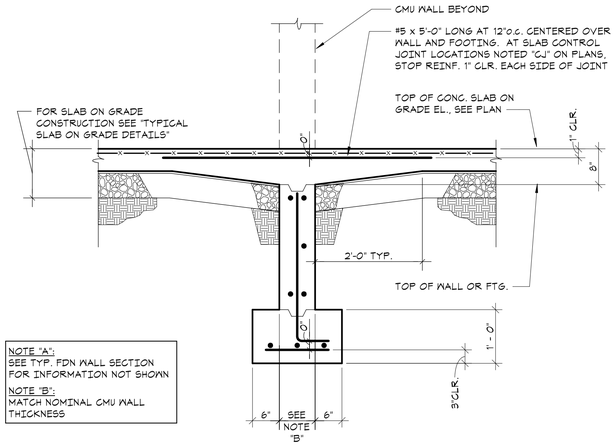

2 TYPICAL FOUNDATION DETAIL FOR MASONRY WALLS AT WALL OPENINGS
NO SCALE

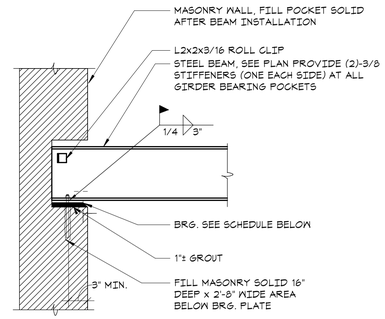

3 SECTION
NO SCALE

STL. BREARING PL. SCHEDULE

MARK	WIDTH	DEPTH	THICKNESS
BP-1	12"	5"	3/8"
BP-2	14"	6"	5/8"
BP-3	8"	4"	3/8"

The Di Salvo Engineering Group
Structural Engineers
405 S. Wilcox Street, Ste 210
Castle Rock, CO 80104
[720] 667-3388 | www.tdeg.com
COLORADO LICENSED STEPHEN GLENN LEWIS 53653 PROFESSIONAL ENGINEER

HELTSHE

M1A | MERIDIAN 105 ARCHITECTURE

CITY HOTEL
415 PERRY STREET, CASTLE ROCK, CO.

DATE: 4/22/26
PROJ. NO. 24603.00

ISSUED FOR:
1 Re-Issued for Permit

SHEET TITLE:
MASONRY TYPICAL DETAILS

SHEET NUMBER
S4.02

4/22/2026 1:15:51 PM C:\Users\james\Documents\24603_City Hotel_struct_tdeg.rvt

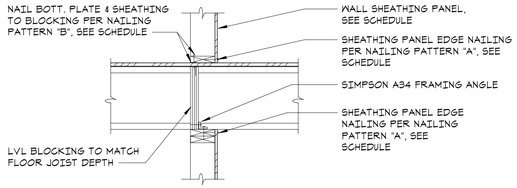

SECTION A

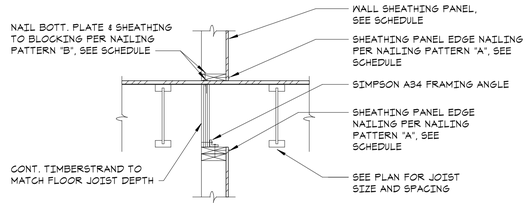

SECTION A

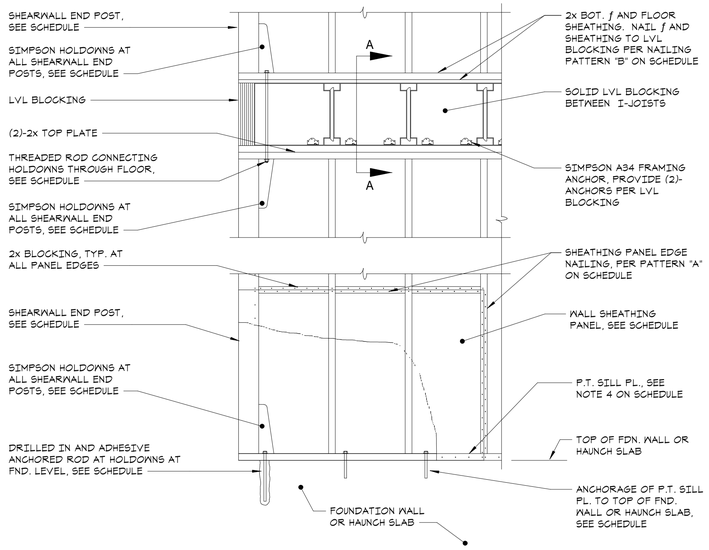

1 TYPICAL SHEAR WALL DETAIL PERPENDICULAR TO JOISTS
NO SCALE

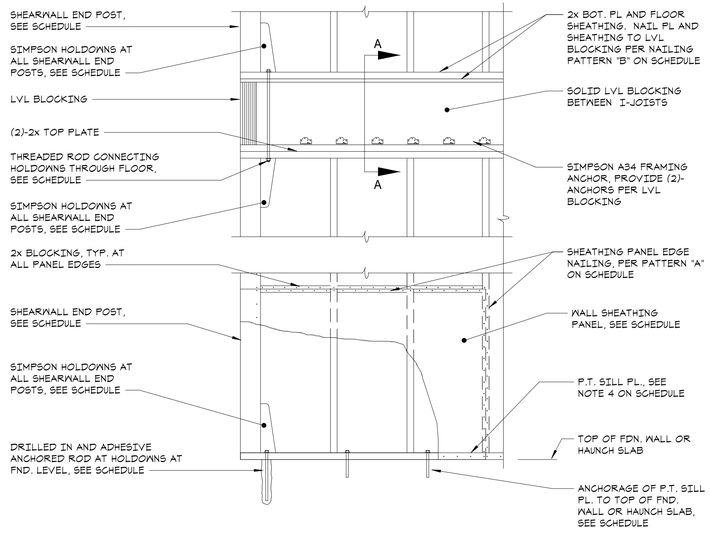

2 TYPICAL SHEAR WALL DETAIL PARALLEL TO JOISTS
NO SCALE

MARK	EXTERIOR / INTERIOR	SHEATHING PANEL		ANCHORAGE OF P.T. SILL TO TOP OF FOUNDATION WALL / FRAMED SLAB	NAILING PATTERN "A"	NAILING PATTERN "B"	SIMPSON HOLDOWN			
		THICKNESS	BOTH SIDES OF WALL		SHEATHING PANEL EDGES TO VERT. STUDS AND HORIZ. 2x BLOCKING	2x BOT. AND FLOOR SHEATHING TO LVL BLOCKING / LVL	MODEL	ANCHOR TO FOUNDATION /BEAM FLANGE BELOW	DRILLED IN AND EPOXY ANCHORED EMBEDMENT DEPTH (MIN.)	END POST SCREWS / SOLID WOOD POST SIZE (MIN.)
SW-1	EXT.	1/2"	N		8d AT 6" o.c.	8d AT 6" o.c.	HDU5-SDS2.5	5/8"Ø THREADED ROD		(14)-SDS 1/4"x2-1/2" (2)-2x6
SW-2	EXT.	1/2"	N	ANCHOR BOLTS PER "GENERAL NOTES & MATERIAL SPECIFICATIONS" SHEET	8d AT 4" o.c.	8d AT 4" o.c.	HDU8-SDS2.5	7/8"Ø THREADED ROD		(20)-SDS 1/4"x2-1/2" (3)-2x6

NOTES:

1. "ATR" INDICATES ALL THREADED ROD WITH NUT AND WASHER AT TOP.
2. SHEATHING PANELS SHALL BE PLYWOOD SHEATHING OF THE INDICATED THICKNESS, AND IN CONFORMANCE WITH THE "GENERAL NOTES AND MATERIAL SPECIFICATIONS" SHEET.
3. RIM BOARD MUST BE CONTINUOUS ACROSS THE EXTENT OF THE SHEARWALL.
4. NAILS INDICATED ARE TO BE COMMON NAILS, EXCEPT FOR THE NAILING OF PLYWOOD SHEATHING TO P.T. SILL PLATE SHALL BE GALVANIZED. ALL NAILS SHALL BE IN CONFORMACE WITH THE "GENERAL NOTES AND MATERIAL SPECIFICATIONS" SHEET.
5. HOLDOWNS INDICATED ARE TO BE LOCATED AT BOTH SHEARWALL END POSTS AND SHALL ANCHOR THE BOTTOM OF THE SHEARWALL END POST IN ONE OF THE FOLLOWING WAYS:
   A. AT FLOOR LEVELS, PROVIDE A MATCHING HOLDOWN AT THE TOP OF THE SHEARWALL BELOW AND CONNECT THROUGH THE FLOOR WITH A THREADED ROD OF THE INDICATED DIAMETER.
   B. AT FIRST FLOOR SHEARWALLS, ANCHOR TO THE STEEL BEAM WITH A THREADED ROD OF INDICATED DIAMETER
6. SEE "TYPICAL SHEARWALL DETAILS" THIS SHEET.

3 SHEARWALL SCHEDULE AND NOTES
NO SCALE

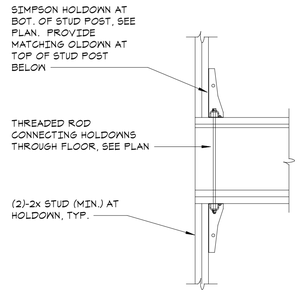

AT FLOOR LEVELS

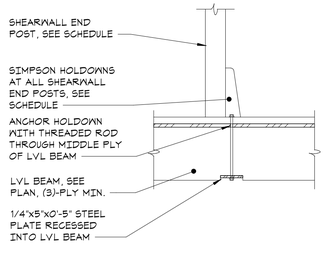

AT LVL BEAMS

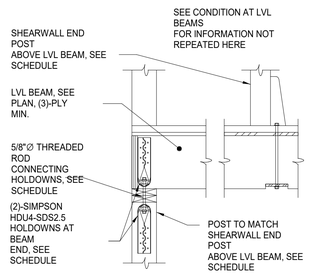

AT LVL BEAM ENDS

4 SECTION
3/4" = 1'-0"

The Di Salvo Engineering Group
Structural Engineers
405 S. Wilcox Street, Ste 210
Castle Rock, CO 80104
[720] 667-3388 | www.tdeg.com

COLORADO LICENSED EXPIRES: 6/30/27 GLENN T. HIGHT 53653 PROFESSIONAL ENGINEER

HELTSHE

M1A | MERIDIAN 105 ARCHITECTURE

CITY HOTEL
415 PERRY STREET, CASTLE ROCK, CO.

DATE: 4/22/26
PROJ. NO. 24603.00

ISSUED FOR:
1 Re-Issued for Permit

SHEET TITLE: TYPICAL WOOD FRAMING DETAILS

SHEET NUMBER S5.01

C:\Users\james\Documents\24603_City Hotel_struct_tdeg.rvt
4/22/2026 1:15:53 PM

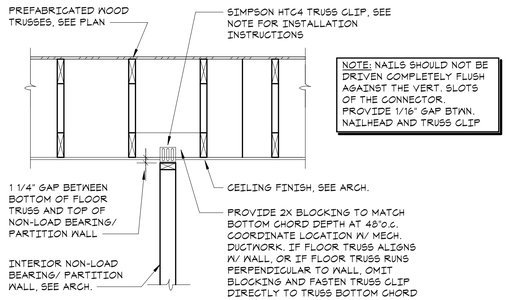

1 TYP NON-LOAD BEARING/PARTITION WALL TO FLOOR TRUSS CONNECTION
NO SCALE

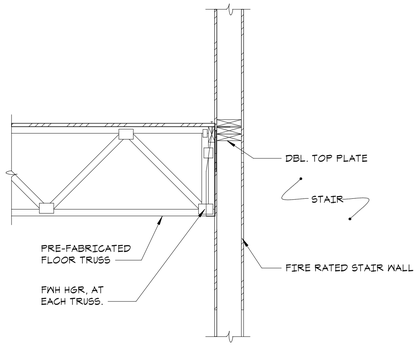

2 WOOD TRUSS AT FIREWALL DETAIL
NO SCALE

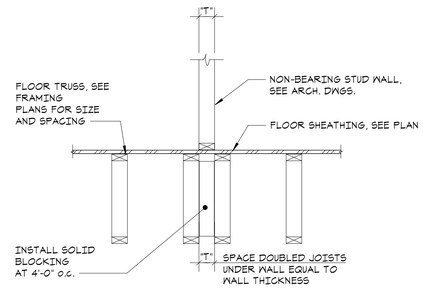

3 SECTION
3/4" = 1'-0"

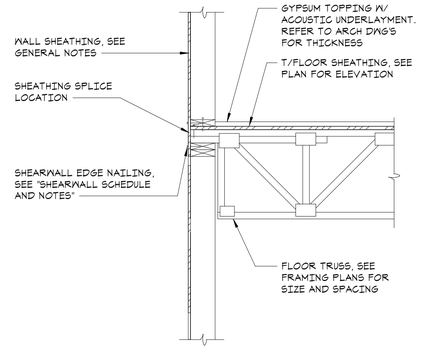

4 TYPICAL EXTERIOR WALL DETAIL
NO SCALE

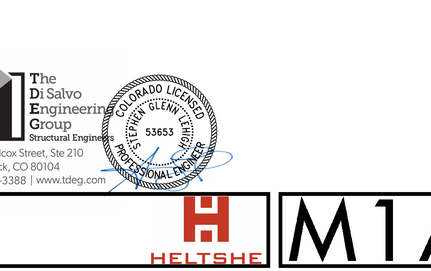

5 TYPICAL EXTERIOR WALL DETAIL
NO SCALE

6 TYPICAL INTERIOR BEARING WALL DETAIL BETWEEN UNITS
NO SCALE

7 PERPENDICULAR WOOD TRUSS AT ELEVATOR DETAIL
NO SCALE

8 PARALLEL WOOD TRUSS AT ELEVATOR DETAIL
NO SCALE

The Di Salvo Engineering Group
Structural Engineers
405 S. Wilcox Street, Ste 210
Castle Rock, CO 80104
[720] 667-3388 | www.tdeg.com

COLORADO LICENSED
STEPHEN GLENN LEHMAN
53653
PROFESSIONAL ENGINEER

HELTSHE

M1A | MERIDIAN 105 ARCHITECTURE

CITY HOTEL
415 PERRY STREET, CASTLE ROCK, CO.

DATE: 4/22/26
PROJ. NO. 24603.00

ISSUED FOR:
1 Re-Issued for Permit

SHEET TITLE:
TYPICAL WOOD FRAMING DETAILS

SHEET NUMBER
S5.02

4/22/2026 1:15:54 PM C:\Users\james\Documents\24603_City Hotel_struct_tdeg.rvt

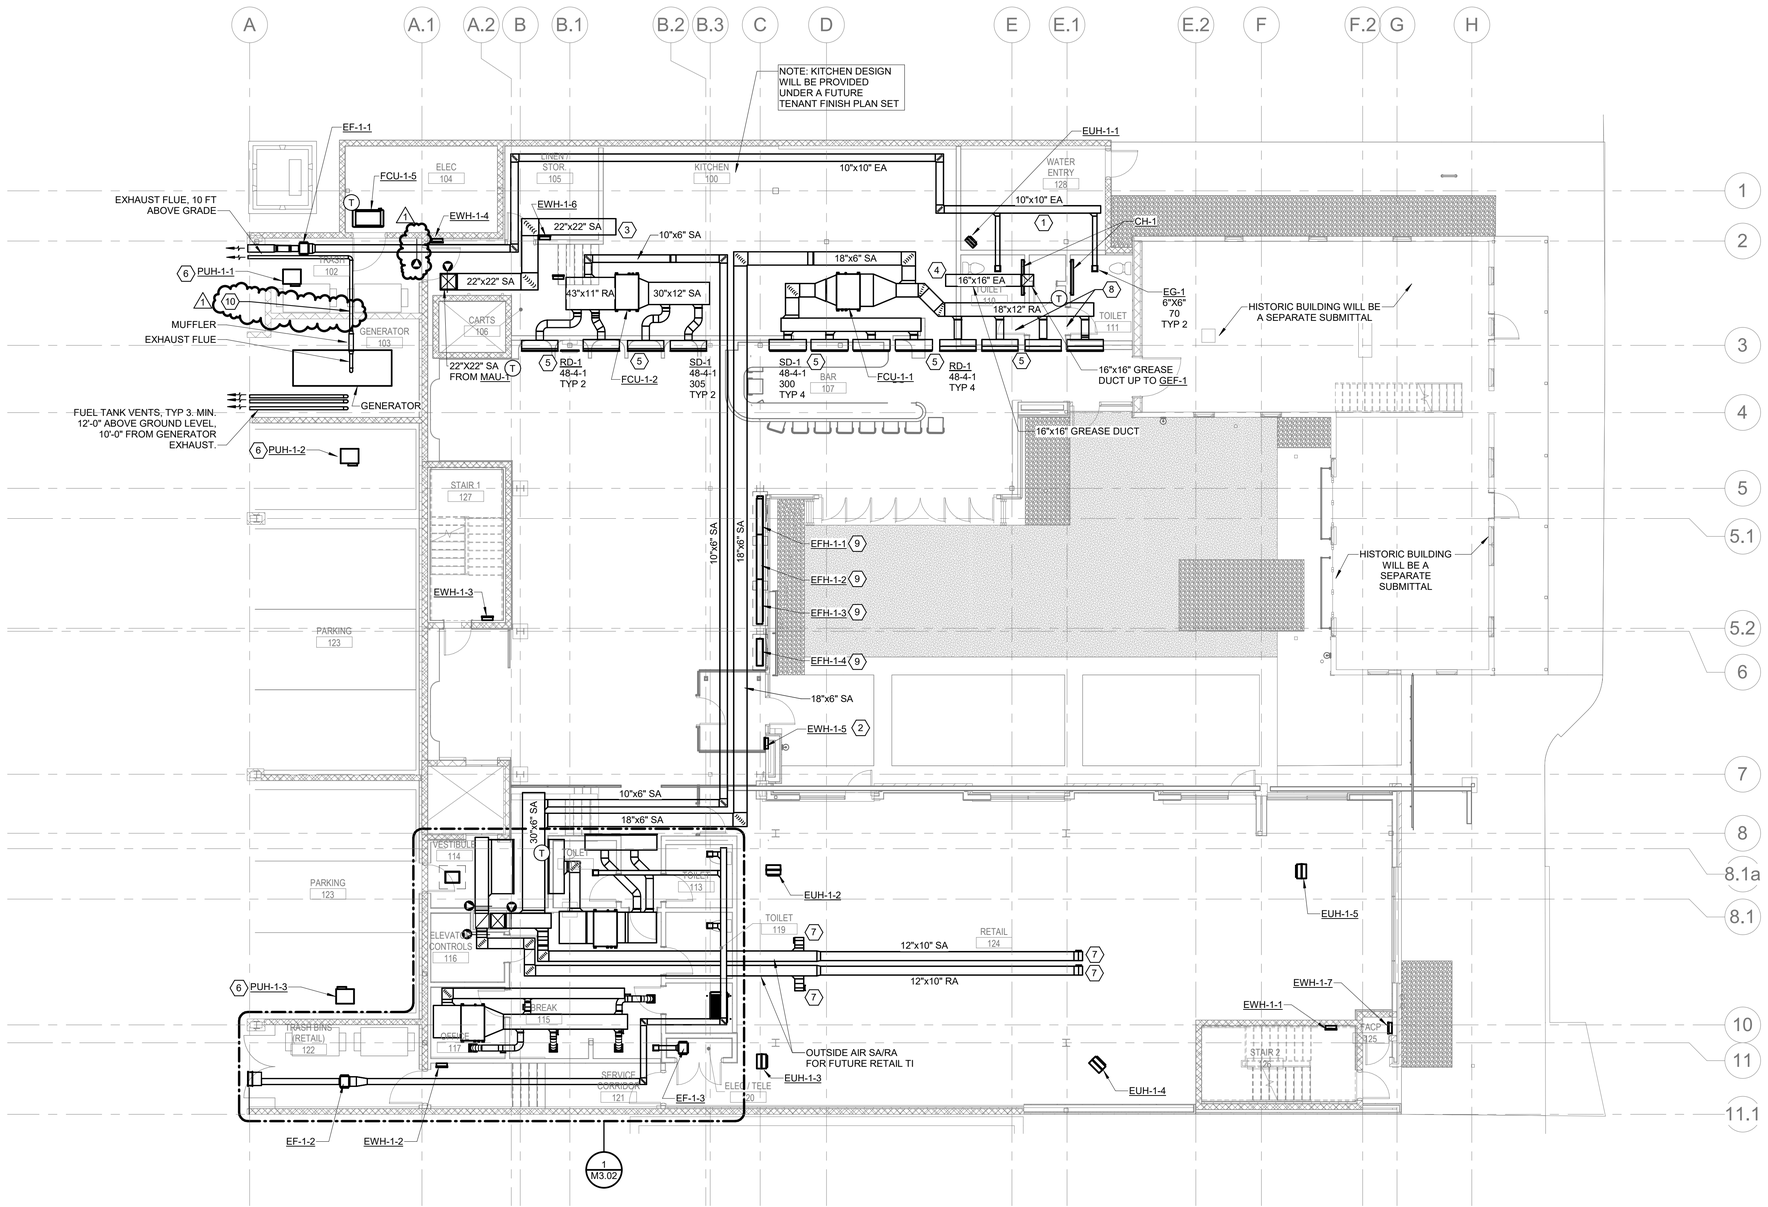

N

1 MECHANICAL PLAN - LEVEL 1

SCALE: 1/8" = 1'-0"

GENERAL NOTES

A. ALL WORK SHOWN SHALL COMPLY WITH ALL NATIONAL, STATE, AND LOCAL CODES AND ORDINANCES.

B. REFERENCE ALL OTHER DRAWINGS AND SPECIFICATIONS FOR ADDITIONAL WORK OR CLARIFICATION OF NECESSARY WORK.

C. ALL SUPPLY AIR DIFFUSERS IN HARD CEILINGS: PROVIDE DIFFUSERS WITH OPPOSED BLADE BALANCING DAMPERS.

D. COORDINATE DUCT ROUTING WITH EXISTING STRUCTURAL CONDITIONS PRIOR TO BID.

E. COORDINATE EXPOSED DUCT COLOR AND FINISH WITH ARCHITECT AND OWNER.

F. INSTALL EQUIPMENT ON MINIMUM 14" CURBS. COORDINATE WITH ARCHITECT FOR SCREENING REQUIREMENTS.

G. MAINTAIN INTEGRITY OF FIRE-RATED PARTITIONS WITH UL-LISTED FIRESTOP SYSTEM.

H. PROVIDE REFRIGERANT PIPING FROM OUTDOOR UNITS TO INDOOR UNITS PER MFR'S RECOMMENDATIONS. COORDINATE AVAILABILITY, PERFORMANCE, AND LENGTHS WITH MFR PRIOR TO BID. PROVIDE LINESETS OR HARD PIPE PER SPECIFICATIONS AS REQUIRED.

KEY NOTES

1. PROVIDE WITH 18"X18" ACCESS PANEL.
2. PROVIDE TEMPERATURE CONTROL RELAY, EMERSON MODEL 16E09 OR SIMILAR, FOR SECONDARY CONTROL OF HEATER. PROVIDE WITH REMOTE OUTSIDE AIR TEMPERATURE SENSOR (FIELD LOCATED). COORDINATE INSTALLATION WITH ELECTRICIAN WITH RELAY LINE VOLTAGE MATCHING THAT OF THE HEATER. UPON SENSING OUTDOOR TEMPERATURES GREATER THAN 45 DEG F HEATER SHALL BE DE-ENERGIZED.
3. 22"x22" SUPPLY AIR DUCT FROM MAU-1 STUBBED INTO KITCHEN SPACE FOR FUTURE KITCHEN TENANT FINISH BUILD OUT.
4. 16"x16" GREASE EXHAUST DUCT STUBBED INTO KITCHEN SPACE FOR FUTURE KITCHEN TENANT FINISH BUILD OUT. PROVIDE GREASE DUCT WITH 3M FIRE BARRIER DUCT WRAP. SEE GREASE DUCT WRAP DETAIL ON SHEET M0.05.
5. PROVIDE BLANK SLOT DIFFUSER SECTIONS TO CREATE A CONTINUOUS APPEARANCE. MOUNT BOTTOM OF DIFFUSERS AT 9'-10" AFF.
6. LOCATE PUH IN CEILING PLENUM ABOVE. MAINTAIN MANUFACTURER REQUIRED CLEARANCES AND SERVICE SPACE.
7. PROVIDE 12"x10" TAP AND DAMPER FOR FUTURE CONNECTION TO OUTSIDE AIR SYSTEM. BALANCE TO 400 CFM EA. DURING INITIAL TAB.
8. PROVIDE RESTROOM DOORS WITH 1" UNDERCUT FOR EXHAUST AIR MAKEUP.
9. EFH-X-X INSTALLED IN SLAB. UPPER CONVECTION GRILLE EQUAL TO PRICE LBP AND SHALL BE MATCHED TO DIMENSIONS OF FLOOR HEATER.
10. GENERATOR ENGINE EXHAUST TO BE ROUTED IN 2HR RATED ENCLOSURE. SEE ARCHITECTURAL PLANS FOR ENCLOSURE DETAILS. (1)

Ramirez, Johnson, & Associates
3301 Lawrence St. Ste 2
Denver, CO 80205
P: 720.598.5774

HELTSHE

M1A MERIDIAN 105 ARCHITECTURE

CITY HOTEL

415 PERRY STREET, CASTLE ROCK, CO.

DATE: 05.15.2025	ISSUED FOR: 1st PERMIT COMMENTS	SHEET TITLE: MECHANICAL PLAN - LEVEL 1	SHEET NUMBER M1.01
PROJ. NO. 2023.002			

COLORADO LICENSED
CLAYTON A. MYERS
43565
05/27/2026
PROFESSIONAL ENGINEER

5/15/2026 10:21:41 AM Autodesk Docs://2024-020 City Hotel/(2024) City Hotel - M&P .rvt

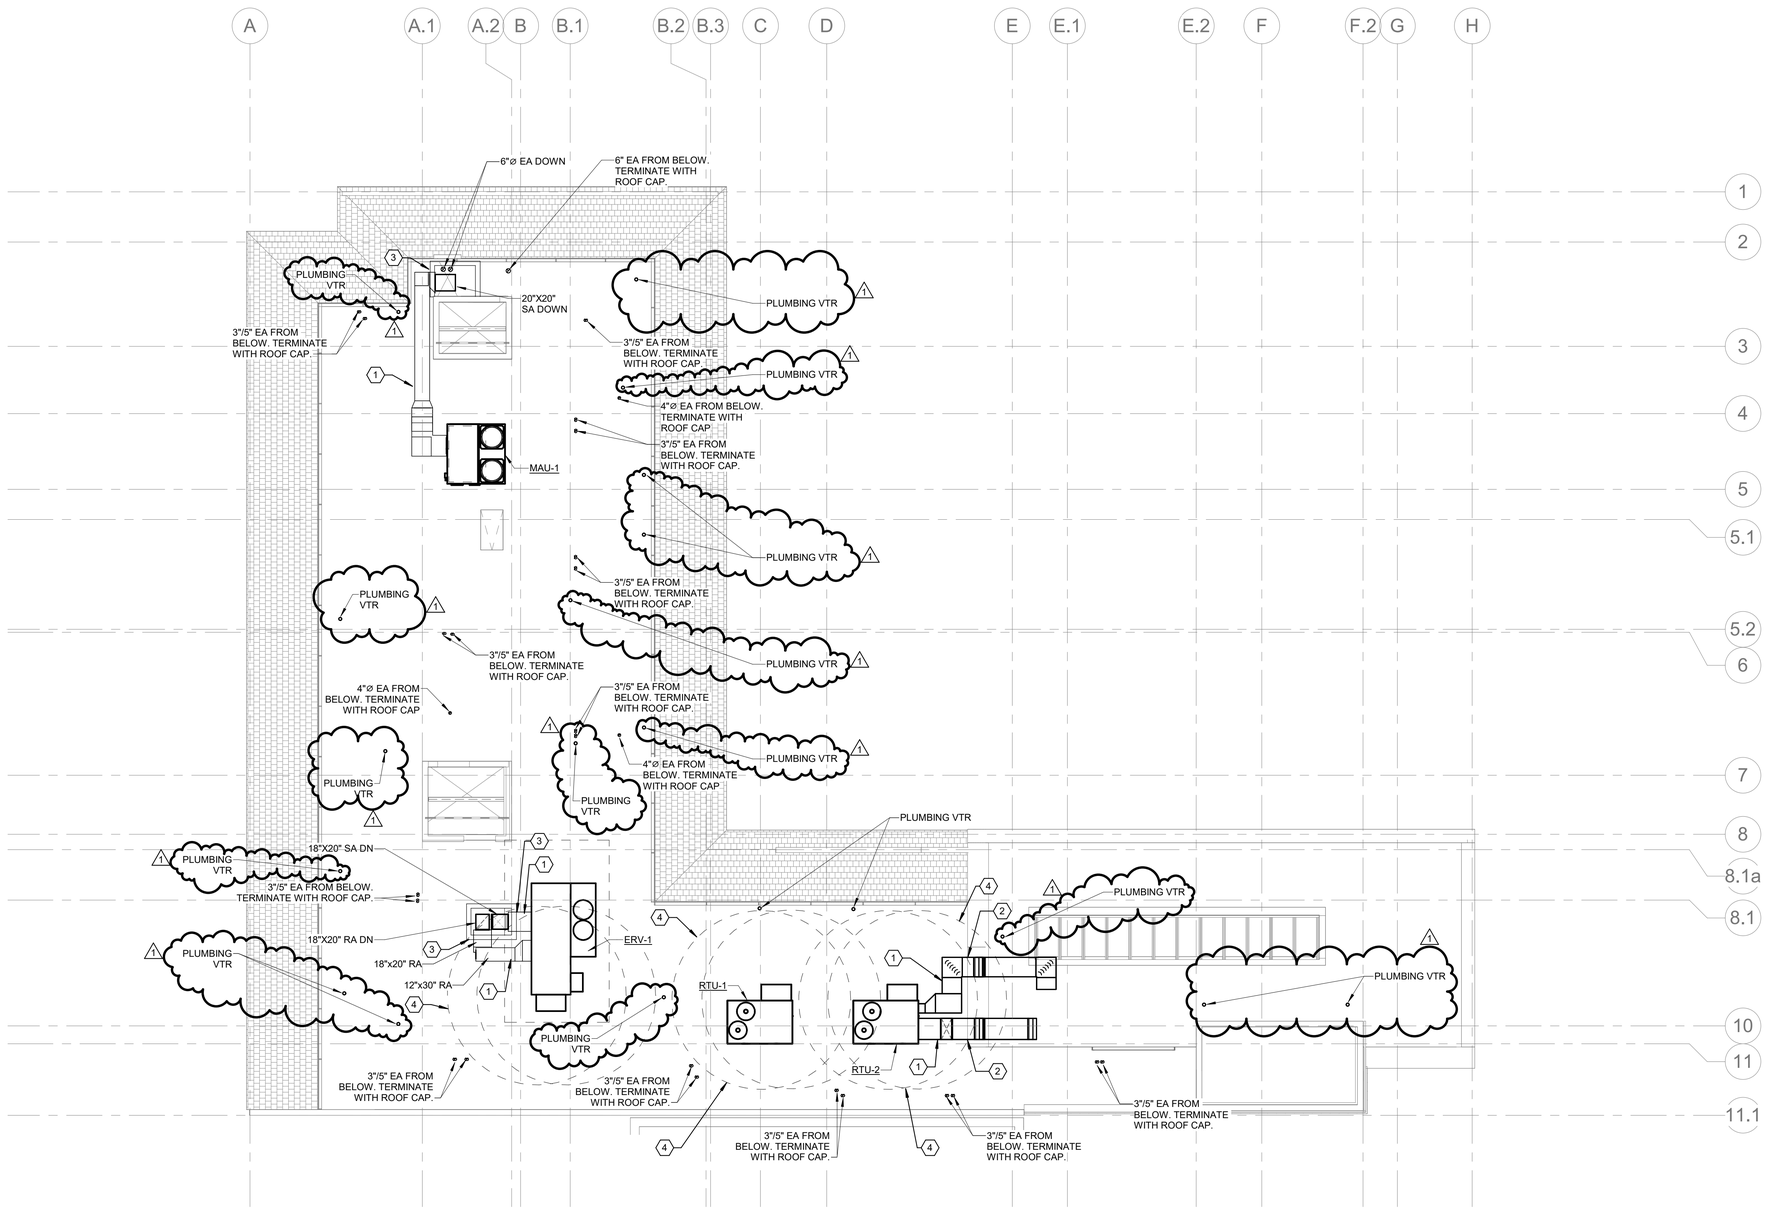

N

1 MECHANICAL PLAN - ROOF

SCALE: 1/8" = 1'-0"

GENERAL NOTES

A. ALL WORK SHOWN SHALL COMPLY WITH ALL NATIONAL, STATE, AND LOCAL CODES AND ORDINANCES.

B. REFERENCE ALL OTHER DRAWINGS AND SPECIFICATIONS FOR ADDITIONAL WORK OR CLARIFICATION OF NECESSARY WORK.

C. ALL SUPPLY AIR DIFFUSERS IN HARD CEILINGS: PROVIDE DIFFUSERS WITH OPPOSED BLADE BALANCING DAMPERS.

D. COORDINATE DUCT ROUTING WITH EXISTING STRUCTURAL CONDITIONS PRIOR TO BID.

E. COORDINATE EXPOSED DUCT COLOR AND FINISH WITH ARCHITECT AND OWNER.

F. INSTALL EQUIPMENT ON MINIMUM 14" CURBS. COORDINATE WITH ARCHITECT FOR SCREENING REQUIREMENTS.

G. MAINTAIN INTEGRITY OF FIRE-RATED PARTITIONS WITH UL-LISTED FIRESTOP SYSTEM.

H. PROVIDE REFRIGERANT PIPING FROM OUTDOOR UNITS TO INDOOR UNITS PER MFR'S RECOMMENDATIONS. COORDINATE AVAILABILITY, PERFORMANCE, AND LENGTHS WITH MFR PRIOR TO BID. PROVIDE LINESETS OR HARD PIPE PER SPECIFICATIONS AS REQUIRED.

KEY NOTES

1. ALL EXTERIOR DUCTWORK SHALL BE SMACNA PHENOLIC DUCT CONSTRUCTION (EQUAL TO THERMADUCT, R-12 INSULATED PANEL) WITH WHITE FINISH. INSTALL WITH DURABLOCK SUPPORT OR SIMILAR WITH MEMBRANE PROTECTION PAD BELOW.
2. DUCTWORK FROM ROOFTOP EQUIPMENT ENTERS INTO BUILDING THROUGH THE SIDEWALL FOR DISTRIBUTION INSIDE THE BUILDING. PROVIDE WITH FRAMED OPENING AND FLASH AND SEAL WEATHWER TIGHT. TRANSITION TO GALVANIZED DUCTING ON BUILDING INTERIOR.
3. PROVIDE RAISED CURB FOR DUCTS TO ENTER SHAFT THROUGH VERTICAL FACE. PROVIDE PENETRATIONS WITH FLASHING AND WATERPROOFING, SEE ARCHITECTURAL SHEETS FOR DETAILS. TRANSITION TO GALVANIZED DUCTING ON BUILDING INTERIOR.
4. MAINTAIN 10' CLEARANCE TO OUTSIDE AIR INTAKES FROM ANY EXHAUSTS, FLUES, OR VENTS.

Ramirez, Johnson, & Associates
2301 Lawrence St. Ste 2
Denver, CO 80205
P: 720.566.9774

HELTSHE

M1A | MERIDIAN 105 ARCHITECTURE

CITY HOTEL
415 PERRY STREET, CASTLE ROCK, CO.

DATE: 05.15.2025	ISSUED FOR: 1st PERMIT COMMENTS	SHEET TITLE: MECHANICAL PLAN - ROOF	SHEET NUMBER M1.05
PROJ. NO. 2023.002			

COLORADO LICENSED
GABRIELA RAMIREZ
43565
05/27/2026
PROFESSIONAL ENGINEER

5/15/2026 10:21:51 AM Autodesk Docs://2024-020 City Hotel/(2024) City Hotel - M&P.rvt

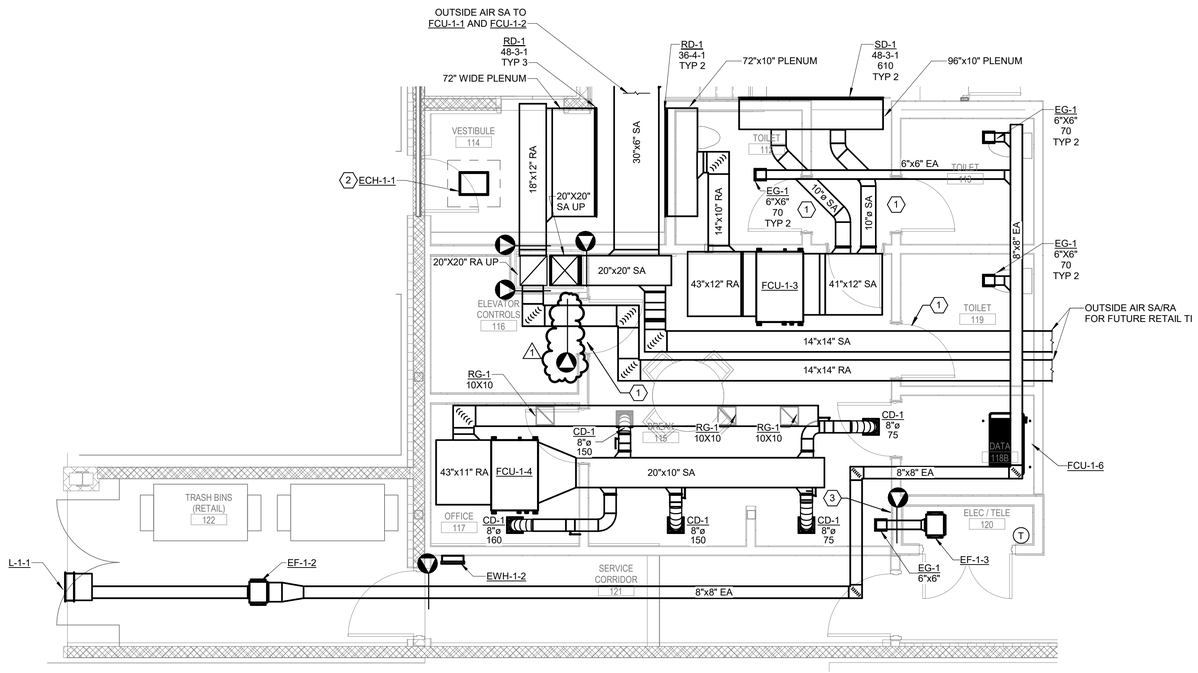

1 ENLARGED MECHANICAL PLAN - STAFF & SERVICE

SCALE: 1/4" = 1'-0"

GENERAL NOTES

A. ALL WORK SHOWN SHALL COMPLY WITH ALL NATIONAL, STATE, AND LOCAL CODES AND ORDINANCES.

B. REFERENCE ALL OTHER DRAWINGS AND SPECIFICATIONS FOR ADDITIONAL WORK OR CLARIFICATION OF NECESSARY WORK.

C. ALL SUPPLY AIR DIFFUSERS IN HARD CEILINGS: PROVIDE DIFFUSERS WITH OPPOSED BLADE BALANCING DAMPERS.

D. COORDINATE DUCT ROUTING WITH EXISTING STRUCTURAL CONDITIONS PRIOR TO BID.

E. COORDINATE EXPOSED DUCT COLOR AND FINISH WITH ARCHITECT AND OWNER.

F. INSTALL EQUIPMENT ON MINIMUM 14" CURBS. COORDINATE WITH ARCHITECT FOR SCREENING REQUIREMENTS.

G. MAINTAIN INTEGRITY OF FIRE-RATED PARTITIONS WITH UL-LISTED FIRESTOP SYSTEM.

H. PROVIDE REFRIGERANT PIPING FROM OUTDOOR UNITS TO INDOOR UNITS PER MFR'S RECOMMENDATIONS. COORDINATE AVAILABILITY, PERFORMANCE, AND LENGTHS WITH MFR PRIOR TO BID. PROVIDE LINESETS OR HARD PIPE PER SPECIFICATIONS AS REQUIRED.

KEY NOTES

1. UNDERCUT DOOR 1".
2. PROVIDE TEMPERATURE CONTROL RELAY, EMERSON MODEL 16E09 OR SIMILAR, FOR SECONDARY CONTROL OF HEATER. PROVIDE WITH REMOTE OUTSIDE AIR TEMPERATURE SENSOR (FIELD LOCATED). COORDINATE INSTALLATION WITH ELECTRICIAN WITH RELAY LINE VOLTAGE MATCHING THAT OF THE HEATER. UPON SENSING OUTDOOR TEMPERATURES GREATER THAN 45 DEG F HEATER SHALL BE DE-ENERGIZED.
3. PROVIDE TRANSFER GRILLE IN BREAK ROOM 6" AFF WITH FIRE/SMOKE DAMPER, ROUTED INTO ELECTRICAL ROOM.

Ramirez, Johnson, & Associates
3301 Lawrence St. Ste 2
Denver, CO 80205
P: 720.588.0774
HELTSHE
M1A MERIDIAN 105 ARCHITECTURE

CITY HOTEL

415 PERRY STREET, CASTLE ROCK, CO.

DATE: 05.15.2025	ISSUED FOR: 1st PERMIT COMMENTS	SHEET TITLE: ENLARGED MECHANICAL PLANS	SHEET NUMBER M3.02
PROJ. NO. 2023.002			

COLORADO LICENSED
JAIME RAMIREZ
43565
05/27/2026
PROFESSIONAL ENGINEER

5/15/2026 10:22:07 AM Autodesk Docs://2024-020 City Hotel/(2024) City Hotel - M&P.rvt

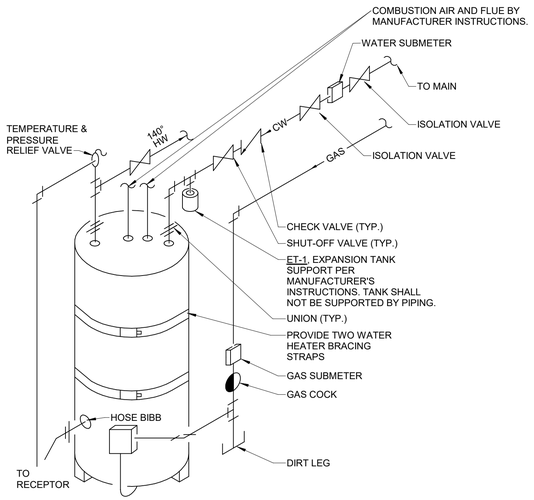

1 GAS WATER HEATER
SCALE: NO SCALE

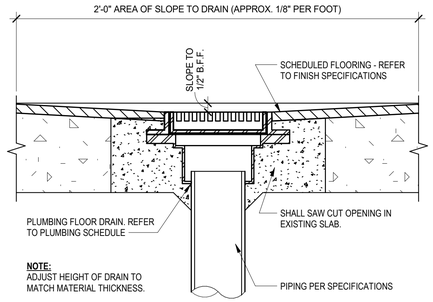

2 FLOOR DRAIN DETAIL
SCALE: NO SCALE

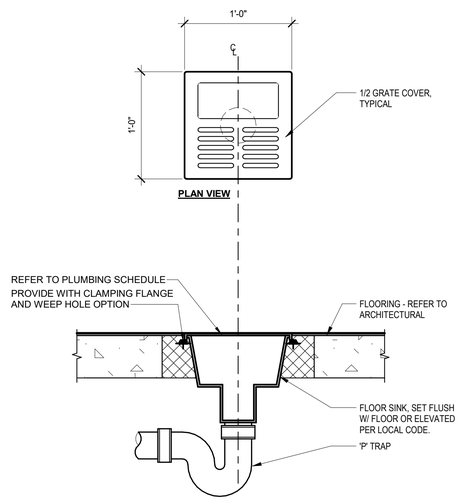

3 FLOOR SINK DETAIL
SCALE: NO SCALE

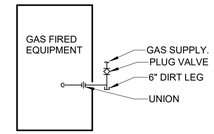

4 GAS FIRED EQUIPMENT PIPING DETAIL
SCALE: NO SCALE

HANGER ROD SCHEDULE			
PIPE SIZE	ROD SIZE	PIPE SIZE	ROD SIZE
UP TO 2"	3/8" DIA.	4" - 5"	5/8" DIA.
2 1/2 - 3"	1/2" DIA.	6" - 12"	7/8" DIA.

5 PIPE HANGER DETAIL
SCALE: NO SCALE

TOTAL WATER CAP. APPROX. (GALLONS)	GREASE CAP. APPROX. (CU. FT.)	DIMENSIONS (INCHES)						
		W	L	A	B	C	D	E
2500	67	72	142	94	48	56	54	44

6 GREASE INTERCEPTOR DETAIL
SCALE: NO SCALE

Ramirez, Johnson, & Associates
3301 Lawrence St. Ste 2
Denver, CO 80202
P: 720.565.9774
HELTSHE
M1A | MERIDIAN 105 ARCHITECTURE

CITY HOTEL
415 PERRY STREET, CASTLE ROCK, CO.

DATE: 05.15.2025
PROJ. NO. 2023.002
ISSUED FOR: 1st PERMIT COMMENTS
SHEET TITLE: PLUMBING DETAILS AND DIAGRAMS

COLORADO LICENSED
JOSHUA RAMIREZ
43565
05/27/2026
PROFESSIONAL ENGINEER

SHEET NUMBER
P0.01

5/15/2026 10:22:09 AM Autodesk Docs://2024-020 City Hotel/(2024) City Hotel - M&P.rvt

PLUMBING FIXTURES

TAG	MANUFACTURER AND MODEL NUMBER	DESCRIPTION	CW	HW	SAN	V
GWH-1,2	A.O. SMITH CYCLONE BTHL-400A	NATURAL GAS WATER HEATER, HIGH VOLUME, 119 GAL, 400 MBH INPUT, 460 GPH RECOVERY AT 100F RISE. POWER DIRECT ENT. 120/1/60, 5A. PROVIDE WITH MANUFACTURER'S CONCENTRIC VENT KIT AND COMMON VENT KIT, VACUUM BREAKER, T&P VALVE AND HEAT TRAPS. PROVIDE CONDENSATE NEUTRALIZER AXOIM NC-1 OR EQUAL AND MV MIXING VALVE.	1-1/2"	1-1/2"	-	-
GWH-3	A.O. SMITH BTXL-11	NATURAL GAS WATER HEATER, 75 GAL, 100 MBH INPUT, 115 GPH RECOVERY AT 100F RISE. POWER DIRECT ENT. 120/1/60, 5A. PROVIDE WITH MANUFACTURER'S CONCENTRIC VENT KIT AND COMMON VENT KIT, VACUUM BREAKER, T&P VALVE AND HEAT TRAPS. PROVIDE CONDENSATE NEUTRALIZER AXOIM NC-1 OR EQUAL AND MV MIXING VALVE.	1-1/2"	1-1/2"	-	-
ET-1	AMTROL ST-80V-C	INLINE THERMAL EXPANSION TANK. TANK VOLUME 53 GAL WITH 0.66 ACCEPTANCE FACTOR.	1/2"	-	-	-
HWCP-1	BELL & GOSSETT ECOCIRC 20-18	HOT WATER RECIRCULATION PUMP WITH INTEGRAL TIMER/THERMOSTAT AT CONTROL, 4.25 GPM AT 8.0 FT H2O. 120/1, 14W.	-	3/4"	-	-
HWCP-2	BELL & GOSSETT ECOCIRC 20-18	HOT WATER RECIRCULATION PUMP WITH INTEGRAL TIMER/THERMOSTAT AT CONTROL, 4.25 GPM AT 8.0 FT H2O. 120/1, 10W.	-	3/4"	-	-
DBP-1	GRUNDFOS MPC-E3-CRE	DOMESTIC WATER BOOSTER PUMP PACKAGE, 180 GPM @ 92.4 FT H2O, 5HP, 208/3/60. PROVIDE WITH INTEGRAL VFD CONTROL PANEL.	2-1/2"	-	-	-
FS-1	JOSAM 49320	12"X12"X6" CAST IROM FLOOR SINK WITH 1/2 GRATE, PORCELAIN COATING WITH DOME STRAINER. PROVIDE SURE SEAL TRAP GUARD.	-	-	2"	2"
FD-1	JOSAM 30000	5" ROUND FLOOR DRAIN, ADJUSTABLE C.I. BODY WITH NICKEL ALLOY TOP. PROVIDE SURE SEAL TRAP GUARD.	-	-	2"	2"
FD-2	JOSAM 32200	9" ROUND FLOOR DRAIN, ADJUSTABLE C.I. BODY WITH CAST IRON TRACTOR GRATE TOP. PROVIDE SURE SEAL TRAP GUARD.	-	-	2"	2"
RPZ-1	WATTS LF009	REDUCED PRESSURE ZONE ASSEMBLY WITH ISOLATION VALVES AND AIR GAP FITTING.	2"	-	-	-
RPZ-2	WATTS LF009	REDUCED PRESSURE ZONE ASSEMBLY WITH ISOLATION VALVES AND AIR GAP FITTING.	1"	-	-	-
BFP-1	WATTS SD-2	DUAL CHECK VALVE WITH ATMOSPHERIC VENT, ASSE 1032 LISTED.	1/2"	-	-	-
TMV-1	WATTS LFUSGB	THERMOSTATIC MIXING VALVE FOR POINT OF USE, ASSE 1070 LISTED.	3/8"	3/8"	-	-
WB-1	WATER-TITE 85738	PLASTIC WASHER BOX. PROVIDE WITH HOT WATER AND COLD WATER PEX CONNECTIONS AND WATER HAMMER ARRESTORS WITH QUARTER TURN VALVES. PROVIDE FIRE RATED BOX WHERE REQUIRED.	1/2"	1/2"	2"	SEE PLANS
MS-1	⚠1 MUSTEE 63M	24"X24"X10" MOLDED FIBERGLASS MOP SINK WITH 63.600A FAUCET W/ VACUUM BREAKER, STAINLESS STEEL WALL GUARDS AND MOP HOOKS.	3/4"	3/4"	3"	2"
HB-1	WOODFORD 65	FREEZEPROOF WALL HYDRANT WITH VACUUM BREAKER, COORDINATE STEM LENGTH WITH WALL THICKNESS.	3/4"	-	-	-
WC-1	TOTO CST746CEM	ADA, VITREOUS CHINA FLOOR MOUNTED FLUSH TANK WATER CLOSET, 1.28 GPF. CONTRACTOR TO VERIFY TRIP LEVER LOCATION.	1/2"	-	4"	2"
WC-2	TOTO CST746CEM	VITREOUS CHINA FLOOR MOUNTED FLUSH TANK WATER CLOSET, 1.28 GPF.	1/2"	-	4"	2"
UR-1	TOTO UT104E / TOTO TEU1LA	VITREOUS CHINA URINALWITH 0.125 GPF SELF POWERED, HYDROELECTRIC OPERATED FLUSH VALVE. PROVIDE WALL CARRIER.	3/4"	-	2"	1-1/2"
L-1	BRIZO LITZE 65334LF-BLLHP BRIZO LITZE HL5339-BL	KOHLER SOHO WHITE VITREOUS CHINA WALL MOUNTED LAVATORY WITH GRID STRAINER AND CONCEALED WALL CARRIER. PROVIDE TMV-1 AND TRUEBRO LAV GUARDS. POLISHED CHROME SINGLE CONTROL MANUAL FAUCET.	1/2"	1/2"	1-1/2"	1-1/4"
AAV-1	STUDOR MINI-VENT	AIR ADMITTANCE VALVE WITH RECESSED ROUGH-IN BOX AND GRILLE.	-	-	-	SEE PLANS
IMB-1	GUY GREY MIB 1AB	WHITE POWDER COATED STEEL RECESSED ICE MAKER BOX WITH LEAD FREE QUARTER-TURN STOP VALVE.	1/2"	-	-	-
GI-1	COPELAND 2000 GALLON INTERCEPTOR	2000 GALLON CONCRETE PRECAST SAND-OIL INTERCEPTOR. RE DETAIL FOR MORE INFORMATION.	1/2"	-	SEE PLANS	-

NOTES:
SIZES SHOWN ARE MINIMUM PIPE SIZES TO A SINGLE FIXTURE. MINIMUM PIPE SIZE TO 2 OR MORE FIXTURES IS 3/4". ALL FIXTURES LISTED ARE NOT NECESSARILY USED ON THIS PROJECT. ⚠1

PLUMBING FIXTURES - GUEST ROOMS

TAG	MANUFACTURER AND MODEL NUMBER	DESCRIPTION	CW	HW	W	V
WC-1	SWISS MADISON SM-1T259	VITREOUS CHINA FLOOR MOUNTED DUAL FLUSH TANK WATER CLOSET, 1.1/1.6 GPF. PROVIDE WITH CHROME TRIP LEVER.	1/2"	-	3"	2"
L-1	BRIZO LITZE 65334LF-BLLHP	CUSTOM FREESTANDING STONETOP VANITY WITH UNDERMOUNT LAVATORY WITH GRID STRAINER. PROVIDE TRUEBRO LAV GUARDS FOR ACCESSIBLE UNITS. MATTE BLACK DUAL HANDLE MANUAL FAUCET WITH 0.5 GPM AERATOR. PROVIDE WITH BLACK DRAIN AND ACCESSORIES UNDER LAVATORY.	1/2"	1/2"	1-1/2"	1-1/4"
SH-1	BRIZO LITZE 81398-GL BRIZO T60235-BLGLLHP BRIZO BT062415-BL	SHOWER SURROUND BY OTHERS. PRESSURE BALANCE SHOWER VALVE TRIM; SOLID BRASS FORGED BODY; 1.75 GPM MAXIMUM RAINCAN SHOWERHEAD. WATERSENSE COMPLIANT.	1/2"	1/2"	2"	2"

NOTES:
SIZES SHOWN ARE MINIMUM PIPE SIZES TO A SINGLE FIXTURE. MINIMUM PIPE SIZE TO 2 OR MORE FIXTURES IS 3/4". ALL FIXTURES LISTED ARE NOT NECESSARILY USED ON THIS PROJECT.
MANUFACTURER AND MODEL NUMBER AND PROVIDED FOR PERFORMACNE CRITERIA. FINAL SELECTIONS BY OWNER/ARCHITECT.

PIPING APPLICATION SCHEDULE

SERVICE	LOCATION	PIPE	FITTING	NOTES
DOMESTIC COLD/HOT WATER	OUTDOOR (BELOW GRADE)	TYPE K COPPER	COPPER SOLDER JOINT FITTINGS ASME B16.22	
DOMESTIC COLD/HOT WATER	INDOOR (ABOVE GRADE)	TYPE L OR TYPE M COPPER	WROUGHT COPPER SOLDER JOINT FITTINGS ASME B16.22	
HYDRONIC SUPPLY & RETURN	INDOOR (ABOVE GRADE)	SCHED 40 BLACK STEEL	150 LB MALLEABLE IRON (THREADED OR WELDED)	
		ASTM B 88, TYPE L COPPER	WROUGHT COPPER JOINT FITTINGS	
DOMESTIC COLD/HOT WATER	INDOOR (ABOVE GRADE)	TYPE A PEX DISTRIBUTION SYSTEM ASTEM F876, CROSSLINKED POLYETHYLENE (ENGEL METHOD), SDR 9 TUBING	ASTM F 1960, COLD EXPANSION FITTINGS WITH PEX REINFORCING RINGS.	ACCEPTABLE FOR PIPING 1" AND SMALLER WITHIN THE DWELLING UNITS.
SANITARY WASTE	BELOW GRADE	SOLID WALL PVC	PVC SOCKET FITTING ASTM D 2665	
SANITARY WASTE AND VENT	ABOVE GRADE	SOLID WALL PVC	PVC SOCKET FITTING ASTM D 2665	
CONDENSATE AND EQUIPMENT DRAINS	ABOVE GRADE	TYPE M OR DMV COPPER	CAST COPPER SOLDER JOINT FITTINGS ASME B16.23.	

PIPING INSULATION SCHEDULE

SERVICE	NOMINAL PIPE SIZE		
	< 1-1/2"	1-1/2" < 4"	6" < 8"
	INSULATION THICKNESS		
DOMESTIC COLD WATER	1"	1-1/2"	-
DOMESTIC HOT / RECIRCULATION WATER	1"	1-1/2"	-

NOTES:
1 ALL PIPING SHALL BE INSULATED AS REQUIRED BY APPLICABLE IECC.
2 INSULATION NOT REQUIRED FOR PIPING CONVEYING FLUIDS WITH A DESIGN OPERATING TEMPERATURE BETWEEN 60°F AND 105°F.
3 INSULATION THICKNESS BASED ON CONDUCTIVITY (K-VALUE) NOT EXCEEDING 0.27.
4 INSULATION EXPOSED TO WEATHER SHALL BE JACKETED WITH 0.016" ALUMINUM.

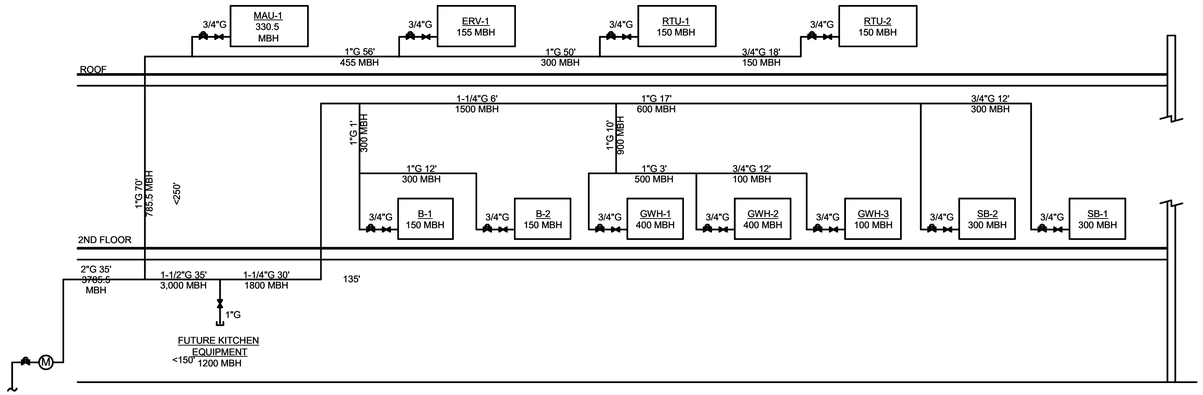

GAS PIPING SIZED FOR 2.0 PSI
MAXIMUM ALLOWABLE PRESSURE DROP OF 1.0 PSI
TOTAL DEVELOPED LENGTH OF < 250'
PER IFGC TABLE 402.4(5)

TOTAL CONNECTED LOAD: 3,785.5 MBH

2 NATURAL GAS RISER DIAGRAM
SCALE: NO SCALE

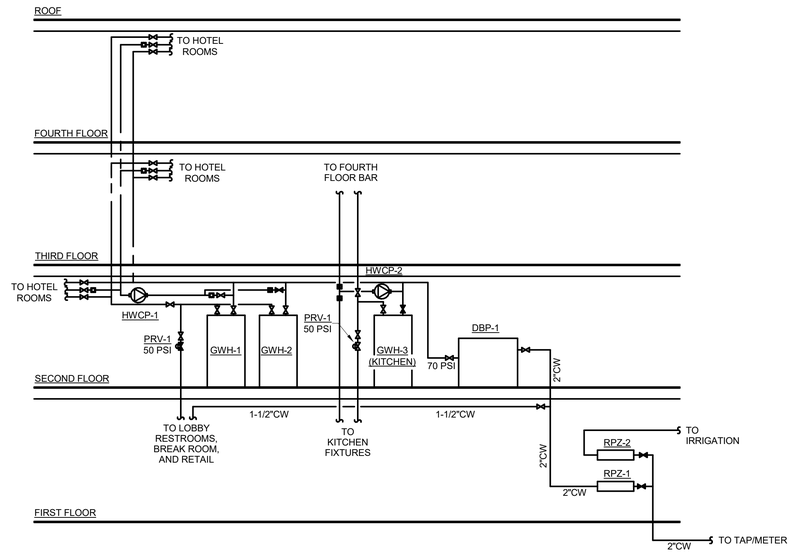

1 WATER RISER DIAGRAM
SCALE: NO SCALE

Autodesk Docs://2024-020 City Hotel/(2024) City Hotel - M&P.rvt
5/15/2026 10:22:10 AM

Ramirez, Johnson, & Associates
3301 Lawrence St. Ste 2
Denver, CO 80205
P: 720.588.0774
HELTSHE
M1A MERIDIAN 105 ARCHITECTURE

CITY HOTEL
415 PERRY STREET, CASTLE ROCK, CO.

DATE: 05.15.2025
PROJ. NO. 2023.002
ISSUED FOR: 1st PERMIT COMMENTS
SHEET TITLE: PLUMBING SCHEDULES AND DIAGRAMS

COLORADO LICENSED
JAIME RAMIREZ
43565
05/27/2026
PROFESSIONAL ENGINEER

SHEET NUMBER
P0.02

GENERAL NOTES

A. ALL WORK SHOWN SHALL COMPLY WITH ALL NATIONAL, STATE, AND LOCAL CODES AND ORDINANCES.

B. REFERENCE ALL OTHER DRAWINGS AND SPECIFICATIONS FOR ADDITIONAL WORK OR CLARIFICATION OF NECESSARY WORK.

C. VERIFY INVERT ELEVATIONS AND SLOPES PRIOR TO BID.

D. VISIBLE EQUIPMENT AND APPLIANCE DRAINS SHALL BE COPPER PER PIPING APPLICATION SCHEDULE.

E. MAINTAIN INTEGRITY OF FIRE-RATED PARTITIONS WITH UL-LISTED FIRESTOP SYSTEM.

F. REFER TO STRUCTURAL PLANS AND SPECIFICATIONS FOR DETAILS. PRIOR TO START OF WORK, COORDINATE ALL CLEARANCES TO STRUCTURAL FOOTINGS AND PIERS, PIPING PENETRATIONS, SLEEVES, AND BLOCKOUTS WITH STRUCTURAL PLANS.

KEY NOTES

1. ELEVATOR SUMP PUMP. ROUTE 2"PD TO FLOOR SINK.
2. 4" GW PROVIDED FOR FUTURE KITCHEN TENANT FINISH.

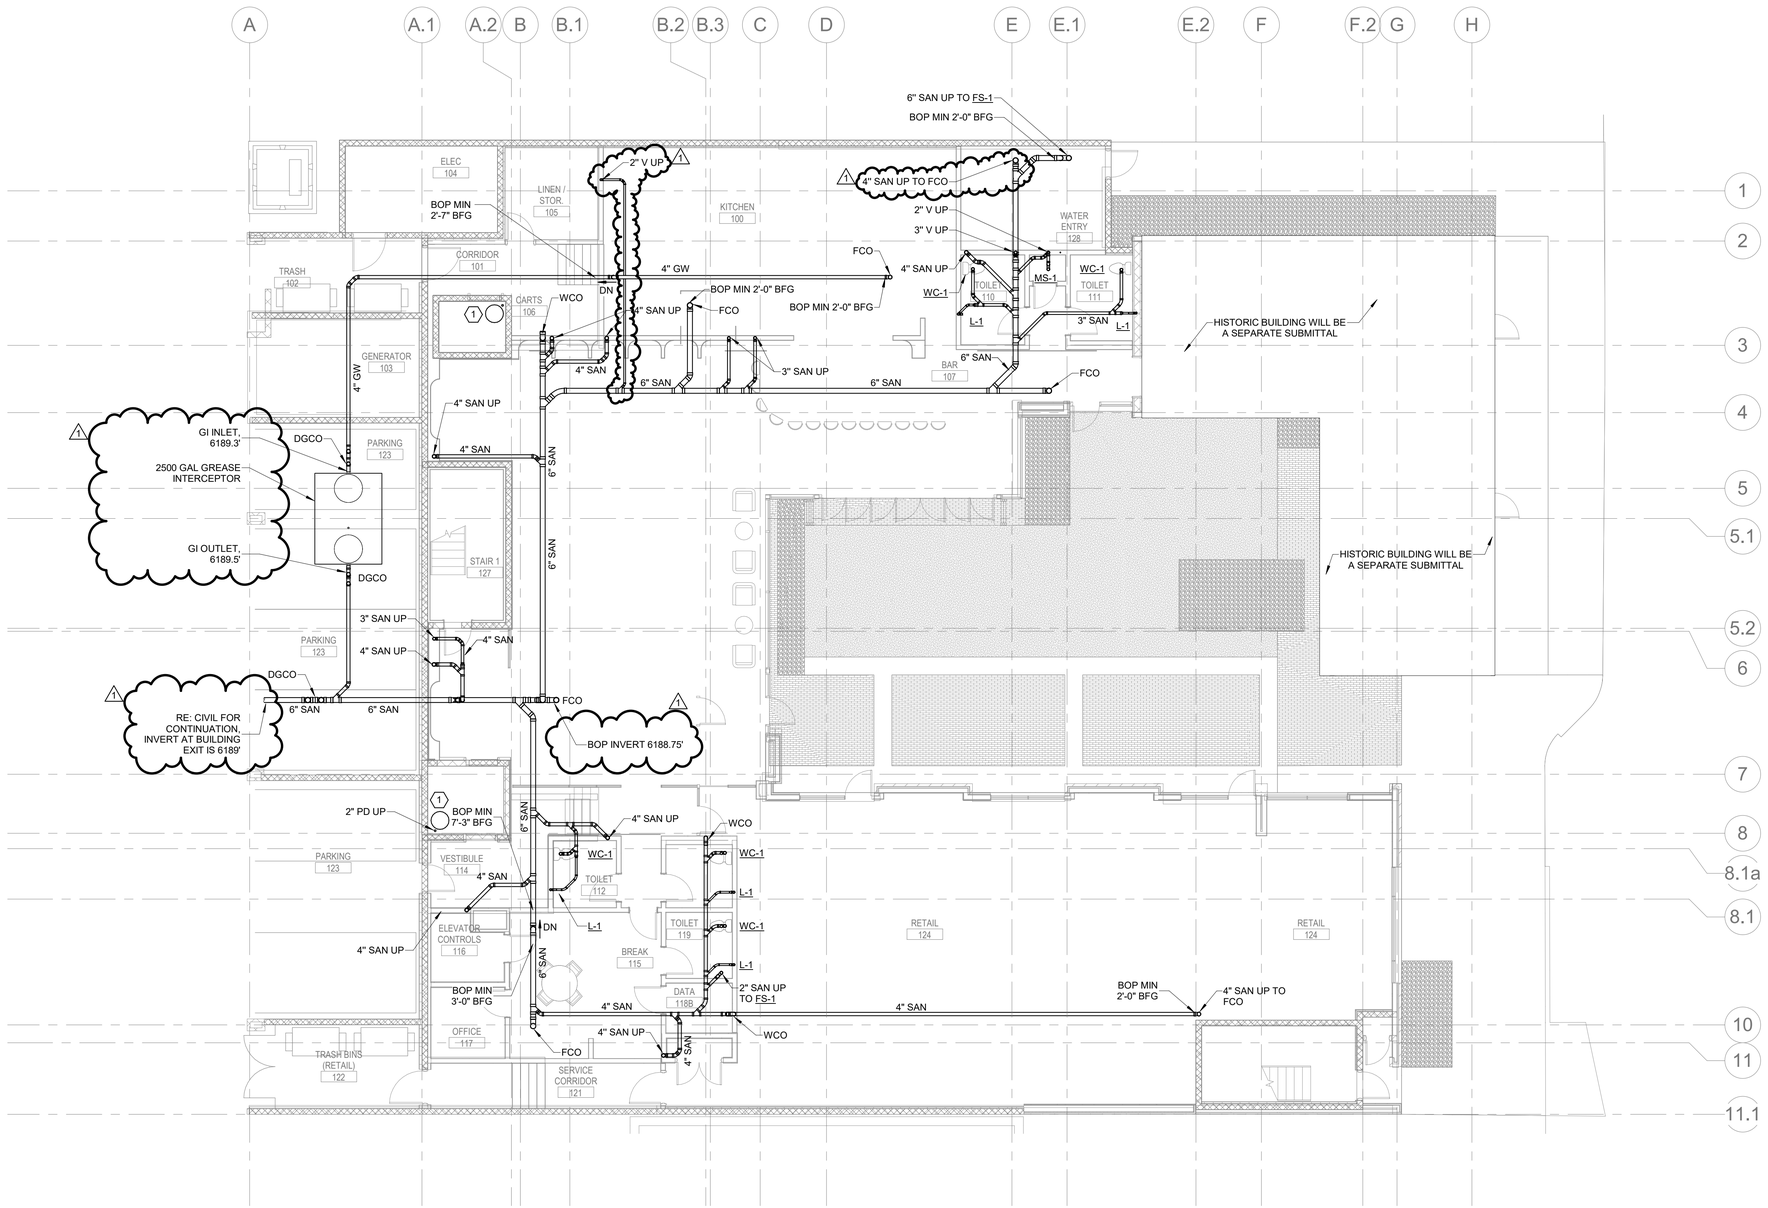

N

1 SANITARY WASTE AND VENT PLAN - UNDERGROUND

SCALE: 1/8" = 1'-0"

Autodesk Docs://2024-020 City Hotel/(2024) City Hotel - M&P.rvt
5/15/2026 2:36:03 PM

Ramirez, Johnson, & Associates
3301 Lawrence St. Ste 2
Denver, CO 80205
P: 720.598.0774
HELTSHE
M1A | MERIDIAN 105 ARCHITECTURE

CITY HOTEL

415 PERRY STREET, CASTLE ROCK, CO.

DATE: 05.15.2025	ISSUED FOR: 1st PERMIT COMMENTS	SHEET TITLE: UNDERGROUND SANITARY WASTE PLANS	SHEET NUMBER P1.00
PROJ. NO. 2023.002			

COLORADO LICENSED
SABRA MIRFENDERESKI
43565
05/27/2026
PROFESSIONAL ENGINEER

GENERAL NOTES

A. ALL WORK SHOWN SHALL COMPLY WITH ALL NATIONAL, STATE, AND LOCAL CODES AND ORDINANCES.

B. REFERENCE ALL OTHER DRAWINGS AND SPECIFICATIONS FOR ADDITIONAL WORK OR CLARIFICATION OF NECESSARY WORK.

C. VERIFY INVERT ELEVATIONS AND SLOPES PRIOR TO BID.

D. VISIBLE EQUIPMENT AND APPLIANCE DRAINS SHALL BE COPPER PER PIPING APPLICATION SCHEDULE.

E. MAINTAIN INTEGRITY OF FIRE-RATED PARTITIONS WITH UL-LISTED FIRESTOP SYSTEM.

F. REFER TO STRUCTURAL PLANS AND SPECIFICATIONS FOR DETAILS. PRIOR TO START OF WORK, COORDINATE ALL CLEARANCES TO STRUCTURAL FOOTINGS AND PIERS, PIPING PENETRATIONS, SLEEVES, AND BLOCKOUTS WITH STRUCTURAL PLANS.

G. SANITARY PIPING IS SHOWN IN CEILING OF THIS LEVEL.

KEY NOTES

1. SANITARY PIPE TO BE ROUTED IN FURRED OUT 2X6 WALL.
2. ROUTE 3/4" CONDENSATE PIPE DOWN IN WALL AND CONNECT TO LAVATORY TAILPIECE.
3. FOR ALL CONDENSATE, AND WASTE PIPING ABOVE ELECTRICAL ROOM, MAINTAIN MIN 12" HORIZONTAL CLEARANCE TO ELECTRICAL PANELS AND GEAR BELOW.
4. ROUTE 2" PD DOWN IN WALL, TERMINATE 2" PD TO FLOOR SINK WITH AIR GAP.

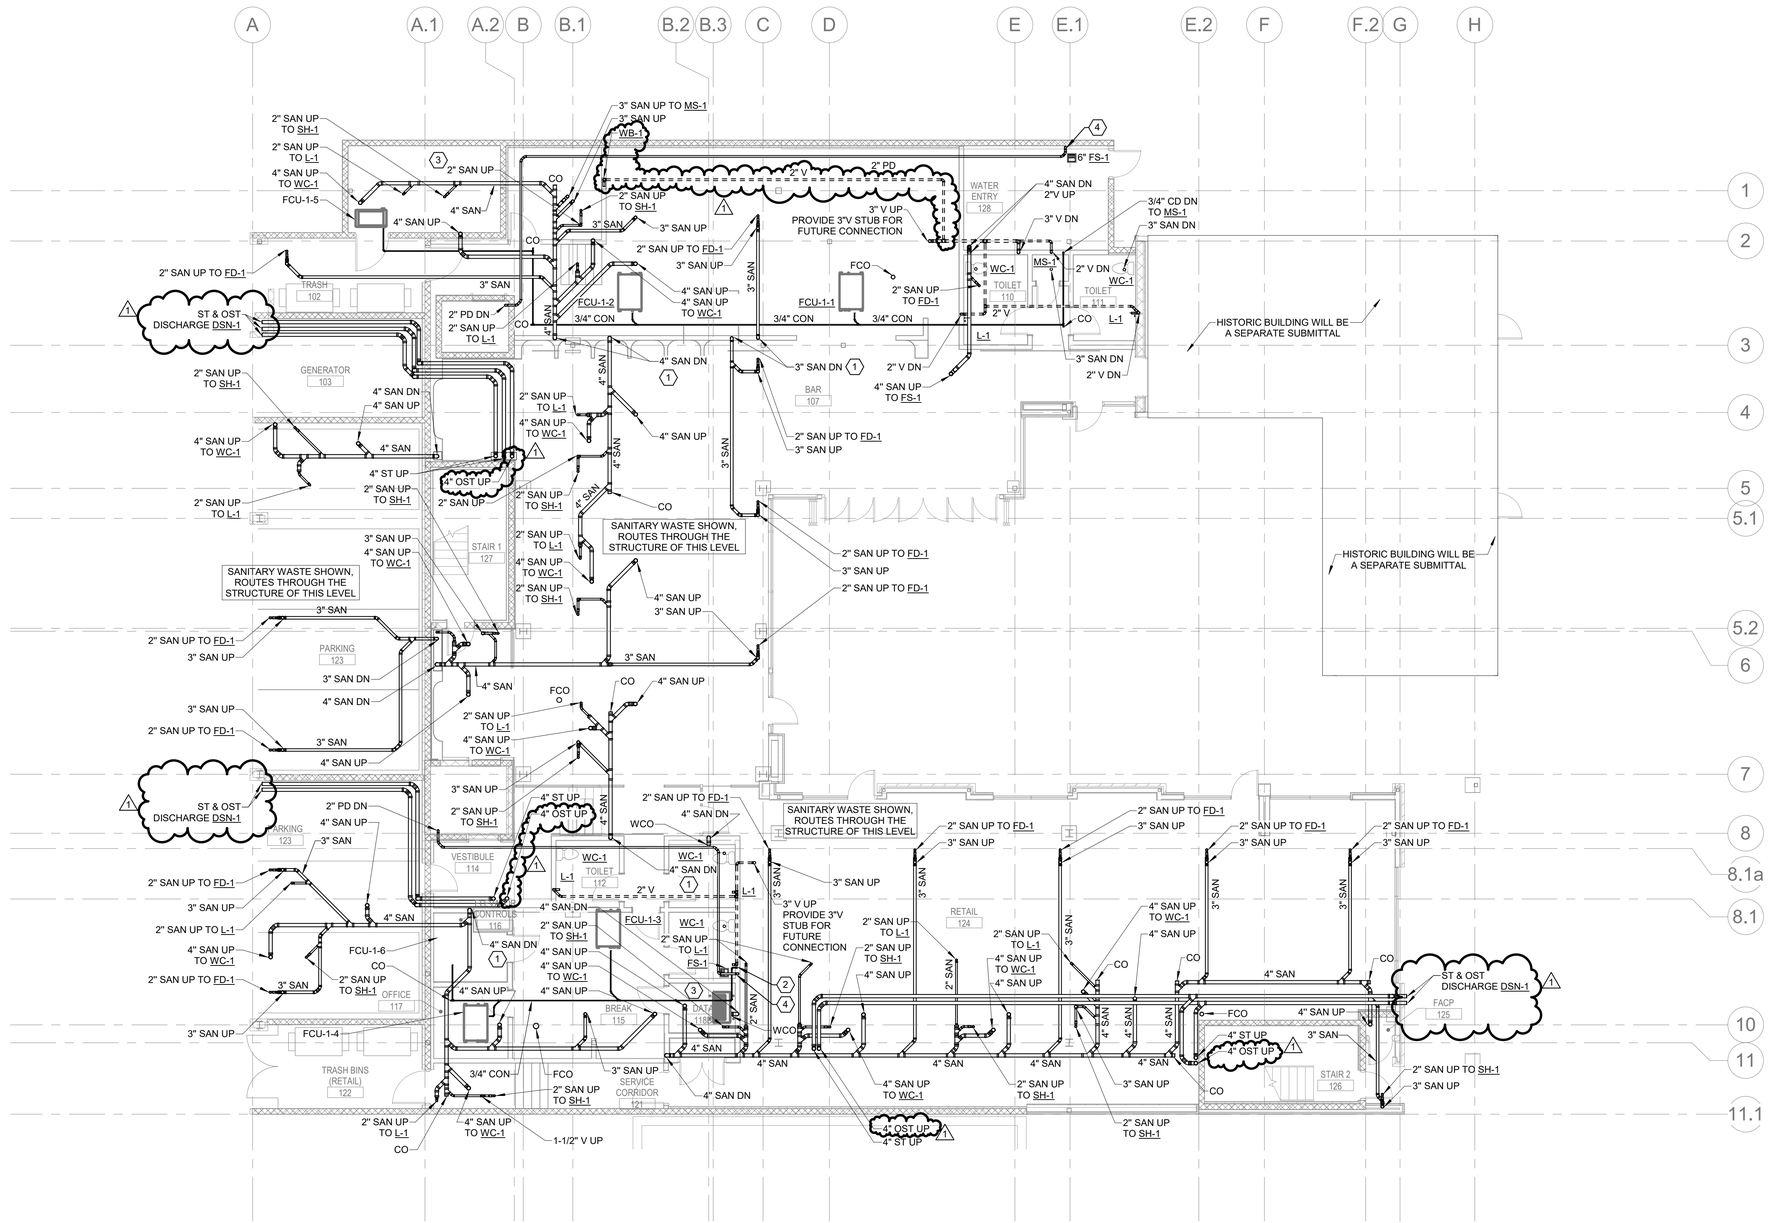
A
A.1
A.2
B
B.1
B.2
B.3
C
D
E
E.1
E.2
F
F.2
G
H
1
2
3
4
5
5.1
5.2
6
7
8
8.1a
8.1
10
11
11.1
TRASH 102
GENERATOR 103
PARKING 123
STAIR 1 127
VESTIBULE 114
TOILET 112
CONTROLS 116
OFFICE 117
BREAK 115
DATA 118
SERVICE CORRIDOR 121
TRASH BINS (RETAIL) 122
WATER ENTRY 128
BAR 107
TOILET 110
TOILET 111
RETAIL 124
STAIR 2 126
FACP 125
ST & OST DISCHARGE DSN-1
HISTORIC BUILDING WILL BE A SEPARATE SUBMITTAL
SANITARY WASTE SHOWN, ROUTES THROUGH THE STRUCTURE OF THIS LEVEL
PROVIDE 3"V STUB FOR FUTURE CONNECTION
3" V UP
2" V
2" PD
3" SAN UP TO MS-1
3" SAN UP
WB-1
6" FS-1
2" SAN UP TO SH-1
2" SAN UP TO L-1
4" SAN UP TO WC-1
FCU-1-5
2" SAN UP
4" SAN
4" SAN UP
CO
3" SAN
2" SAN UP TO FD-1
3" SAN UP
4" SAN UP TO WC-1
FCU-1-2
3/4" CON
FCU-1-1
FCO
WC-1
MS-1
2" V DN
3" V DN
4" SAN DN 2"V UP
3/4" CD DN TO MS-1
3" SAN DN
L-1
2" PD DN
2" SAN UP TO L-1
4" SAN DN
4" ST UP
4" OST UP
2" SAN UP TO SH-1
4" SAN UP TO FS-1
3" SAN DN
2" V DN
2" SAN UP TO FD-1
3" SAN UP
4" SAN UP TO WC-1
2" SAN UP TO L-1
2" SAN UP TO SH-1
4" SAN UP 3" SAN UP
2" SAN UP TO FD-1
3" SAN UP
4" SAN UP TO WC-1
2" SAN UP TO SH-1
4" SAN UP 3" SAN UP
2" SAN UP TO FD-1
3" SAN UP
4" SAN DN
4" SAN UP
3" SAN DN
4" SAN UP
2" SAN UP TO FD-1
3" SAN UP
2" SAN UP TO L-1
4" SAN UP TO WC-1
2" SAN UP TO FD-1
3" SAN UP
2" SAN UP TO L-1
4" SAN UP TO WC-1
2" SAN UP TO SH-1
4" SAN UP
3" SAN UP
2" SAN UP TO FD-1
3" SAN UP

GENERAL NOTES

A. ALL WORK SHOWN SHALL COMPLY WITH ALL NATIONAL, STATE, AND LOCAL CODES AND ORDINANCES.

B. REFERENCE ALL OTHER DRAWINGS AND SPECIFICATIONS FOR ADDITIONAL WORK OR CLARIFICATION OF NECESSARY WORK.

C. VERIFY INVERT ELEVATIONS AND SLOPES PRIOR TO BID.

D. VISIBLE EQUIPMENT AND APPLIANCE DRAINS SHALL BE COPPER PER PIPING APPLICATION SCHEDULE.

E. MAINTAIN INTEGRITY OF FIRE-RATED PARTITIONS WITH UL-LISTED FIRESTOP SYSTEM.

F. REFER TO STRUCTURAL PLANS AND SPECIFICATIONS FOR DETAILS. PRIOR TO START OF WORK, COORDINATE ALL CLEARANCES TO STRUCTURAL FOOTINGS AND PIERS, PIPING PENETRATIONS, SLEEVES, AND BLOCKOUTS WITH STRUCTURAL PLANS.

G. SANITARY PIPING IS SHOWN IN CEILING OF THIS LEVEL.

N

1 SANITARY WASTE AND VENT PLAN - LEVEL 2

SCALE: 1/8" = 1'-0"

Ramirez, Johnson, & Associates
3301 Lawrence St. Ste 2
Denver, CO 80205
P: 720.594.0774

HELTSHE

M1A | MERIDIAN 105 ARCHITECTURE

CITY HOTEL

415 PERRY STREET, CASTLE ROCK, CO.

DATE: 05.15.2025	ISSUED FOR: 1st PERMIT COMMENTS	SHEET TITLE: SANITARY WASTE AND VENT PLAN - LEVEL 2	
PROJ. NO. 2023.002			

COLORADO LICENSED
CAMRA MURPHY
43565
05/27/2026
PROFESSIONAL ENGINEER

SHEET NUMBER
P1.02

5/15/2026 10:22:23 AM Autodesk Docs://2024-020 City Hotel/(2024) City Hotel - M&P .rvt

GENERAL NOTES

A. ALL WORK SHOWN SHALL COMPLY WITH ALL NATIONAL, STATE, AND LOCAL CODES AND ORDINANCES.

B. REFERENCE ALL OTHER DRAWINGS AND SPECIFICATIONS FOR ADDITIONAL WORK OR CLARIFICATION OF NECESSARY WORK.

C. VERIFY INVERT ELEVATIONS AND SLOPES PRIOR TO BID.

D. VISIBLE EQUIPMENT AND APPLIANCE DRAINS SHALL BE COPPER PER PIPING APPLICATION SCHEDULE.

E. MAINTAIN INTEGRITY OF FIRE-RATED PARTITIONS WITH UL-LISTED FIRESTOP SYSTEM.

F. REFER TO STRUCTURAL PLANS AND SPECIFICATIONS FOR DETAILS. PRIOR TO START OF WORK, COORDINATE ALL CLEARANCES TO STRUCTURAL FOOTINGS AND PIERS, PIPING PENETRATIONS, SLEEVES, AND BLOCKOUTS WITH STRUCTURAL PLANS.

G. SANITARY PIPING IS SHOWN IN CEILING OF THIS LEVEL.

KEY NOTES

1. VTAC CONDENSATE TO HUB DRAIN IN CLOSET. CONNECT TO 2" SANITARY RISER. DISCHARGE RISER TO FLOOR DRAIN AT LOWEST LEVEL.

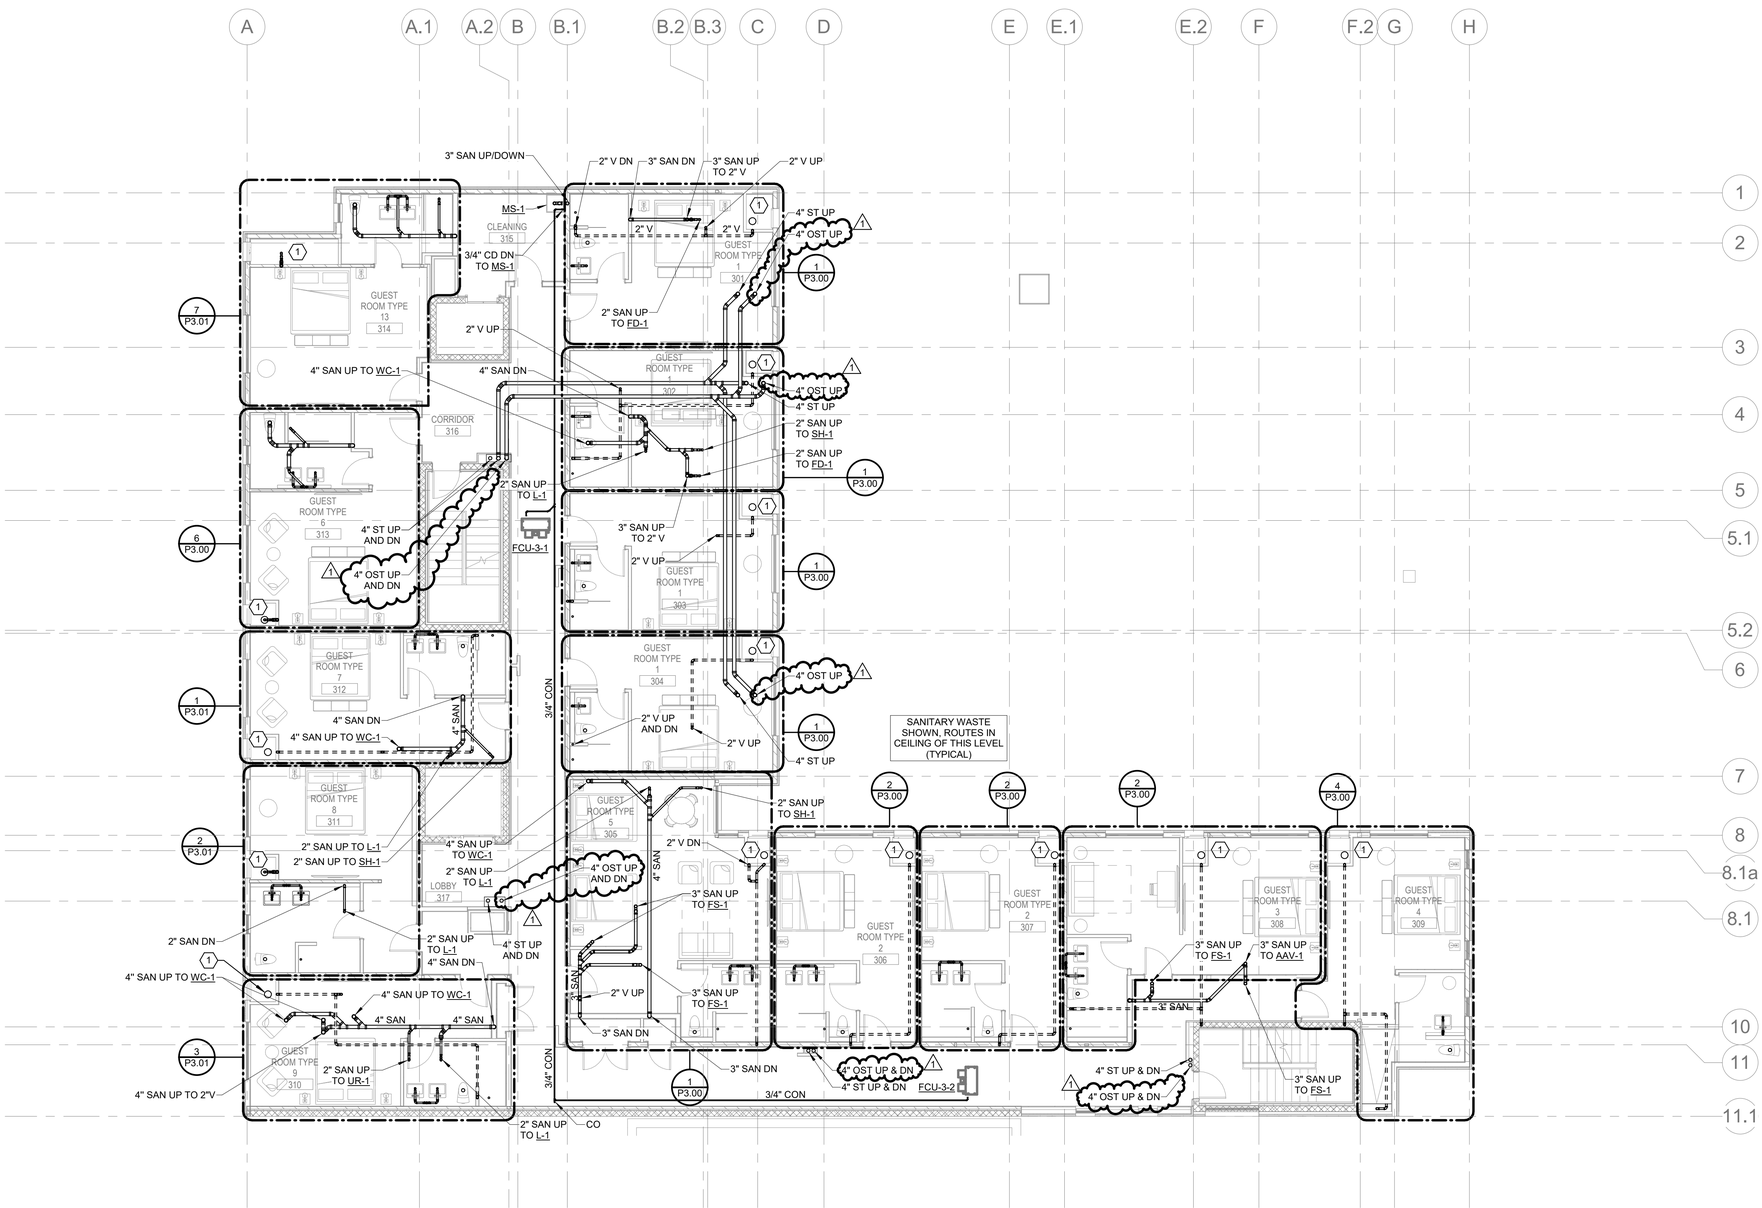

N

1 SANITARY WASTE AND VENT PLAN - LEVEL 3

SCALE: 1/8" = 1'-0"

5/15/2026 10:22:28 AM Autodesk Docs://2024-020 City Hotel/(2024) City Hotel - M&P .rvt

Ramirez, Johnson, & Associates
2301 Lawrence St. Ste 2
Denver, CO 80205
P: 720.598.5774

HELTSHE

M1A | MERIDIAN 105 ARCHITECTURE

CITY HOTEL

415 PERRY STREET, CASTLE ROCK, CO.

DATE: 05.15.2025	ISSUED FOR: 1st PERMIT COMMENTS	SHEET TITLE: SANITARY WASTE AND VENT PLAN - LEVEL 3	SHEET NUMBER P1.03
PROJ. NO. 2023.002			

COLORADO LICENSED
CLAYTON A. MUSTER
43565
05/27/2026
PROFESSIONAL ENGINEER

GENERAL NOTES

A. ALL WORK SHOWN SHALL COMPLY WITH ALL NATIONAL, STATE, AND LOCAL CODES AND ORDINANCES.

B. REFERENCE ALL OTHER DRAWINGS AND SPECIFICATIONS FOR ADDITIONAL WORK OR CLARIFICATION OF NECESSARY WORK.

C. VERIFY INVERT ELEVATIONS AND SLOPES PRIOR TO BID.

D. VISIBLE EQUIPMENT AND APPLIANCE DRAINS SHALL BE COPPER PER PIPING APPLICATION SCHEDULE.

E. MAINTAIN INTEGRITY OF FIRE-RATED PARTITIONS WITH UL-LISTED FIRESTOP SYSTEM.

F. REFER TO STRUCTURAL PLANS AND SPECIFICATIONS FOR DETAILS. PRIOR TO START OF WORK, COORDINATE ALL CLEARANCES TO STRUCTURAL FOOTINGS AND PIERS, PIPING PENETRATIONS, SLEEVES, AND BLOCKOUTS WITH STRUCTURAL PLANS.

G. SANITARY PIPING IS SHOWN IN CEILING OF THIS LEVEL.

KEY NOTES

1. TERRACE ROOF DRAINS TO INTERNAL STORM PIPING. STORM PIPING WILL DISCHARGE TO LAMBS TONGUES AT THE COURTYARD.

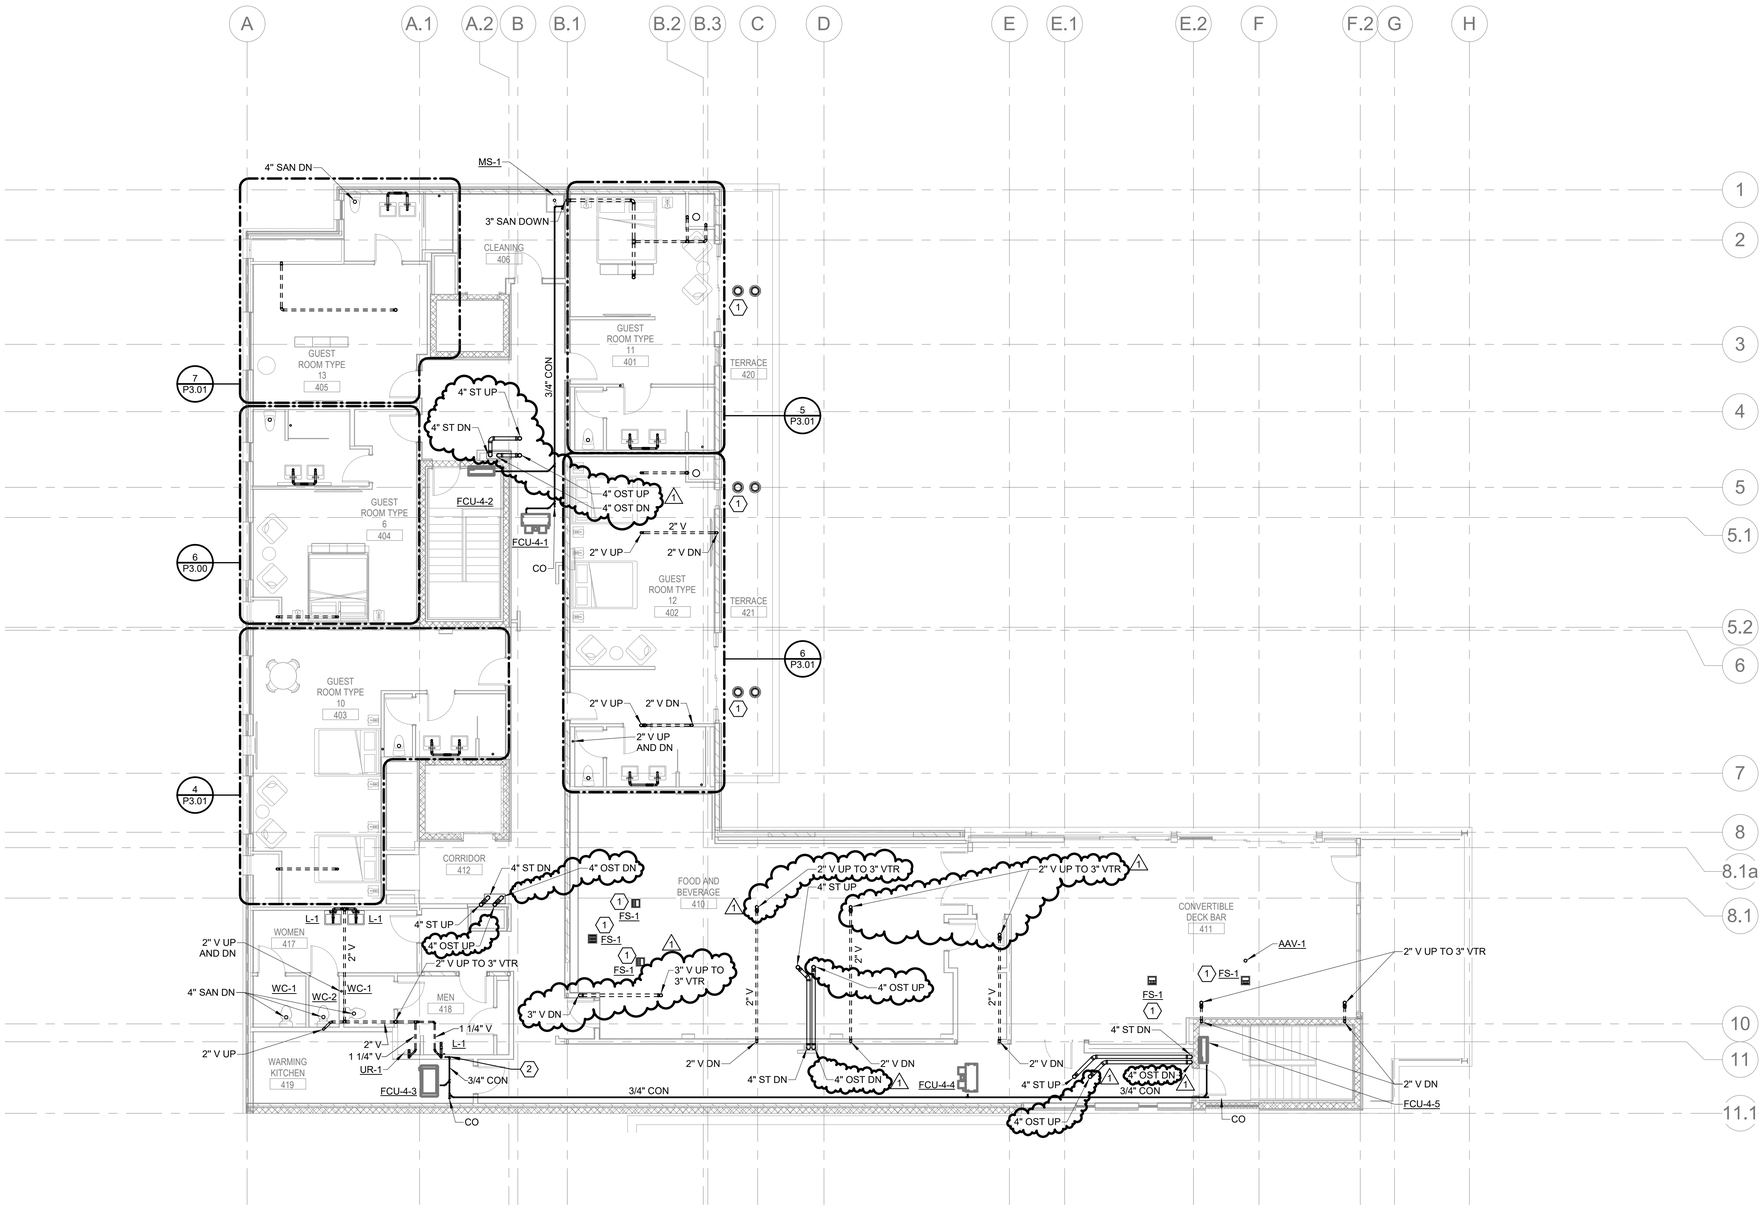

N

1 SANITARY WASTE AND VENT PLAN - LEVEL 4

SCALE: 1/8" = 1'-0"

Ramirez, Johnson, & Associates
1001 Lawrence St. Ste 2
Denver, CO 80220
P: 702.566.0774

HELTSHE

M1A MERIDIAN 105 ARCHITECTURE

CITY HOTEL

415 PERRY STREET, CASTLE ROCK, CO.

DATE: 05.15.2025	ISSUED FOR: 1st PERMIT COMMENTS	SHEET TITLE: SANITARY WASTE AND VENT PLAN - LEVEL 4	SHEET NUMBER P1.04
PROJ. NO. 2023.002			

COLORADO LICENSED
SABRINA MURPHY
43565
05/27/2026
PROFESSIONAL ENGINEER

5/15/2026 10:22:31 AM
Autodesk Docs://2024-020 City Hotel/(2024) City Hotel - M&P.rvt

GENERAL NOTES

A. ALL WORK SHOWN SHALL COMPLY WITH ALL NATIONAL, STATE, AND LOCAL CODES AND ORDINANCES.

B. REFERENCE ALL OTHER DRAWINGS AND SPECIFICATIONS FOR ADDITIONAL WORK OR CLARIFICATION OF NECESSARY WORK.

C. VERIFY INVERT ELEVATIONS AND SLOPES PRIOR TO BID.

D. VISIBLE EQUIPMENT AND APPLIANCE DRAINS SHALL BE COPPER PER PIPING APPLICATION SCHEDULE.

E. MAINTAIN INTEGRITY OF FIRE-RATED PARTITIONS WITH UL-LISTED FIRESTOP SYSTEM.

F. REFER TO STRUCTURAL PLANS AND SPECIFICATIONS FOR DETAILS. PRIOR TO START OF WORK, COORDINATE ALL CLEARANCES TO STRUCTURAL FOOTINGS AND PIERS, PIPING PENETRATIONS, SLEEVES, AND BLOCKOUTS WITH STRUCTURAL PLANS.

KEY NOTES

1. 3" SANITARY VENTS THROUGH ROOF FROM STACKS BELOW.
2. MAINTAIN 10' CLEARANCE TO OUTSIDE AIR INTAKES FROM ANY PLUMBING VTRs. (1)

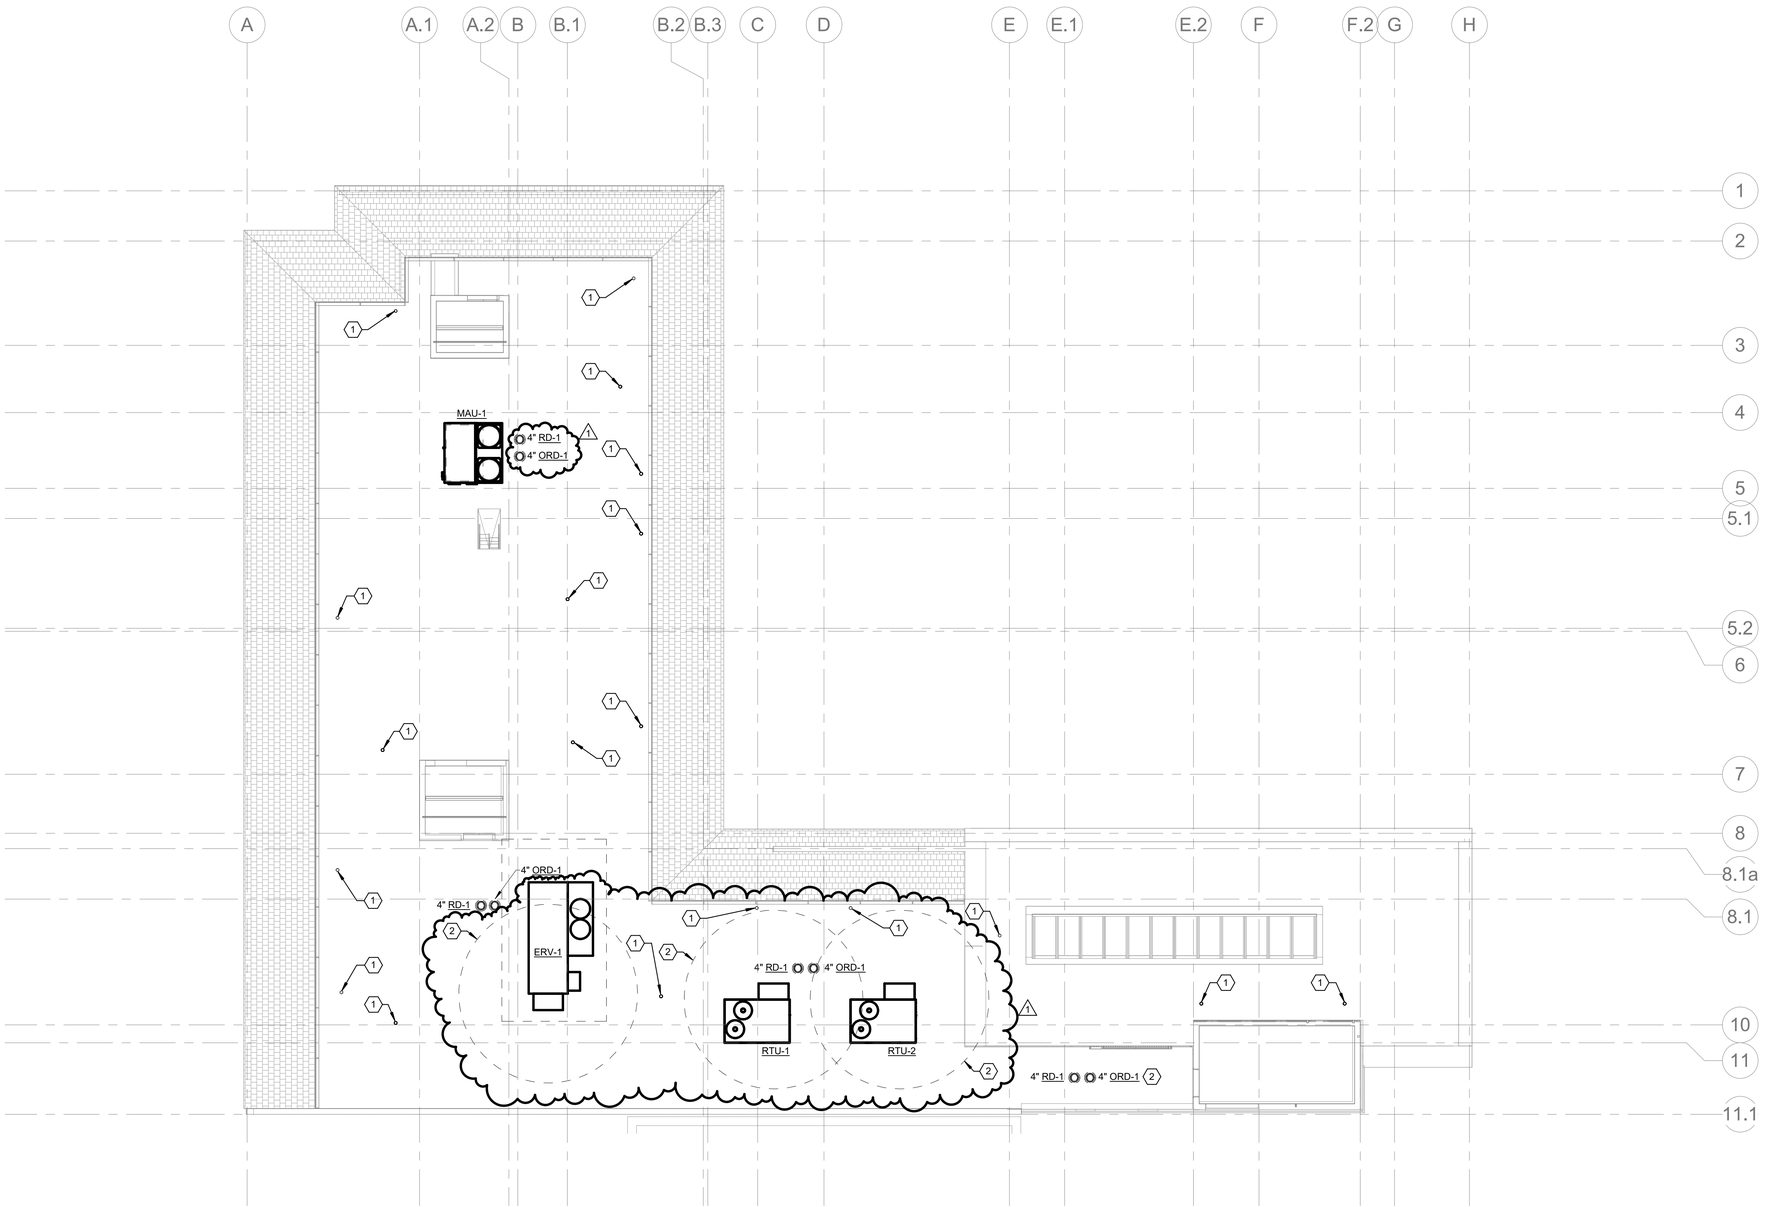

N

1 SANITARY WASTE AND VENT PLAN - ROOF

SCALE: 1/8" = 1'-0"

Ramirez, Johnson, & Associates
3301 Lawrence St. Ste 2
Denver, CO 80205
P: 720.398.0774

HELTSHE

M1A | MERIDIAN 105 ARCHITECTURE

CITY HOTEL

415 PERRY STREET, CASTLE ROCK, CO.

DATE: 05.15.2025	ISSUED FOR: 1st PERMIT COMMENTS	SHEET TITLE: SANITARY WASTE AND VENT PLAN - ROOF	SHEET NUMBER P1.05
PROJ. NO. 2023.002			

COLORADO LICENSED
JAIME RAMIREZ
43565
05/27/2026
PROFESSIONAL ENGINEER

5/15/2026 10:22:34 AM Autodesk Docs://2024-020 City Hotel/(2024) City Hotel - M&P.rvt

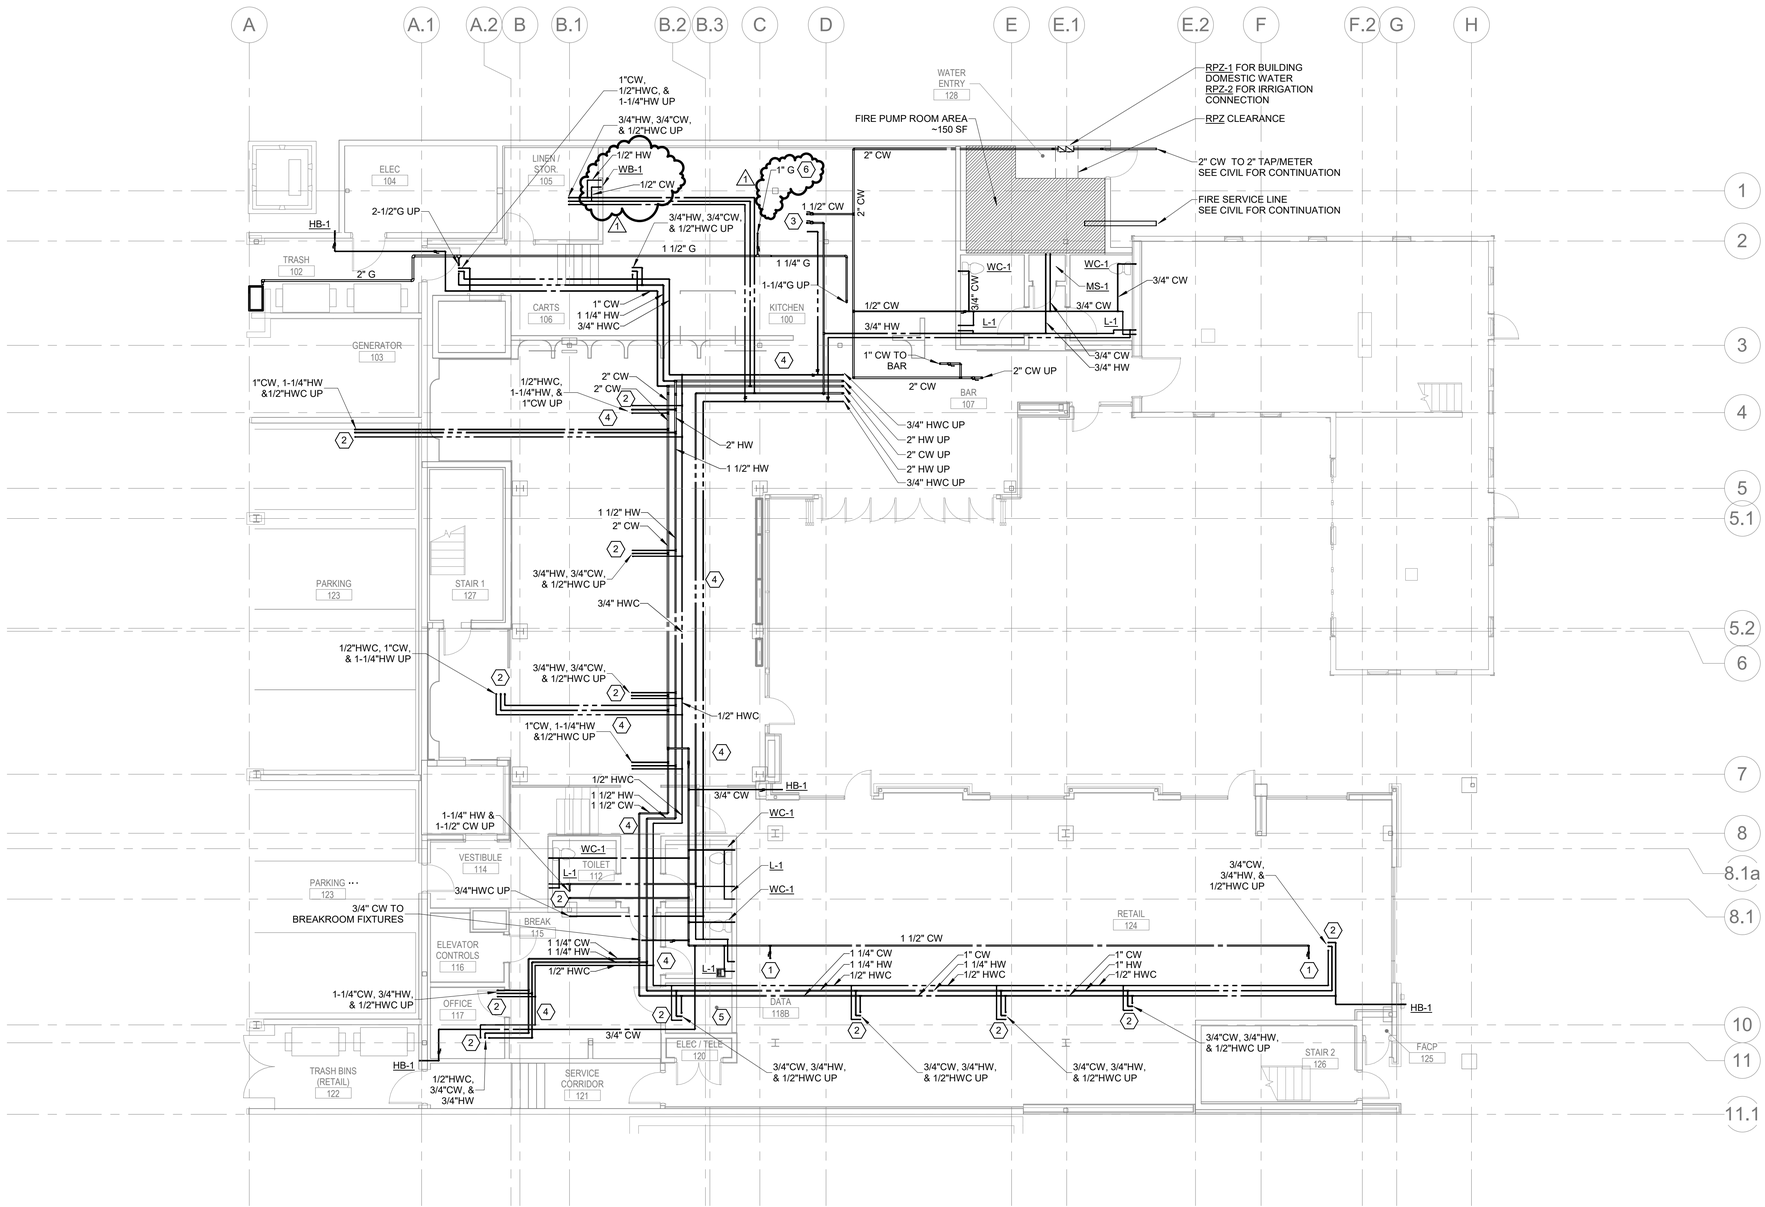

N

1 WATER AND GAS PLAN - LEVEL 1

SCALE: 1/8" = 1'-0"

GENERAL NOTES

A. ALL WORK SHOWN SHALL COMPLY WITH ALL NATIONAL, STATE, AND LOCAL CODES AND ORDINANCES.

B. REFERENCE ALL OTHER DRAWINGS AND SPECIFICATIONS FOR ADDITIONAL WORK OR CLARIFICATION OF NECESSARY WORK.

C. VERIFY INVERT ELEVATIONS AND SLOPES PRIOR TO BID.

D. ROUTE HOT WATER CIRCULATION WITHIN 24" OF PUBLIC LAVATORY/SINK ROUGH-INS PER 2018 IECC.

E. VISIBLE EQUIPMENT AND APPLIANCE DRAINS SHALL BE COPPER PER PIPING APPLICATION SCHEDULE.

F. MAINTAIN INTEGRITY OF FIRE-RATED PARTITIONS WITH UL-LISTED FIRESTOP SYSTEM.

KEY NOTES

1. 1" CW CAPPED FOR FUTURE USE.
2. PROVIDE ISOLATION VALVES AND RISER VALVE TAG AT BASE OF ALL DOMESTIC WATER PIPING RISERS. PROVIDE O&M MANUALS WITH VALVE LEGEND AND LABELED PLAN INDICATING VALVE LOCATION AND EQUIPMENT SERVED.
3. PROVIDE 1" CW/HW STUB WITH ISOLATION VALVE FOR FUTURE KITCHEN TENANT FINISH.
4. DOMESTIC WATER PIPING ROUTED THROUGH OPEN WEB STRUCTURE ABOVE CEILING.
5. FOR ALL WATER PIPING ABOVE ELECTRICAL ROOM, MAINTAIN MIN 12" HORIZONTAL CLEARANCE TO ELECTRICAL PANELS AND GEAR BELOW. ⚠1
6. STUB AND CAP 1" GAS PIPE WITH ISOLATION VALVE FOR FUTURE KITCHEN TI.

Ramirez, Johnson, & Associates
3301 Lawrence St. Ste 2
Denver, CO 80205
P: 720.594.0774

HELTSHE

M1A | MERIDIAN 105 ARCHITECTURE

CITY HOTEL

415 PERRY STREET, CASTLE ROCK, CO.

DATE: 05.15.2025	ISSUED FOR: 1st PERMIT COMMENTS	SHEET TITLE: WATER AND GAS PLAN - LEVEL 1	SHEET NUMBER P2.01
PROJ. NO. 2023.002			

COLORADO LICENSED
CJ MIRAMIREZ
43565
05/27/2026
PROFESSIONAL ENGINEER

5/15/2026 10:22:40 AM Autodesk Docs://2024-020 City Hotel/(2024) City Hotel - M&P .rvt

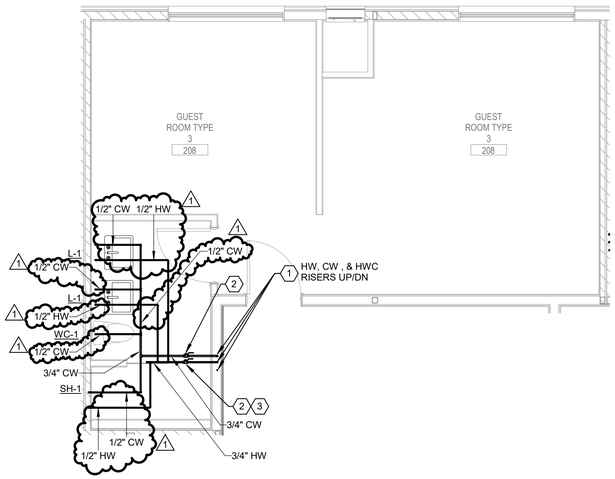

3 GUEST ROOM TYPE 3 WATER PLAN

SCALE: 1/4" = 1'-0"

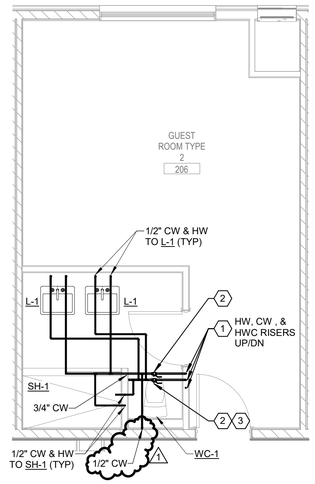

2 GUEST ROOM TYPE 2 WATER PLAN

SCALE: 1/4" = 1'-0"

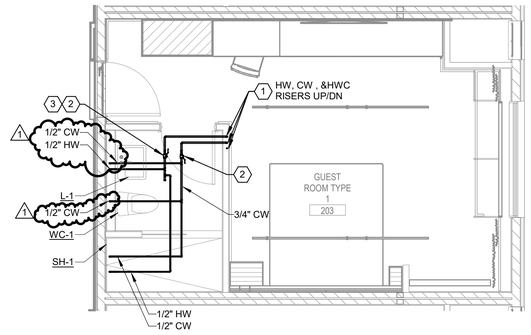

1 GUEST ROOM TYPE 1 WATER PLAN

SCALE: 1/4" = 1'-0"

GENERAL NOTES

A. ALL WORK SHOWN SHALL COMPLY WITH ALL NATIONAL, STATE, AND LOCAL CODES AND ORDINANCES.

B. REFERENCE ALL OTHER DRAWINGS AND SPECIFICATIONS FOR ADDITIONAL WORK OR CLARIFICATION OF NECESSARY WORK.

C. VERIFY INVERT ELEVATIONS AND SLOPES PRIOR TO BID.

D. ROUTE HOT WATER CIRCULATION WITHIN 24" OF PUBLIC LAVATORY/SINK ROUGH-INS PER 2018 IECC.

E. VISIBLE EQUIPMENT AND APPLIANCE DRAINS SHALL BE COPPER PER PIPING APPLICATION SCHEDULE.

F. MAINTAIN INTEGRITY OF FIRE-RATED PARTITIONS WITH UL-LISTED FIRESTOP SYSTEM.

KEY NOTES

1. DOMESTIC WATER MAINS ARE ROUTED TO RISERS ON LEVELS 2,3, AND 4. SEE OVERALL PLANS AND RISER DIAGRAM FOR MAIN AND RISER ROUTING/SIZING.
2. COORDINATE ACCESS PANEL FOR ISOLATION AND BALANCING WITH ARCHITECT.
3. PROVIDE 3/4" HW MANIFOLD AND BRANCH 1/2" HW LINES INDIVIDUALLY TO EACH FIXTURE IN ACCORDANCE WITH IECC 404.5.1.

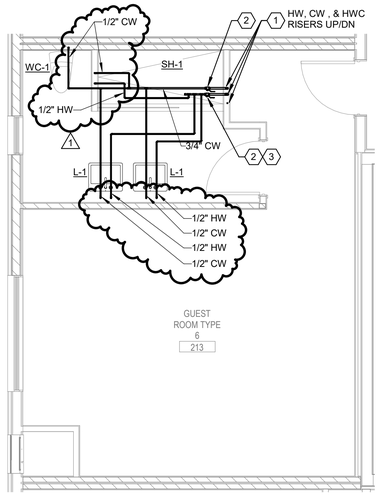

6 GUEST ROOM TYPE 6 WATER PLAN

SCALE: 1/4" = 1'-0"

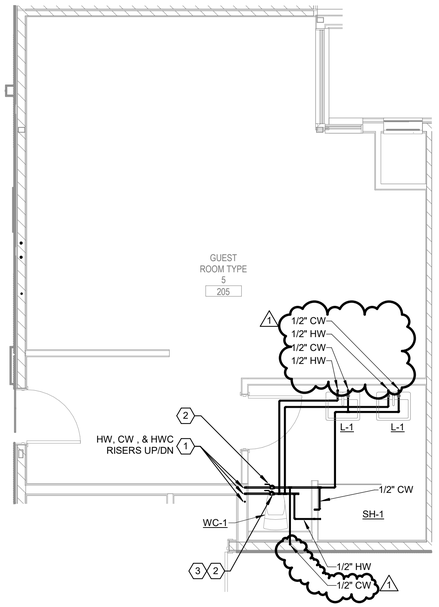

5 GUEST ROOM TYPE 5 WATER PLAN

SCALE: 1/4" = 1'-0"

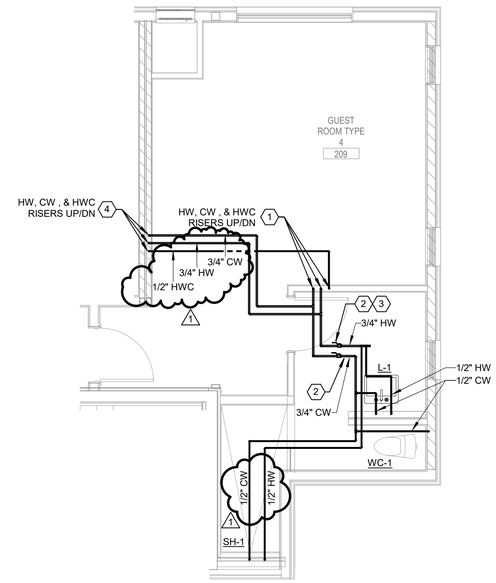

4 GUEST ROOM TYPE 4 WATER PLAN

SCALE: 1/4" = 1'-0"

COLORADO LICENSED
CARLOS RAMIREZ
43565
05/27/2026
PROFESSIONAL ENGINEER

Ramirez, Johnson, & Associates
3301 Lawrence St. Ste 2
Denver, CO 80205
P: 720.398.0774

HELTSHE

M1A | MERIDIAN 105 ARCHITECTURE

CITY HOTEL
415 PERRY STREET, CASTLE ROCK, CO.

DATE: 05.15.2025	ISSUED FOR: 1st PERMIT COMMENTS	SHEET TITLE: DOMESTIC WATER UNIT PLANS	SHEET NUMBER P4.00
PROJ. NO. 2023.002			

5/15/2026 10:23:06 AM Autodesk Docs://2024-020 City Hotel\(2024) City Hotel - M&P.rvt

GENERAL NOTES

A. ALL WORK SHOWN SHALL COMPLY WITH ALL NATIONAL, STATE, AND LOCAL CODES AND ORDINANCES.

B. REFERENCE ALL OTHER DRAWINGS AND SPECIFICATIONS FOR ADDITIONAL WORK OR CLARIFICATION OF NECESSARY WORK.

C. VERIFY INVERT ELEVATIONS AND SLOPES PRIOR TO BID.

D. ROUTE HOT WATER CIRCULATION WITHIN 24" OF PUBLIC LAVATORY/SINK ROUGH-INS PER 2018 IECC.

E. VISIBLE EQUIPMENT AND APPLIANCE DRAINS SHALL BE COPPER PER PIPING APPLICATION SCHEDULE.

F. MAINTAIN INTEGRITY OF FIRE-RATED PARTITIONS WITH UL-LISTED FIRESTOP SYSTEM.

KEY NOTES

1. DOMESTIC WATER MAINS ARE ROUTED TO RISERS ON LEVELS 2,3, AND 4. SEE OVERALL PLANS AND RISER DIAGRAM FOR MAIN AND RISER ROUTING/SIZING.
2. COORDINATE ACCESS PANEL FOR ISOLATION AND BALANCING WITH ARCHITECT.
3. PROVIDE 3/4" HW MANIFOLD AND BRANCH 1/2" HW LINES INDIVIDUALLY TO EACH FIXTURE IN ACCORDANCE WITH IECC 404.5.1.

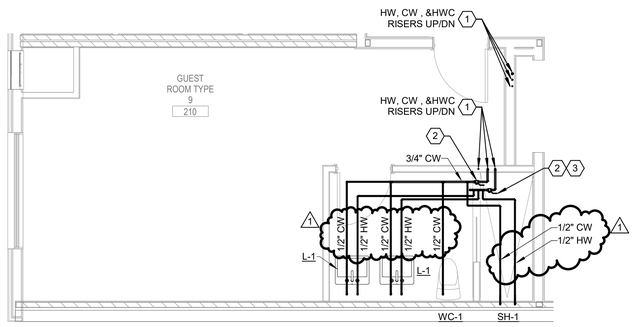

3 GUEST ROOM TYPE 9 WATER PLAN
SCALE: 1/4" = 1'-0"

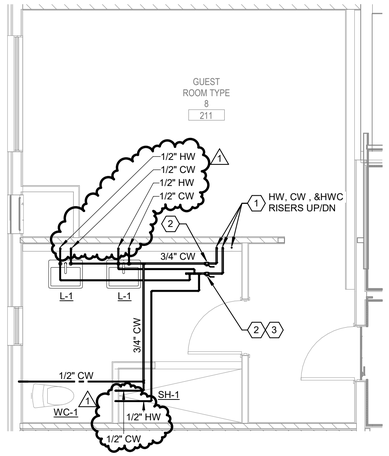

2 GUEST ROOM TYPE 8 WATER PLAN
SCALE: 1/4" = 1'-0"

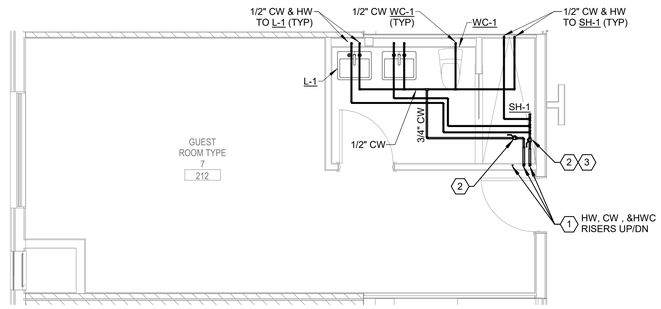

1 GUEST ROOM TYPE 7 WATER PLAN
SCALE: 1/4" = 1'-0"

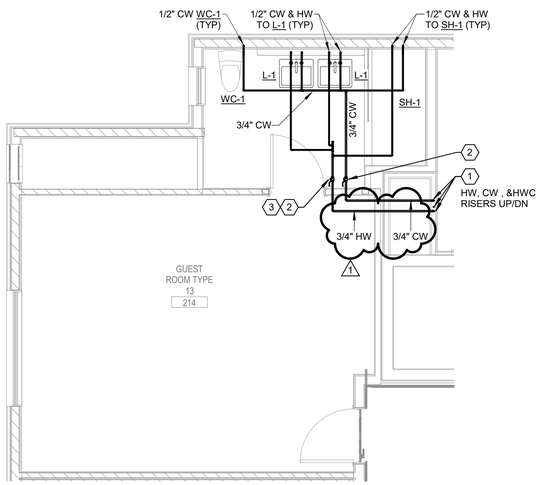

7 GUEST ROOM TYPE 13 WATER PLAN
SCALE: 1/4" = 1'-0"

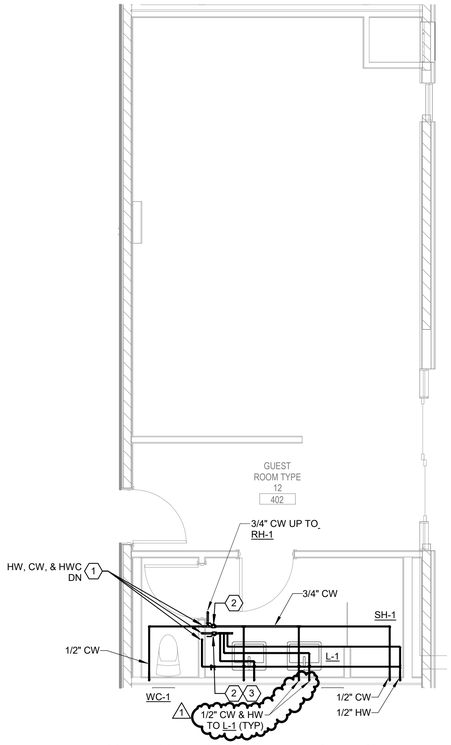

6 GUEST ROOM TYPE 12 WATER PLAN
SCALE: 1/4" = 1'-0"

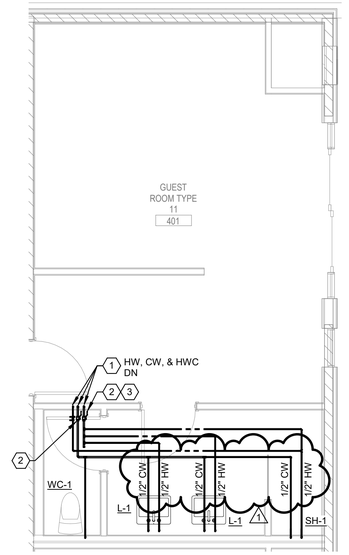

5 GUEST ROOM TYPE 11 WATER PLAN
SCALE: 1/4" = 1'-0"

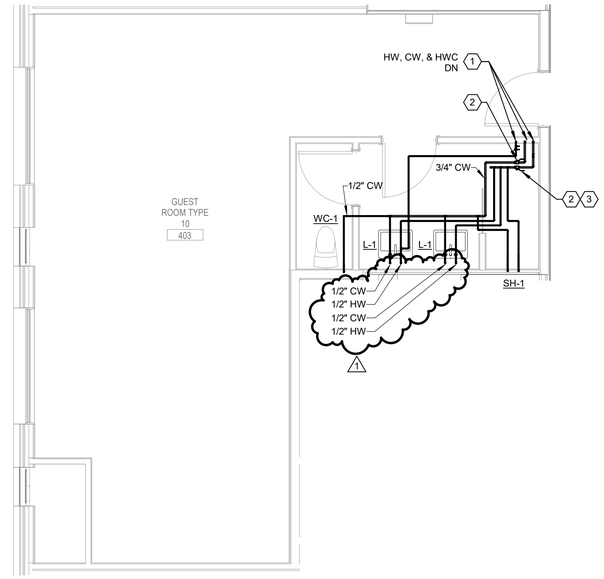

4 GUEST ROOM TYPE 10 WATER PLAN
SCALE: 1/4" = 1'-0"

COLORADO LICENSED
SABRA RAMIREZ
43565
05/27/2026
PROFESSIONAL ENGINEER

Ramirez, Johnson, & Associates
3301 Lawrence St. Ste 2
Denver, CO 80205
P: 720.588.0774

HELTSHE

M1A | MERIDIAN 105 ARCHITECTURE

CITY HOTEL
415 PERRY STREET, CASTLE ROCK, CO.

DATE: 05.15.2025	ISSUED FOR: 1st PERMIT COMMENTS	SHEET TITLE: DOMESTIC WATER UNIT PLANS	SHEET NUMBER P4.01
PROJ. NO. 2023.002			

Autodesk Docs://2024-020 City Hotel/(2024) City Hotel - M&P.rvt
5/15/2026 10:23:11 AM

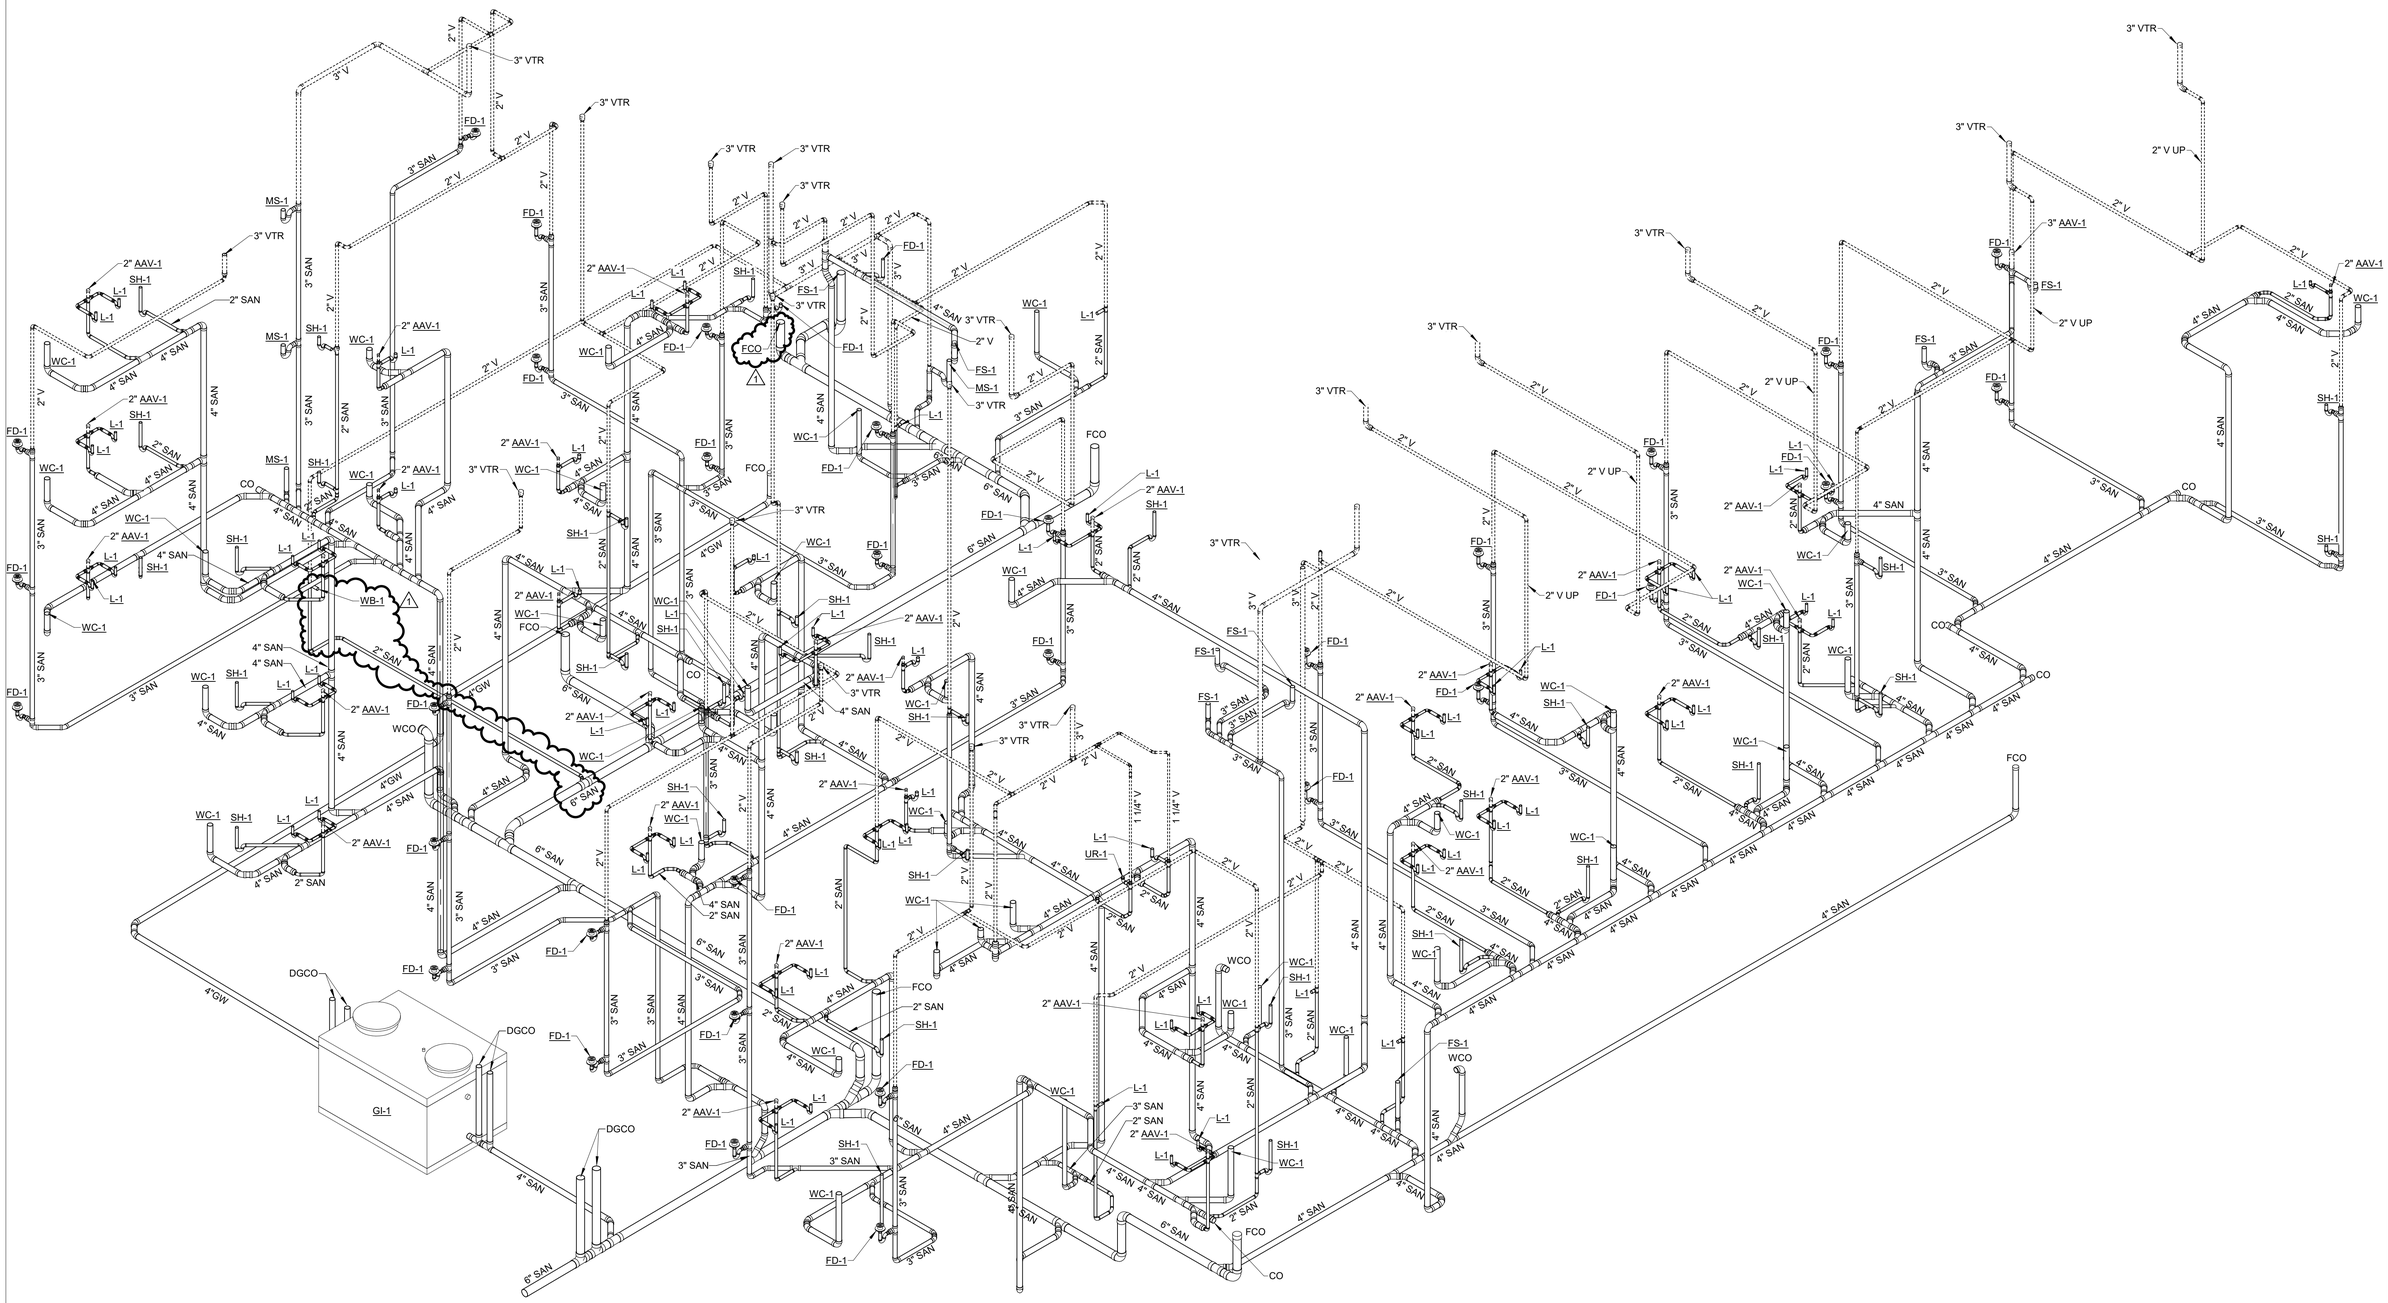

1 SANITARY WASTE AND VENT ISOMETRIC PLAN

SCALE: NO SCALE

Ramirez, Johnson, & Associates
1001 Lawrence St. Ste 2
Denver, CO 80220
P: 702.566.0774

HELTSHE

M1A MERIDIAN 105 ARCHITECTURE

CITY HOTEL

415 PERRY STREET, CASTLE ROCK, CO.

DATE: 05.15.2025	ISSUED FOR: 1st PERMIT COMMENTS	SHEET TITLE: SANITARY WASTE AND VENT ISOMETRIC	
PROJ. NO. 2023.002			

COLORADO LICENSED
SABRINA MUNOZ
43565
05/27/2026
PROFESSIONAL ENGINEER

SHEET NUMBER
P5.00

Autodesk Docs://2024-020 City Hotel/(2024) City Hotel - M&P .rvt
5/15/2026 10:23:19 AM

ELECTRICAL SYMBOLS

NOTE:

THIS IS A MASTER SYMBOLS LIST. ALL SYMBOLS, ABBREVIATIONS, ETC. MAY NOT NECESSARILY BE USED ON ALL DRAWINGS

ONE LINE AND RISER

- PANEL XXX — PANEL
- CURRENT TRANSFORMER, RATED AS SPECIFIED OR REQUIRED
- M — MOTOR
- SPD — SURGE PROTECTION DEVICE
- GROUND CONNECTION
- 800A3P — SWITCH, RATING AS SHOWN
- 400A FRN — FUSE, FUSE AMPACITY AND TYPE AS SHOWN
- 800A3P — CIRCUIT BREAKER, RATING AS SHOWN
- M — UTILITY METER (AS REQUIRED BY UTILITY)
- M — DIGITAL METER
- SAFETY SWITCH, NON-FUSED, 240V, U.N.O.
- FUSED DISCONNECT
- COMBINATION STARTER/DISCONNECT (SIZE AS INDICATED)
- T — T-XX — TRANSFORMER, TYPE AND RATING AS SHOWN
- CONDUIT CONNECTION
- G — CIRCUIT BREAKER WITH GROUND FAULT PROTECTION
- G — FUSE WITH GROUND FAULT PROTECTION
- ATS-XX — AUTOMATIC TRANSFER SWITCH
- GROUND CONNECTION WITH TEST WELL
- GROUND ROD

MISCELLANEOUS

- X — KEY NOTE DESIGNATION
- X — SHORT CIRCUIT TAG DESIGNATION
- XXXX — FEEDER TAG DESIGNATION
- 1/A1 — REVISION NUMBER DESIGNATION
- NEW TO EXISTING CONNECTION
- EXISTING LINEWORK
- DEMOLITION LINEWORK
- NEW LINEWORK

COMMUNICATIONS

- JUNCTION BOX FOR INSTALLATION OF COMMUNICATION OR DATA OUTLET, MOUNTED 18" AFF, UNLESS OTHERWISE NOTED. INSTALL 1" CONDUIT FROM BOX TO 3" INTO ACCESSIBLE LOCATION ABOVE FINISHED CEILING. PROVIDE (2) RJ-45 JACKS UNLESS NOTED OTHERWISE.
- FLOOR JUNCTION BOX FOR INSTALLATION OF COMMUNICATION OR DATA OUTLET. INSTALL 1" CONDUIT FROM BOX CONCEALED IN FLOOR SLAB TO WALL AND TO 3" INTO ACCESSIBLE LOCATION ABOVE FINISHED CEILING. PROVIDE (2) RJ-45 JACKS UNLESS NOTED OTHERWISE.
- JUNCTION BOX FOR INSTALLATION OF TV OUTLET. MOUNTED 18" AFF, UNLESS OTHERWISE NOTED. INSTALL 1" CONDUIT FROM BOX TO 3" INTO ACCESSIBLE LOCATION ABOVE FINISHED CEILING. COORDINATE MOUNTING HEIGHT WITH ARCHITECT PRIOR TO ROUGH-IN.
- WAP — CEILING MOUNTED JUNCTION BOX FOR INSTALLATION OF WIRELESS ACCESS POINT. PROVIDE (1) RJ-45 JACKS UNLESS NOTED OTHERWISE.
- S — EMERGENCY COMMUNICATIONS SYSTEM (ECS) SPEAKER

POWER

- PANELBOARD, ELECTRICAL DISTRIBUTION PANEL, OR LOAD CENTER SURFACE MOUNTED
- PANELBOARD, ELECTRICAL DISTRIBUTION PANEL, OR LOAD CENTER RECESS MOUNTED
- 20 AMP, 125V, NEMA 5-20R DUPLEX RECEPTACLE
- 20 AMP, 125V, NEMA 5-20R QUAD RECEPTACLE
- 20 AMP, 125V, NEMA 5-20R GFCI DUPLEX RECEPTACLE
- 20 AMP, 125V, NEMA 5-20R GFCI DUPLEX RECEPTACLE, MOUNTED 6" ABOVE COUNTER AND/OR ABOVE BACKSPLASH, UNLESS OTHERWISE NOTED
- 20 AMP, 125V, NEMA 5-20R DUPLEX RECEPTACLE, MOUNTED 6" ABOVE COUNTER AND/OR ABOVE BACKSPLASH, UNLESS OTHERWISE NOTED
- 20 AMP, 125V, NEMA 5-20R QUAD RECEPTACLE, MOUNTED 6" ABOVE COUNTER AND/OR ABOVE BACKSPLASH, UNLESS OTHERWISE NOTED
- 20 AMP, 125V, NEMA 5-20R SWITCHED DUPLEX RECEPTACLE
- 20 AMP, 125V, NEMA 5-20R DUPLEX FLOOR RECEPTACLE, 3/4" CONDUIT RUN CONCEALED IN FLOOR SLAB
- 20 AMP, 125V, NEMA 5-20R CEILING FLOOR RECEPTACLE, 3/4" CONDUIT
- 20 AMP, 125V, NEMA 5-20R QUAD FLOOR RECEPTACLE, 3/4" CONDUIT RUN CONCEALED IN FLOOR SLAB
- 20 AMP, 125V, NEMA 5-20R QUAD CEILING RECEPTACLE, 3/4" CONDUIT
- J — JUNCTION BOX, WALL MOUNTED
- J — JUNCTION BOX, FLOOR MOUNTED
- J — JUNCTION BOX, CEILING MOUNTED
- SPECIAL RECEPTACLE, FLOOR MOUNTED, CONFIGURATION AS NOTED ON PLAN
- SPECIAL RECEPTACLE, WALL MOUNTED, CONFIGURATION AS NOTED ON PLAN
- SPECIAL RECEPTACLE, CEILING MOUNTED, CONFIGURATION AS NOTED ON PLAN
- FURNITURE FEED RECEPTACLE, WALL MOUNTED, CONFIGURATION AS NOTED ON PLAN
- FURNITURE FEED RECEPTACLE, FLOOR MOUNTED, CONFIGURATION AS NOTED ON PLAN
- M — MOTOR: HORSEPOWER AS INDICATED ON PLANS OR DIAGRAMS
- PLUGMOLD, REFER TO DRAWING FOR LENGTHS
- SAFETY SWITCH, NON-FUSED, 240V, U.N.O.
- FUSED DISCONNECT
- COMBINATION STARTER/DISCONNECT (SIZE AS INDICATED)
- PHOTOCELL
- EMERGENCY POWER OFF (EPO) BUTTON
- EV — ELECTRIC VEHICLE CHARGER, WALL MOUNTED
- EV — ELECTRIC VEHICLE CHARGER

FIRE ALARM

- FACP — FIRE ALARM CONTROL PANEL
- FARA — FIRE ALARM REMOTE ANNUNCIATOR PANEL
- S — SMOKE DETECTOR, ADDRESSABLE PHOTO ELECTRIC
- S CO — COMBINATION SMOKE AND CARBON MONOXIDE DETECTOR, ADDRESSABLE PHOTO ELECTRIC
- HD — HEAT DETECTOR
- S — DUCT SMOKE DETECTOR, ADDRESSABLE PHOTO ELECTRIC
- FIRE ADA ALARM STROBE MOUNTED AT 90" AFF OR 6" BELOW CEILING WHICHEVER IS LOWER
- FIRE ADA ALARM HORN MOUNTED AT 90" AFF OR 6" BELOW CEILING WHICHEVER IS LOWER
- FIRE ALARM AUDIBLE AND ADA STROBE LIGHT MOUNTED AT 90" AFF OR 6" BELOW CEILING, WHICHEVER IS LOWER
- F — FIRE ALARM MANUAL PULL STATION, ADDRESSABLE DOUBLE ACTION
- MAGNETIC DOOR HOLDER

CONDUIT DESIGNATIONS

- XX/XXX — PANEL NAME / CIRCUIT NUMBER - BRANCH CIRCUITS HOMERUN USE NUMBER 12 AWG WIRE, UNLESS OTHERWISE NOTED. ALL CIRCUITS SHALL CONTAIN A GROUND AND NEUTRAL CONDUCTOR, UNLESS NOTED OTHERWISE. CONTRACTOR SHALL PROVIDE MULTI-WIRE CIRCUIT HANDLE TIES AS FINAL FIELD INSTALLED WIRING REQUIRES.
- CONDUIT AND WIRE CONCEALED, 3/4" UNLESS OTHERWISE NOTED, CONDUIT USED FOR SWITCH LEGS, AND CONDUIT USED FOR CONTROL WIRING
- CONDUIT AND WIRE EMBEDDED IN CONCRETE OR BELOW GRADE

LIGHTING

NOTE: UPPER CASE LETTER DENOTES LUMINAIRES TYPE. LOWER CASE LETTER ADJACENT TO LUMINAIRE INDICATES SWITCH THAT CONTROLS LUMINAIRES, HATCHING DENOTES FIXTURE SHALL BE PROVIDED WITH EMERGENCY BATTERY BACKUP.

- A — 2' X 4' RECESSED LUMINAIRE, MOUNTING IS NOTED ON LUMINAIRE SCHEDULE
- A — 2' X 4' SURFACE LUMINAIRE, MOUNTING IS NOTED ON LUMINAIRE SCHEDULE
- A — 2' X 2' RECESSED LUMINAIRE, MOUNTING IS NOTED ON LUMINAIRE SCHEDULE
- A — 2' X 2' SURFACE MOUNTED LUMINAIRE, MOUNTING IS NOTED ON LUMINAIRE SCHEDULE
- A — 1' X 4' RECESSED LUMINAIRE, MOUNTING IS NOTED ON LUMINAIRE SCHEDULE
- A — 1' X 4' SURFACE MOUNTED LUMINAIRE, MOUNTING IS NOTED ON LUMINAIRE SCHEDULE
- A — 1' X 4' WALL MOUNTED LUMINAIRE, MOUNTING IS NOTED ON LUMINAIRE SCHEDULE
- A — PENDANT LUMINAIRE, MOUNTING IS NOTED ON LUMINAIRE SCHEDULE
- A — FLUORESCENT STRIP TYPE LUMINAIRE, LENGTHS AS NOTED ON LUMINAIRE SCHEDULE
- A — SURFACE MOUNTED DOWNLIGHT, MOUNTING IS NOTED ON LUMINAIRE SCHEDULE
- A — RECESSED MOUNTED DOWNLIGHT, MOUNTING IS NOTED ON LUMINAIRE SCHEDULE
- A — WALL MOUNTED LUMINAIRE, MOUNTING IS NOTED ON LUMINAIRE SCHEDULE
- A — WALL WASH LUMINAIRE, MOUNTING IS NOTED ON LUMINAIRE SCHEDULE
- TRACK LUMINAIRE, MOUNTING IS NOTED ON LUMINAIRE SCHEDULE
- CEILING FAN, MOUNTING IS NOTED ON LUMINAIRE SCHEDULE
- A A — CEILING MOUNTED EXIT SIGN. PROVIDE DIRECTIONAL ARROWS AS REQUIRED
- A — EMERGENCY BATTERY LUMINAIRE (2 HEAD) 84" AFF, UNLESS OTHERWISE NOTED
- A — EMERGENCY BATTERY LUMINAIRE (2 HEAD) WITH MOUNTED EXIT SIGN. PROVIDE DIRECTIONAL ARROWS AS REQUIRED MOUNT AT 84" AFF, UNLESS OTHERWISE NOTED
- A A — WALL MOUNTED EXIT SIGN. PROVIDE DIRECTIONAL ARROWS AS REQUIRED
- A — SINGLE POLE MOUNTED, EXTERIOR LUMINAIRE
- A — BOLLARD LUMINAIRE
- S — SINGLE POLE SWITCH; 3= THREE WAY SWITCH, 4= FOUR WAY SWITCH, K= KEY SWITCH, D= DIMMER SWITCH, T0= MOTOR RATED SWITCH, T= TIMER, HOA=HAND-OFF-AUTOMATIC, P= PILOT LIGHT, OS= OCCUPANCY SENSOR, LVD= LOW VOLTAGE DIMMER (LOWER SWITCH CASE LETTER INDICATES LUMINAIRES CONTROLLED)
- VS — CEILING MOUNTED VACANCY SENSOR
- OS — CEILING MOUNTED OCCUPANCY SENSOR

SECURITY DEVICES

- CR — JUNCTION BOX FOR INSTALLATION OF CARD READER, MOUNTED 48" AFF, UNLESS OTHERWISE NOTED. INSTALL 1" CONDUIT FROM BOX TO 3" INTO ACCESSIBLE LOCATION ABOVE FINISHED CEILING, U.N.O.
- JUNCTION BOX FOR INSTALLATION OF SECURITY CAMERA, MOUNTED 96" AFF, UNLESS OTHERWISE NOTED. INSTALL 1" CONDUIT FROM BOX TO 3" INTO ACCESSIBLE LOCATION ABOVE FINISHED CEILING, U.N.O. REFER TO SECURITY CONSULTANT DRAWINGS FOR FINAL REQUIREMENTS.

STD. MOUNTING HEIGHTS U.N.O.

ARCHITECTURAL DRAWINGS SHALL TAKE PRECEDENCE OVER MOUNTING HEIGHTS INDICATED ON ELECTRICAL DRAWINGS.

RECEPTACLES (CENTERLINE)	18"
RECEPTACLES IN EQUIP. RMS.	48"
RECEPTACLES (EXTERIOR)	24"
RECEPTACLES (GARAGES)	42"
ALARMS, SWITCHES AND CONTROLS (CENTERLINE)	48"
SAFETY SWITCHES	48"
PANELS (TOP)	72"
FIRE ALARM PULL STATIONS (HANDLE)	44"
STROBES (CENTERLINE)	80"*
FIRE ALARM BELLS (EXTERIOR)	12'-0"
CONTROLS (FIRE ALARM CONTROL PANEL)	48"
ANNUNCIATION PANELS	48"
INTERCOM (AFEA ONLY)	36"
EXIT SIGNS (WALL MOUNTED BTM.)	80"
INTERCOMS	48"
PHOTOCELLS	12'-0"

ABBREVIATIONS

A	AMPS, AIR (COMPRESSED)
AC	ABOVE COUNTER
AFC	ABOVE FINISHED CEILING
AFEA	AREA FOR EVACUATION ASSISTANCE
AFF	ABOVE FINISHED FLOOR
AFG	ABOVE FINISHED GRADE
AHU	AIR HANDLING UNIT
AIC	AMPERE INTERRUPTING CURRENT
AL	ALUMINUM
ATS	AUTOMATIC TRANSFER SWITCH
AWG	AMERICAN WIRE GAUGE
AV	FOR AUDIO VISUAL MEDIA CABINET
BFF	BELOW FINISHED FLOOR
BKR	BREAKER
BOS	BOTTOM OF STRUCTURE
BTU	BRITISH THERMAL UNIT
C	CONDUIT
CATV	CABLE TELEVISION SYSTEM
CCTV	CLOSED CIRCUIT TELEVISION
CFM	CUBIC FEET PER MINUTE
CKT	CIRCUIT
CLG	CEILING
CM	COFFEE MAKER
CU	COPPER, CONDENSING UNIT
DDC	DIRECT DIGITAL CONTROL
DN	DOWN
DPDT	DOUBLE POLE, DOUBLE THROW
DPST	DOUBLE POLE, SINGLE THROW
DW	DISHWASHER
(E)	EXISTING
EPO	EMERGENCY POWER OFF
ETR	EXISTING TO REMAIN
FBO	FURNISHED BY OTHERS
FF	FINISHED FLOOR
FHC	FIRE HOSE CABINET
FLA	FULL LOAD AMPS
FLR	FLOOR
GD	GARBAGE DISPOSAL
GFI	GROUND FAULT CIRCUIT INTERRUPTER
GFI	RECEPTACLE OR CIRCUIT BREAKER
GFR	GROUND FAULT RELAY
GND	GROUND
HSTAT	HUMIDISTAT
HTG	HEATING
HTR	HEATER
IG	ISOLATED GROUND
KCMIL	1000 CIRCULAR MILS
KV	KILOVOLT
KVA	KILOVOLT AMPS
KVAR	KILOVOLT AMPS REACTIVE
KW	KILOWATT
KWH	KILOWATT HOUR
LED	LIGHT EMITTING DIODE
LF	LINEAR FEET
LRA	LOCKED ROTOR AMPS
MCA	MINIMUM CIRCUIT AMPACITY
MCB	MAIN CIRCUIT BREAKER
MCC	MOTOR CONTROL CENTER
MD	MOTORIZED DAMPER
MDP	MAIN DISTRIBUTION PANEL
MFR	MANUFACTURER
MH	MANHOLE
MSB	MAIN SWITCHBOARD
MTD	MOUNTED
MW	MICROWAVE
N/A	NOT APPLICABLE
NIC	NOT IN CONTRACT
N/O,N/C	NORMALLY OPEN, NORMALLY CLOSED
N/L	NIGHT LIGHT
OC	ON CENTER
OV	OVEN
PH,ø	PHASE
PNL	PANEL
QTY	QUANTITY
(R)	REMOVE
(RL)	RELOCATE
RCP	REFLECTED CEILING PLAN
REF	REFRIGERATOR
REV	REVISION
RLA	RUNNING LOAD AMPS
RPM	REVOLUTIONS PER MINUTE
SA	SUPPLY AIR
SD	SMOKE DETECTOR
SF	SQUARE FEET
SPDT	SINGLE POLE, DOUBLE THROW
SPST	SINGLE POLE, SINGLE THROW
SP	STATIC PRESSURE
STO	SWITCH W/ THERMAL OVERLOAD
SWBD	SWITCHBOARD
TSTAT	THERMOSTAT
TL	TWISTLOCK
TV	TELEVISION
TYP	TYPICAL
U/F	UNDERFLOOR
U/G	UNDERGROUND
U/S	UNDER SLAB
UL	UNDERWRITERS LABORATORIES, INC.
UNO	UNLESS NOTED OTHERWISE
UPS	UNINTERRUPTIBLE POWER SUPPLY
VAV	VARIABLE AIR VOLUME
VM	VENDING MACHINE
W/	WITH
W/O	WITHOUT
WP	WEATHERPROOF
WT	WATERTIGHT, WEIGHT
XFMR	TRANSFORMER
XP	EXPLOSION PROOF

CODE SUMMARY

TOWN OF CASTLE ROCK BUILDING CODES:
2018 INTERNATIONAL BUILDING CODE
2018 INTERNATIONAL FIRE CODE
2018 INTERNATIONAL MECHANICAL CODE
2018 INTERNATIONAL PLUMBING CODE
2018 INTERNATIONAL FUEL GAS CODE
2018 ENERGY CONSERVATION CODE
2023 NATIONAL ELECTRIC CODE
ASME A17.1.2019 ELEVATOR CODE.
A117.1-2009 - ACCESSIBLE AND USABLE BUILDING AND FACILITIES

ELECTRICAL GENERAL NOTES

1. DO NOT SCALE DRAWINGS. VERIFY DIMENSIONS ON ARCHITECTURAL DRAWINGS AND IN FIELD PRIOR TO COMMENCEMENT OF WORK.

2. PROVIDE ELECTRICAL DEMOLITION REQUIRED. REFER TO ARCHITECTURAL DEMOLITION DRAWINGS FOR LOCATION AND EXTENT OF DEMOLITION REQUIRED. CONTRACTOR SHALL VISIT SITE PRIOR TO BID TO DETERMINE EXTENT OF WORK INVOLVED. PROVIDE LABOR AND MATERIALS AS REQUIRED TO MAINTAIN AND/OR RESTORE CONTINUITY OF SERVICE TO EXISTING CIRCUITS.

3. FIELD VERIFY EXISTING EQUIPMENT OR CIRCUITS THAT ARE REMAINING TO BE RECONNECTED TO NEW OR EXISTING SWITCHBOARDS/PANELBOARDS. PROVIDE SWITCHES, RECEPTACLES, CONDUIT, WIRE, ETC. AS REQUIRED TO RESTORE CONTINUITY OF CIRCUIT(S).

4. PROVIDE ALL NECESSARY DEMOLITION TO REMOVE EXISTING UNUSED CONDUIT, WIRE, CABLE, J-BOXES, RECEPTACLES, SWITCHES, LIGHTS, FIRE ALARM DEVICES, ETC. COMPLETE WITH ASSOCIATED CIRCUITING TO SOURCE. WHERE IT IS NOT FEASIBLE TO REMOVE THE ABOVE, OUTLET SHALL BE ABANDONED, WIRE REMOVED AND BLANK COVER PLATES PROVIDED.

5. FINAL CONNECTIONS TO EQUIPMENT SHALL BE IN ACCORDANCE WITH MANUFACTURER'S APPROVED WIRING DIAGRAMS, DETAILS, AND INSTRUCTIONS. IT SHALL BE THE CONTRACTOR'S RESPONSIBILITY TO PROVIDE MATERIALS AND EQUIPMENT COMPATIBLE WITH EQUIPMENT ACTUALLY SUPPLIED.

6. EXISTING SYSTEMS AND CONDITIONS SHOWN ON DRAWINGS FOR EXISTING BUILDINGS ARE TO BE NOTED "FOR GUIDANCE ONLY". THE ELECTRICAL CONTRACTOR TO FIELD CHECK ALL EXISTING CONDITIONS PRIOR TO BIDDING AND TO INCLUDE IN HIS BID AN ALLOWANCE FOR REMOVAL AND/OR RELOCATION OF EXISTING CONDUITS, WIRES, DEVICES, FIXTURES, OR OTHER EQUIPMENT AS INDICATED ON THE PLANS OR AS REQUIRED TO COORDINATE AND ADAPT NEW AND EXISTING ELECTRICAL SYSTEM TO ALL OTHER WORK AS REQUIRED.

7. PRIOR TO COMMENCEMENT OF DEMOLITION, THE CONTRACTOR SHALL SUBMIT A SYSTEM SHUTDOWN REQUEST FOR ALL SYSTEMS, I.E. HVAC, ELECTRICAL, FIRE ALARM, ECS, ETC

8. REVIEW ARCHITECTURAL, STRUCTURAL, MECHANICAL AND OTHER DRAWINGS PRIOR TO BID.

9. WORK SHALL BE PERFORMED IN A WORKMANLIKE MANNER TO THE SATISFACTION OF THE ARCHITECT/ENGINEER.

10. WORK, MATERIALS, AND EQUIPMENT SHALL CONFORM TO THE LATEST EDITIONS OF LOCAL, STATE, AND NATIONAL CODES AND ORDINANCES.

11. PROVIDE PERMITS AND INSPECTIONS REQUIRED.

12. SYSTEMS SHALL BE TESTED FOR PROPER OPERATION. IF TESTS SHOW THAT WORK IS DEFECTIVE, CONTRACTOR SHALL MAKE CORRECTIONS NECESSARY AT NO COST TO OWNER.

13. FIRE ALARM SYSTEM SHALL BE DESIGNED AND SUBMITTED AS DELEGATED DESIGN SUBMITTAL. MATERIALS, EQUIPMENT, AND WORKMANSHIP SHALL MEET PREVAILING CODES. THE SYSTEM SHALL BE COMPLETE AND OPERABLE IN EVERY RESPECT. SUBMIT SHOP DRAWINGS ACCORDING TO SPECIFICATIONS. SHOP DRAWINGS SHALL INCLUDE A SINGLE LINE DIAGRAM THAT SHOWS DEVICES, CONDUIT, WIRE, CABLE SIZES AND EQUIPMENT TO BE USED. SHOP DRAWINGS SHALL BE STAMPED AND SIGNED BY A REGISTERED ENGINEER. SYSTEM CALIBRATION AND TESTING SHALL BE BY FACTORY CERTIFIED TECHNICIAN.

14. WIRE SHALL BE COPPER, 60 DEGREES C RATED FOR ALL CIRCUITS/FEEDERS 30 AMPS OR LESS, 75 DEGREES C RATED FOR ALL CIRCUITS/FEEDERS OVER 30 AMPS. SIZES INDICATED ARE FOR INSTALLATION IN A MAXIMUM 30 DEGREES C AMBIENT. CONDUCTOR AMPACITY SHALL BE DE-RATED FOR HIGHER AMBIENT INSTALLATIONS.

15. CONTRACTOR SHALL BE RESPONSIBLE FOR REPLACING EQUIPMENT WHICH IS DAMAGED DUE TO INCORRECT FIELD WIRING PROVIDED UNDER THIS SECTION, OR FACTORY WIRING IN EQUIPMENT PROVIDED UNDER THIS SECTION.

16. CONTRACTOR'S FAILURE TO ORDER OR RELEASE ORDER FOR MATERIALS AND/OR EQUIPMENT WILL NOT BE ACCEPTED AS A REASON TO SUBSTITUTE ALTERNATE MATERIALS, EQUIPMENT, OR INSTALLATION METHODS.

17. SYSTEMS SHALL BE COMPLETE, OPERABLE, AND READY FOR CONTINUOUS OPERATION. LIGHTS, SWITCHES, RECEPTACLES, MOTORS, ETC. SHALL BE CONNECTED AND OPERABLE.

18. RECEPTACLES WHICH ARE SHOWN WALL MOUNTED ON THE ELECTRICAL DRAWINGS ON WALLS WHICH, ON THE ARCHITECTURAL DRAWINGS AND ELEVATIONS, ARE SHOWN AS GLASS OR PARTITIONS SHALL BE FLUSH FLOOR DUPLEX RECEPTACLES MOUNTED ADJACENT TO BASE OR WALLS.

19. BOXES FOR TELEPHONE, TV, COMPUTER, WIRING DEVICES, ETC. SHALL BE MINIMUM 4" SQUARE.

20. RECESSED FIXTURES INSTALLED INDOORS SHALL BE THERMALLY PROTECTED.

21. SEE DIVISION 22 AND 23 DRAWINGS FOR LOCATION OF MECHANICAL AND PLUMBING EQUIPMENT. PROVIDE SERVICE TO, AND CONNECT EQUIPMENT AS REQUIRED.

22. CONDUITS PENETRATING THROUGH ROOF SHALL HAVE ROOF FLASHING WITH CAULK TYPE COUNTER FLASHING SLEEVE. INSTALLATION SHALL BE WATERTIGHT.

23. FINAL CONNECTIONS TO MOTORS, TRANSFORMERS AND OTHER VIBRATING EQUIPMENT SHALL BE WITH SEAL TIGHT FLEX AND APPROVED FITTINGS. DO NOT SECURE CONDUITS, DISCONNECTS, OR DEVICES TO DUCTWORK OR MECHANICAL EQUIPMENT.

24. WHERE PANELS ARE INSTALLED FLUSH WITH WALLS, EMPTY CONDUITS SHALL BE EXTENDED FROM THE PANEL TO AN ACCESSIBLE SPACE ABOVE OR BELOW. A MINIMUM OF ONE 3/4" CONDUIT SHALL BE INSTALLED FOR EVERY THREE SINGLE POLE SPARE CIRCUIT BREAKERS OR SPACES, OR FRACTION THEREOF, BUT NOT LESS THAN TWO CONDUITS.

25. ALL ELECTRICAL SYSTEMS COMPONENTS SHALL BE LISTED OR LABELED BY UL OR OTHER RECOGNIZED TESTING FACILITY.

26. PROVIDE CARBON MONOXIDE DETECTORS AS REQUIRED PER NFPA 72, 17.12. LOCATIONS INCLUDE BUT NOT LIMITED TO:
- 26.1. ADJACENT TO PERMANENTLY INSTALLED FUEL-BURNING APPLIANCES.
- 26.2. CENTRALLY LOCATED ON EVERY HABITABLE LEVEL AND IN EVERY HVAC ZONE OF THE BUILDING.
- 26.3. OUTSIDE OF EACH SEPARATE DWELLING UNIT, GUEST ROOM, AND GUEST SUITE SLEEPING AREA WITHIN 21 FT OF ANY DOOR TO A SLEEPING ROOM.

SCOPE OF WORK

ELECTRICAL ENGINEERING DESIGN DOCUMENTS FOR THE RENOVATION AND NEW CONSTRUCTION OF A BOUTIQUE HOTEL AT 415 PERRY ST, CASTLE ROCK, CO. A NEW 4 STORY WITH APPROXIMATELY 30 ROOMS. AN ESTIMATED 2000SF OF SPACE ON THE MAIN LEVEL WILL BE PROVIDED WITH A CORE/SHELL LEVEL FINISH FOR FUTURE RESTAURANT CONCEPT TO BE FINISHED AS PART OF A SEPARATE PERMIT ALONG WITH A ROOFTOP SPEAKEASY. THE ADJACENT EXISTING BUILDING IS TO REMAIN.

COMMISSIONING

- SYSTEMS COMMISSIONING SHALL BE PROVIDED IN ACCORDANCE WITH 2018 IECC C408.1 AND 408.3.
- PRELIMINARY AND FINAL COMMISSIONING REPORTS, FUNCTIONAL TESTING OF LIGHTING CONTROLS REPORT, LOCATION AND CATALOGUE NUMBER OF EACH PIECE OF EQUIPMENT, AND OPERATING AND MAINTENANCE MANUALS SHALL BE PROVIDED TO THE OWNER WITHIN 90 DAYS OF DATE OF RECEIPT OF CERTIFICATE OF OCCUPANCY.
- ADDITIONAL REQUIREMENTS ARE OUTLINED IN PROJECT SPECIFICATION SECTION 26 0800.

ENERGY COMPLIANCE

- THIS PROJECT IS DESIGNED IN ACCORDANCE WITH 2018 IECC.
- THIS PROJECT IS PURSUING ENERGY COMPLAINCE VIA 2018 IECC C406, PRESCRIPTIVE PATH.

Autodesk Docs://2024-020 City Hotel/(2024) City Hotel - Elec.rvt
5/20/2026 9:03:17 AM

Ramirez, Johnson, & Associates
1801 Lawrence St. Ste C
Denver, CO 80205
P: 720.598.0774
HELTSHE
M1A MERIDIAN 105 ARCHITECTURE

CITY HOTEL
415 PERRY STREET, CASTLE ROCK, CO.

DATE: 05.20.2026
PROJ. NO. 2023.002
ISSUED FOR: 1st PERMIT COMMENTS
SHEET TITLE: ELECTRICAL LEGEND

COLORADO LICENSED
DEBORA A MIRA
43565
05/27/2026
PROFESSIONAL ENGINEER

SHEET NUMBER
E0.00

SHORT CIRCUIT / VOLTAGE DROP ANALYSIS CALCULATIONS

PROJECT NAME: CITY HOTEL **PROJECT NO:** 2024-020 **BY:** RJA

FROM	INITIAL ISC	INITIAL PRI VOLT	TO	LOAD AMPS	CABLE USED	CABLE FT	CABLE SETS OF CONDS	CABLE AWG OR MCM	CABLE AL OR CU	CABLE MAG OR NMAG	C VALUE	CIRC MILS	FINAL F	FINAL M	FINAL ISC	SEGMENT VD VD	SEGMENT VD % VD (L-N)	CUMM VD VD	CUMM VD %VD (L-N)
UTIL XFMR	83272	208	METER/CT	2000	X	10	6	400	CU	NMAG	145782	2400000	0.04757	0.954594	**79491**	0.2	0.1	0.2	**0.1**
METER/CT	79491	208	MDP	2000	X	15	6	400	CU	NMAG	145782	2400000	0.06811	0.936234	**74422**	0.3	0.1	0.5	**0.2**
MDP	74422	208	ATS-1	125	X	7	1	1/0	CU	MAG	8925	105600	0.48606	0.672921	**50080**	0.2	0.1	0.7	**0.3**
ATS-1	50080	208	EM	125	X	5	1	1/0	CU	MAG	8925	105600	0.23363	0.810617	**40596**	0.1	0.1	0.8	**0.4**
EM	40596	208	ELEV N	60	X	15	1	4	CU	MAG	3806	41740	1.33230	0.428762	**17406**	0.5	0.2	1.3	**0.6**
ELEV N	17406	208	ELEV N CTRL PNL	60	X	30	1	4	CU	MAG	3806	41740	1.14248	0.466749	**8124**	1.0	0.5	2.3	**1.1**
EM	40596	208	ELEV S	60	X	56	1	4	CU	MAG	3806	41740	4.97392	0.167394	**6796**	1.9	0.9	4.2	**2.0**
ELEV S	6796	208	ELEV S CTRL PNL	60	X	30	1	4	CU	MAG	3806	41740	0.44604	0.691544	**4699**	1.0	0.5	5.2	**2.5**
MDP	74422	208	ATS-2	125	X	21	1	1/0	CU	MAG	8925	105600	1.45818	0.406805	**30275**	0.6	0.3	1.1	**0.5**
ATS-2	40596	208	SB	125	X	5	1	1/0	CU	MAG	8925	105600	0.18938	0.840772	**34132**	0.1	0.1	1.2	**0.6**
MDP	74422	208	L1	200	X	18	2	3/0	CU	MAG	25688	335600	0.43425	0.697228	**51889**	0.2	0.1	0.7	**0.4**
MDP	74422	208	R1	200	X	94	1	3/0	CU	MAG	12844	167800	4.53552	0.180651	**13444**	2.6	1.2	3.1	**1.5**
MDP	74422	208	K	400	X	14	2	3/0	CU	MAG	25688	335600	0.33775	0.747523	**55632**	0.4	0.2	0.9	**0.4**
MDP	74422	208	M12	600	X	17	2	350	CU	MAG	39408	700000	0.26734	0.789054	**58723**	0.3	0.2	0.8	**0.4**
MDP	74422	208	L2A	400	X	35	2	3/0	CU	MAG	25688	335600	0.84438	0.542188	**40351**	1.0	0.5	1.4	**0.7**
L2A	40351	208	L2B	200	X	84	1	3/0	CU	MAG	12844	167800	2.19750	0.312745	**12619**	2.3	1.1	3.3	**1.6**
MDP	74422	208	L3A	400	X	45	2	3/0	CU	MAG	25688	335600	1.08563	0.479471	**35683**	1.2	0.6	1.7	**0.8**
L3A	35683	208	L3B	200	X	84	1	3/0	CU	MAG	12844	167800	1.94331	0.339754	**12124**	2.3	1.1	3.6	**1.7**
MDP	74422	208	M34	400	X	47	2	3/0	CU	MAG	25688	335600	1.13388	0.468630	**34876**	1.3	0.6	1.8	**0.9**
MDP	74422	208	L4	200	X	55	1	3/0	CU	MAG	12844	167800	2.65376	0.273690	**20369**	1.5	0.7	2.0	**1.0**
MDP	74422	208	B	200	X	118	1	3/0	CU	MAG	12844	167800	5.69353	0.149398	**11119**	3.3	1.6	3.7	**1.8**
UTIL XFMR	83272	208	FIRE PUMP METER	175	X	18	1	2/0	CU	NMAG	11424	133100	1.09257	0.477881	**39794**	0.5	0.3	0.5	**0.3**
FIRE PUMP METER	39794	208	FIRE PUMP	175	X	7	1	2/0	CU	MAG	10755	133100	0.21568	0.822587	**32734**	0.2	0.1	0.8	**0.4**
UTIL XFMR	83272	208	L1B & METER	200	X	117	1	3/0	CU	NMAG	13923	167800	5.82706	0.146476	**12197**	3.2	1.6	3.2	**1.6**

NOTE: FEEDER LENGTHS ARE TO BE IN FEET AND AS SHOWN ON THE DRAWINGS PER FAULT CURRENT REQUIREMENTS OF NEC 110.9 AND 110.10. FEEDER LENGTH SHORTER THAN SPECIFIED WILL NOT BE ACCEPTED. CONTRACTOR SHALL NOTIFY ENGINEER OF ANY FIELD CONDITION THAT RESULTS IN A CHANGE OF 10% OR GREATER CIRCUIT DISTANCE.

COPPER GROUNDING SCHEDULE

SERVICE SIZE	GROUNDING NOTES, SEE BELOW. (1)	(2)	(3)	(4)	(5)
200A	4	6	4	4	6
2000A	3/0	6	3/0	4	6

GROUNDING NOTES:
(1) ALTERNATING-CURRENT GROUNDING ELECTRODE CONDUCTOR (NEC 250.66)
(2) STEEL GROUND ROD, 5/8" X 8' COPPER CLAD (NEC 250.66.A)-PROVIDE #6, OR AS NOTED IF EXTENDING TO OTHER TYPES OF ELECTRODES REQUIRING LARGER CONDUCTOR, SPRINKLER/GAS/ ETC PIPE (NEC 250-104.B) PROVIDE SUPPLEMENTAL ELECTRODE AS REQUIRED PER NEC 250.53.
(3) STRUCTURAL STEEL (NEC 250-104.C), COLD WATER PIPE (NEC 250.104.A)
(4) CONCRETE ENCASED ELECTRODE - UFER (NEC 250.66.B)
(5) BONDING FOR COMMUNICATIONS SYSTEMS (NEC 250.94)

GENERAL NOTES:
1. IF EXACT SERVICE SIZE IS NOT LISTED, USE NEXT AMPERAGE SIZE UP.
2. NEC REFERENCES ARE FROM NEC 2023.
3. BONDS SHALL BE MECHANICAL TYPE. INTERIOR BONDS MAY BE EXOTHERMIC.
4. BOND SIZE SHALL MATCH CONDUCTORS SHOWN ON FEEDER SCHEDULE.
5. GROUND CONDUCTORS SHALL BE STRANDED COPPER INSULATED CABLE, UON.
6. IF SINGLE ROD, PIPE, OR PLATE ELECTRODE RESISTANCE IS OVER 25 OHMS, PROVIDE SUPPLEMENTAL ELECTRODE PER NEC 250.53.A.
7. PROVIDE GROUNDING ELECTRODE CONNECTIONS IN ACCORDANCE WITH NEC 250.64(D).

Switchboard: MDP

Location: ELEC 104 **Volts:** 120/208 Wye **A.I.C. Rating:** 85KAIC
Supply From: **Phases:** 3 **Mains Type:** MCB
Mounting: SURFACE **Wires:** 4 **Mains Rating:** 2000 A
Enclosure: NEMA 3R **MCB Rating:** 2000 A

CKT	Circuit Description	Load Classification	Frame	Trip	Poles	Phase A	Phase B	Phase C	Load	Notes
1	EM	Spare; E; L; M	125 A	125 A	3	10916 VA	10780 VA	11395 VA	33091 VA	
2	SB	Spare	125 A	125 A	3	0 VA	0 VA	0 VA	0 VA	
3	L1	Spare; R; E; C; L	200 A	200 A	3	7067 VA	6930 VA	6419 VA	20415 VA	
4	K	Spare; A	400 A	400 A	3	1320 VA	0 VA	0 VA	1320 VA	
5	M12	Spare; R; E; M	600 A	600 A	3	50542 VA	51489 VA	52903 VA	154934 VA	
6	R1	Spare; R; L	200 A	200 A	3	792 VA	0 VA	0 VA	792 VA	
7	L2A	Spare; R; E; L; M; A	400 A	400 A	3	42102 VA	40851 VA	41079 VA	124032 VA	
8	L3A	Spare; R; E; L; M; A	400 A	400 A	3	41156 VA	41102 VA	41739 VA	123996 VA	
9	M34	Spare; R; E; M	400 A	400 A	3	28249 VA	27954 VA	27747 VA	83949 VA	
10	L4	Spare; R; E; L; M; A	200 A	200 A	3	15239 VA	16849 VA	16848 VA	48936 VA	
11	B	Spare; R; L; M	200 A	200 A	3	1760 VA	1260 VA	1116 VA	4136 VA	
12	SPACE (200A FRAME)	--	200 A	200 A	3	0 VA	0 VA	0 VA	0 VA	
13	SPACE (200A FRAME)	--	200 A	200 A	3	0 VA	0 VA	0 VA	0 VA	
14	SPACE (200A FRAME)	--	200 A	200 A	3	0 VA	0 VA	0 VA	0 VA	
15	SPACE (200A FRAME)	--	200 A	200 A	3	0 VA	0 VA	0 VA	0 VA	
16	FUTURE SOLAR CONNECTION	--	200 A	200 A	3	0 VA	0 VA	0 VA	0 VA	
					Total Conn. Load:	199142 VA	197213 VA	199245 VA		
					Total Amps:	1662 A	1643 A	1663 A		

	Load Classification	Connected Load	Demand Factor	Estimated Demand	Panel Totals	
L	Lighting	15609 VA	125.00%	19511 VA		
C	Continuous	2400 VA	125.00%	3000 VA	**Total Conn. Load:**	595601 VA
R	Receptacle	90720 VA	55.51%	50360 VA	**Total Est. Demand:**	545421 VA
M	Motor	292767 VA	100.00%	292767 VA	**Total Conn.:**	1653 A
LM	Largest Motor				**Total Est. Demand:**	1514 A
E	Equipment	153186 VA	153186 VA	153186 VA		
A	Appliance	40920 VA	65.00%	26598 VA		

Notes:

ESTIMATED FUTURE LOADS
PANEL SB: 13.5KVA
PANEL K: 90KVA
PANEL R1: 45KVA
PANEL B: 15KVA
TOTAL: 163.5KVA
454A

GENERAL NOTES

1. REFER TO ELECTRICAL FLOOR PLANS FOR PANEL LOCATIONS.
2. CONTRACTOR IS RESPONSIBLE FOR SUBMITTING UTILITY APPLICATION TO UTILITY COMPANY.
3. CONTRACTOR SHALL PROVIDE SELECTIVE COORDINATION AS REQUIRED BY NEC 700.32 UPON ACCEPTANCE OF BID TO BE SUBMITTED WITH PERMIT DOCUMENTS.
4. ALL EQUIPMENT IS NEW UNLESS OTHERWISE NOTED.
5. ALL NEW DEVICES IN EXISTING GEAR SHALL BE UL LISTED FOR THE EQUIPMENT, BE OF THE SAME MANUFACTURER AND WITHSTAND RATING.
6. ITEMS SHOWN IN THIN DASHED LIGHT LINEWEIGHT ARE EXISTING TO REMAIN. ITEMS SHOWN IN THICK BLACK LINEWEIGHT ARE NEW.
7. CONTRACTOR SHALL CONTACT UTILITY COMPANY TO COORDINATE ELECTRICAL WORK. COORDINATE AND VERIFY EXISTING ELECTRICAL SERVICE AND TRANSFORMER ARE OF ADEQUATE CAPACITY TO ACCOMMODATE NEW WORK. COORDINATE WITH OWNER/GC PRIOR TO BID.

KEY NOTES (THIS SHEET)

1. COORDINATE METER AND CT REQUIREMENTS WITH XCEL ENERGY AND VERIFY WITH BUILDING OWNER/ELECTRICAL CONTRACTOR THAT METER AND CT HAVE BEEN INSTALLED IN ACCORDANCE WITH XCEL REQUIREMENTS.
2. REFER TO BONDING SCHEDULE FOR ADDITIONAL INFORMATION. CONNECT GROUNDING INDICATED TO ALL AVAILABLE POINTS.
3. CONTRACTOR SHALL PROVIDE CIRCUIT BREAKER WHICH CONFORMS TO THE ARC ENERGY REDUCTION REQUIREMENTS OF NEC 240.87.
4. PROVIDE GROUNDING ELECTRODE CONNECTIONS IN ACCORDANCE WITH NEC 250.64(D).
5. PROVIDE LABELING AS REQUIRED PER NEC 230.70 FOR MULTIPLE SERVICE DISCONNECTS. PROVIDE WITHIN LABELING THAT BUILDINGS HAVE SEPARATE ADDRESSES AND LOCATION OF OTHER DISCONNECT.
6. PROVIDE DIGITAL SUB-METERING EQUIPMENT FOR MONITORING OF ELECTRICAL UTILITIES FOR RETAIL TENANT. PROVIDE ALL REQUIRED COMPONENTS FOR A COMPLETE AND OPERABLE METERING SYSTEM INCLUDING SUB-METERING EQUIPMENT, DATA COLLECTION SYSTEMS, DATA NETWORKING DEVICES, AND DATA MANAGEMENT SOFTWARE SYSTEMS. COORDINATE EXACT REQUIREMENTS INCLUDING SPACE REQUIREMENTS AND LAYOUT WITH SELECTED METERING EQUIPMENT.
7. LABEL SPACE "FOR FUTURE ELECTRIC SOLAR" PER 2018 IECC CA103.7.

COPPER FEEDER SCHEDULE

MARK	CONDUCTOR AND CONDUIT
60A4	4 #4, 1 #10 GND-1 1/4" C
125A4	4 #1/0, 1 #6 GND-2" C
175A4	4 #2/0, 1 #6 GND-2" C
175S4	4 #2/0 - 2" C
200A4	4 #3/0, 1 #6 GND 2"-C
200S4	4 #3/0 - 2" C
400A4	2 SETS OF 4 #3/0, 1 #3 GND-2" C
600A4	2 SETS OF 4 350 KCMIL, 1 #1 GND-3" C
2000S4	6 SETS OF 4 400 KCMIL - 3" C

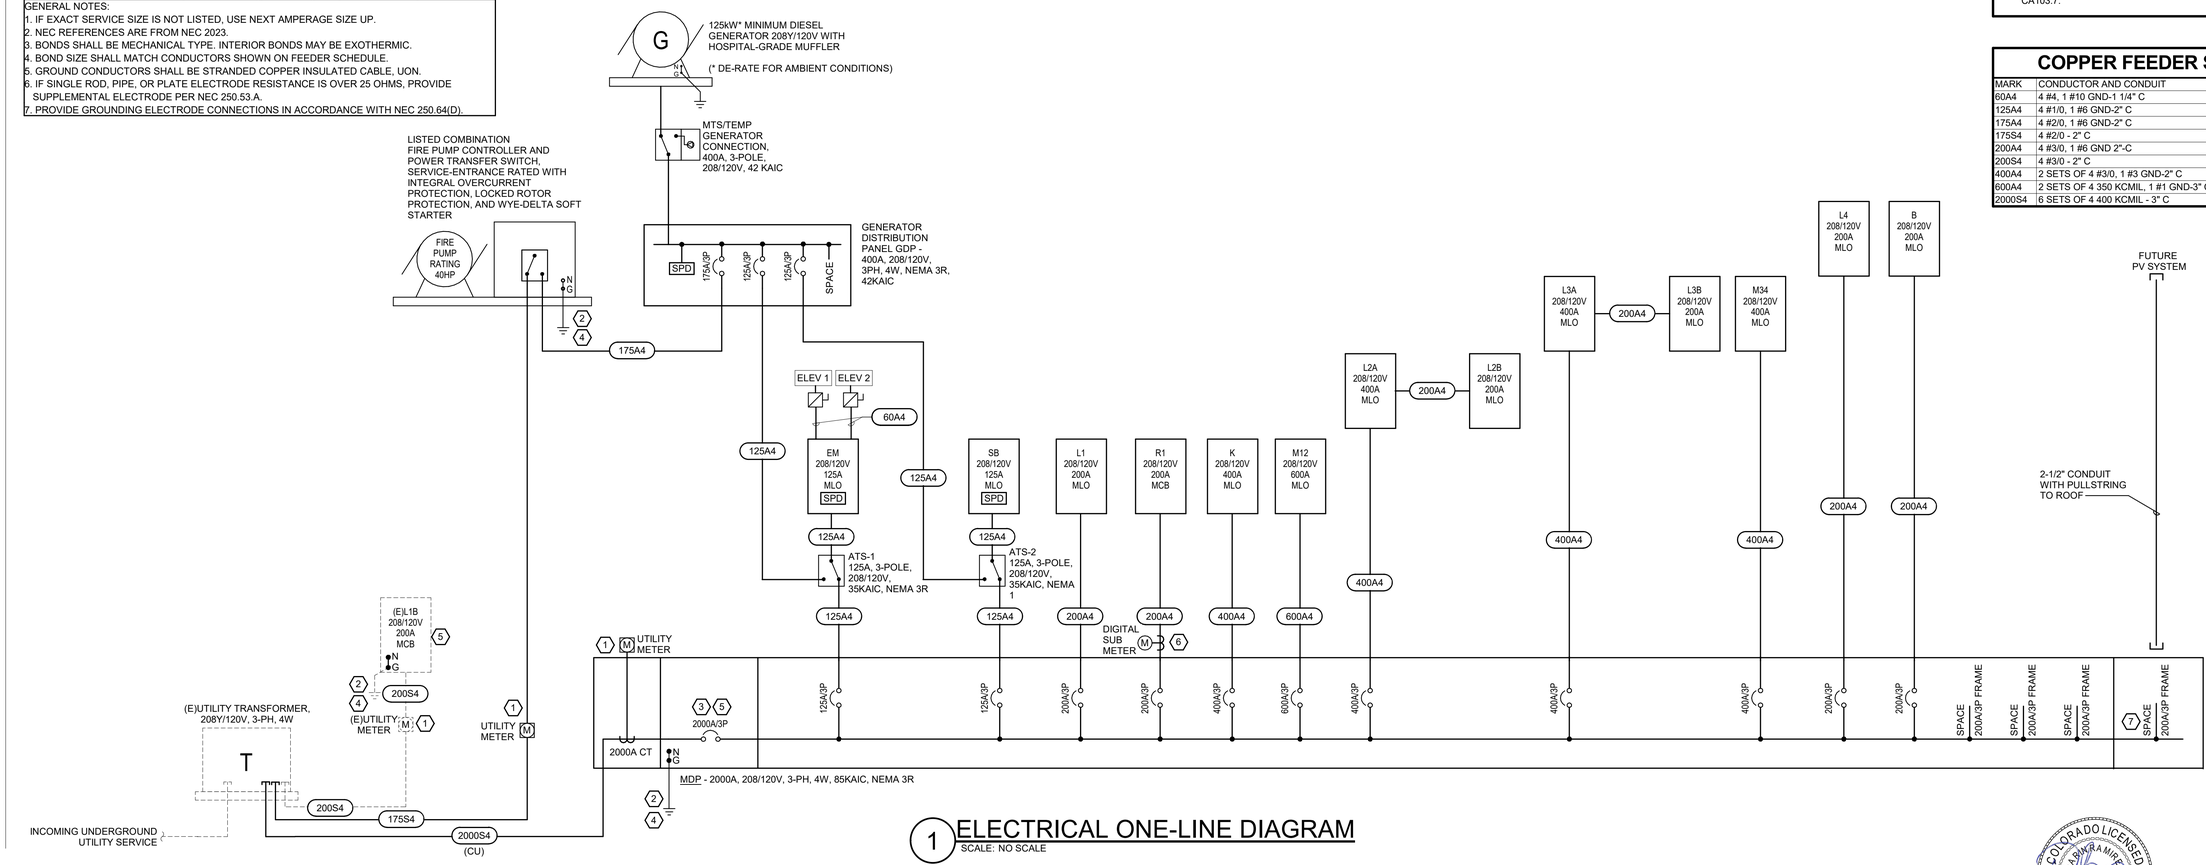

1 ELECTRICAL ONE-LINE DIAGRAM
SCALE: NO SCALE

Ramirez, Johnson, & Associates — 1001 Lawrence St. Ste 2, Denver, CO 80205, P: 720.598.0774
HELTSHE

M1A MERIDIAN 105 ARCHITECTURE

CITY HOTEL
415 PERRY STREET, CASTLE ROCK, CO.

DATE: 05.20.2026
PROJ. NO. 2023.002
ISSUED FOR: 1st PERMIT COMMENTS
SHEET TITLE: ELECTRICAL ONE-LINE DIAGRAM

COLORADO LICENSED — RAMIREZ — 43565 — 05/27/2026 — PROFESSIONAL ENGINEER

SHEET NUMBER E0.01

Autodesk Docs://2024-020 City Hotel/(2024) City Hotel - Elec.rvt
5/20/2026 9:03:19 AM

Branch Panel: EM

Location: SEE PLANS
Supply From: MDP
Mounting: SURFACE
Enclosure: NEMA 1

Volts: 120/208 Wye
Phases: 3
Wires: 4

A.I.C. Rating: 65,000
Mains Type: MLO
Bus Rating: 125 A

CKT	Circuit Description	OPT	Load Class	Trip	Poles	A		B		C		Poles	Trip	Load Class	OPT	Circuit Description	CKT
1	LTG - 2ND FLOOR CORRIDOR		L	20 A	1	422	4933										
3	LTG - 3ND FLOOR CORRIDOR		L	20 A	1			480	4933			3	60 A	M		ELEVATOR-NORTH	4
5	LTG - 4TH FLOOR CORRIDOR		L	20 A	1					444	4933						6
7	LTG - STAIRS (N)		L	20 A	1	128	250										
9	LTG - STAIRS (S)		L	20 A	1			133	250			2	20 A	E		ELEV-NORTH CAB LTG ELEV-NORTH CAB HVAC	8 10
11	LTG - 1ST FLOOR EM LIGHTS		L	20 A	1					785	4933						12
13	SPARE		--	20 A	1	0	4933										
15	SPARE		--	20 A	1			0	4933			3	60 A	M		ELEVATOR-SOUTH	14 16
17	SPARE		--	20 A	1					0	250						18
19	SPARE		--	20 A	1	0	250					2	20 A	E		ELEV-SOUTH CAB LTG ELEV-SOUTH CAB HVAC	20
21	SPARE		--	20 A	1			0	50			1	20 A	E		ELEV-NORTH CAMERA	22
23	SPARE		--	20 A	1					0	50	1	20 A	E		ELEV-SOUTH CAMERA	24
25	SPARE		--	20 A	1	0	0					1	20 A	--		SPARE	26
27	SPARE		--	20 A	1			0	0			1	20 A	--		SPARE	28
29	SPARE		--	20 A	1					0	0	1	20 A	--		SPARE	30
31	SPARE		--	20 A	1	0	0					1	20 A	--		SPARE	32
33	SPARE		--	20 A	1			0	0			1	20 A	--		SPARE	34
35	SPACE		--	--	1					--	--	1	--	--		SPACE	36
37	SPACE		--	--	1	--	--					1	--	--		SPACE	38
39	SPACE		--	--	1			--	--			1	--	--		SPACE	40
41	SPACE		--	--	1					--	--	1	--	--		SPACE	42
						Total Load:		10916 VA		10780 VA		11395 VA					
						Total Amps:		91 A		90 A		95 A					
						Phase Balance		99 % A-B		95 % B-C		96 % C-A					

Load Classification		Connected Load	Demand Factor	Estimated Demand	Panel Totals	
L	Lighting	2391 VA	125.00%	2989 VA		
C	Continuous				**Total Conn. Load:**	33091 VA
R	Receptacle				**Total Est. Demand:**	33689 VA
M	Motor	29600 VA	100.00%	29600 VA	**Total Conn.:**	92 A
LM	Largest Motor				**Total Est. Demand:**	94 A
E	Equipment	1100 VA	100.00%	1100 VA	**Spare Capacity:**	31 A
A	Appliance					

OPTIONS:
'ST' – PROVIDE SHUNT TRIP BREAKER / 'GFCI' – PROVIDE CIRCUIT BREAKER / 'GFP' – PROVIDE GFP CIRCUIT BREAKER / 'ERMS' - ENERGY REDUCING MAINTENANCE SWITCH / 'ZSI' - ZONE SELECTIVE INTERLOCKING / 'L' - PROVIDE CIRCUIT BREAKER WITH LOCKING PROVISIONS / 'R' – PROVIDE CIRCUIT BREAKER WITH RED MARKING

Notes:

Branch Panel: L1

Location: SEE PLANS
Supply From: MDP
Mounting: SURFACE
Enclosure: NEMA 1

Volts: 120/208 Wye
Phases: 3
Wires: 4

A.I.C. Rating: 65,000
Mains Type: MLO
Bus Rating: 200 A

CKT	Circuit Description	OPT	Load Class	Trip	Poles	A		B		C		Poles	Trip	Load Class	OPT	Circuit Description	CKT
1	LTG - STAIRS (N)		L	20 A	1	128	930					1	20 A	L		LTG - 1ST FLOOR TAPE LIGHTS	2
3	LTG - STAIRS (S)		L	20 A	1			128	888			1	20 A	L		LTG - LOBBY DOWNLIGHTS	4
5	REC - LINEN&ELEC&GEN&CORR		R	20 A	1					900	572	1	20 A	L		LTG - 1ST FLOOR SOUTH LIGHTS	6
7	REC - ELEV-NORTH		R	20 A	1	180	1318					1	20 A	L		LTG - 1ST FLOOR NORTH LIGHTS	8
9	REC - ELEV-SOUTH		R	20 A	1			180	1200			1	20 A	E		FACP	10
11	REC - LOBBY		R	20 A	1					720	466	1	20 A	L		EXTERIOR LIGHTING	12
13	IRRIGATION CONTROLLER		R	20 A	1	180	1200					1	20 A	C	L	SIGNAGE	14
15	REC - LOBBY FLOOR RCPTS		R	20 A	1			1080	1200			1	20 A	C	L	SIGNAGE	16
17	BOOSTER PUMP		R	20 A	1					180	360	1	20 A	R		REC-CHARGING STATION	18
19	REC - TOILETS&JAN (NORTH)		R	20 A	1	540	50					1	20 A	E		FLOW SWITCH/TAMPER SWITCH	20
21	REC - VESTIBUL&DATA		R	20 A	1			720	252			1	20 A	L		LTG - MECH MEZZANINE	22
23	REC - TOILETS (SOUTH)		R	20 A	1					540	100	1	20 A	E		ADA DOOR OPENERS	24
25	IT HEAD END		R	20 A	1	360	500					1	20 A	E		GENERATOR JACKET HEATER	26
27	TELECOM ENTRY		R	20 A	1			360	500			1	20 A	E		GENERATOR STARTER	28
29	REC - OFFICE 117&118		R	20 A	1					1080	180	1	20 A	R		GENERATOR RECEPTACLE	30
31	REC - BREAK&LIQ&CORR&ELEC		R	20 A	1	1620	62					1	20 A	L		LTG - ELEV NORTH PIT	32
33	REC - PARKING		R	20 A	1			360	62			1	20 A	L		LTG - ELEV SOUTH PIT	34
35	REC - AMENITY		R	20 A	1					1260	62	1	20 A	L		LTG - ELEV CTRL ROOM	36
37	SPARE		--	20 A	1	0	0					1	20 A	--		SPARE	38
39	SPARE		--	20 A	1			0	0			1	20 A	--		SPARE	40
41	SPARE		--	20 A	1					0	0	1	20 A	--		SPARE	42
43	SPACE		--	--	1	--	0					1	20 A	--		SPARE	44
45	SPACE		--	--	1			--	0			1	20 A	--		SPARE	46
47	SPACE		--	--	1					--	0	1	20 A	--		SPARE	48
49	SPACE		--	--	1	--	0					1	20 A	--		SPARE	50
51	SPACE		--	--	1			--	0			1	20 A	--		SPARE	52
53	SPACE		--	--	1					--	0	1	20 A	--		SPARE	54
55	SPACE		--	--	1	--	0					1	20 A	--		SPARE	56
57	SPACE		--	--	1			--	0			1	20 A	--		SPARE	58
59	SPACE		--	--	1					--	0	1	20 A	--		SPARE	60
						Total Load:		7067 VA		6930 VA		6419 VA					
						Total Amps:		60 A		58 A		53 A					
						Phase Balance		98 % A-B		93 % B-C		91 % C-A					

Load Classification		Connected Load	Demand Factor	Estimated Demand	Panel Totals	
L	Lighting	4866 VA	125.00%	6082 VA		
C	Continuous	2400 VA	125.00%	3000 VA	**Total Conn. Load:**	20415 VA
R	Receptacle	10800 VA	96.30%	10400 VA	**Total Est. Demand:**	21831 VA
M	Motor				**Total Conn.:**	57 A
LM	Largest Motor				**Total Est. Demand:**	61 A
E	Equipment	2350 VA	100.00%	2350 VA	**Spare Capacity:**	139 A
A	Appliance					

OPTIONS:
'ST' – PROVIDE SHUNT TRIP BREAKER / 'GFCI' – PROVIDE CIRCUIT BREAKER / 'GFP' – PROVIDE GFP CIRCUIT BREAKER / 'ERMS' - ENERGY REDUCING MAINTENANCE SWITCH / 'ZSI' - ZONE SELECTIVE INTERLOCKING / 'L' - PROVIDE CIRCUIT BREAKER WITH LOCKING PROVISIONS / 'R' – PROVIDE CIRCUIT BREAKER WITH RED MARKING

Notes:

Branch Panel: GDP

Location: SEE PLANS
Supply From:
Mounting: SURFACE
Enclosure: NEMA 3R

Volts: 120/208 Wye
Phases: 3
Wires: 4

A.I.C. Rating: 42,000
Mains Type: MLO
Bus Rating: 400 A

CKT	Circuit Description	OPT	Load Class	Trip	Poles	A		B		C		Poles	Trip	Load Class	OPT	Circuit Description	CKT
1						0	13690										
3	SPD		--	20 A	3			0	13690			3	175 A	LM		FIRE PUMP	4
5										0	13690						6
7						10916	0										8
9	EM		--	125 A	3			10780	0			3	125 A	--		SB	10
11										11935	0						12
13						3696	0					1	20 A	--		SPARE	14
15	JOCKEY PUMP		M	40 A	3			3696	0			1	20 A	--		SPARE	16
17										3696	0	1	20 A	--		SPARE	18
19	SPACE		--	--	1	--	--					1	--	--		SPACE	20
21	SPACE		--	--	1			--	--			1	--	--		SPACE	22
23	SPACE		--	--	1					--	--	1	--	--		SPACE	24
						Total Load:		28302 VA		28166 VA		29321 VA					
						Total Amps:		236 A		235 A		245 A					
						Phase Balance		100 % A-B		96 % B-C		97 % C-A					

Load Classification		Connected Load	Demand Factor	Estimated Demand	Panel Totals	
L	Lighting					
C	Continuous				**Total Conn. Load:**	85789 VA
R	Receptacle				**Total Est. Demand:**	96057 VA
M	Motor	11088 VA	100.00%	11088 VA	**Total Conn.:**	238 A
LM	Largest Motor	41070 VA	125.00%	51338 VA	**Total Est. Demand:**	267 A
E	Equipment				**Spare Capacity:**	133 A
A	Appliance					

OPTIONS:
'ST' – PROVIDE SHUNT TRIP BREAKER / 'GFCI' – PROVIDE CIRCUIT BREAKER / 'GFP' – PROVIDE GFP CIRCUIT BREAKER / 'ERMS' - ENERGY REDUCING MAINTENANCE SWITCH / 'ZSI' - ZONE SELECTIVE INTERLOCKING / 'L' - PROVIDE CIRCUIT BREAKER WITH LOCKING PROVISIONS / 'R' – PROVIDE CIRCUIT BREAKER WITH RED MARKING

Notes:

Branch Panel: K

Location: SEE PLANS
Supply From: MDP
Mounting: SURFACE
Enclosure: NEMA 1

Volts: 120/208 Wye
Phases: 3
Wires: 4

A.I.C. Rating: 65,000
Mains Type: MLO
Bus Rating: 400 A

CKT	Circuit Description	OPT	Load Class	Trip	Poles	A		B		C		Poles	Trip	Load Class	OPT	Circuit Description	CKT
1	WASHER/DRYER	GFCI	A	20 A	1	1320	0					1	20 A	--		SPARE	2
3	SPARE		--	20 A	1			0	0			1	20 A	--		SPARE	4
5	SPARE		--	20 A	1					0	0	1	20 A	--		SPARE	6
7	SPARE		--	20 A	1	0	--					1	--	--		SPACE	8
9	SPARE		--	20 A	1			0	--			1	--	--		SPACE	10
11	SPARE		--	20 A	1					0	--	1	--	--		SPACE	12
13	SPARE		--	20 A	1	0	--					1	--	--		SPACE	14
15	SPACE		--	--	1			--	--			1	--	--		SPACE	16
17	SPACE		--	--	1					--	--	1	--	--		SPACE	18
19	SPACE		--	--	1	--	--					1	--	--		SPACE	20
21	SPACE		--	--	1			--	--			1	--	--		SPACE	22
23	SPACE		--	--	1					--	--	1	--	--		SPACE	24
25	SPACE		--	--	1	--	--					1	--	--		SPACE	26
27	SPACE		--	--	1			--	--			1	--	--		SPACE	28
29	SPACE		--	--	1					--	--	1	--	--		SPACE	30
31	SPACE		--	--	1	--	--					1	--	--		SPACE	32
33	SPACE		--	--	1			--	--			1	--	--		SPACE	34
35	SPACE		--	--	1					--	--	1	--	--		SPACE	36
37	SPACE		--	--	1	--	--					1	--	--		SPACE	38
39	SPACE		--	--	1			--	--			1	--	--		SPACE	40
41	SPACE		--	--	1					--	--	1	--	--		SPACE	42
43	SPACE		--	--	1	--	--					1	--	--		SPACE	44
45	SPACE		--	--	1			--	--			1	--	--		SPACE	46
47	SPACE		--	--	1					--	--	1	--	--		SPACE	48
49	SPACE		--	--	1	--	--					1	--	--		SPACE	50
51	SPACE		--	--	1			--	--			1	--	--		SPACE	52
53	SPACE		--	--	1					--	--	1	--	--		SPACE	54
55	SPACE		--	--	1	--	--					1	--	--		SPACE	56
57	SPACE		--	--	1			--	--			1	--	--		SPACE	58
59	SPACE		--	--	1					--	--	1	--	--		SPACE	60
						Total Load:		1320 VA		0 VA		0 VA					
						Total Amps:		11 A		0 A		0 A					
						Phase Balance		0 % A-B		% B-C		0 % C-A					

Load Classification		Connected Load	Demand Factor	Estimated Demand	Panel Totals	
L	Lighting					
C	Continuous				**Total Conn. Load:**	1320 VA
R	Receptacle				**Total Est. Demand:**	1320 VA
M	Motor				**Total Conn.:**	4 A
LM	Largest Motor				**Total Est. Demand:**	4 A
E	Equipment				**Spare Capacity:**	396 A
A	Appliance	1320 VA	100.00%	1320 VA		

OPTIONS:
'ST' – PROVIDE SHUNT TRIP BREAKER / 'GFCI' – PROVIDE CIRCUIT BREAKER / 'GFP' – PROVIDE GFP CIRCUIT BREAKER / 'ERMS' - ENERGY REDUCING MAINTENANCE SWITCH / 'ZSI' - ZONE SELECTIVE INTERLOCKING / 'L' - PROVIDE CIRCUIT BREAKER WITH LOCKING PROVISIONS / 'R' – PROVIDE CIRCUIT BREAKER WITH RED MARKING

Notes:

ESTIMATED FUTURE LOAD: 90KVA
250A

Autodesk Docs://2024-020 City Hotel/(2024) City Hotel - Elec.rvt
5/20/2026 9:03:20 AM

Ramirez, Johnson, & Associates
3321 Lawrence St. Ste 2
Denver, CO 80205
P: 720.598.0774
HELTSHE

M1A MERIDIAN 105 ARCHITECTURE

CITY HOTEL
415 PERRY STREET, CASTLE ROCK, CO.

DATE: 05.20.2026
PROJ. NO. 2023.002

ISSUED FOR:
1st PERMIT COMMENTS

SHEET TITLE:
ELECTRICAL PANEL SCHEDULES

COLORADO LICENSED
SAMUEL A MILLER
43565
05/27/2026
PROFESSIONAL ENGINEER

SHEET NUMBER
E0.02

Branch Panel: M12

Location: SEE PLANS
Supply From: MDP
Mounting: SURFACE
Enclosure: NEMA 1

Volts: 120/208 Wye
Phases: 3
Wires: 4

A.I.C. Rating: 65,000
Mains Type: MLO
Bus Rating: 600 A

CKT	Circuit Description	OPT	Load Class	Trip	Poles	A	B	C	Poles	Trip	Load Class	OPT	Circuit Description	CKT
1	PUH-1-1		E	30 A	2	2600	1508		2	20 A	E		EUH-1-1	2
3							2600	1508						4
5	PUH-1-2		E	30 A	2			2600	2	20 A	E		EUH-1-2	6
7						2600	1508							8
9	PUH-1-3		E	30 A	2		2600	1508	2	20 A	E		EUH-1-3	10
11								2600	1508					12
13	ECH-1-1		E	20 A	1	1500	1508		2	20 A	E		EUH-1-4	14
15	EWH-1-1		E	20 A	1		1800	1508						16
17	EWH-1-2		E	20 A	1			1800	1508	2	20 A	E	EUH-1-5	18
19	EWH-1-3		E	20 A	1	1800	1508							20
21	EWH-1-4		E	20 A	1			1800	500	1	20 A	M	MOTORIZED&FIRE/SMK DMPRS	22
23	EWH-1-5		E	20 A	1				1800	180	1	20 A	R; E	SMOKE CURTAINS-NORTH	24
25	EF-1-1		M	20 A	1	24	180				1	20 A	R; E	SMOKE CURTAINS-SOUTH	26
27	EF-1-2 & EF-1-3		M	20 A	1			58	1800		1	20 A	E	EWH-2-1	28
29	EF-2-1		M	20 A	1					21	468	2	15 A	E	FCU-1-1	30
31	EFH-1-1		E	20 A	2	625	468									32
33								625	132			2	15 A	E	FCU-1-2	34
35	EFH-1-2		E	20 A	2					625	132					36
37						625	132					2	15 A	E	FCU-1-3	38
39	EFH-1-3		E	20 A	2			500	132							40
41										500	0	1	20 A	--	SPARE	42
43	EFH-1-4		E	20 A	2	375	0					1	20 A	--	SPARE	44
45								375	1564			1	20 A	E	SB-2	46
47	EWH-1-6		E	30 A	1					1800	118	1	15 A	E	FCU-2-1	48
49	FCU-1-5		E	15 A	2	66	118					1	15 A	E	FCU-2-2	50
51								66	799			1	15 A	M	HWP-1/2	52
53										792	1034	1	15 A	M	CWP-1/2	54
55	GEF-1		M	20 A	3	792	1564					1	15 A	E	SB-1	56
57								792	24			1	15 A	E	HWCP-1 & HWCP-2	58
59										10200	1564	1	15 A	E	B-1	60
61	C-1		E	110 A	3	10200	1564					1	15 A	E	B-2	62
63								10200	3854			2	40 A	M	DBP-1	64
65										10200	3854					66
67	C-2		E	110 A	3	10200	575					1	15 A	E	GWH-1	68
69								10200	575			1	15 A	E	GWH-2	70
71	REC-MECH RM 219 MAINT. REC		R	20 A	1					180	575	1	15 A	E	GWH-3	72
73	EWH-1-7		E	20 A	1	1800	1585									74
75								1585	1585			3	20 A	M	CWP-3/4	76
77	HWP-3/4		M	20 A	3					1585	1585					78
79						1585	132					2	15 A	E	FCU-1-4	80
81	CH-1A		E	20 A	2			302	132							82
83										302	1800	1	20 A	E	EWH-2-2	84
85	CH-1B		E	20 A	2	302	1034					1	20 A	M	SMP-1/2	86
87								302	2065							88
89	SPACE		--	--	1					--	2065	3	20 A	M	SMP-3/4	90
91	SPACE		--	--	1	--	2065									92
93	SPACE		--	--	1			--	--			1	--	--	SPACE	94
95	SPACE		--	--	1					--	--	1	--	--	SPACE	96
97	SPACE		--	--	1	--	--					1	--	--	SPACE	98
99	SPACE		--	--	1			--	--			1	--	--	SPACE	100
101	SPACE		--	--	1					--	--	1	--	--	SPACE	102
103	SPACE		--	--	1	--	--					1	--	--	SPACE	104
105	SPACE		--	--	1			--	--			1	--	--	SPACE	106
107	SPACE		--	--	1					--	--	1	--	--	SPACE	108
109	SPACE		--	--	1	--	--					1	--	--	SPACE	110
111	SPACE		--	--	1			--	--			1	--	--	SPACE	112
113	SPACE		--	--	1					--	--	1	--	--	SPACE	114
115	SPACE		--	--	1	--	--					1	--	--	SPACE	116
117	SPACE		--	--	1			--	--			1	--	--	SPACE	118
119	SPACE		--	--	1					--	--	1	--	--	SPACE	120
121	SPACE		--	--	1	--	--					1	--	--	SPACE	122
123	SPACE		--	--	1			--	--			1	--	--	SPACE	124
125	SPACE		--	--	1					--	--	1	--	--	SPACE	126
						Total Load:		50542 VA		51489 VA			52903 VA			
						Total Amps:		421 A		430 A			442 A			
						Phase Balance		98 % A-B		97 % B-C			96 % C-A			

Load Classification		Connected Load	Demand Factor	Estimated Demand	Panel Totals	
L	Lighting					
C	Continuous				**Total Conn. Load:**	154934 VA
R	Receptacle	540 VA	100.00%	540 VA	**Total Est. Demand:**	154934 VA
M	Motor	29256 VA	100.00%	29256 VA	**Total Conn.:**	430 A
LM	Largest Motor				**Total Est. Demand:**	430 A
E	Equipment	125138 VA	100.00%	125138 VA	**Spare Capacity:**	170 A
A	Appliance					

OPTIONS:
'ST' – PROVIDE SHUNT TRIP BREAKER / 'GFCI' – PROVIDE CIRCUIT BREAKER / 'GFP' – PROVIDE GFP CIRCUIT BREAKER / 'ERMS' - ENERGY REDUCING MAINTENANCE SWITCH / 'ZSI' - ZONE SELECTIVE INTERLOCKING / 'L' - PROVIDE CIRCUIT BREAKER WITH LOCKING PROVISIONS / 'R' – PROVIDE CIRCUIT BREAKER WITH RED MARKING

Notes:

Branch Panel: R1

Location: SEE PLANS
Supply From: MDP
Mounting: SURFACE
Enclosure: NEMA 1

Volts: 120/208 Wye
Phases: 3
Wires: 4

A.I.C. Rating: 22,000
Mains Type: MCB
Bus Rating: 200 A
MCB Rating: 200 A

CKT	Circuit Description	OPT	Load Class	Trip	Poles	A	B	C	Poles	Trip	Load Class	OPT	Circuit Description	CKT
1	RETAIL RECEPTS		R	20 A	1	540	252		1	20 A	L		RETAIL LTG	2
3	SPARE		--	20 A	1			0 0	1	20 A	--		SPARE	4
5	SPARE		--	20 A	1			0 0	1	20 A	--		SPARE	6
7	SPARE		--	20 A	1	0 0			1	20 A	--		SPARE	8
9	SPARE		--	20 A	1		0 0		1	20 A	--		SPARE	10
11	SPARE		--	20 A	1			0 0	1	20 A	--		SPARE	12
13	SPARE		--	20 A	1	0 0			1	20 A	--		SPARE	14
15	SPARE		--	20 A	1		0 0		1	20 A	--		SPARE	16
17	SPARE		--	20 A	1			0 0	1	20 A	--		SPARE	18
19	SPARE		--	20 A	1	0 0			1	20 A	--		SPARE	20
21	SPARE		--	20 A	1		0 0		1	20 A	--		SPARE	22
23	SPARE		--	20 A	1			0 0	1	20 A	--		SPARE	24
25	SPARE		--	20 A	1	0 0			1	20 A	--		SPARE	26
27	SPARE		--	20 A	1		0 0		1	20 A	--		SPARE	28
29	SPARE		--	20 A	1			0 0	1	20 A	--		SPARE	30
31	SPARE		--	20 A	1	0 0			1	20 A	--		SPARE	32
33	SPARE		--	20 A	1		0 0		1	20 A	--		SPARE	34
35	SPACE		--	--	1			-- --	1	--	--		SPACE	36
37	SPACE		--	--	1	-- --			1	--	--		SPACE	38
39	SPACE		--	--	1		-- --		1	--	--		SPACE	40
41	SPACE		--	--	1			-- --	1	--	--		SPACE	42
						Total Load:	792 VA	0 VA	0 VA					
						Total Amps:	7 A	0 A	0 A					
						Phase Balance	0 % A-B	% B-C	0 % C-A					

Load Classification		Connected Load	Demand Factor	Estimated Demand	Panel Totals	
L	Lighting	252 VA	125.00%	315 VA		
C	Continuous				**Total Conn. Load:**	792 VA
R	Receptacle	540 VA	100.00%	540 VA	**Total Est. Demand:**	855 VA
M	Motor				**Total Conn.:**	2 A
LM	Largest Motor				**Total Est. Demand:**	2 A
E	Equipment				**Spare Capacity:**	198 A
A	Appliance					

OPTIONS:
'ST' – PROVIDE SHUNT TRIP BREAKER / 'GFCI' – PROVIDE CIRCUIT BREAKER / 'GFP' – PROVIDE GFP CIRCUIT BREAKER / 'ERMS' - ENERGY REDUCING MAINTENANCE SWITCH / 'ZSI' - ZONE SELECTIVE INTERLOCKING / 'L' - PROVIDE CIRCUIT BREAKER WITH LOCKING PROVISIONS / 'R' – PROVIDE CIRCUIT BREAKER WITH RED MARKING

Notes:

ESTIMATED FUTURE LOAD: 45KVA
125A

Branch Panel: SB

Location: SEE PLANS
Supply From: MDP
Mounting: SURFACE
Enclosure: NEMA 1

Volts: 120/208 Wye
Phases: 3
Wires: 4

A.I.C. Rating: 35,000
Mains Type: MLO
Bus Rating: 125 A

CKT	Circuit Description	OPT	Load Class	Trip	Poles	A	B	C	Poles	Trip	Load Class	OPT	Circuit Description	CKT
1	SPARE		--	20 A	1	0 0			1	20 A	--		SPARE	2
3	SPARE		--	20 A	1		0 0		1	20 A	--		SPARE	4
5	SPARE		--	20 A	1			0 0	1	20 A	--		SPARE	6
7	SPARE		--	20 A	1	0 0			1	20 A	--		SPARE	8
9	SPACE		--	--	1		-- --		1	--	--		SPACE	10
11	SPACE		--	--	1			-- --	1	--	--		SPACE	12
13	SPACE		--	--	1	-- --			1	--	--		SPACE	14
15	SPACE		--	--	1		-- --		1	--	--		SPACE	16
17	SPACE		--	--	1			-- --	1	--	--		SPACE	18
19	SPACE		--	--	1	-- --			1	--	--		SPACE	20
21	SPACE		--	--	1		-- --		1	--	--		SPACE	22
23	SPACE		--	--	1			-- --	1	--	--		SPACE	24
25	SPACE		--	--	1	-- --			1	--	--		SPACE	26
27	SPACE		--	--	1		-- --		1	--	--		SPACE	28
29	SPACE		--	--	1			-- --	1	--	--		SPACE	30
31	SPACE		--	--	1	-- --			1	--	--		SPACE	32
33	SPACE		--	--	1		-- --		1	--	--		SPACE	34
35	SPACE		--	--	1			-- --	1	--	--		SPACE	36
37	SPACE		--	--	1	-- --			1	--	--		SPACE	38
39	SPACE		--	--	1		-- --		1	--	--		SPACE	40
41	SPACE		--	--	1			-- --	1	--	--		SPACE	42
						Total Load:	0 VA	0 VA	0 VA					
						Total Amps:	0 A	0 A	0 A					
						Phase Balance	% A-B	% B-C	% C-A					

Load Classification		Connected Load	Demand Factor	Estimated Demand	Panel Totals	
L	Lighting					
C	Continuous				**Total Conn. Load:**	0 VA
R	Receptacle				**Total Est. Demand:**	0 VA
M	Motor				**Total Conn.:**	0 A
LM	Largest Motor				**Total Est. Demand:**	0 A
E	Equipment				**Spare Capacity:**	125 A
A	Appliance					

OPTIONS:
'ST' – PROVIDE SHUNT TRIP BREAKER / 'GFCI' – PROVIDE CIRCUIT BREAKER / 'GFP' – PROVIDE GFP CIRCUIT BREAKER / 'ERMS' - ENERGY REDUCING MAINTENANCE SWITCH / 'ZSI' - ZONE SELECTIVE INTERLOCKING / 'L' - PROVIDE CIRCUIT BREAKER WITH LOCKING PROVISIONS / 'R' – PROVIDE CIRCUIT BREAKER WITH RED MARKING

Notes:

ESTIMATED FUTURE LOAD: 13.5KVA
37.5A
TO BE USED FOR REFRIGERATORS AND WALK-IN COOLERS AND FREEZERS

Autodesk Docs://2024-020 City Hotel/(2024) City Hotel - Elec.rvt
5/20/2026 9:03:22 AM

Ramirez, Johnson, & Associates
5301 Lawrence St. Ste 2
Denver, CO 80216
P: 720.549.9714
HELTSHE
M1A MERIDIAN 105 ARCHITECTURE

CITY HOTEL
415 PERRY STREET, CASTLE ROCK, CO.

DATE: 05.20.2026
PROJ. NO. 2023.002
ISSUED FOR: 1st PERMIT COMMENTS
SHEET TITLE: ELECTRICAL PANEL SCHEDULES

COLORADO LICENSED
DAMIAN RAMIREZ
43565
05/27/2026
PROFESSIONAL ENGINEER

SHEET NUMBER
E0.03

Branch Panel: L2A

Location: SEE PLANS
Supply From: MDP
Mounting: SURFACE
Enclosure: NEMA 1

Volts: 120/208 Wye
Phases: 3
Wires: 4

A.I.C. Rating: 42,000
Mains Type: MLO
Bus Rating: 400 A

CKT	Circuit Description	OPT	Load Class	Trip	Poles	A		B		C		Poles	Trip	Load Class	OPT	Circuit Description	CKT
1	REC - 2ND FLOOR CLEANING		R	20 A	1	180	229					1	20 A	R; L	DF	UNIT 212 BATHROOM	2
3	REC - 2ND FLOOR CORR (N)		R	20 A	1			720	1200			1	20 A	A	AFCI	UNIT 212 MICROWAVE	4
5	SPARE		--	20 A	1					0	1710	1	20 A	R; L	AFCI	UNIT 212 GEN REC & LTG	6
7	LTG - 2ND FLOOR CORR (N)		L	20 A	1	399	2500					2	35 A	M		UNIT 212 VTAC-1	8
9	UNIT 201 GEN REC & LTG	AFCI	R; L	20 A	1			1710	2500								10
11	UNIT 201 MICROWAVE	AFCI	A	20 A	1					1200	0	1	20 A	--		SPARE	12
13	UNIT 201 BATHROOM	DF	R; L	20 A	1	229	1200					1	20 A	A	AFCI	UNIT 213 MICROWAVE	14
15	UNIT 201 CH-1	GFCI	E	20 A	2			300	439			1	20 A	R; L	DF	UNIT 213 BATHROOM	16
17										300	1710	1	20 A	R; L	AFCI	UNIT 213 GEN REC & LTG	18
19	UNIT 201 VTAC-1		M	35 A	2	2500	2500					2	35 A	M		UNIT 213 VTAC-1	20
21								2500	2500								22
23	UNIT 202 GEN REC & LTG	AFCI	R; L	20 A	1					1710	300	2	20 A	E	GFCI	UNIT 213 CH-1	24
25	UNIT 202 MICROWAVE	AFCI	A	20 A	1	1200	300										26
27	UNIT 202 BATHROOM	DF	R; L	20 A	1			229	1710			1	20 A	R; L	AFCI	UNIT 214 GEN REC & LTG	28
29	UNIT 202 VTAC-1		M	35 A	2					2500	1200	1	20 A	A	AFCI	UNIT 214 MICROWAVE	30
31						2500	439					1	20 A	R; L	DF	UNIT 214 BATHROOM	32
33	SPARE		--	20 A	1			0	2500			2	35 A	M		UNIT 214 VTAC-1	34
35	UNIT 203 MICROWAVE	AFCI	A	20 A	1					1200	2500						36
37	UNIT 203 GEN REC & LTG	AFCI	R; L	20 A	1	1710	300					2	20 A	E	GFCI	UNIT 214 CH-1	38
39	UNIT 203 BATHROOM	DF	R; L	20 A	1			229	300								40
41	UNIT 203 VTAC-1		M	35 A	2					2500	0	1	20 A	--		SPARE	42
43						2500	0					1	20 A	--		SPARE	44
45	SPARE		--	20 A	1			0	0			1	20 A	--		SPARE	46
47	UNIT 204 MICROWAVE	AFCI	A	20 A	1					1200	0	1	20 A	--		SPARE	48
49	UNIT 204 BATHROOM	DF	R; L	20 A	1	229	0					1	20 A	--		SPARE	50
51	UNIT 204 GEN REC & LTG	AFCI	R; L	20 A	1			1710	0			1	20 A	--		SPARE	52
53	UNIT 204 VTAC-1		M	35 A	2					2500	--	1	--	--		SPACE	54
55						2500	20687					3	200 A	Spare; R; E; L; M;...		L2B	56
57	SPARE		--	20 A	1			0	22304								58
59	SPARE		--	20 A	1					0	20549						60
						Total Load:		42102 VA		40851 VA							
						Total Amps:		351 A		340 A							
						Phase Balance		97 % A-B		99 % B-C							

Load Classification		Connected Load	Demand Factor	Estimated Demand	Panel Totals	
L	Lighting	2852 VA	125.00%	3565 VA		
C	Continuous				**Total Conn. Load:**	124032 VA
R	Receptacle	30780 VA	66.24%	20390 VA	**Total Est. Demand:**	108475 VA
M	Motor	70000 VA	100.00%	70000 VA	**Total Conn.:**	344 A
LM	Largest Motor				**Total Est. Demand:**	301 A
E	Equipment	3600 VA	100.00%	3600 VA	**Spare Capacity:**	99 A
A	Appliance	16800 VA	65.00%	10920 VA		

OPTIONS:
'ST' – PROVIDE SHUNT TRIP BREAKER / 'GFCI' – PROVIDE CIRCUIT BREAKER / 'GFP' – PROVIDE GFP CIRCUIT BREAKER / 'ERMS' - ENERGY REDUCING MAINTENANCE SWITCH / 'ZSI' - ZONE SELECTIVE INTERLOCKING / 'L' - PROVIDE CIRCUIT BREAKER WITH LOCKING PROVISIONS / 'R' – PROVIDE CIRCUIT BREAKER WITH RED MARKING

Notes:

Branch Panel: L2B

Location: SEE PLANS
Supply From: L2A
Mounting: SURFACE
Enclosure: NEMA 1

Volts: 120/208 Wye
Phases: 3
Wires: 4

A.I.C. Rating: 22,000
Mains Type: MLO
Bus Rating: 200 A

CKT	Circuit Description	OPT	Load Class	Trip	Poles	A		B		C		Poles	Trip	Load Class	OPT	Circuit Description	CKT
1	REC - 2ND FLOOR CORR. (S)		R	20 A	1	720	1710					1	20 A	R; L	AFCI	UNIT 209 GEN REC & LTG	2
3	2ND FLOOR CORR LTG (S)		L	20 A	1			327	229			1	20 A	R; L	AFCI	UNIT 209 BATHROOM	4
5	SPARE		--	20 A	1					0	1200	1	20 A	A	DF	UNIT 209 MICROWAVE	6
7	UNIT 205 GEN REC & LTG	AFCI	R; L	20 A	1	1710	2500					2	20 A	M		UNIT 209 VTAC-1	8
9	UNIT 205 BATHROOM	DF	R; L	20 A	1			439	2500								10
11	UNIT 205 MICROWAVE	AFCI	A	20 A	1					1200	300	2	20 A	E	GFCI	UNIT 209 CH-1	12
13	UNIT 205 VTAC-1		M	20 A	2	2500	300										14
15								2500	1710			1	20 A	R; L	AFCI	UNIT 210 GEN REC & LTG	16
17	UNIT 206 GEN REC & LTG	AFCI	R; L	20 A	1					1710	1200	1	20 A	A	AFCI	UNIT 210 MICROWAVE	18
19	SPARE		--	20 A	1	0	439					1	20 A	R; L	DF	UNIT 210 BATHROOM	20
21	UNIT 206 MICROWAVE	AFCI	A	20 A	1			1200	300			2	20 A	E	GFCI	UNIT 210 CH-1	22
23	UNIT 206 BATHROOM	DF	R; L	20 A	1					229	300						24
25	UNIT 205 LIVING ROOM	AFCI	R	20 A	1	1440	2500					2	20 A	M		UNIT 210 VTAC-1	26
27	UNIT 206 VTAC-1		M	20 A	2			2500	2500								28
29										2500	1710	1	20 A	R; L	AFCI	UNIT 211 GEN REC & LTG	30
31	SPARE		--	20 A	1	0	1200					1	20 A	A	AFCI	UNIT 211 MICROWAVE	32
33	UNIT 207 GEN REC & LTG	AFCI	R; L	20 A	1			1710	439			1	20 A	R; L	DF	UNIT 211 BATHROOM	34
35	UNIT 207 MICROWAVE	AFCI	A	20 A	1					1200	2500	2	20 A	M		UNIT 211 VTAC-1	36
37	UNIT 207 BATHROOM	DF	R; L	20 A	1	229	2500										38
39	UNIT 207 VTAC-1		M	20 A	2			2500	300			2	20 A	E	GFCI	UNIT 211 CH-1	40
41										2500	300						42
43	SPARE		--	20 A	1	0	0					1	20 A	--		SPARE	44
45	UNIT 208 GEN REC & LTG	AFCI	R; L	20 A	1			1710	0			1	20 A	--		SPARE	46
47	UNIT 208 MICROWAVE	AFCI	A	20 A	1					1200	0	1	20 A	--		SPARE	48
49	UNIT 208 BATHROOM	DF	R; L	20 A	1	439	0					1	20 A	--		SPARE	50
51	UNIT 208 LIVING ROOM	AFCI	R	20 A	1			1440	0			1	20 A	--		SPARE	52
53	UNIT 208 VTAC-1		M	20 A	2					2500	0	1	20 A	--		SPARE	54
55						2500	0					1	20 A	--		SPARE	56
57	SPARE		--	20 A	1			0	0			1	20 A	--		SPARE	58
59	SPARE		--	20 A	1					0	0	1	20 A	--		SPARE	60
						Total Load:		20687 VA		22304 VA		20549 VA					
						Total Amps:		173 A		186 A		171 A					
						Phase Balance		93 % A-B		92 % B-C		99 % C-A					

Load Classification		Connected Load	Demand Factor	Estimated Demand	Panel Totals	
L	Lighting	1420 VA	125.00%	1775 VA		
C	Continuous				**Total Conn. Load:**	63540 VA
R	Receptacle	16920 VA	79.55%	13460 VA	**Total Est. Demand:**	57495 VA
M	Motor	35000 VA	100.00%	35000 VA	**Total Conn.:**	176 A
LM	Largest Motor				**Total Est. Demand:**	160 A
E	Equipment	1800 VA	100.00%	1800 VA	**Spare Capacity:**	40 A
A	Appliance	8400 VA	65.00%	5460 VA		

OPTIONS:
'ST' – PROVIDE SHUNT TRIP BREAKER / 'GFCI' – PROVIDE CIRCUIT BREAKER / 'GFP' – PROVIDE GFP CIRCUIT BREAKER / 'ERMS' - ENERGY REDUCING MAINTENANCE SWITCH / 'ZSI' - ZONE SELECTIVE INTERLOCKING / 'L' - PROVIDE CIRCUIT BREAKER WITH LOCKING PROVISIONS / 'R' – PROVIDE CIRCUIT BREAKER WITH RED MARKING

Notes:

Autodesk Docs://2024-020 City Hotel/(2024) City Hotel - Elec.rvt
5/20/2026 9:03:23 AM

Ramirez, Johnson, & Associates
3301 Lawrence St. Ste 2
Denver, CO 80205
P: 720.598.0774
HELTSHE
M1A | MERIDIAN 105 ARCHITECTURE

CITY HOTEL
415 PERRY STREET, CASTLE ROCK, CO.

DATE: 05.20.2026
PROJ. NO. 2023.002
ISSUED FOR: 1st PERMIT COMMENTS
SHEET TITLE: ELECTRICAL PANEL SCHEDULES

COLORADO LICENSED
DAMIAN A MIRES
43565
05/27/2026
PROFESSIONAL ENGINEER

SHEET NUMBER
E0.04

Branch Panel: L3A

Location: SEE PLANS
Supply From: MDP
Mounting: SURFACE
Enclosure: NEMA 1

Volts: 120/208 Wye
Phases: 3
Wires: 4

A.I.C. Rating: 42,000
Mains Type: MLO
Bus Rating: 400 A

CKT	Circuit Description	OPT	Load Class	Trip	Poles	A		B		C		Poles	Trip	Load Class	OPT	Circuit Description	CKT
1	REC - 3RD FLOOR CLEANING		R	20 A	1	180	1710					1	20 A	R; L	AFCI	UNIT 312 GEN REC & LTG	2
3	REC - 3RD FLOOR CORR. (N)		R	20 A	1			720	229			1	20 A	R; L	DF	UNIT 312 BATHROOM	4
5	SPARE		--	20 A	1					0	1200	1	20 A	A	AFCI	UNIT 312 MICROWAVE	6
7	3RD FLOOR CORR LTG (N)		L	20 A	1	364	2500					2	35 A	M		UNIT 312 VTAC-1	8
9	UNIT 301 GEN REC & LTG	AFCI	R; L	20 A	1			1710	2500								10
11	UNIT 301 MICROWAVE	AFCI	A	20 A	1					1200	0	1	20 A	--		SPARE	12
13	UNIT 301 BATHROOM	DF	R; L	20 A	1	229	439					1	20 A	R; L	DF	UNIT 313 BATHROOM	14
15	UNIT 301 VTAC-1		M	35 A	2			2500	1200			1	20 A	A	AFCI	UNIT 313 MICROWAVE	16
17										2500	1710	1	20 A	R; L	AFCI	UNIT 313 GEN REC & LTG	18
19	UNIT 301 CH-1	DF	E	20 A	2	300	2500					2	35 A	M		UNIT 313 VTAC-1	20
21								300	2500								22
23	UNIT 302 MICROWAVE	AFCI	A	20 A	1					1200	300	2	20 A	E	DF	UNIT 313 CH-1	24
25	UNIT 302 BATHROOM	DF	R; L	20 A	1	229	300										26
27	UNIT 302 GEN REC & LTG	AFCI	R; L	20 A	1			1710	1710			1	20 A	R; L	AFCI	UNIT 314 GEN REC & LTG	28
29	UNIT 302 VTAC-1		M	35 A	2					2500	1200	1	20 A	A	AFCI	UNIT 314 MICROWAVE	30
31						2500	439					1	20 A	R; L	DF	UNIT 314 BATHROOM	32
33	SPARE		--	20 A	1			0	2500			2	35 A	M		UNIT 314 VTAC-1	34
35	UNIT 303 GEN REC & LTG	AFCI	R; L	20 A	1					1710	2500						36
37	UNIT 303 MICROWAVE	AFCI	A	20 A	1	1200	300					2	20 A	E	DF	UNIT 314 CH-1	38
39	UNIT 303 BATHROOM	DF	R; L	20 A	1			229	300								40
41	UNIT 303 VTAC-1		M	35 A	2					2500	0	1	20 A	--		SPARE	42
43						2500	0					1	20 A	--		SPARE	44
45	SPARE		--	20 A	1			0	0			1	20 A	--		SPARE	46
47	UNIT 304 BATHROOM	DF	R; L	20 A	1					229	0	1	20 A	--		SPARE	48
49	UNIT 304 MICROWAVE	AFCI	A	20 A	1	1200	0					1	20 A	--		SPARE	50
51	UNIT 304 GEN REC & LTG	AFCI	R; L	20 A	1			1710	0			1	20 A	--		SPARE	52
53	UNIT 304 VTAC-1		M	35 A	2					2500	0	1	20 A	--		SPARE	54
55						2500	21766							Spare; R; E; L; M;...		L3B	56
57	SPARE		--	20 A	1			0	21284			3	200 A				58
59	SPARE		--	20 A	1					0	20490						60
						Total Load:		41156 VA		41102 VA		41739 VA					
						Total Amps:		343 A		343 A		348 A					
						Phase Balance		100 % A-B		98 % B-C		99 % C-A					

	Load Classification	Connected Load	Demand Factor	Estimated Demand	Panel Totals	
L	Lighting	2816 VA	125.00%	3521 VA		
C	Continuous				**Total Conn. Load:**	123996 VA
R	Receptacle	30780 VA	66.24%	20390 VA	**Total Est. Demand:**	108431 VA
M	Motor	70000 VA	100.00%	70000 VA	**Total Conn.:**	344 A
LM	Largest Motor				**Total Est. Demand:**	301 A
E	Equipment	3600 VA	100.00%	3600 VA	**Spare Capacity:**	99 A
A	Appliance	16800 VA	65.00%	10920 VA		

OPTIONS:
'ST' – PROVIDE SHUNT TRIP BREAKER / 'GFCI' – PROVIDE CIRCUIT BREAKER / 'GFP' – PROVIDE GFP CIRCUIT BREAKER / 'ERMS' - ENERGY REDUCING MAINTENANCE SWITCH / 'ZSI' - ZONE SELECTIVE INTERLOCKING / 'L' - PROVIDE CIRCUIT BREAKER WITH LOCKING PROVISIONS / 'R' – PROVIDE CIRCUIT BREAKER WITH RED MARKING

Notes:

Branch Panel: L3B

Location: SEE PLANS
Supply From: L3A
Mounting: SURFACE
Enclosure: NEMA 1

Volts: 120/208 Wye
Phases: 3
Wires: 4

A.I.C. Rating: 22,000
Mains Type: MLO
Bus Rating: 200 A

CKT	Circuit Description	OPT	Load Class	Trip	Poles	A		B		C		Poles	Trip	Load Class	OPT	Circuit Description	CKT
1	REC - 3RD FLOOR CORR. (S)		R	20 A	1	720	229					1	20 A	R; L	DF	UNIT 309 BATHROOM	2
3	3RD FLOOR CORR LTG (S)		L	20 A	1			327	1200			1	20 A	A	AFCI	UNIT 309 MICROWAVE	4
5	UNIT 305 GEN REC & LTG	AFCI	R; L	20 A	1					1710	1710	1	20 A	R; L	AFCI	UNIT 309 GEN REC & LTG	6
7	UNIT 305 MICROWAVE	AFCI	A	20 A	1	1200	2500					2	35 A	M		UNIT 309 VTAC-1	8
9	UNIT 305 BATHROOM	DF	R; L	20 A	1			439	2500								10
11	UNIT 305 VTAC-1		M	35 A	2					2500	300						12
13						2500	300					2	20 A	E	DF	UNIT 309 CH-1	14
15	UNIT 305 LIVING ROOM	AFCI	R	20 A	1			1440	1710			1	20 A	R; L	AFCI	UNIT 310 GEN REC & LTG	16
17	SPARE		--	20 A	1					0	1200	1	20 A	A	AFCI	UNIT 310 MICROWAVE	18
19	UNIT 306 GEN REC & LTG	AFCI	R; L	20 A	1	1710	439					1	20 A	R; L	DF	UNIT 310 BATHROOM	20
21	UNIT 306 BATHROOM	DF	R; L	20 A	1			229	2500			2	35 A	M		UNIT 310 VTAC-1	22
23	UNIT 306 MICROWAVE	AFCI	A	20 A	1					1200	2500						24
25	UNIT 306 VTAC-1		M	35 A	2	2500	300					2	20 A	E	DF	UNIT 310 CH-1	26
27								2500	300								28
29	SPARE		--	20 A	1					0	1710	1	20 A	R; L	AFCI	UNIT 311 GEN REC & LTG	30
31	UNIT 307 BATHROOM	DF	R; L	20 A	1	229	1200					1	20 A	A	AFCI	UNIT 311 MICROWAVE	32
33	UNIT 307 MICROWAVE	AFCI	A	20 A	1			1200	439			1	20 A	R; L	DF	UNIT 311 BATHROOM	34
35	UNIT 307 GEN REC & LTG	AFCI	R; L	20 A	1					1710	2500	2	35 A	M		UNIT 311 VTAC-1	36
37	UNIT 307 VTAC-1		M	35 A	2	2500	2500										38
39								2500	300			2	20 A	E	DF	UNIT 311 CH-1	40
41	SPARE		--	20 A	1					0	300						42
43	UNIT 308 BATHROOM	DF	R; L	20 A	1	439	0					1	20 A	--		SPARE	44
45	UNIT 308 MICROWAVE	AFCI	A	20 A	1			1200	0			1	20 A	--		SPARE	46
47	UNIT 308 GEN REC & LTG	AFCI	R; L	20 A	1					1710	0	1	20 A	--		SPARE	48
49	UNIT 308 VTAC-1		M	35 A	2	2500	0					1	20 A	--		SPARE	50
51								2500	0			1	20 A	--		SPARE	52
53	UNIT 308 LIVING ROOM	AFCI	R	20 A	1					1440	0	1	20 A	--		SPARE	54
55	SPARE		--	20 A	1	0	0					1	20 A	--		SPARE	56
57	SPACE		--	--	1			--	--			1	--	--		SPACE	58
59	SPACE		--	--	1					--	--	1	--	--		SPACE	60
						Total Load:		21766 VA		21284 VA		20490 VA					
						Total Amps:		182 A		178 A		171 A					
						Phase Balance		98 % A-B		96 % B-C		94 % C-A					

	Load Classification	Connected Load	Demand Factor	Estimated Demand	Panel Totals	
L	Lighting	1420 VA	125.00%	1775 VA		
C	Continuous				**Total Conn. Load:**	63540 VA
R	Receptacle	16920 VA	79.55%	13460 VA	**Total Est. Demand:**	57495 VA
M	Motor	35000 VA	100.00%	35000 VA	**Total Conn.:**	176 A
LM	Largest Motor				**Total Est. Demand:**	160 A
E	Equipment	1800 VA	100.00%	1800 VA	**Spare Capacity:**	40 A
A	Appliance	8400 VA	65.00%	5460 VA		

OPTIONS:
'ST' – PROVIDE SHUNT TRIP BREAKER / 'GFCI' – PROVIDE CIRCUIT BREAKER / 'GFP' – PROVIDE GFP CIRCUIT BREAKER / 'ERMS' - ENERGY REDUCING MAINTENANCE SWITCH / 'ZSI' - ZONE SELECTIVE INTERLOCKING / 'L' - PROVIDE CIRCUIT BREAKER WITH LOCKING PROVISIONS / 'R' – PROVIDE CIRCUIT BREAKER WITH RED MARKING

Notes:

Autodesk Docs://2024-020 City Hotel/(2024) City Hotel - Elec.rvt
5/20/2026 9:03:24 AM

Ramirez, Johnson, & Associates
3301 Lawrence St. Ste 2
Denver, CO 80205
P: 720.598.5774
HELTSHE
M1A | MERIDIAN 105 ARCHITECTURE

CITY HOTEL
415 PERRY STREET, CASTLE ROCK, CO.

DATE: 05.20.2026
PROJ. NO. 2023.002
ISSUED FOR: 1st PERMIT COMMENTS
SHEET TITLE: ELECTRICAL PANEL SCHEDULES

COLORADO LICENSED
DAMIAN R. MIRES
43565
05/27/2026
PROFESSIONAL ENGINEER

SHEET NUMBER
E0.05

Branch Panel: M34

Location: SEE PLANS
Supply From: MDP
Mounting: SURFACE
Enclosure: NEMA 1

Volts: 120/208 Wye
Phases: 3
Wires: 4

A.I.C. Rating: 35,000
Mains Type: MLO
Bus Rating: 400 A

CKT	Circuit Description	OPT	Load Class	Trip	Poles	A		B		C		Poles	Trip	Load Class	OPT	Circuit Description	CKT
1	FCU-3-1		E	15 A	1	118	4380										2
3	FCU-3-2		E	15 A	1			118	4380			3	50 A	M		RTU-1	4
5	FCU-4-1		E	15 A	1					118	4380						6
7	FCU-4-2		E	15 A	1	72	4380										8
9	FCU-4-3		E	15 A	1			118	4380			3	50 A	M		RTU-2	10
11	FCU-4-4		E	15 A	1					118	4380						12
13	FCU-4-5		E	15 A	1	72	9204										14
15	EF-3-1		M	15 A	1			21	9204			3	100 A	M		MAU-1	16
17	EF-4-1,EF-4-2, EF-4-3		M	15 A	1					64	9204						18
19	RH-4-1		E	20 A	2	1477	540					1	20 A	R		REC-MAINT. RECEPTS	20
21								1477	250			1	20 A	M		DAMPERS	22
23	RH-4-2		E	20 A	2					1477	4728						24
25						1477	4728					3	20 A	M		ERV-1	26
27	RH-4-3		E	20 A	2			1477	4728								28
29										1477	0	1	20 A	--		SPARE	30
31	EWH-3-1		E	20 A	1	1800	0					1	20 A	--		SPARE	32
33	EWH-3-2		E	20 A	1			1800	0			1	20 A	--		SPARE	34
35	EWH-4-1		E	20 A	1					1800	--	1	--	--		SPACE	36
37	SPACE		--	--	1	--	--					1	--	--		SPACE	38
39	SPACE		--	--	1			--	--			1	--	--		SPACE	40
41	SPACE		--	--	1					--	--	1	--	--		SPACE	42
					Total Load:	28249 VA		27954 VA		27747 VA							
					Total Amps:	236 A		233 A		231 A							
					Phase Balance	99 % A-B		99 % B-C		98 % C-A							

	Load Classification	Connected Load	Demand Factor	Estimated Demand	Panel Totals	
L	Lighting					
C	Continuous				**Total Conn. Load:**	83949 VA
R	Receptacle	540 VA	100.00%	540 VA	**Total Est. Demand:**	83949 VA
M	Motor	68411 VA	100.00%	68411 VA	**Total Conn.:**	233 A
LM	Largest Motor				**Total Est. Demand:**	233 A
E	Equipment	14998 VA	100.00%	14998 VA	**Spare Capacity:**	167 A
A	Appliance					

OPTIONS:
'ST' – PROVIDE SHUNT TRIP BREAKER / 'GFCI' – PROVIDE CIRCUIT BREAKER / 'GFP' – PROVIDE GFP CIRCUIT BREAKER / 'ERMS' - ENERGY REDUCING MAINTENANCE SWITCH / 'ZSI' - ZONE SELECTIVE INTERLOCKING / 'L' - PROVIDE CIRCUIT BREAKER WITH LOCKING PROVISIONS / 'R' – PROVIDE CIRCUIT BREAKER WITH RED MARKING

Notes:

Branch Panel: L1B

Location: HISTORICAL BLDG EXTERIOR
Supply From:
Mounting: SURFACE
Enclosure: NEMA 3R SERVICE ENTRANCE RATED

Volts: 120/208 Wye
Phases: 3
Wires: 4

A.I.C. Rating: 22,000
Mains Type: MLO
Bus Rating: 200 A
MCB Rating: 200 A

CKT	Circuit Description	OPT	Load Class	Trip	Poles	A		B		C		Poles	Trip	Load Class	OPT	Circuit Description	CKT
1	LTG - EXTERIOR		--	20 A	1	212	2496					2	35 A	--		EUH-1A	2
3	LTG - INTERIOR		--	20 A	1			588	2496								4
5	REC - GENERAL		--	20 A	1					180	2496	2	35 A	--		EUH-1B	6
7	SPARE		--	20 A	1	0	2496										8
9	SPARE		--	20 A	1			0	2496			2	35 A	--		EUH-1C	10
11	SPARE		--	20 A	1					0	2496						12
13	SPARE		--	20 A	1	0	2496					2	35 A	--		EUH-1D	14
15	SPARE		--	20 A	1			0	2496								16
17	SPARE		--	20 A	1					0	50	1	20 A	--		MOTORIZED DAMPER	18
19	SPARE		--	20 A	1	0	0					1	20 A	--		SPARE	20
21	SPARE		--	20 A	1			0	0			1	20 A	--		SPARE	22
23	SPARE		--	20 A	1					0	0	1	20 A	--		SPARE	24
25	SPARE		--	20 A	1	0	0					1	20 A	--		SPARE	26
27	SPARE		--	20 A	1			0	0			1	20 A	--		SPARE	28
29	SPARE		--	20 A	1					0	0	1	20 A	--		SPARE	30
31	SPARE		--	20 A	1	0	0					1	20 A	--		SPARE	32
33	SPARE		--	20 A	1			0	0			1	20 A	--		SPARE	34
35	SPARE		--	20 A	1					0	0	1	20 A	--		SPARE	36
37	SPARE		--	20 A	1	0	0					1	20 A	--		SPARE	38
39	SPACE		--	20 A	1			0	0			1	20 A	--		SPARE	40
41	SPACE		--	--	1					--	--	1	--	--		SPACE	42
43	SPACE		--	--	1	--	--					1	--	--		SPACE	44
45	SPACE		--	--	1			--	--			1	--	--		SPACE	46
47	SPACE		--	--	1					--	--	1	--	--		SPACE	48
49	SPACE		--	--	1	--	--					1	--	--		SPACE	50
51	SPACE		--	--	1			--	--			1	--	--		SPACE	52
53	SPACE		--	--	1					--	--	1	--	--		SPACE	54
					Total Load:	7700 VA		8076 VA		5222 VA							
					Total Amps:	67 A		70 A		44 A							
					Phase Balance	95 % A-B		65 % B-C		68 % C-A							

	Load Classification	Connected Load	Demand Factor	Estimated Demand	Panel Totals	
L	Lighting					
C	Continuous				**Total Conn. Load:**	20998 VA
R	Receptacle				**Total Est. Demand:**	20998 VA
M	Motor				**Total Conn.:**	58 A
LM	Largest Motor				**Total Est. Demand:**	58 A
E	Equipment				**Spare Capacity:**	142 A
A	Appliance					

OPTIONS:
'ST' – PROVIDE SHUNT TRIP BREAKER / 'GFCI' – PROVIDE CIRCUIT BREAKER / 'GFP' – PROVIDE GFP CIRCUIT BREAKER / 'ERMS' - ENERGY REDUCING MAINTENANCE SWITCH 'L' - PROVIDE CIRCUIT BREAKER WITH LOCKING PROVISIONS / 'R' – PROVIDE CIRCUIT BREAKER WITH RED MARKING / 'NEW' PROVIDE CIRCUIT BREAKER TO MATCH EXISTING

Notes:
LIGHT LINEWEIGHT INDICATES EXISTING BREAKER/CIRCUITING. BOLD LINEWEIGHT INDICATES NEW BREAKERS/CIRCUITING. PROVIDE NEW CIRCUIT BREAKERS WHERE INDICATED, AIC RATING AND MANUFACTURER TO MATCH EXISTING.

Branch Panel: L4

Location: SEE PLANS
Supply From: MDP
Mounting: SURFACE
Enclosure: NEMA 1

Volts: 120/208 Wye
Phases: 3
Wires: 4

A.I.C. Rating: 22,000
Mains Type: MLO
Bus Rating: 200 A

CKT	Circuit Description	OPT	Load Class	Trip	Poles	A		B		C		Poles	Trip	Load Class	OPT	Circuit Description	CKT
1	REC - 4TH FLOOR CLEANING		R	20 A	1	180	1230					1	20 A	R; L	AFCI	UNIT 403 GEN REC & LTG	2
3	REC - 4TH FLOOR CORR. (N)		R	20 A	1			720	1200			1	20 A	A	AFCI	UNIT 403 MICROWAVE	4
5	SPARE		--	20 A	1					0	439	1	20 A	R; L	DF	UNIT 403 BATHROOM	6
7	4TH FLOOR CORR LTG		L	20 A	1	1011	2500										8
9	SPARE		--	20 A	1			0	2500			2	35 A	M		UNIT 403 VTAC-1	10
11	UNIT 401 GEN REC & LTG	AFCI	R; L	20 A	1					1230	1440	1	20 A	R	AFCI	UNIT 403 LIVING ROOM	12
13	UNIT 401 MICROWAVE	AFCI	A	20 A	1	1200	0					1	20 A	--		SPARE	14
15	UNIT 401 BATHROOM	DF	R; L	20 A	1			439	1710			1	20 A	R; L	AFCI	UNIT 404 GEN REC & LTG	16
17	UNIT 401 VTAC-1		M	35 A	2					2500	1200	1	20 A	A	AFCI	UNIT 404 MICROWAVE	18
19						2500	439					1	20 A	R; L	DF	UNIT 404 BATHROOM	20
21	UNIT 401 LIVING ROOM	AFCI	R	20 A	1			1440	2500			2	35 A	M		UNIT 404 VTAC-1	22
23	UNIT 401 CH-1	GFCI	E	20 A	2					300	2500						24
25						300	300					2	20 A	E	GFCI	UNIT 404 CH-1	26
27	UNIT 402 GEN REC & LTG	AFCI	R; L	20 A	1			1230	300								28
29	UNIT 402 MICROWAVE	AFCI	A	20 A	1					1200	439	1	20 A	R; L	DF	UNIT 405 BATHROOM	30
31	UNIT 402 BATHROOM	DF	R; L	20 A	1	439	1200					1	20 A	A	AFCI	UNIT 405 MICROWAVE	32
33	UNIT 402 VTAC-1		M	35 A	2			2500	1710			1	20 A	R; L	AFCI	UNIT 405 GEN REC & LTG	34
35										2500	2500	2	35 A	M		UNIT 405 VTAC-1	36
37	UNIT 402 LIVING ROOM	AFCI	R	20 A	1	1440	2500										38
39	UNIT 402 CH-1	GFCI	E	20 A	2			300	300			2	20 A	E	GFCI	UNIT 405 CH-1	40
41										300	300						42
43	SPARE		--	20 A	1	0	0					1	20 A	--		SPARE	44
45	SPARE		--	20 A	1			0	0			1	20 A	--		SPARE	46
47	SPARE		--	20 A	1					0	0	1	20 A	--		SPARE	48
49	SPARE		--	20 A	1	0	0					1	20 A	--		SPARE	50
51	SPARE		--	20 A	1			0	0			1	20 A	--		SPARE	52
53	SPARE		--	20 A	1					0	0	1	20 A	--		SPARE	54
55	SPARE		--	20 A	1	0	0					1	20 A	--		SPARE	56
57	SPACE		--	--	1			--	--			1	--	--		SPACE	58
59	SPACE		--	--	1					--	--	1	--	--		SPACE	60
					Total Load:	15239 VA		16849 VA		16848 VA							
					Total Amps:	127 A		142 A		142 A							
					Phase Balance	90 % A-B		100 % B-C		90 % C-A							

	Load Classification	Connected Load	Demand Factor	Estimated Demand	Panel Totals	
L	Lighting	2036 VA	125.00%	2545 VA		
C	Continuous				**Total Conn. Load:**	48936 VA
R	Receptacle	13500 VA	87.04%	11750 VA	**Total Est. Demand:**	45895 VA
M	Motor	25000 VA	100.00%	25000 VA	**Total Conn.:**	136 A
LM	Largest Motor				**Total Est. Demand:**	127 A
E	Equipment	2400 VA	100.00%	2400 VA	**Spare Capacity:**	73 A
A	Appliance	6000 VA	70.00%	4200 VA		

OPTIONS:
'ST' – PROVIDE SHUNT TRIP BREAKER / 'GFCI' – PROVIDE CIRCUIT BREAKER / 'GFP' – PROVIDE GFP CIRCUIT BREAKER / 'ERMS' - ENERGY REDUCING MAINTENANCE SWITCH / 'ZSI' - ZONE SELECTIVE INTERLOCKING / 'L' - PROVIDE CIRCUIT BREAKER WITH LOCKING PROVISIONS / 'R' – PROVIDE CIRCUIT BREAKER WITH RED MARKING

Notes:

Branch Panel: B

Location: SEE PLANS
Supply From: MDP
Mounting: SURFACE
Enclosure: NEMA 1

Volts: 120/208 Wye
Phases: 3
Wires: 4

A.I.C. Rating: 22,000
Mains Type: MLO
Bus Rating: 200 A

CKT	Circuit Description	OPT	Load Class	Trip	Poles	A		B		C		Poles	Trip	Load Class	OPT	Circuit Description	CKT
1	REC - BAR RESTROOMS		R	20 A	1	540	720					1	20 A	R		REC -BAR GEN RECEPTS	2
3	REC - WARMING KITCHEN		R	20 A	1			540	720			1	20 A	R		REC - BAR GEN RECEPTS	4
5	REC - BAR CORRIDOR		R	20 A	1					720	398	1	20 A	L		LTG - BAR GEN LIGHTING	6
7	MOTORIZED SHADE - DECK BAR		M	20 A	1	500	0					1	20 A	--		SPARE	8
9	SPARE		--	20 A	1			0	0			1	20 A	--		SPARE	10
11	SPARE		--	20 A	1					0	0	1	20 A	--		SPARE	12
13	SPARE		--	20 A	1	0	0					1	20 A	--		SPARE	14
15	SPARE		--	20 A	1			0	0			1	20 A	--		SPARE	16
17	SPACE		--	--	1					--	--	1	--	--		SPACE	18
19	SPACE		--	--	1	--	--					1	--	--		SPACE	20
21	SPACE		--	--	1			--	--			1	--	--		SPACE	22
23	SPACE		--	--	1					--	--	1	--	--		SPACE	24
25	SPACE		--	--	1	--	--					1	--	--		SPACE	26
27	SPACE		--	--	1			--	--			1	--	--		SPACE	28
29	SPACE		--	--	1					--	--	1	--	--		SPACE	30
31	SPACE		--	--	1	--	--					1	--	--		SPACE	32
33	SPACE		--	--	1			--	--			1	--	--		SPACE	34
35	SPACE		--	--	1					--	--	1	--	--		SPACE	36
37	SPACE		--	--	1	--	--					1	--	--		SPACE	38
39	SPACE		--	--	1			--	--			1	--	--		SPACE	40
41	SPACE		--	--	1					--	--	1	--	--		SPACE	42
					Total Load:	1760 VA		1260 VA		1116 VA							
					Total Amps:	15 A		11 A		9 A							
					Phase Balance	72 % A-B		89 % B-C		63 % C-A							

	Load Classification	Connected Load	Demand Factor	Estimated Demand	Panel Totals	
L	Lighting	398 VA	125.00%	498 VA		
C	Continuous				**Total Conn. Load:**	4136 VA
R	Receptacle	3240 VA	100.00%	3240 VA	**Total Est. Demand:**	4235 VA
M	Motor	500 VA	100.00%	500 VA	**Total Conn.:**	11 A
LM	Largest Motor				**Total Est. Demand:**	12 A
E	Equipment				**Spare Capacity:**	188 A
A	Appliance					

OPTIONS:
'ST' – PROVIDE SHUNT TRIP BREAKER / 'GFCI' – PROVIDE CIRCUIT BREAKER / 'GFP' – PROVIDE GFP CIRCUIT BREAKER / 'ERMS' - ENERGY REDUCING MAINTENANCE SWITCH / 'ZSI' - ZONE SELECTIVE INTERLOCKING / 'L' - PROVIDE CIRCUIT BREAKER WITH LOCKING PROVISIONS / 'R' – PROVIDE CIRCUIT BREAKER WITH RED MARKING

Notes:

ESTIMATED FUTURE LOAD: 15KVA 42A

COLORADO LICENSED
43565
05/27/2026
PROFESSIONAL ENGINEER

Ramirez, Johnson, & Associates
3301 Lawrence St. Ste 2
Denver, CO 80205
P: 720.595.0774
HELTSHE

M1A MERIDIAN 105 ARCHITECTURE

CITY HOTEL
415 PERRY STREET, CASTLE ROCK, CO.

DATE: 05.20.2026
PROJ. NO. 2023.002

ISSUED FOR: 1st PERMIT COMMENTS

SHEET TITLE: ELECTRICAL PANEL SCHEDULES

SHEET NUMBER E0.06

Autodesk Docs://2024-020 City Hotel/(2024) City Hotel - Elec.rvt
5/20/2026 9:03:25 AM

LUMINAIRE SCHEDULE

TYPE	DESCRIPTION	MANUFACTURER	MODEL	INPUT VA	LAMPS	LUMENS	VOLTAGE	MOUNTING	NOTES
A1	2" ADJUSTABLE RECESSED LED DOWNLIGHT	DMF	XMA-07-9-27-NS-O	10 VA	LED, 2700K	750	120 V	RECESSED	
A1E	2" ADJUSTABLE RECESSED LED DOWNLIGHT, CONNECTED TO EMERGENCY LIGHTING CIRCUIT	DMF	XMA-07-9-27-NS-O	10 VA	LED, 2700K	750	120 V	RECESSED	
A2	2" ADJUSTABLE DOWNLIGHT	PRESCOLITE	AB2LED-2AB8LED9L27K8MD25PHXX	18 VA	LED, 2700K	900	120 V	RECESSED	
A2E	2" ADJUSTABLE DOWNLIGHT CONNECTED TO EMERGENCY LIGHTING CIRCUIT	PRESCOLITE	AB2LED-2AB8LED9L27K8MD25PHXX	18 VA	LED, 2700K	900	120 V	RECESSED	
B1	SURFACE MOUNT MONOPOINT LED	LUCIFER	CM1-12-AD1-BK-BK	11 VA	LED, 2700K	1095	120 V	SURFACE	
C1	TAPE LIGHT	BEULUX	A-L240-IP00-CT27-XX	2 VA	LED, 2700K	100/FT	<varies>	IN EXTRUSION	
D1	4" RECESSED DOWNLIGHT	DMF	MD-20-9-27-SP-0-M4TRS-XX	24 VA	LED, 2700K	2000	120 V	RECESSED	
D2	CAPSULE WALL SCONCE LED	CURREY & CO	CNC2485904	12 VA	LED, 2700K	800	120 V	WALL	
DU	BARBICAN SINGLE LIGHT BRASS WALL SCONCE	CRC1261667	CURREY & CO	60 VA	LED, 2700K	600	120 V	WALL	
E1	FREESTANDING RE-CHARGABLE LED TABLE LAMP	BY ARCH	BY ARCH	10 VA	LED, 2700K	300	120 V	N/A	1
EU	ILLUMINATED MIRROR	MUNNWORKS	OMEGA IV	24 VA	LED, 2700K	1750	120 V	WALL	
FU	UNIT BATHROOM SQUARE DOWNLIGHT	DMF	M4-NC-S-S, DRD2M-10-9-27K-GA-O	13 VA	LED, 2700K	1000	120 V	RECESSED	
L1	WALL SCONCE FOR BAR	BRUCK	EXT-EUD-SW-10LM-27K-90-BK-W-UNV-10V	17 VA	LED, 2700K	1100	120 V	SURFACE	+8'-0"AFF
L2	EXTERIOR WALL SCONCE	BEGA	B33539-K27	3 VA	LED, 2700K	145	120 V	SURFACE	+8'-0"AFF
L3	IN-GRADE, ASYMMETRIC THROW	BEGA	B77019-K27	3 VA	LED, 2700K	364	120 V	IN-GRADE	
L4	IN-GRADE, LANDSCAPE, ASYMMETRIC THROW	BEGA	B84086-K27	3 VA	LED, 2700K	381	120 V	IN-GRADE	
L5	WET-LISTED TAPE LIGHT	WAC	T24-OD1-X-27P	1 VA	LED, 2700K	100/FT	120 V	IN EXTRUSION	
L6	2X2 WET-LISTED RECESSED TROFFER	LITHONIA	2WRTL-F-L24-3000LM-OAW-AFL-120-GZ1-30 K-80CRI	27 VA	LED, 3000K	2848	120 V	RECESSED	
L6E	2X2 WET-LISTED RECESSED TROFFER	LITHONIA	2WRTL-F-L24-3000LM-OAW-AFL-120-GZ1-30 K-80CRI	27 VA	LED, 3000K	2848	120 V	RECESSED	
L8	IN-GRADE SYMMETRIC FLOODLIGHT	BEGA	B77018-K27	3 VA	LED, 2700K	352	120 V	IN-GRADE	
L9	DECORATIVE SCONCE	HUBBARDTON FORGE	303003	6 VA	G9 LED, 2700K	500	120 V	SURFACE	+7'-0" AFF
L10	4' LINEAR SIGNAGE LUMINAIRE	ALCON	11704-X-4L-27K-12-X-CL-UNI	35 VA	LED, 3000K	1684	120 V	SURFACE	+12'-9" AFF
L10E	4' LINEAR SIGNAGE LUMINAIRE, CONNECTED TO EMERGENCY LIGHTING CIRCUIT	ALCON	11704-X-4L-27K-12-X-CL-UNI	35 VA	LED, 3000K	1684	120 V	SURFACE	
R1	2X2 RECESSED TROFFER, DOUBLE GASKETED	COLUMBIA	LJT-22-30K-ULG-G-FS-A12-ED-U-G2	53 VA	LED, 3000K	6212	120 V	RECESSED	
R1E	2X2 RECESSED TROFFER, DOUBLE GASKETED, CONNECTED TO EMERGENCY LIGHTING CIRCUIT	COLUMBIA	LJT-22-30K-ULG-G-FS-A12-ED-U-G2	53 VA	LED, 3000K	6212	120 V	RECESSED	
R2	2X2 RECESSED INDIRECT TROFFER	LITECONTROL	55L-G-D-22-AHE-WHS-30K-D30-D01-UNV	24 VA	LED, 3000K	3000	120 V	RECESSED	
R2E	2X2 RECESSED INDIRECT TROFFER, CONNECTED TO EMERGENCY LIGHTING CIRCUIT	LITECONTROL	55L-G-D-22-AHE-WHS-30K-D30-D01-UNV	24 VA	LED, 3000K	3000	120 V	RECESSED	
S1	4' ELEVATOR PIT STRIP FIXTURE, ENCLOSED	COLUMBIA	LXEM-4-35-VL-RFA-EU	62 VA	LED, 3500K	8415	120 V	SURFACE	
S3	SURFACE MOUNT 4' LED STRIP WITH LENS	COLUMBIA	LCL-4-35-ML-E-U	42 VA	LED, 3500K	4597	120 V	SURFACE	
S3E	SURFACE MOUNT 4' LED STRIP WITH LENS, CONNECTED TO EMERGENCY LIGHTING CIRCUIT	COLUMBIA	LCL-4-35-ML-E-U	42 VA	LED, 3500K	4597	120 V	SURFACE	
S8	8' LED STRIP WITH LENS	COLUMBIA	LCL-8-30-ML-E-U	84 VA	LED,3000K	10308	120 V	SURFACE	
W1	LINEAR DIRECT/INDIRECT WALL LIGHT	FINELITE	HP2-WM-ID-4'-B-S-8TW-ASY -R-F-96LG-120-S-C-MB-FE-FB	32 VA	LED, 2700K	3688	120 V	WALL	SET TO 2700K
W1E	LINEAR DIRECT/INDIRECT WALL LIGHT, CONNECTED TO EMERGENCY LIGHTING CIRCUIT	FINELITE	HP2-WM-ID-4'-B-S-8TW-ASY -R-F-96LG-120-S-C-MB-FE-FB	32 VA	LED, 2700K	3688	120 V	WALL	SET TO 2700K
X1	THERMOPLASTIC COMBO EXIT/EM	DUAL-LITE	EVC-U-G-W-I	5 VA	LED		120 V	SURFACE	
X2	FLAT-PANEL EXIT SIGN WITH INTEGRAL BATTERY, GREEN LETTERING WITH MIRROR BACKING	EXITRONIX	902EX/903EX-R/WR-2CI-GM-BA-G2	5 VA	LED		120 V	SURFACE	
X3	EMERGENCY LIGHTING UNIT	DUAL-LITE	LZ-2-03L	6 VA	LED		120 V	SURFACE	

ABBREVIATIONS: BF - BOTTOM OF FIXTURE; OH - OVERALL FIXTURE HEIGHT; RD - RECESSED FIXTURE DEPTH; AFF - ABOVE FINISHED FLOOR

GENERAL NOTES:
A.LUMINAIRE SHOWN WITH CATALOG NUMBERS ARE THE BASIS OF DESIGN. SIMILAR BY OTHER LISTED MANUFACTURERS ARE ACCEPTABLE WITH PRIOR APPROVAL BY OWNER AND ENGINEER.
B.CONTRACTOR TO VERIFY LIGHT FIXTURE CATALOG NUMBER AND INSTALLATION REQUIREMENTS PRIOR TO ORDERING.
C.VERIFY TRIM COMPATIBILITY WITH CEILING TYPE PRIOR TO SUBMITTALS.

NOTES:
1. REFER TO ARCHITECTURAL DRAWINGS FOR QUANTITY AND LOCATIONS. SHOWN ON LUMINAIRE SCHEDULE FOR REFERENCE ONLY.

MECHANICAL EQUIPMENT SCHEDULE

TAG	NUMBER	EQUIPMENT DESCRIPTION	PANEL	CIRCUIT	MCA	TOTAL POWER LOAD	MOTOR HP	VOLT	PH	MOTOR RATED SWITCH	DISC SW	DISC. SWITCH AMPS	DISC. SWITCH POLES	FEEDER	COMMENTS
B	1	BOILER	M12	60	14 A	1564 VA		120 V	1	No	Yes	30 A	1	2#12, 1#12G, 3/4"C	2
B	2	BOILER	M12	62	14 A	1564 VA		120 V	1	No	Yes	30 A	1	2#12, 1#12G, 3/4"C	2
BF	1	BATHROOM EXHAUST FAN			0 A	7 VA		120 V	1	Yes	No			2#12, 1#12G, 3/4"C	3
C	1	AIR COOLED CHILLER	M12	59,61,63	85 A	30600 VA		208 V	3	No	Yes	200 A	3	3#1/0, 1#6G, 1-1/2"C	2
C	2	AIR COOLED CHILLER	M12	65,67,69	85 A	30600 VA		208 V	3	No	Yes	200 A	3	3#1/0, 1#6G, 1-1/2"C	2
CH	1	COVE HEATER			3 A	603 VA		208 V	1	No	Yes	30 A	1	2#12, 1#12G, 3/4"C	3
CH	1A	COVE HEATER	M12	81,83	3 A	603 VA		208 V	1	No	Yes	30 A	2	2#12, 1#12G, 3/4"C	
CH	1B	COVE HEATER	M12	85,87	3 A	603 VA		208 V	1	No	Yes	30 A	2	2#12, 1#12G, 3/4"C	
CWP	1/2	PUMP	M12	54	0 A	1034 VA	1/6	120 V	1	Yes	No			2#12, 1#12G, 3/4"C	2
CWP	3/4	PUMP	M12	74,76,78	0 A	4754 VA	1 1/2	208 V	3	No	Yes	30 A	3	2#12, 1#12G, 3/4"C	2
DBP	1	DOMESTIC WATER BOOSTER PUMP	M12	64,66	0 A	7709 VA	3	208 V	1	No	Yes	30 A	2	2#12, 1#12G, 3/4"C	2
ECH	1-1	ELECTRIC CEILING HEATER	M12	13	0 A	1500 VA		120 V	1	No	Yes	30 A	1	2#12, 1#12G, 3/4"C	2
EF	1-1	EXHAUST FAN	M12	25	0 A	24 VA		120 V	1	Yes	No			2#12, 1#12G, 3/4"C	
EF	1-2	EXHAUST FAN	M12	27	0 A	34 VA		120 V	1	Yes	No			2#12, 1#12G, 3/4"C	
EF	1-3	EXHAUST FAN	M12	27	0 A	24 VA		120 V	1	Yes	No			2#12, 1#12G, 3/4"C	
EF	2-1	EXHAUST FAN	M12	29	0 A	21 VA		120 V	1	Yes	No			2#12, 1#12G, 3/4"C	
EF	3-1	EXHAUST FAN	M34	15	0 A	21 VA		120 V	1	Yes	No			2#12, 1#12G, 3/4"C	
EF	4-1	EXHAUST FAN	M34	17	0 A	25 VA		120 V	1	Yes	No			2#12, 1#12G, 3/4"C	
EF	4-2	EXHAUST FAN	M34	17	0 A	18 VA		120 V	1	Yes	No			2#12, 1#12G, 3/4"C	
EF	4-3	EXHAUST FAN	M34	17	0 A	21 VA		120 V	1	Yes	No			2#12, 1#12G, 3/4"C	
EFH	1-1	ELECTRIC FLOOR HEATER	M12	31,33	0 A	1250 VA		208 V	1	No	Yes	30 A	2	2#12, 1#12G, 3/4"C	2
EFH	1-2	ELECTRIC FLOOR HEATER	M12	35,37	0 A	1250 VA		208 V	1	No	Yes	30 A	2	2#12, 1#12G, 3/4"C	2
EFH	1-3	ELECTRIC FLOOR HEATER	M12	39,41	0 A	1000 VA		208 V	1	No	Yes	30 A	2	2#12, 1#12G, 3/4"C	2
EFH	1-4	ELECTRIC FLOOR HEATER	M12	43,45	0 A	750 VA		208 V	1	No	Yes	30 A	2	2#12, 1#12G, 3/4"C	2
ERV	1	ENERGY RECOVERY VENTILATOR	M34	24,26,28	39 A	14184 VA		208 V	3	No	Yes	60 A	3	3#6, 1#10G, 3/4"C	2
EUH	1-1	ELECTRIC UNIT HEATER	M12	2,4	15 A	3016 VA		208 V	1	No	Yes	30 A	2	2#12, 1#12G, 3/4"C	2
EUH	1-2	ELECTRIC UNIT HEATER	M12	6,8	15 A	3016 VA		208 V	1	No	Yes	30 A	2	2#12, 1#12G, 3/4"C	2
EUH	1-3	ELECTRIC UNIT HEATER	M12	10,12	15 A	3016 VA		208 V	1	No	Yes	30 A	2	2#12, 1#12G, 3/4"C	2
EUH	1-4	ELECTRIC UNIT HEATER	M12	14,16	15 A	3016 VA		208 V	1	No	Yes	30 A	2	2#12, 1#12G, 3/4"C	2
EUH	1-5	ELECTRIC UNIT HEATER	M12	18,20	15 A	3016 VA		208 V	1	No	Yes	30 A	2	2#12, 1#12G, 3/4"C	2
EWH	1-1	ELECTRIC WALL HEATER	M12	15	0 A	1800 VA		120 V	1	No	Yes	30 A	1	2#12, 1#12G, 3/4"C	2
EWH	1-2	ELECTRIC WALL HEATER	M12	17	0 A	1800 VA		120 V	1	No	Yes	30 A	1	2#12, 1#12G, 3/4"C	2
EWH	1-3	ELECTRIC WALL HEATER	M12	19	0 A	1800 VA		120 V	1	No	Yes	30 A	1	2#12, 1#12G, 3/4"C	2
EWH	1-4	ELECTRIC WALL HEATER	M12	21	0 A	1800 VA		120 V	1	No	Yes	30 A	1	2#12, 1#12G, 3/4"C	2
EWH	1-5	ELECTRIC WALL HEATER	M12	23	0 A	1800 VA		120 V	1	No	Yes	30 A	1	2#12, 1#12G, 3/4"C	2
EWH	1-6	ELECTRIC WALL HEATER	M12	47	0 A	1800 VA		120 V	1	No	Yes	30 A	1	2#12, 1#12G, 3/4"C	2
EWH	1-7	ELECTRIC WALL HEATER	M12	73	0 A	1800 VA		120 V	1	No	Yes	30 A	1	2#12, 1#12G, 3/4"C	2
EWH	2-1	ELECTRIC WALL HEATER	M12	28	0 A	1800 VA		120 V	1	No	Yes	30 A	1	2#12, 1#12G, 3/4"C	2
EWH	2-2	ELECTRIC WALL HEATER	M12	84	0 A	1800 VA		120 V	1	No	Yes	30 A	1	2#12, 1#12G, 3/4"C	2
EWH	3-1	ELECTRIC WALL HEATER	M34	31	0 A	1800 VA		120 V	1	No	Yes	30 A	1	2#12, 1#12G, 3/4"C	2
EWH	3-2	ELECTRIC WALL HEATER	M34	33	0 A	1800 VA		120 V	1	No	Yes	30 A	1	2#12, 1#12G, 3/4"C	2
EWH	4-1	ELECTRIC WALL HEATER	M34	35	0 A	1800 VA		120 V	1	No	Yes	30 A	1	2#12, 1#12G, 3/4"C	2
FCU	1-1	FAN COIL UNIT	M12	30,32	5 A	936 VA		208 V	1	No	Yes	30 A	2	2#10, 1#10G, 3/4"C	
FCU	1-2	FAN COIL UNIT	M12	34,36	1 A	264 VA		208 V	1	No	Yes	30 A	2	2#10, 1#10G, 3/4"C	
FCU	1-3	FAN COIL UNIT	M12	38,40	1 A	264 VA		208 V	1	No	Yes	30 A	2	2#10, 1#10G, 3/4"C	
FCU	1-4	FAN COIL UNIT	M12	80,82	1 A	264 VA		208 V	1	No	Yes	30 A	2	2#10, 1#10G, 3/4"C	
FCU	1-5	FAN COIL UNIT	M12	49,51	1 A	131 VA		208 V	1	No	Yes	30 A	2	2#10, 1#10G, 3/4"C	
FCU	2-1	FAN COIL UNIT	M12	48	1 A	118 VA		120 V	1	No	Yes	30 A	1	2#12, 1#12G, 3/4"C	
FCU	2-2	FAN COIL UNIT	M12	50	1 A	118 VA		120 V	1	No	Yes	30 A	1	2#12, 1#12G, 3/4"C	
FCU	3-1	FAN COIL UNIT	M34	1	1 A	118 VA		120 V	1	No	Yes	30 A	1	2#12, 1#12G, 3/4"C	
FCU	3-2	FAN COIL UNIT	M34	3	1 A	118 VA		120 V	1	No	Yes	30 A	1	2#12, 1#12G, 3/4"C	
FCU	4-1	FAN COIL UNIT	M34	5	1 A	118 VA		120 V	1	No	Yes	30 A	1	2#12, 1#12G, 3/4"C	
FCU	4-2	FAN COIL UNIT	M34	7	1 A	72 VA		120 V	1	No	Yes	30 A	1	2#12, 1#12G, 3/4"C	
FCU	4-3	FAN COIL UNIT	M34	9	1 A	118 VA		120 V	1	No	Yes	30 A	1	2#12, 1#12G, 3/4"C	
FCU	4-4	FAN COIL UNIT	M34	11	1 A	118 VA		120 V	1	No	Yes	30 A	1	2#12, 1#12G, 3/4"C	
FCU	4-5	FAN COIL UNIT	M34	13	1 A	72 VA		120 V	1	No	Yes	30 A	1	2#12, 1#12G, 3/4"C	
FP	1	FIRE PUMP	GDP	2,4,6	0 A	41070 VA		208 V	3	No	No	200 A	3	3#1/0, 1#6G, 2"C	2
GEF	1	EXHAUST FAN	M12	53,55,57	0 A	2376 VA	1 1/2	208 V	3	No	Yes	30 A	3	2#12, 1#12G, 3/4"C	1,2
GWH	1	GAS WATER HEATER	M12	68	5 A	575 VA		120 V	1	Yes	No			2#12, 1#12G, 3/4"C	
GWH	2	GAS WATER HEATER	M12	70	5 A	575 VA		120 V	1	Yes	No			2#12, 1#12G, 3/4"C	
GWH	3	GAS WATER HEATER	M12	72	5 A	575 VA		120 V	1	Yes	No			2#12, 1#12G, 3/4"C	
HWCP	1	HOT WATER RECIRCULATION PUMP	M12	58	0 A	14 VA		120 V	1	No	No			2#12, 1#12G, 3/4"C	
HWCP	2	HOT WATER RECIRCULATION PUMP	M12	58	0 A	10 VA		120 V	1	No	No			2#12, 1#12G, 3/4"C	
HWP	1/2	PUMP	M12	52	0 A	799 VA	1/8	120 V	1	Yes	No			2#12, 1#12G, 3/4"C	2
HWP	3/4	PUMP	M12	75,77,79	0 A	4754 VA	1 1/2	208 V	3	No	Yes	30 A	3	2#12, 1#12G, 3/4"C	2
JP	1	JOCKEY PUMP	GDP	13,15,17	0 A	11088 VA	10	208 V	3	No	No	100 A	3	3#8, 1#10G, 3/4"C	2
MAU	1	MAKEUP AIR UNIT	M34	14,16,18	77 A	27612 VA		208 V	3	No	Yes	100 A	3	3#1, 1#8G, 1-1/4"C	2
PUH	1-1	PLENUM UNIT HEATER	M12	1,3	25 A	5200 VA		208 V	1	No	Yes	30 A	2	2#10, 1#10G, 3/4"C	2
PUH	1-2	PLENUM UNIT HEATER	M12	5,7	25 A	5200 VA		208 V	1	No	Yes	30 A	2	2#10, 1#10G, 3/4"C	2
PUH	1-3	PLENUM UNIT HEATER	M12	9,11	25 A	5200 VA		208 V	1	No	Yes	30 A	2	2#10, 1#10G, 3/4"C	2
RH	4-1	RADIANT HEATER	M34	19,21	14 A	2954 VA		208 V	1	No	Yes	30 A	2	2#12, 1#12G, 3/4"C	2
RH	4-2	RADIANT HEATER	M34	23,25	14 A	2954 VA		208 V	1	No	Yes	30 A	2	2#12, 1#12G, 3/4"C	2
RH	4-3	RADIANT HEATER	M34	27,29	14 A	2954 VA		208 V	1	No	Yes	30 A	2	2#12, 1#12G, 3/4"C	2
RTU	1	ROOFTOP UNIT	M34	2,4,6	37 A	13140 VA		208 V	3	No	Yes	60 A	3	3#6, 1#10G, 3/4"C	2
RTU	2	ROOFTOP UNIT	M34	8,10,12	37 A	13140 VA		208 V	3	No	Yes	60 A	3	3#6, 1#10G, 3/4"C	2
SB	1	SNOWMELT BOILER	M12	56	14 A	1564 VA		120 V	1	No	Yes	30 A	1	2#12, 1#12G, 3/4"C	2
SB	2	SNOWMELT BOILER	M12	46	14 A	1564 VA		120 V	1	No	Yes	30 A	1	2#12, 1#12G, 3/4"C	2
SMP	1/2	PUMP	M12	86	0 A	1034 VA	1/6	120 V	1	Yes	No			2#12, 1#12G, 3/4"C	2
SMP	3/4	PUMP	M12	88,90,92	0 A	6194 VA	3	208 V	3	No	Yes	30 A	3	2#12, 1#12G, 3/4"C	2
VTAC	1	HEAT PUMP			0 A	5000 VA		208 V	1	No	Yes	30 A	1	2#12, 1#12G, 3/4"C	2,3

GENERAL NOTES:
1. REFER TO MECHANICAL DRAWINGS FOR MECHANICAL EQUIPMENT LOCATIONS.
2. DIVISION 26 CONTRACTOR TO VERIFY EXACT POWER REQUIREMENTS WITH DIVISION 23 CONTRACTOR PRIOR TO ROUGH-IN.

NOTES:
1. PROVIDE SINGLE-POLE, FRACTIONAL HORSEPOWER MANUAL STARTER WITH OVERLOAD PROTECTION. SIZE PER NAMEPLATE RATING OF UNIT.
2. DISCONNECT FURNISHED BY DIVISION 23 CONTRACTOR. REFER TO MECHANICAL SCHEDULES FOR ADDITIONAL INFORMATION.
3. REFER TO ELECTRICAL ENLARGED UNIT PLANS AND LEVELS 2, 3, AND 4 POWER PLANS FOR CIRCUIT DESIGNATIONS.

5/20/2026 9:03:27 AM Autodesk Docs://2024-020 City Hotel\(2024) City Hotel - Elec.rvt

Ramirez, Johnson, & Associates
3321 Lawrence St. Ste 2
Denver, CO 80205
P: 720.598.0774
HELTSHE
M1A MERIDIAN 105 ARCHITECTURE

CITY HOTEL
415 PERRY STREET, CASTLE ROCK, CO.

DATE: 05.20.2026
PROJ. NO. 2023.002
ISSUED FOR: 1st PERMIT COMMENTS
SHEET TITLE: ELECTRICAL SCHEDULES

COLORADO LICENSED DAMIAN RAMIREZ 43565 05/27/2026 PROFESSIONAL ENGINEER

SHEET NUMBER E0.07

COM*check* Software Version COMcheckWeb

Interior Lighting Compliance Certificate

Project Information

Energy Code: 2018 IECC
Project Title: 24020 City Hotel
Project Type: New Construction

Construction Site:
415 Perry St
Castle Rock, Colorado 80104

Owner/Agent:

Designer/Contractor:

Efficiency Packages

Description	Credit
Reduced Lighting Power	1.0

Credits: 1.0 Required 1.0 Proposed

Allowed Interior Lighting Power

A Area Category	B Floor Area (ft2)	C Allowed Watts / ft2	D Allowed Watts
1-MAIN ELECTRICAL RM (Common Space Types:Electrical/Mechanical)	165	0.39	64
2-LINEN STORAGE (Common Space Types:Storage >=50 - <=1000 sq.ft.)	107	0.41	44
3-LEVEL 1 CORRIDORS (Common Space Types:Corridor/Transition >=8 ft wide)	250	0.59	148
4-KITCHEN (Common Space Types:Food Preparation)	857	0.95	814
5-WATER ENTRY (Common Space Types:Electrical/Mechanical)	182	0.39	71
6-LEVEL 1 RESTROOMS (Common Space Types:Restrooms)	296	0.77	228
7-LOBBY (Hotel:Hotel Lobby)	1902	0.95	1807
8-BAR (Common Space Types:Dining Area - Bar Lounge/Leisure)	530	0.84	445
9-RETAIL CORE SHELL (Retail:Sales Area)	2376	1.10	2614
10-ELEV CTRL, DATA, ELEC (Common Space Types:Electrical/Mechanical)	110	0.39	43
11-OFFICE (Common Space Types:Office - Enclosed)	65	0.84	55
12-BREAKROOM (Common Space Types:Lounge/Breakroom)	274	0.56	153
13-STAIRWELLS (Common Space Types:Stairwell)	1096	0.52	570
14-MECH MEZZANINE (Common Space Types:Electrical/Mechanical)	459	0.39	179
15-LEVEL 2 CORRIDOR (Common Space Types:Corridor/Transition <8 ft wide)	1261	0.59	744
16-CLEANING ROOMS (Common Space Types:Storage >=50 - <=1000 sq.ft.)	387	0.41	159
17-LINEN LEVELS 2 AND 3 (Common Space Types:Storage <50 sq.ft.)	40	0.41	16
18-LEVEL 3 CORRIDOR (Common Space Types:Corridor/Transition <8 ft wide)	1261	0.59	744
19-LEVEL 4 CORRIDOR (Common Space Types:Corridor/Transition <8 ft wide)	1354	0.59	799
20-LEVEL 4 RESTROOMS (Common Space Types:Restrooms)	222	0.77	171
21-WARMING KITCHEN (Common Space Types:Food Preparation)	170	0.95	162
22-FOOD AND BEV CORE SHELL (Common Space Types:Dining Area - Bar Lounge/Leisure)	989	0.84	831
23-CONVERTABLE DECK BAR (Common Space Types:Dining Area - Bar Lounge/Leisure)	893	0.84	750
24-GUEST ROOMS (Common Space Types:Guest Room)	10427	0.69	7195
25-TRASH CORRIDORS (Common Space Types:Corridor/Transition >=8 ft wide)	350	0.59	206

A Area Category	B Floor Area (ft2)	C Allowed Watts / ft2	D Allowed Watts
wide)			
		Total Allowed Watts =	24081

Proposed Interior Lighting Power

A Fixture ID : Description / Lamp / Wattage Per Lamp / Ballast	B Lamps/ Fixture	C # of Fixture	D Fixture Watt.	E (C X D)
1-MAIN ELECTRICAL RM (Common Space Types:Electrical/Mechanical)				
S3/S3E: S3/S3E: LED:	0	2	42	84
2-LINEN STORAGE (Common Space Types:Storage >=50 - <=1000 sq.ft.)				
S3/S3E: S3/S3E: LED:	0	1	42	42
3-LEVEL 1 CORRIDORS (Common Space Types:Corridor/Transition >=8 ft wide)				
R1/R1E: R1/R1E: LED:	0	5	53	265
4-KITCHEN (Common Space Types:Food Preparation)				
R1/R1E: R1/R1E: LED:	0	14	53	742
5-WATER ENTRY (Common Space Types:Electrical/Mechanical)				
S3/S3E: S3/S3E: LED:	0	2	42	84
6-LEVEL 1 RESTROOMS (Common Space Types:Restrooms)				
D2: D2: LED:	0	8	12	96
A1/A1E: A1/A1E: LED:	0	2	10	20
7-LOBBY (Hotel:Hotel Lobby)				
A1/A1E: A1/A1E: LED:	0	120	10	1200
D1: D1: LED:	0	1	24	24
C1: C1: LED:	0	242	2	484
8-BAR (Common Space Types:Dining Area - Bar Lounge/Leisure)				
A1/A1E: A1/A1E: LED:	0	11	10	110
C1: C1: LED:	0	55	2	110
B1: B1: LED:	0	17	11	187
D2: D2: LED:	0	2	12	24
9-RETAIL CORE SHELL (Retail:Sales Area)				
S8: S8: LED:	0	3	84	252
10-ELEV CTRL, DATA, ELEC (Common Space Types:Electrical/Mechanical)				
S3/S3E: S3/S3E: LED:	0	3	42	126
11-OFFICE (Common Space Types:Office - Enclosed)				
R2/R2E: R2/R2E: LED:	0	1	24	24
12-BREAKROOM (Common Space Types:Lounge/Breakroom)				
R2/R2E: R2/R2E: LED:	0	6	24	144
13-STAIRWELLS (Common Space Types:Stairwell)				
W1/W1E: W1/W1E: LED:	0	8	32	256
14-MECH MEZZANINE (Common Space Types:Electrical/Mechanical)				
S8: S8: LED:	0	3	84	252
15-LEVEL 2 CORRIDOR (Common Space Types:Corridor/Transition <8 ft wide)				
A1/A1E: A1/A1E: LED:	0	52	10	520
D1: D1: LED:	0	1	24	24
16-CLEANING ROOMS (Common Space Types:Storage >=50 - <=1000 sq.ft.)				
S3/S3E: S3/S3E: LED:	0	9	42	378
A1/A1E: A1/A1E: LED:	0	2	10	20
17-LINEN LEVELS 2 AND 3 (Common Space Types:Storage <50 sq.ft.)				

A Fixture ID : Description / Lamp / Wattage Per Lamp / Ballast	B Lamps/ Fixture	C # of Fixture	D Fixture Watt.	E (C X D)
S3/S3E: S3/S3E: LED:	0	2	42	84
18-LEVEL 3 CORRIDOR (Common Space Types:Corridor/Transition <8 ft wide)				
A2/A2E: A2/A2E: LED:	0	53	18	954
D1: D1: LED:	0	1	24	24
19-LEVEL 4 CORRIDOR (Common Space Types:Corridor/Transition <8 ft wide)				
A2/A2E: A2/A2E: LED:	0	53	18	954
D1: D1: LED:	0	1	24	24
20-LEVEL 4 RESTROOMS (Common Space Types:Restrooms)				
A1/A1E: A1/A1E: LED:	0	8	10	80
D2: D2: LED:	0	4	12	48
21-WARMING KITCHEN (Common Space Types:Food Preparation)				
R1/R1E: R1/R1E: LED:	0	4	53	212
22-FOOD AND BEV CORE SHELL (Common Space Types:Dining Area - Bar Lounge/Leisure)				
S8: S8: LED:	0	4	84	336
23-CONVERTABLE DECK BAR (Common Space Types:Dining Area - Bar Lounge/Leisure)				
L1: L1: LED:	0	4	17	68
L2: L2: LED:	0	2	3	6
A2/A2E: A2/A2E: LED:	0	2	18	36
24-GUEST ROOMS (Common Space Types:Guest Room)				
DU: DU: LED:	0	71	60	4260
EU: EU: LED:	0	52	24	1248
FU: FU: LED:	0	34	13	442
C1: C1: LED:	0	210	2	420
25-TRASH CORRIDORS (Common Space Types:Corridor/Transition >=8 ft wide)				
S3/S3E: S3/S3E: LED:	0	3	42	126
L6/L6E: L6/L6E: LED:	0	2	27	54
		Total Proposed Watts =		14844

Proposed Interior Lighting Controls

Fixture	Lighting Control
1-MAIN ELECTRICAL RM (Common Space Types:Electrical/Mechanical)	
S3/S3E: S3/S3E: LED:	Interior Timeswitch, Manual Control
2-LINEN STORAGE (Common Space Types:Storage >=50 - <=1000 sq.ft.)	
S3/S3E: S3/S3E: LED:	Occupancy Sensor, Manual Control
3-LEVEL 1 CORRIDORS (Common Space Types:Corridor/Transition >=8 ft wide)	
R1/R1E: R1/R1E: LED:	Occupancy Sensor, Manual Control
4-KITCHEN (Common Space Types:Food Preparation)	
R1/R1E: R1/R1E: LED:	Occupancy Sensor, Manual Control
5-WATER ENTRY (Common Space Types:Electrical/Mechanical)	
S3/S3E: S3/S3E: LED:	Occupancy Sensor, Manual Control
6-LEVEL 1 RESTROOMS (Common Space Types:Restrooms)	
D2: D2: LED:	Occupancy Sensor, Manual Control
A1/A1E: A1/A1E: LED:	Occupancy Sensor, Manual Control
7-LOBBY (Hotel:Hotel Lobby)	

Fixture	Lighting Control
A1/A1E: A1/A1E: LED:	Interior Timeswitch, Manual Control
D1: D1: LED:	Interior Timeswitch, Manual Control
C1: C1: LED:	Interior Timeswitch, Manual Control
8-BAR (Common Space Types:Dining Area - Bar Lounge/Leisure)	
A1/A1E: A1/A1E: LED:	Interior Timeswitch, Manual Control
C1: C1: LED:	Interior Timeswitch, Manual Control
B1: B1: LED:	Interior Timeswitch, Manual Control
D2: D2: LED:	Interior Timeswitch, Manual Control
9-RETAIL CORE SHELL (Retail:Sales Area)	
S8: S8: LED:	Occupancy Sensor, Manual Control
10-ELEV CTRL, DATA, ELEC (Common Space Types:Electrical/Mechanical)	
S3/S3E: S3/S3E: LED:	Occupancy Sensor, Manual Control
11-OFFICE (Common Space Types:Office - Enclosed)	
R2/R2E: R2/R2E: LED:	Occupancy Sensor, Manual Control
12-BREAKROOM (Common Space Types:Lounge/Breakroom)	
R2/R2E: R2/R2E: LED:	Occupancy Sensor, Manual Control
13-STAIRWELLS (Common Space Types:Stairwell)	
W1/W1E: W1/W1E: LED:	Occupancy Sensor, Bi-level
14-MECH MEZZANINE (Common Space Types:Electrical/Mechanical)	
S8: S8: LED:	Occupancy Sensor, Manual Control
15-LEVEL 2 CORRIDOR (Common Space Types:Corridor/Transition <8 ft wide)	
A1/A1E: A1/A1E: LED:	Occupancy Sensor, Bi-level
D1: D1: LED:	Occupancy Sensor, Bi-level
16-CLEANING ROOMS (Common Space Types:Storage >=50 - <=1000 sq.ft.)	
S3/S3E: S3/S3E: LED:	Occupancy Sensor, Manual Control
A1/A1E: A1/A1E: LED:	Occupancy Sensor, Manual Control
17-LINEN LEVELS 2 AND 3 (Common Space Types:Storage <50 sq.ft.)	
S3/S3E: S3/S3E: LED:	Occupancy Sensor, Manual Control
18-LEVEL 3 CORRIDOR (Common Space Types:Corridor/Transition <8 ft wide)	
A2/A2E: A2/A2E: LED:	Occupancy Sensor, Bi-level
D1: D1: LED:	Occupancy Sensor, Bi-level
19-LEVEL 4 CORRIDOR (Common Space Types:Corridor/Transition <8 ft wide)	
A2/A2E: A2/A2E: LED:	Occupancy Sensor, Bi-level
D1: D1: LED:	Occupancy Sensor, Bi-level
20-LEVEL 4 RESTROOMS (Common Space Types:Restrooms)	
A1/A1E: A1/A1E: LED:	Occupancy Sensor, Manual Control
D2: D2: LED:	Occupancy Sensor, Manual Control

Fixture	Lighting Control
21-WARMING KITCHEN (Common Space Types:Food Preparation)	
R1/R1E: R1/R1E: LED:	Occupancy Sensor
22-FOOD AND BEV CORE SHELL (Common Space Types:Dining Area - Bar Lounge/Leisure)	
S8: S8: LED:	Occupancy Sensor, Manual Control
23-CONVERTABLE DECK BAR (Common Space Types:Dining Area - Bar Lounge/Leisure)	
L1: L1: LED:	Occupancy Sensor, Manual Control
L2: L2: LED:	Occupancy Sensor, Manual Control
A2/A2E: A2/A2E: LED:	Occupancy Sensor, Manual Control
24-GUEST ROOMS (Common Space Types:Guest Room)	
DU: DU: LED:	Occupancy Sensor, Manual Control
EU: EU: LED:	Occupancy Sensor, Manual Control
FU: FU: LED:	Occupancy Sensor, Manual Control
C1: C1: LED:	Occupancy Sensor, Manual Control
25-TRASH CORRIDORS (Common Space Types:Corridor/Transition >=8 ft wide)	
S3/S3E: S3/S3E: LED:	Occupancy Sensor, Manual Control
L6/L6E: L6/L6E: LED:	Occupancy Sensor, Manual Control

Interior Lighting PASSES: Design 38% better than code

Interior Lighting Compliance Statement

Compliance Statement: The proposed interior lighting design represented in this document is consistent with the building plans, specifications, and other calculations submitted with this permit application. The proposed interior lighting systems have been designed to meet the 2018 IECC requirements in COMcheckWeb and to comply with any applicable mandatory requirements listed in the Inspection Checklist.

Name - Title Signature Date

COM*check* Software Version COMcheckWeb

Exterior Lighting Compliance Certificate

Project Information

Energy Code: 2018 IECC
Project Title: 24020 City Hotel
Project Type: New Construction
Exterior Lighting Zone 2 (Residential mixed use area (LZ2))

Construction Site:
415 Perry St
Castle Rock, Colorado 80104

Owner/Agent:

Designer/Contractor:

Efficiency Packages

Description	Credit
Reduced Lighting Power	1.0

Credits: 1.0 Required 1.0 Proposed

Allowed Exterior Lighting Power

A Area/Surface Category	B Quantity	C Allowed Watts /	D Tradable Wattage	E Allowed Watts (B X C)
COURTYARD (Plaza area)	2542 ft2	0.1	Yes	254
FUTURE RESTAURANT ENTRY (Entry canopy)	285 ft2	0.25	Yes	71
MURAL LIGHT (Illuminated area of facade wall or surface)	600 ft2	0.07	No	45
COVERED PARKING (Parking area)	1301 ft2	0.04	Yes	52
GENERATOR ROOM (Special feature area)	205 ft2	0.1	Yes	20
		Total Tradable Watts (a) =		398
		Base Site Allowance (b) =		400
		Total Allowed Watts =		443

(a) Wattage tradeoffs are only allowed between tradable areas/surfaces.
(b) A base site allowance equal to 400 watts may be applied toward compliance of both non-tradable and tradable areas/surfaces.

Proposed Exterior Lighting Power

A Fixture ID : Description / Lamp / Wattage Per Lamp / Ballast	B Lamps/ Fixture	C # of Fixture	D Fixture Watt.	E (C X D)
COURTYARD (Plaza area, 2542 ft2): Tradable Wattage				
L8: L8: LED:	0	20	3	60
L9: L9: LED:	0	2	6	12
L10/L10E: L10/L10E: LED:	0	6	35	210
L4: L4: LED:	0	2	3	6
L5: L5: LED:	0	12	1	12
FUTURE RESTAURANT ENTRY (Entry canopy, 285 ft2): Tradable Wattage				
L2: L2: LED:	0	5	3	15
L10/L10E: L10/L10E: LED:	0	2	35	70
MURAL LIGHT (Illuminated area of facade wall or surface, 600 ft2): Non-tradable Wattage				

A Fixture ID : Description / Lamp / Wattage Per Lamp / Ballast	B Lamps/ Fixture	C # of Fixture	D Fixture Watt.	E (C X D)
L10/L10E: L10/L10E: LED:	0	4	35	140
COVERED PARKING (Parking area, 1301 ft2): Tradable Wattage				
L6/L6E: L6/L6E: LED:	0	3	27	81
GENERATOR ROOM (Special feature area, 205 ft2): Tradable Wattage				
S3/S3E: S3/S3E: LED:	0	4	42	168
		Total Tradable Proposed Watts =		634

Proposed Exterior Lighting Controls

Fixture	Lighting Control
COURTYARD (Plaza area, 2542 ft2): Tradable Wattage	
L8: L8: LED:	Daylight Shutoff, Exterior Timeswitch
L9: L9: LED:	Daylight Shutoff, Exterior Timeswitch
L10/L10E: L10/L10E: LED:	Daylight Shutoff, Exterior Timeswitch
L4: L4: LED:	Daylight Shutoff, Exterior Timeswitch
L5: L5: LED:	Daylight Shutoff, Exterior Timeswitch
FUTURE RESTAURANT ENTRY (Entry canopy, 285 ft2): Tradable Wattage	
L2: L2: LED:	Daylight Shutoff, Exterior Timeswitch
L10/L10E: L10/L10E: LED:	Daylight Shutoff, Exterior Timeswitch
MURAL LIGHT (Illuminated area of facade wall or surface, 600 ft2): Non-tradable Wattage	
L10/L10E: L10/L10E: LED:	Daylight Shutoff, Facade or Landscape, Exterior Timeswitch
COVERED PARKING (Parking area, 1301 ft2): Tradable Wattage	
L6/L6E: L6/L6E: LED:	Daylight Shutoff, Exterior Timeswitch
GENERATOR ROOM (Special feature area, 205 ft2): Tradable Wattage	
S3/S3E: S3/S3E: LED:	Daylight Shutoff, Exterior Timeswitch

Exterior Lighting PASSES: Design 10% better than code

Exterior Lighting Compliance Statement

Compliance Statement: The proposed exterior lighting design represented in this document is consistent with the building plans, specifications, and other calculations submitted with this permit application. The proposed exterior lighting systems have been designed to meet the 2018 IECC requirements in COMcheckWeb and to comply with any applicable mandatory requirements listed in the Inspection Checklist.

Name - Title Signature Date

COM*check* Software Version COMcheckWeb

Inspection Checklist

Energy Code: 2018 IECC

Requirements: 90.0% were addressed directly in the COM*check* software

Text in the "Comments/Assumptions" column is provided by the user in the COMcheck Requirements screen. For each requirement, the user certifies that a code requirement will be met and how that is documented, or that an exception is being claimed. Where compliance is itemized in a separate table, a reference to that table is provided.

Section # & Req.ID	Plan Review	Complies?	Comments/Assumptions
C103.2 [PR4][1]	Plans, specifications, and/or calculations provide all information with which compliance can be determined for the interior lighting and electrical systems and equipment and document where exceptions to the standard are claimed. Information provided should include interior lighting power calculations, wattage of bulbs and ballasts, transformers and control devices.	☐Complies ☐Does Not ☐Not Observable ☐Not Applicable	
C103.2 [PR8][1]	Plans, specifications, and/or calculations provide all information with which compliance can be determined for the exterior lighting and electrical systems and equipment and document where exceptions to the standard are claimed. Information provided should include exterior lighting power calculations, wattage of bulbs and ballasts, transformers and control devices.	☐Complies ☐Does Not ☐Not Observable ☐Not Applicable	
C406 [PR9][1]	Plans, specifications, and/or calculations provide all information with which compliance can be determined for the additional energy efficiency package options.	☐Complies ☐Does Not ☐Not Observable ☐Not Applicable	Requirement will be met.

Additional Comments/Assumptions:

1	High Impact (Tier 1)	2	Medium Impact (Tier 2)	3	Low Impact (Tier 3)

Autodesk Docs://2024-020 City Hotel/(2024) City Hotel - Elec.rvt
5/20/2026 9:03:29 AM

Ramirez, Johnson, & Associates
3301 Lawrence St. Ste 2
Denver, CO 80205
P: 720.598.0774
HELTSHE
M1A | MERIDIAN 105 ARCHITECTURE

CITY HOTEL
415 PERRY STREET, CASTLE ROCK, CO.

DATE: 05.20.2026
PROJ. NO. 2023.002
ISSUED FOR: 1st PERMIT COMMENTS
SHEET TITLE: ELECTRICAL COMCHECK

COLORADO LICENSED DANIELLA M. HELTSHE 43565 05/27/2026 PROFESSIONAL ENGINEER

SHEET NUMBER
E0.08

Section # & Req.ID	Rough-In Electrical Inspection	Complies?	Comments/Assumptions
C405.2.2.2 [EL22][1]	Spaces required to have light-reduction controls have a manual control that allows the occupant to reduce the connected lighting load in a reasonably uniform illumination pattern >= 50 percent.	☐Complies ☐Does Not ☐Not Observable ☐Not Applicable	Requirement will be met. **Location on plans/spec:** NO DAYLIGHT ZONES WITH MORE THAN 150W OF LIGHTING IN SCOPE
C405.2.1, C405.2.1.1 [EL18][1]	Occupancy sensors installed in classrooms/lecture/training rooms, conference/meeting/multipurpose rooms, copy/print rooms, lounges/breakrooms, enclosed offices, open plan office areas, restrooms, storage rooms, locker rooms, warehouse storage areas, and other spaces <= 300 sqft that are enclosed by floor-to-ceiling height partitions. Reference section language C405.2.1.2 for control function in warehouses and section C405.2.1.3 for open plan office spaces.	☐Complies ☐Does Not ☐Not Observable ☐Not Applicable	**Exception:** Automatic-on controls are allowed in corridors, stairways, restrooms, primary building entrance areas and lobbies, and areas where manual-on controls could impact safety or security. **Location on plans/spec:** E2.01
C405.2.1.2 [EL19][1]	Occupancy sensors control function in warehouses: In warehouses, the lighting in aisleways and open areas is controlled with occupant sensors that automatically reduce lighting power by 50% or more when the areas are unoccupied. The occupant sensors control lighting in each aisleway independently and do not control lighting beyond the aisleway being controlled by the sensor.	☐Complies ☐Does Not ☐Not Observable ☐Not Applicable	**Exception:** Requirement does not apply. **Location on plans/spec:** NO WOREHOUSES IN SCOPE
C405.2.1.3 [EL20][1]	Occupant sensor control function in open plan office areas: Occupant sensor controls in open office spaces >= 300 sq.ft. have controls 1) configured so that general lighting can be controlled separately in control zones with floor areas <= 600 sq.ft. within the space, 2) automatically turn off general lighting in all control zones within 20 minutes after all occupants have left the space, 3) are configured so that general lighting power in each control zone is reduced by >= 80% of the full zone general lighting power within 20 minutes of all occupants leaving that control zone, and 4) are configured such that any daylight responsive control will activate space general lighting or control zone general lighting only when occupancy for the same area is detected.	☐Complies ☐Does Not ☐Not Observable ☐Not Applicable	**Exception:** Requirement does not apply. **Location on plans/spec:** NO OPEN PLAN OFFICE AREAS IN SCOPE
C405.2.2.1, C405.2.2.2 [EL21][2]	Each area not served by occupancy sensors (per C405.2.1) have time-switch controls and functions detailed in sections C405.2.2.1 and C405.2.2.2.	☐Complies ☐Does Not ☐Not Observable ☐Not Applicable	Requirement will be met. **Location on plans/spec:** E2.01, E2.02, E2.03, E2.04, E3.00, E3.01

1 High Impact (Tier 1) | 2 Medium Impact (Tier 2) | 3 Low Impact (Tier 3)

Section # & Req.ID	Rough-In Electrical Inspection	Complies?	Comments/Assumptions
C405.2.3.1, C405.2.3.2 [EL23][2]	Daylight zones provided with individual controls that control the lights independent of general area lighting. See code section C405.2.3 Daylight-responsive controls for applicable spaces, C405.2.3.1 Daylight responsive control function and section C405.2.3.2 Sidelit zone.	☐Complies ☐Does Not ☐Not Observable ☐Not Applicable	Requirement will be met. **Location on plans/spec:** NO DAYLIGHT ZONES WITH MORE THAN 150W OF LIGHTING IN SCOPE
C405.2.4 [EL26][2]	Separate lighting control devices for specific uses installed per approved lighting plans.	☐Complies ☐Does Not ☐Not Observable ☐Not Applicable	Requirement will be met. **Location on plans/spec:** E2.01, E2.02, E2.03, E2.04, E3.00, E3.01
C405.2.4 [EL27][1]	Additional interior lighting power allowed for special functions per the approved lighting plans and is automatically controlled and separated from general lighting.	☐Complies ☐Does Not ☐Not Observable ☐Not Applicable	Requirement will be met. **Location on plans/spec:** E2.01, E2.02, E2.03, E2.04, E3.00, E3.01
C405.2.5 [EL28][2e]	Manual controls required by the energy code are in a location with ready access to occupants and located where the controlled lights are visible, or identify the area served and their status.	☐Complies ☐Does Not ☐Not Observable ☐Not Applicable	Requirement will be met. **Location on plans/spec:** E2.01, E2.02, E2.03, E2.04, E3.00, E3.01
C405.2.6 [EL30][2e]	Automatic lighting controls for exterior lighting installed. Controls will be daylight controlled, set based on business operation time-of-day, or reduce connected lighting > 30%.	☐Complies ☐Does Not ☐Not Observable ☐Not Applicable	Requirement will be met. **Location on plans/spec:** E2.01
C405.6 [EL26][2]	Low-voltage dry-type distribution electric transformers meet the minimum efficiency requirements of Table C405.6.	☐Complies ☐Does Not ☐Not Observable ☐Not Applicable	Requirement will be met.
C405.7 [EL27][2]	Electric motors meet the minimum efficiency requirements of Tables C405.7(1) through C405.7(4). Efficiency verified through certification under an approved certification program or the equipment efficiency ratings shall be provided by motor manufacturer (where certification programs do not exist).	☐Complies ☐Does Not ☐Not Observable ☐Not Applicable	Requirement will be met.
C405.8.2, C405.8.2.1 [EL28][2]	Escalators and moving walks comply with ASME A17.1/CSA B44 and have automatic controls configured to reduce speed to the minimum permitted speed in accordance with ASME A17.1/CSA B44 or applicable local code when not conveying passengers.	☐Complies ☐Does Not ☐Not Observable ☐Not Applicable	Requirement will be met.
C405.9 [EL29][2]	Total voltage drop across the combination of feeders and branch circuits <= 5%.	☐Complies ☐Does Not ☐Not Observable ☐Not Applicable	**Exception:** Requirement does not apply.

Additional Comments/Assumptions:

1 High Impact (Tier 1) | 2 Medium Impact (Tier 2) | 3 Low Impact (Tier 3)

Section # & Req.ID	Final Inspection	Complies?	Comments/Assumptions
C303.3, C408.2.5.2 [FI17][3]	Furnished O&M instructions for systems and equipment to the building owner or designated representative.	☐Complies ☐Does Not ☐Not Observable ☐Not Applicable	
C405.3.1 [FI18][3]	Interior installed lamp and fixture lighting power is consistent with what is shown on the approved lighting plans, demonstrating proposed watts are less than or equal to allowed watts.	☐Complies ☐Does Not ☐Not Observable ☐Not Applicable	*See the Interior Lighting fixture schedule for values.*
C405.4.1 [FI19][3]	Exterior lighting power is consistent with what is shown on the approved lighting plans, demonstrating proposed watts are less than or equal to allowed watts.	☐Complies ☐Does Not ☐Not Observable ☐Not Applicable	*See the Exterior Lighting fixture schedule for values.*
C408.1.1 [FI57][3]	Building operations and maintenance documents will be provided to the owner. Documents will cover manufacturers' information, specifications, programming procedures and means of illustrating to owner how building, equipment and systems are intended to be installed, maintained, and operated.	☐Complies ☐Does Not ☐Not Observable ☐Not Applicable	Requirement will be met.
C408.2.5.3 [FI16][3]	Furnished as-built drawings for electric power systems within 90 days of system acceptance.	☐Complies ☐Does Not ☐Not Observable ☐Not Applicable	
C408.3 [FI33][3]	Lighting systems have been tested to ensure proper calibration, adjustment, programming, and operation.	☐Complies ☐Does Not ☐Not Observable ☐Not Applicable	

Additional Comments/Assumptions:

1 High Impact (Tier 1) | 2 Medium Impact (Tier 2) | 3 Low Impact (Tier 3)

Autodesk Docs://2024-020 City Hotel/(2024) City Hotel - Elec.rvt
5/20/2026 9:03:30 AM

Ramirez, Johnson, & Associates
3301 Lawrence St. Ste 2
Denver, CO 80205
P: 720.598.0774
HELTSHE
M1A MERIDIAN 105 ARCHITECTURE

CITY HOTEL
415 PERRY STREET, CASTLE ROCK, CO.

DATE: 05.20.2026
PROJ. NO. 2023.002
ISSUED FOR: 1st PERMIT COMMENTS
SHEET TITLE: ELECTRICAL COMCHECK

COLORADO LICENSED
DAMIRA MIR
43565
05/27/2026
PROFESSIONAL ENGINEER

SHEET NUMBER
E0.09

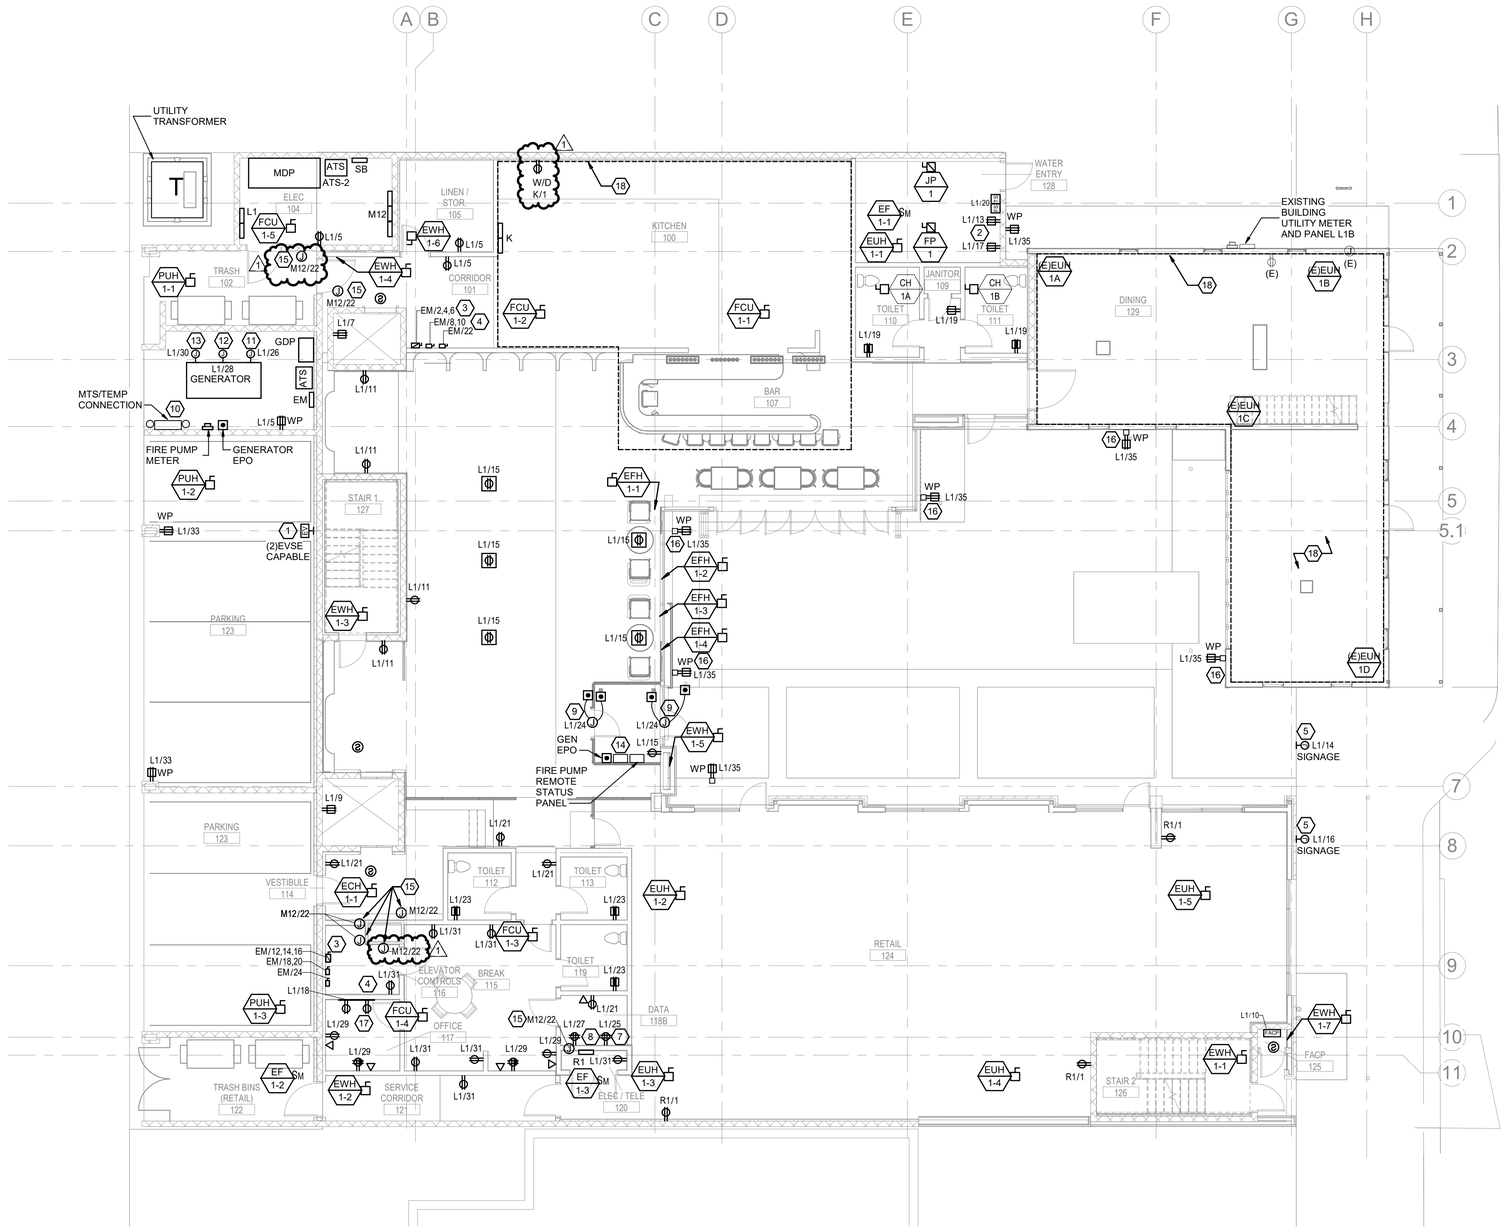

N

1 ELECTRICAL POWER PLAN - LEVEL 1
SCALE: 1/8" = 1'-0"

GENERAL NOTES

1. SEE SHEET E0.00 FOR LEGEND AND ADDITIONAL GENERAL NOTES.
2. MAKE ALL FINAL ELECTRICAL CONNECTIONS TO EQUIPMENT REQUIRING ELECTRICAL CONNECTION. THIS SHALL INCLUDE BUT NOT BE LIMITED TO ALL MECHANICAL AND OTHER EQUIPMENT INCLUDED IN THIS PROJECT.
3. PROVIDE FUSES SIZED PER EQUIPMENT MANUFACTURER'S REQUIREMENTS.
4. DISCONNECT SWITCH LOCATIONS ARE SHOWN DIAGRAMMATICALLY AND SHALL BE INSTALLED IN ACCESSIBLE LOCATION TO SUIT EQUIPMENT AND SPACE. DISCONNECT SWITCHES SHALL BE WITHIN SIGHT OF THE EQUIPMENT THEY SERVE AND MOUNTED AT 6'-3" MAXIMUM, TO TOP OF CABINET. MAINTAIN NEC WORK SPACE AND REQUIREMENTS.
5. RECEPTACLES INDICATED TO BE MOUNTED ABOVE COUNTER ARE TO BE MOUNTED HORIZONTALLY 6" ABOVE COUNTER. COORDINATE MOUNTING HEIGHTS WITH ARCHITECT WHERE ABOVE COUNTER RECEPTACLES ARE LOCATED BELOW WINDOWS.
6. COORDINATE AND VERIFY EXACT MOUNTING LOCATIONS OF WALL AND FLOOR DEVICES WITH ARCHITECTURAL ELEVATIONS, AND ANY FURNITURE OR SPECIALTY EQUIPMENT SUPPLIER DRAWINGS PRIOR TO ROUGH-IN.
7. COORDINATE EXACT REQUIREMENTS AND LOCATIONS OF MECHANICAL EQUIPMENT WITH MECHANICAL DRAWINGS AND MECHANICAL CONTRACTOR PRIOR TO ROUGH-IN.
8. CONTRACTOR RESPONSIBLE FOR CONNECTION OF OWNER SUPPLIED EQUIPMENT MADE TO BE OPERATIONAL.
9. COORDINATE ALL DEVICES SHOWN WITHIN CASEWORK WITH CASEWORK MANUFACTURER. RUN CONDUIT WITHIN CASEWORK AS NECESSARY.
10. REFER TO TELECOM DRAWINGS AND SPECIFICATIONS FOR LOW-VOLTAGE SYSTEMS INFRASTRUCTURE REQUIREMENTS. ELECTRICAL CONTRACTOR SHALL PROVIDE ALL CONDUITS AND BACKBOXES REQUIRED FOR LOW-VOLTAGE SYSTEMS.
11. GFCI PROTECTION IS INDICATED AS REQUIRED. GFCI TRIP SWITCH SHALL BE IN ACCESSIBLE LOCATION, EITHER AT ACCESSIBLE RECEPTACLE, A REMOTE-MOUNTED GFCI SWITCH, OR AT CIRCUIT BREAKER. DO NOT PROVIDE GFCI PROTECTION IN MORE THAN ONE LOCATION.
12. PROVIDE TAMPER-PROOF RECEPTACLES IN ALL SLEEPING UNITS AND PUBLIC AREAS.
13. COORDINATE DEVICE AND FACEPLATE FINISHES FOR ALL DEVICES WITH INTERIOR DRAWINGS AND ARCHITECT PRIOR TO PROCUREMENT.

KEY NOTES (THIS SHEET)

1. ELECTRIC VEHICLE CHARGING CAPABLE SPACE: PROVIDE CONDUIT WITH PULLSTRING. PROVIDE 1-1/2" GRC WITH GRC ELBOW AND NIPPLE WITH COUPLING AND THREADED CAP. SET CONDUIT CAP FLUSH WITH WALL. COORDINATE EXACT LOCATION OF ELECTRIC VEHICLE CHARGING STATION WITH OWNER/ARCHITECT PRIOR TO ROUGH-IN. MARK TERMINATION AS "ELECTRIC VEHICLE CAPABLE SPACE".
2. PROVIDE DEDICATED DUPLEX RECEPTACLES FOR CONNECTION OF IRRIGATION CONTROLLER AND BOOSTER PUMP. VERIFY EXACT REQUIREMENTS WITH MANUFACTURER PRIOR TO ROUGH-IN.
3. PROVIDE 60/3P BUSSMAN ELEVATOR DISCONNECT WITH INTEGRAL SHUNT TRIP. CONFIRM EXACT SIZE AND REQUIREMENTS WITH ELEVATOR SHOP DRAWINGS PRIOR TO PURCHASE.
4. PROVIDE 30A/2P DISCONNECT FOR ELEVATOR CAB LIGHTING AND HVAC AND 20A/1P DISCONNECT FOR ELEVATOR CAMERA.
5. PROVIDE 120V CONNECTION TO EXTERIOR BUILDING SIGNAGE. COORDINATE EXACT LOCATION AND REQUIREMENTS WITH OWNER AND SIGNAGE VENDOR PRIOR TO ROUGH-IN. PROVIDE PHOTOCELL FOR AUTOMATIC ON/OFF CONTROL. PROVIDE LOCKABLE CIRCUIT BREAKER AS DISCONNECTING MEANS.
6. PROVIDE JUNCTION BOX FOR ACCESS CONTROLS. VERIFY EXACT REQUIREMENTS WITH MANUFACTURER/SECURITY DESIGNER. VERIFY EXACT LOCATION WITH OWNER/ARCHITECT PRIOR TO ROUGH-IN.
7. PROVIDE DEDICATED CIRCUIT FOR ACCESS CONTROL HEAD-END EQUIPMENT. COORDINATE EXACT LOCATION AND REQUIREMENTS WITH SECURITY SYSTEM INSTALLER PRIOR TO ROUGH-IN.
8. BUILDING TELECOMM ENTRY. REFER TO DETAIL FOR ADDITIONAL REQUIREMENTS. COORDINATE ADDITIONAL REQUIREMENTS WITH OWNER AND TELECOMM SERVICE PROVIDER(S) PRIOR TO ROUGH-IN.
9. PROVIDE 120V CIRCUIT FOR ADA DOOR OPENER. COORDINATE EXACT REQUIREMENTS WITH MANUFACTURER PRIOR TO ROUGH-IN.
10. GENERATOR MANUAL TRANSFER SWITCH AND TEMPORARY CONNECTION. COORDINATE EXACT REQUIREMENTS PRIOR TO ROUGH-IN. PROVIDE ADEQUATE ROOM FOR TRANSFER SWITCH AND CONDUITS.
11. PROVIDE DEDICATED 120V CIRCUIT FOR GENERATOR JACKET HEATER. COORDINATE EXACT REQUIREMENTS WITH GENERATOR INSTALLER PRIOR TO ROUGH-IN.
12. PROVIDE DEDICATED 120V CIRCUIT FOR GENERATOR STARTER. COORDINATE EXACT REQUIREMENTS WITH GENERATOR INSTALLER PRIOR TO ROUGH-IN.
13. PROVIDE DEDICATED 120V CIRCUIT FOR GENERATOR RECEPTACLE. COORDINATE EXACT REQUIREMENTS WITH GENERATOR INSTALLER PRIOR TO ROUGH-IN.
14. GENERATOR ANNUNCIATOR PANEL. COORDINATE EXACT LOCATION AND REQUIREMENTS WITH GENERATOR MANUFACTURER PRIOR TO ROUGH-IN.
15. PROVIDE 120V CONNECTION TO MOTORIZED OR FIRE/SMOKE DAMPER. COORDINATE EXACT LOCATION AND REQUIREMENTS WITH MECHANICAL DRAWINGS PRIOR TO ROUGH-IN.
16. PROVIDE WEATHER PROOF RECEPTACLE PEDESTAL WITH EXTERIOR RATED DUPLEX RECEPTACLE, LEGRAND XPP1G16-BK, OR AS APPROVED. COORDINATE EXACT LOCATION WITH ARCHITECT PRIOR TO ROUGH-IN.
17. PROVIDE POWER TO WIREMOLD RACEWAY FOR CHARGING TABLE LIGHTS. COORDINATE EXACT LOCATION WITH RCHITECT PRIOR TO ROUGH-IN.
18. THIS AREA TO BE COMPLETED UNDER SEPERATE PERMIT.

Ramirez, Johnson, & Associates
1001 Lawrence St. Ste 7
Denver, CO 80203
P: 720.598.0774
HELTSHE

M1A MERIDIAN 105 ARCHITECTURE

CITY HOTEL
415 PERRY STREET, CASTLE ROCK, CO.

DATE: 05.20.2026	ISSUED FOR: 1st PERMIT COMMENTS	SHEET TITLE: ELECTRICAL POWER PLAN - LEVEL 1	SHEET NUMBER E1.01
PROJ. NO. 2023.002			

COLORADO LICENSED
43565
05/27/2026
PROFESSIONAL ENGINEER

Autodesk Docs://2024-020 City Hotel/(2024) City Hotel - Elec.rvt
5/20/2026 9:03:33 AM

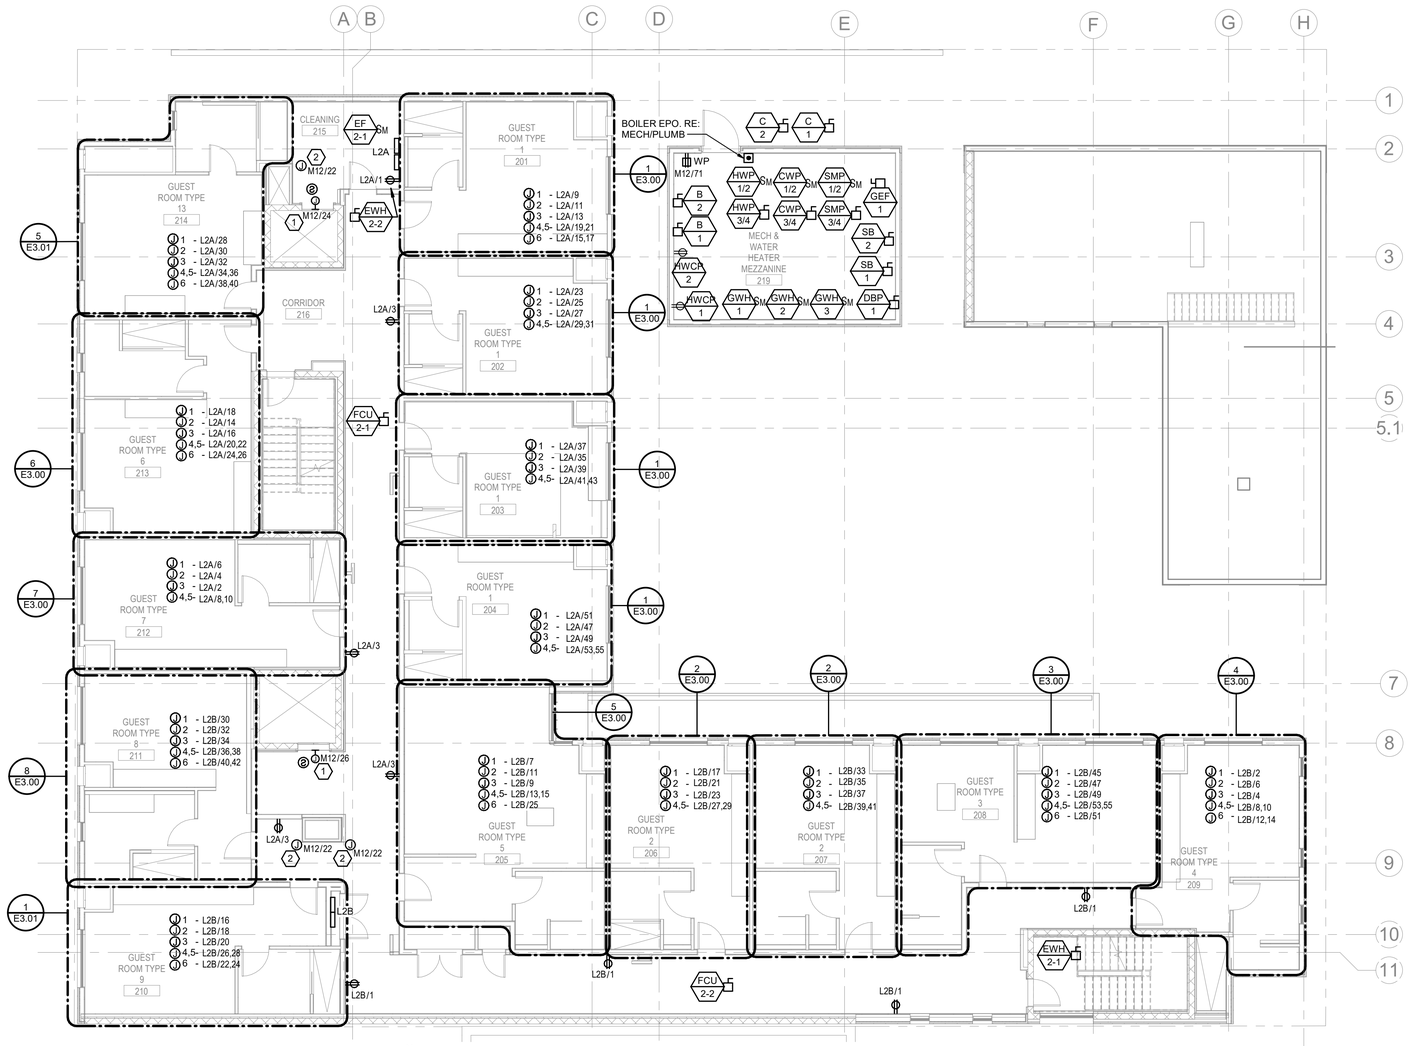

N

1 ELECTRICAL POWER PLAN - LEVEL 2
SCALE: 1/8" = 1'-0"

GENERAL NOTES

1. SEE SHEET E0.00 FOR LEGEND AND ADDITIONAL GENERAL NOTES.
2. MAKE ALL FINAL ELECTRICAL CONNECTIONS TO EQUIPMENT REQUIRING ELECTRICAL CONNECTION. THIS SHALL INCLUDE BUT NOT BE LIMITED TO ALL MECHANICAL AND OTHER EQUIPMENT INCLUDED IN THIS PROJECT.
3. PROVIDE FUSES SIZED PER EQUIPMENT MANUFACTURER'S REQUIREMENTS.
4. DISCONNECT SWITCH LOCATIONS ARE SHOWN DIAGRAMMATICALLY AND SHALL BE INSTALLED IN ACCESSIBLE LOCATION TO SUIT EQUIPMENT AND SPACE. DISCONNECT SWITCHES SHALL BE WITHIN SIGHT OF THE EQUIPMENT THEY SERVE AND MOUNTED AT 6'-3" MAXIMUM, TO TOP OF CABINET. MAINTAIN NEC WORK SPACE AND REQUIREMENTS.
5. RECEPTACLES INDICATED TO BE MOUNTED ABOVE COUNTER ARE TO BE MOUNTED HORIZONTALLY 6" ABOVE COUNTER. COORDINATE MOUNTING HEIGHTS WITH ARCHITECT WHERE ABOVE COUNTER RECEPTACLES ARE LOCATED BELOW WINDOWS.
6. COORDINATE AND VERIFY EXACT MOUNTING LOCATIONS OF WALL AND FLOOR DEVICES WITH ARCHITECTURAL ELEVATIONS, AND ANY FURNITURE OR SPECIALTY EQUIPMENT SUPPLIER DRAWINGS PRIOR TO ROUGH-IN.
7. COORDINATE EXACT REQUIREMENTS AND LOCATIONS OF MECHANICAL EQUIPMENT WITH MECHANICAL DRAWINGS AND MECHANICAL CONTRACTOR PRIOR TO ROUGH-IN.
8. CONTRACTOR RESPONSIBLE FOR CONNECTION OF OWNER SUPPLIED EQUIPMENT MADE TO BE OPERATIONAL.
9. COORDINATE ALL DEVICES SHOWN WITHIN CASEWORK WITH CASEWORK MANUFACTURER. RUN CONDUIT WITHIN CASEWORK AS NECESSARY.
10. REFER TO TELECOM DRAWINGS AND SPECIFICATIONS FOR LOW-VOLTAGE SYSTEMS INFRASTRUCTURE REQUIREMENTS. ELECTRICAL CONTRACTOR SHALL PROVIDE ALL CONDUITS AND BACKBOXES REQUIRED FOR LOW-VOLTAGE SYSTEMS.
11. GFCI PROTECTION IS INDICATED AS REQUIRED. GFCI TRIP SWITCH SHALL BE IN ACCESSIBLE LOCATION, EITHER AT ACCESSIBLE RECEPTACLE, A REMOTE-MOUNTED GFCI SWITCH, OR AT CIRCUIT BREAKER. DO NOT PROVIDE GFCI PROTECTION IN MORE THAN ONE LOCATION.
12. PROVIDE TAMPER-PROOF RECEPTACLES IN ALL SLEEPING UNITS AND PUBLIC AREAS.
13. JUNCTION BOXES AND ADJACENT NUMBER DESIGNATIONS WITHIN GUEST ROOMS INDICATE WHICH DEVICES IN GUEST ROOMS ARE TO BE CIRCUITED TO BRANCH CIRCUIT PANELS. SEE GUEST ROOM ENLARGED PLANS FOR CIRCUIT NUMBERS ADJACENT TO DEVICES FOR CIRCUITING.
14. COORDINATE DEVICE AND FACEPLATE FINISHES FOR ALL DEVICES WITH INTERIOR DRAWINGS AND ARCHITECT PRIOR TO PROCUREMENT.

KEY NOTES (THIS SHEET)

1. PROVIDE 120V CONNECTION TO SMOKE CURTAIN OUTSIDE OF ELEVATOR SHAFT. COORDINATE EXACT REQUIREMENTS WITH MANUFACTURER AND LOCATION WITH ARCHITECTURAL DRAWINGS PRIOR TO ROUGH-IN.
2. PROVIDE 120V CONNECTION TO MOTORIZED OR FIRE/SMOKE DAMPER. COORDINATE EXACT LOCATION AND REQUIREMENTS WITH MECHANICAL DRAWINGS PRIOR TO ROUGH-IN.

Ramirez, Johnson, & Associates
3301 Lawrence St. Ste 2
Denver, CO 80205
P: 720.598.5774
HELTSHE

M1A MERIDIAN 105 ARCHITECTURE

CITY HOTEL
415 PERRY STREET, CASTLE ROCK, CO.

DATE: 05.20.2026
PROJ. NO. 2023.002
ISSUED FOR: 1st PERMIT COMMENTS
SHEET TITLE: ELECTRICAL POWER PLAN - LEVEL 2

COLORADO LICENSED
DANIEL RAMIREZ
43565
05/27/2026
PROFESSIONAL ENGINEER

SHEET NUMBER
E1.02

Autodesk Docs://2024-020 City Hotel\(2024) City Hotel - Elec.rvt
5/20/2026 9:03:36 AM

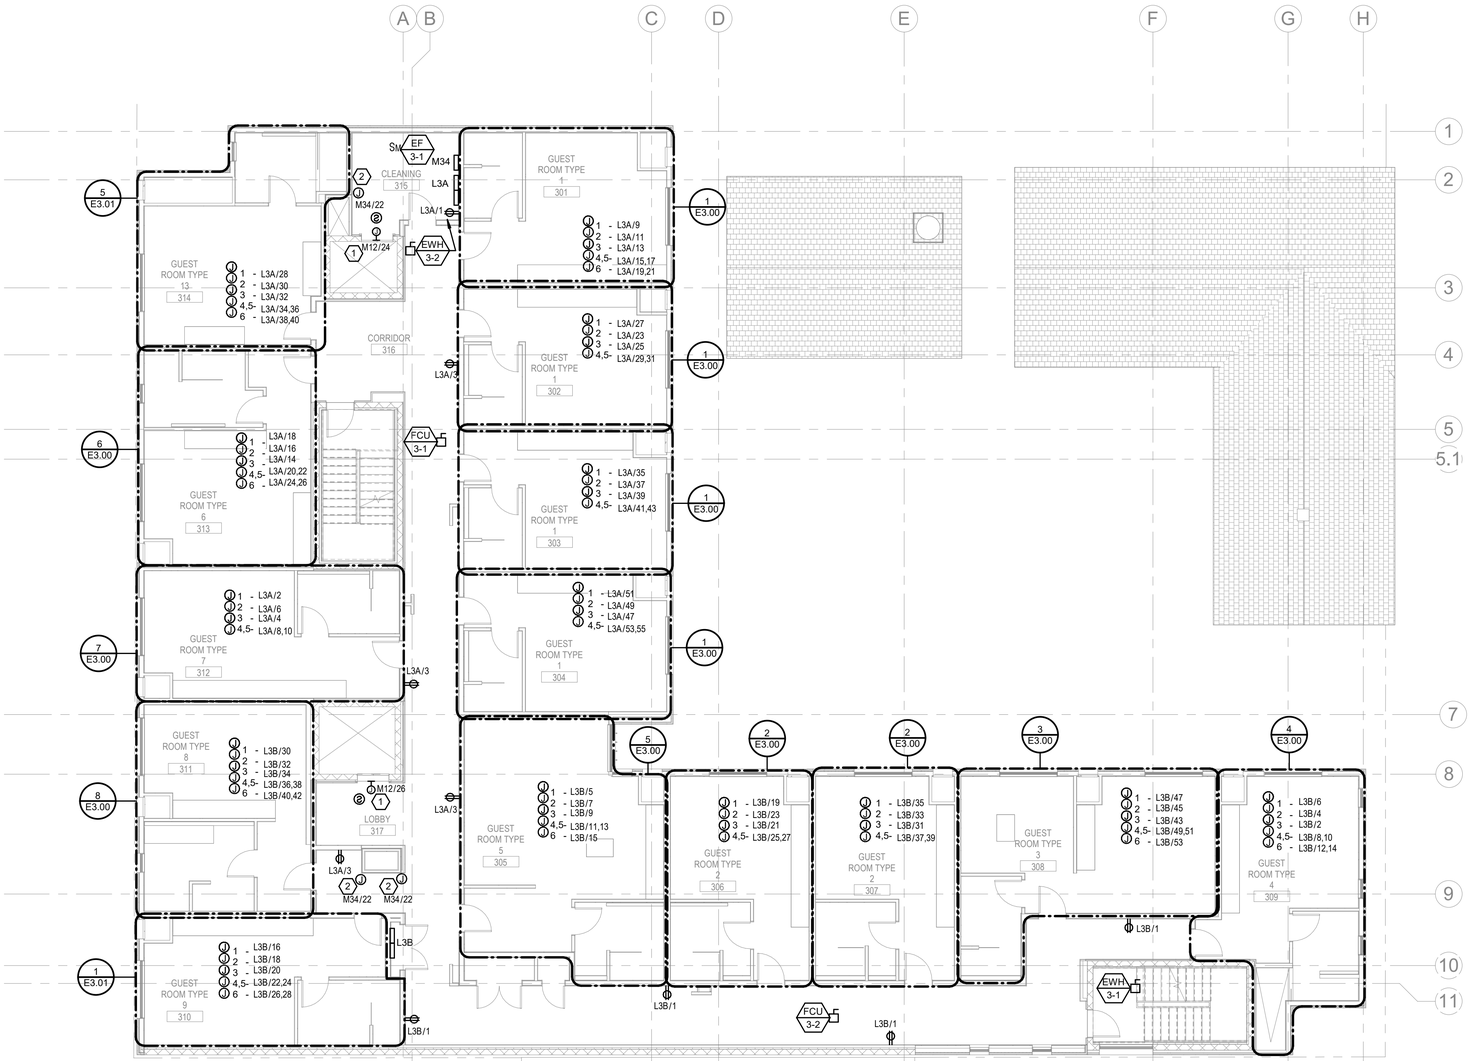

1 ELECTRICAL POWER PLAN - LEVEL 3
SCALE: 1/8" = 1'-0"

GENERAL NOTES

1. SEE SHEET E0.00 FOR LEGEND AND ADDITIONAL GENERAL NOTES.
2. MAKE ALL FINAL ELECTRICAL CONNECTIONS TO EQUIPMENT REQUIRING ELECTRICAL CONNECTION. THIS SHALL INCLUDE BUT NOT BE LIMITED TO ALL MECHANICAL AND OTHER EQUIPMENT INCLUDED IN THIS PROJECT.
3. PROVIDE FUSES SIZED PER EQUIPMENT MANUFACTURER'S REQUIREMENTS.
4. DISCONNECT SWITCH LOCATIONS ARE SHOWN DIAGRAMMATICALLY AND SHALL BE INSTALLED IN ACCESSIBLE LOCATION TO SUIT EQUIPMENT AND SPACE. DISCONNECT SWITCHES SHALL BE WITHIN SIGHT OF THE EQUIPMENT THEY SERVE AND MOUNTED AT 6'-3" MAXIMUM, TO TOP OF CABINET. MAINTAIN NEC WORK SPACE AND REQUIREMENTS.
5. RECEPTACLES INDICATED TO BE MOUNTED ABOVE COUNTER ARE TO BE MOUNTED HORIZONTALLY 6" ABOVE COUNTER. COORDINATE MOUNTING HEIGHTS WITH ARCHITECT WHERE ABOVE COUNTER RECEPTACLES ARE LOCATED BELOW WINDOWS.
6. COORDINATE AND VERIFY EXACT MOUNTING LOCATIONS OF WALL AND FLOOR DEVICES WITH ARCHITECTURAL ELEVATIONS, AND ANY FURNITURE OR SPECIALTY EQUIPMENT SUPPLIER DRAWINGS PRIOR TO ROUGH-IN.
7. COORDINATE EXACT REQUIREMENTS AND LOCATIONS OF MECHANICAL EQUIPMENT WITH MECHANICAL DRAWINGS AND MECHANICAL CONTRACTOR PRIOR TO ROUGH-IN.
8. CONTRACTOR RESPONSIBLE FOR CONNECTION OF OWNER SUPPLIED EQUIPMENT MADE TO BE OPERATIONAL.
9. COORDINATE ALL DEVICES SHOWN WITHIN CASEWORK WITH CASEWORK MANUFACTURER. RUN CONDUIT WITHIN CASEWORK AS NECESSARY.
10. REFER TO TELECOM DRAWINGS AND SPECIFICATIONS FOR LOW-VOLTAGE SYSTEMS INFRASTRUCTURE REQUIREMENTS. ELECTRICAL CONTRACTOR SHALL PROVIDE ALL CONDUITS AND BACKBOXES REQUIRED FOR LOW-VOLTAGE SYSTEMS.
11. GFCI PROTECTION IS INDICATED AS REQUIRED. GFCI TRIP SWITCH SHALL BE IN ACCESSIBLE LOCATION, EITHER AT ACCESSIBLE RECEPTACLE, A REMOTE-MOUNTED GFCI SWITCH, OR AT CIRCUIT BREAKER. DO NOT PROVIDE GFCI PROTECTION IN MORE THAN ONE LOCATION.
12. PROVIDE TAMPER-PROOF RECEPTACLES IN ALL SLEEPING UNITS AND PUBLIC AREAS.
13. JUNCTION BOXES AND ADJACENT NUMBER DESIGNATIONS WITHIN GUEST ROOMS INDICATE WHICH DEVICES IN GUEST ROOMS ARE TO BE CIRCUITED TO BRANCH CIRCUIT PANELS. SEE GUEST ROOM ENLARGED PLANS FOR CIRCUIT NUMBERS ADJACENT TO DEVICES FOR CIRCUITING.
14. COORDINATE DEVICE AND FACEPLATE FINISHES FOR ALL DEVICES WITH INTERIOR DRAWINGS AND ARCHITECT PRIOR TO PROCUREMENT.

KEY NOTES (THIS SHEET)

1. PROVIDE 120V CONNECTION TO SMOKE CURTAIN OUTSIDE OF ELEVATOR SHAFT. COORDINATE EXACT REQUIREMENTS WITH MANUFACTURER AND LOCATION WITH ARCHITECTURAL DRAWINGS PRIOR TO ROUGH-IN.
2. PROVIDE 120V CONNECTION TO MOTORIZED OR FIRE/SMOKE DAMPER. COORDINATE EXACT LOCATION AND REQUIREMENTS WITH MECHANICAL DRAWINGS PRIOR TO ROUGH-IN.

Ramirez, Johnson, & Associates
3301 Lawrence St. Ste 2
Denver, CO 80205
P: 720.548.5774
HELTSHE
M1A MERIDIAN 105 ARCHITECTURE

CITY HOTEL
415 PERRY STREET, CASTLE ROCK, CO.

DATE: 05.20.2026	ISSUED FOR: 1st PERMIT COMMENTS	SHEET TITLE: ELECTRICAL POWER PLAN - LEVEL 3	SHEET NUMBER E1.03
PROJ. NO. 2023.002			

COLORADO LICENSED DAMIAN RAMIREZ 43565 05/27/2026 PROFESSIONAL ENGINEER

Autodesk Docs://2024-020 City Hotel/(2024) City Hotel - Elec.rvt
5/20/2026 9:03:37 AM

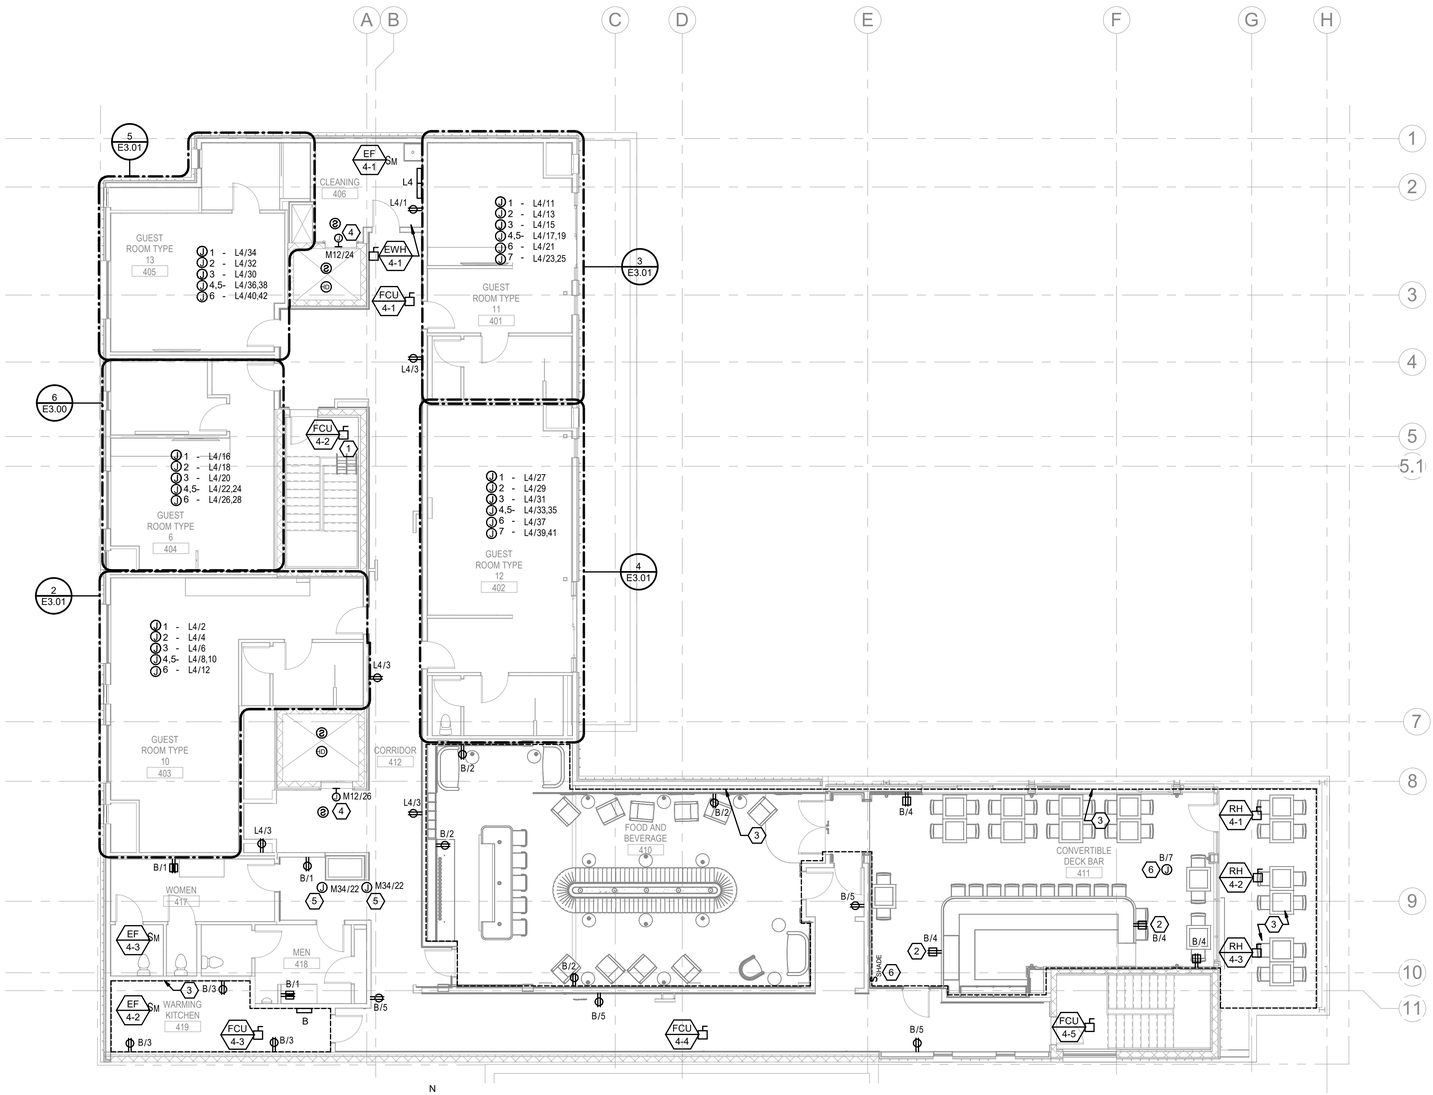

1 ELECTRICAL POWER PLAN - LEVEL 4
SCALE: 1/8" = 1'-0"

GENERAL NOTES

1. SEE SHEET E0.00 FOR LEGEND AND ADDITIONAL GENERAL NOTES.
2. MAKE ALL FINAL ELECTRICAL CONNECTIONS TO EQUIPMENT REQUIRING ELECTRICAL CONNECTION. THIS SHALL INCLUDE BUT NOT BE LIMITED TO ALL MECHANICAL AND OTHER EQUIPMENT INCLUDED IN THIS PROJECT.
3. PROVIDE FUSES SIZED PER EQUIPMENT MANUFACTURER'S REQUIREMENTS.
4. DISCONNECT SWITCH LOCATIONS ARE SHOWN DIAGRAMMATICALLY AND SHALL BE INSTALLED IN ACCESSIBLE LOCATION TO SUIT EQUIPMENT AND SPACE. DISCONNECT SWITCHES SHALL BE WITHIN SIGHT OF THE EQUIPMENT THEY SERVE AND MOUNTED AT 6'-3" MAXIMUM, TO TOP OF CABINET. MAINTAIN NEC WORK SPACE AND REQUIREMENTS.
5. RECEPTACLES INDICATED TO BE MOUNTED ABOVE COUNTER ARE TO BE MOUNTED HORIZONTALLY 6" ABOVE COUNTER. COORDINATE MOUNTING HEIGHTS WITH ARCHITECT WHERE ABOVE COUNTER RECEPTACLES ARE LOCATED BELOW WINDOWS.
6. COORDINATE AND VERIFY EXACT MOUNTING LOCATIONS OF WALL AND FLOOR DEVICES WITH ARCHITECTURAL ELEVATIONS, AND ANY FURNITURE OR SPECIALTY EQUIPMENT SUPPLIER DRAWINGS PRIOR TO ROUGH-IN.
7. COORDINATE EXACT REQUIREMENTS AND LOCATIONS OF MECHANICAL EQUIPMENT WITH MECHANICAL DRAWINGS AND MECHANICAL CONTRACTOR PRIOR TO ROUGH-IN.
8. CONTRACTOR RESPONSIBLE FOR CONNECTION OF OWNER SUPPLIED EQUIPMENT MADE TO BE OPERATIONAL.
9. COORDINATE ALL DEVICES SHOWN WITHIN CASEWORK WITH CASEWORK MANUFACTURER. RUN CONDUIT WITHIN CASEWORK AS NECESSARY.
10. REFER TO TELECOM DRAWINGS AND SPECIFICATIONS FOR LOW-VOLTAGE SYSTEMS INFRASTRUCTURE REQUIREMENTS. ELECTRICAL CONTRACTOR SHALL PROVIDE ALL CONDUITS AND BACKBOXES REQUIRED FOR LOW-VOLTAGE SYSTEMS.
11. GFCI PROTECTION IS INDICATED AS REQUIRED. GFCI TRIP SWITCH SHALL BE IN ACCESSIBLE LOCATION, EITHER AT ACCESSIBLE RECEPTACLE, A REMOTE-MOUNTED GFCI SWITCH, OR AT CIRCUIT BREAKER. DO NOT PROVIDE GFCI PROTECTION IN MORE THAN ONE LOCATION.
12. PROVIDE TAMPER-PROOF RECEPTACLES IN ALL SLEEPING UNITS AND PUBLIC AREAS.
13. JUNCTION BOXES AND ADJACENT NUMBER DESIGNATIONS WITHIN GUEST ROOMS INDICATE WHICH DEVICES IN GUEST ROOMS ARE TO BE CIRCUITED TO BRANCH CIRCUIT PANELS. SEE GUEST ROOM ENLARGED PLANS FOR CIRCUIT NUMBERS ADJACENT TO DEVICES FOR CIRCUITING.
14. COORDINATE DEVICE AND FACEPLATE FINISHES FOR ALL DEVICES WITH INTERIOR DRAWINGS AND ARCHITECT PRIOR TO PROCUREMENT.

KEY NOTES (THIS SHEET)

1. INSTALL DUPLEX RECEPTACLE AT THE ATTIC HATCH. COORDINATE EXACT LOCATION WITH OWNER PRIOR TO INSTALLATION.
2. PROVIDE USB-A AND C RECEPTACLE WITH DEEP BACK BOX FOR THE BAR SEATING AREA. COORDINATE MOUNTING HEIGHT WITH OWNER AND FINISH OF THE RECEPTACLE AND FACEPLATE WITH MILLWORKER PRIOR TO ROUGH-IN. MOUNT 6 INCHES BELOW BAR TOP.
3. THIS AREA TO BE COMPLETED UNDER SEPERATE PERMIT.
4. PROVIDE 120V CONNECTION TO SMOKE CURTAIN OUTSIDE OF ELEVATOR SHAFT. COORDINATE EXACT REQUIREMENTS WITH MANUFACTURER AND LOCATION WITH ARCHITECTURAL DRAWINGS PRIOR TO ROUGH-IN.
5. PROVIDE 120V CONNECTION TO MOTORIZED OR FIRE/SMOKE DAMPER. COORDINATE EXACT LOCATION AND REQUIREMENTS WITH MECHANICAL DRAWINGS PRIOR TO ROUGH-IN.
6. PROVIDE 120V CONNECTION AND CONTROLS FOR MOTORIZED SHADE. COORDINATE REQUIREMENTS WITH MANUFACTURER. COORDINATE EXACT LOCATION FOR CONTROLS WITH OWNER AND ARCHITECT PRIOR TO ROUGH-IN.

Ramirez, Johnson, & Associates
5301 Lawrence St. Ste 2
Denver, CO 80216
ph 720.598.5774
HELTSHE
M1A MERIDIAN 105 ARCHITECTURE

CITY HOTEL
415 PERRY STREET, CASTLE ROCK, CO.

DATE: 05.20.2026
PROJ. NO. 2023.002
ISSUED FOR: 1st PERMIT COMMENTS
SHEET TITLE: ELECTRICAL POWER PLAN - LEVEL 4

COLORADO LICENSED
GABRIELA MIER
43565
05/27/2026
PROFESSIONAL ENGINEER

SHEET NUMBER
E1.04

Autodesk Docs://2024-020 City Hotel/(2024) City Hotel - Elec.rvt
5/20/2026 9:03:39 AM

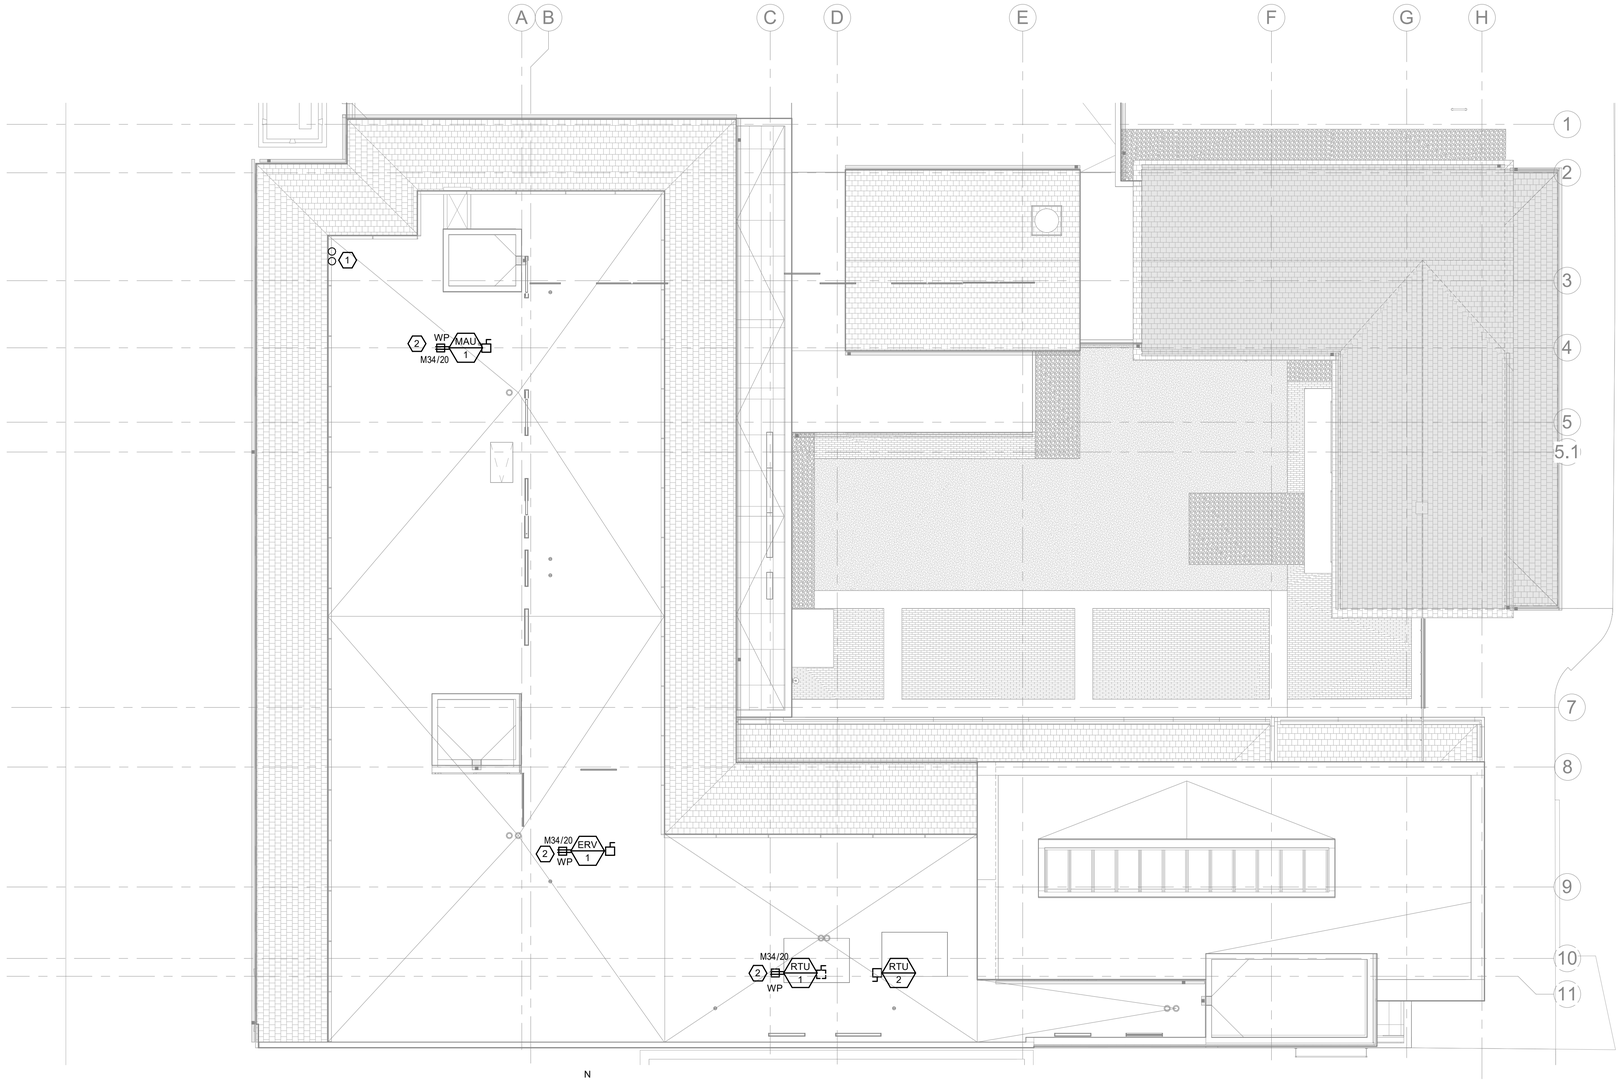

N

1 ELECTRICAL POWER PLAN - ROOF
SCALE: 1/8" = 1'-0"

GENERAL NOTES

1. SEE SHEET E0.00 FOR LEGEND AND ADDITIONAL GENERAL NOTES.
2. MAKE ALL FINAL ELECTRICAL CONNECTIONS TO EQUIPMENT REQUIRING ELECTRICAL CONNECTION. THIS SHALL INCLUDE BUT NOT BE LIMITED TO ALL MECHANICAL AND OTHER EQUIPMENT INCLUDED IN THIS PROJECT.
3. PROVIDE FUSES SIZED PER EQUIPMENT MANUFACTURER'S REQUIREMENTS.
4. DISCONNECT SWITCH LOCATIONS ARE SHOWN DIAGRAMMATICALLY AND SHALL BE INSTALLED IN ACCESSIBLE LOCATION TO SUIT EQUIPMENT AND SPACE. DISCONNECT SWITCHES SHALL BE WITHIN SIGHT OF THE EQUIPMENT THEY SERVE AND MOUNTED AT 6'-3" MAXIMUM, TO TOP OF CABINET. MAINTAIN NEC WORK SPACE AND REQUIREMENTS.
5. RECEPTACLES INDICATED TO BE MOUNTED ABOVE COUNTER ARE TO BE MOUNTED HORIZONTALLY 6" ABOVE COUNTER. COORDINATE MOUNTING HEIGHTS WITH ARCHITECT WHERE ABOVE COUNTER RECEPTACLES ARE LOCATED BELOW WINDOWS.
6. COORDINATE AND VERIFY EXACT MOUNTING LOCATIONS OF WALL AND FLOOR DEVICES WITH ARCHITECTURAL ELEVATIONS, AND ANY FURNITURE OR SPECIALTY EQUIPMENT SUPPLIER DRAWINGS PRIOR TO ROUGH-IN.
7. COORDINATE EXACT REQUIREMENTS AND LOCATIONS OF MECHANICAL EQUIPMENT WITH MECHANICAL DRAWINGS AND MECHANICAL CONTRACTOR PRIOR TO ROUGH-IN.
8. CONTRACTOR RESPONSIBLE FOR CONNECTION OF OWNER SUPPLIED EQUIPMENT MADE TO BE OPERATIONAL.
9. COORDINATE ALL DEVICES SHOWN WITHIN CASEWORK WITH CASEWORK MANUFACTURER. RUN CONDUIT WITHIN CASEWORK AS NECESSARY.
10. REFER TO TELECOM DRAWINGS AND SPECIFICATIONS FOR LOW-VOLTAGE SYSTEMS INFRASTRUCTURE REQUIREMENTS. ELECTRICAL CONTRACTOR SHALL PROVIDE ALL CONDUITS AND BACKBOXES REQUIRED FOR LOW-VOLTAGE SYSTEMS.
11. GFCI PROTECTION IS INDICATED AS REQUIRED. GFCI TRIP SWITCH SHALL BE IN ACCESSIBLE LOCATION, EITHER AT ACCESSIBLE RECEPTACLE, A REMOTE-MOUNTED GFCI SWITCH, OR AT CIRCUIT BREAKER. DO NOT PROVIDE GFCI PROTECTION IN MORE THAN ONE LOCATION.
12. PROVIDE TAMPER-PROOF RECEPTACLES IN ALL SLEEPING UNITS AND PUBLIC AREAS.
13. JUNCTION BOXES AND ADJACENT NUMBER DESIGNATIONS WITHIN GUEST ROOMS INDICATE WHICH DEVICES IN GUEST ROOMS ARE TO BE CIRCUITED TO BRANCH CIRCUIT PANELS. SEE GUEST ROOM ENLARGED PLANS FOR CIRCUIT NUMBERS ADJACENT TO DEVICES FOR CIRCUITING.
14. COORDINATE DEVICE AND FACEPLATE FINISHES FOR ALL DEVICES WITH INTERIOR DRAWINGS AND ARCHITECT PRIOR TO PROCUREMENT.

KEY NOTES (THIS SHEET)

1. PROVIDE CONDUIT FROM MDP TO SOLAR ARRAY. COORDINATE EXACT LOCATION WITH SOLAR CONTRACTOR PRIOR TO ANY ROUGH-IN. SEE ONE-LINE DIAGRAM FOR CONDUIT SIZING.
2. PROVIDE WEATHERPROOF SERVICE RECEPTACLE WITHIN 25' OF ALL MECHANICAL EQUIPMENT PER NEC 210.63.

Ramirez, Johnson, & Associates
1001 Lawrence St. Ste 2
Denver, CO 80205
P: 720.598.0774
HELTSHE
M1A MERIDIAN 105 ARCHITECTURE

CITY HOTEL
415 PERRY STREET, CASTLE ROCK, CO.

DATE: 05.20.2026	ISSUED FOR: 1st PERMIT COMMENTS	SHEET TITLE: ELECTRICAL POWER PLAN - ROOF LEVEL	SHEET NUMBER E1.05
PROJ. NO. 2023.002			

COLORADO LICENSED
SANDRA MIRZA
43565
05/27/2026
PROFESSIONAL ENGINEER

Autodesk Docs://2024-020 City Hotel/(2024) City Hotel - Elec.rvt
5/20/2026 9:03:42 AM

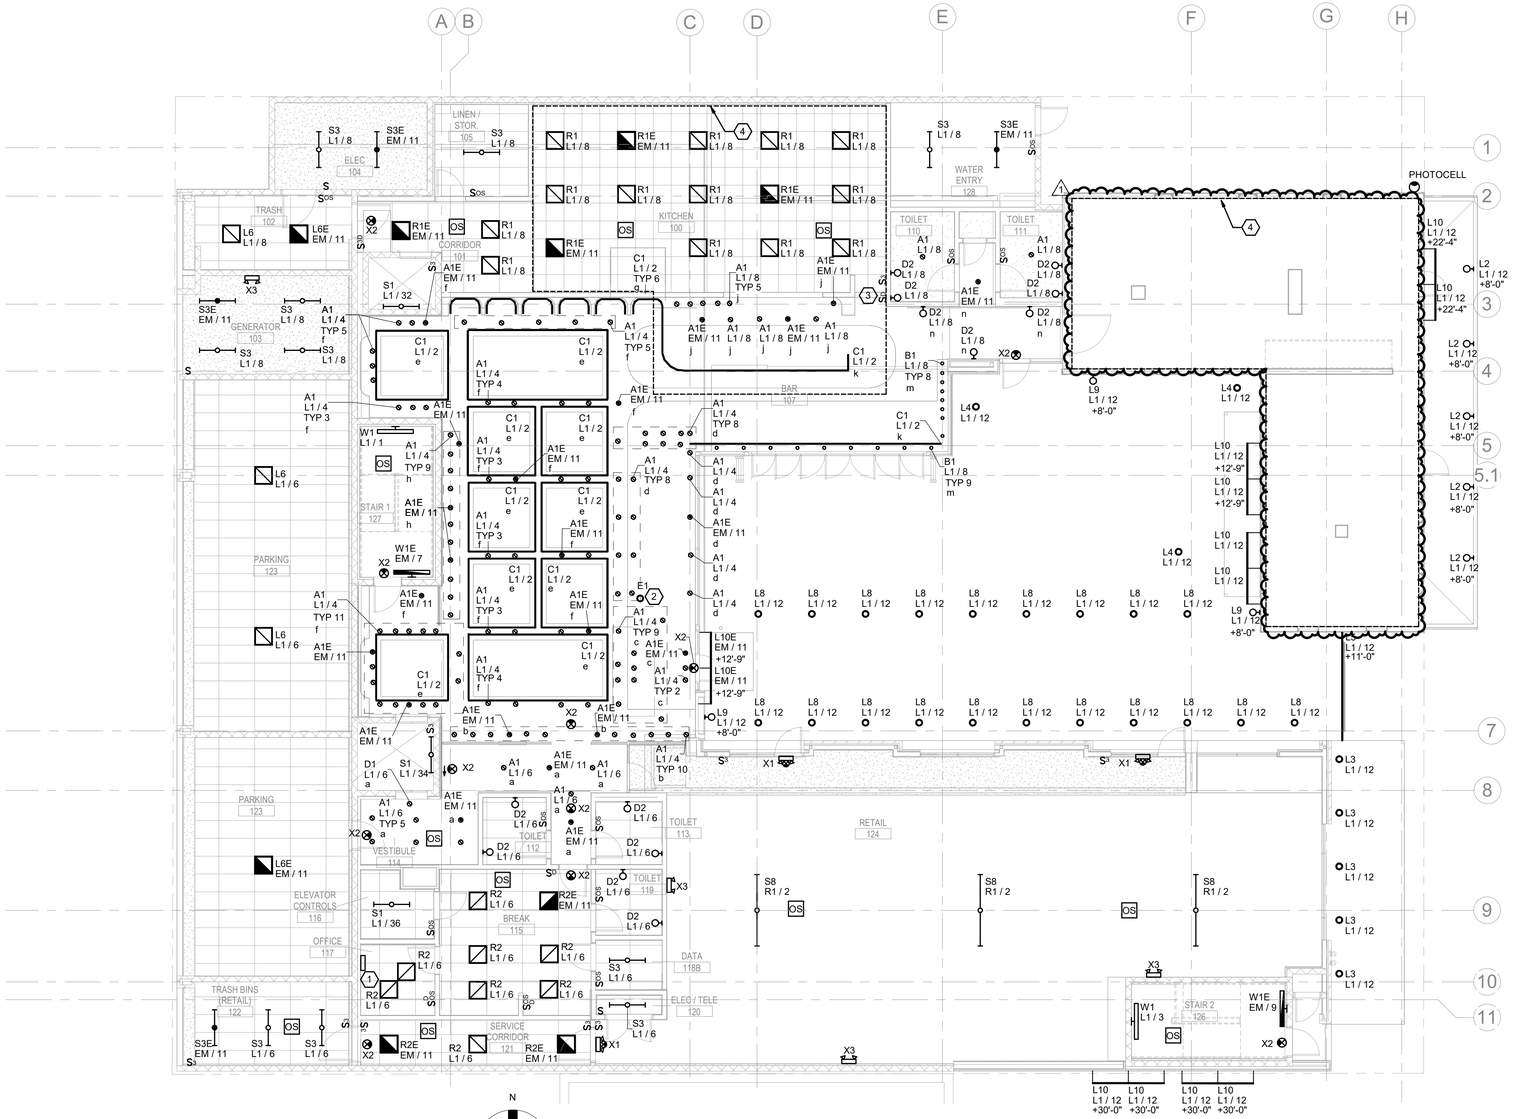

GENERAL NOTES

1. SEE SHEET E0.00 FOR LEGEND AND ADDITIONAL GENERAL NOTES.
2. CONFIRM MOUNTING HEIGHT AND LOCATION OF ALL LUMINAIRES AND DEVICES WITH ARCHITECT PRIOR TO ROUGH-IN. REFER TO ARCHITECTURAL ELEVATIONS AND REFLECTED CEILING PLANS.
3. CONNECT ALL EXIT SIGNS AHEAD OF LOCAL SWITCHING.
4. ALL CEILING MOUNTED OCCUPANCY SENSORS AND VACANCY SENSORS SHALL BE DUAL TECHNOLOGY TYPE.
5. COORDINATE LUMINAIRE LOCATIONS WITH MECHANICAL PIPING, DUCTWORK, ETC. TO AVOID CONFLICTS. SEE SPECIFICATIONS FOR COORDINATION REQUIREMENTS.
6. FIELD COORDINATE EXACT LOCATIONS OF CEILING MOUNTED OCCUPANCY SENSORS AND VACANCY SENSORS PER MANUFACTURER'S INSTRUCTIONS. THE LOCATIONS OF THE SENSORS ON DRAWINGS ARE DIAGRAMMATIC. DO NOT LOCATE OCCUPANCY SENSORS WITHIN THREE FEET OF AN HVAC SUPPLY DEVICE. IF ADDITIONAL SENSORS ARE NEEDED FOR COMPLETE COVERAGE OF SPACE THEY SHALL BE PROVIDED AND INSTALLED BY THE CONTRACTOR AS REQUIRED TO PROVIDE COMPLETE SPACE COVERAGE.
7. CONTRACTOR SHALL PROVIDE ALL NECESSARY SWITCH PACKS FOR OCCUPANCY SENSORS TO PROVIDE FUNCTION INDICATED.
8. ALL EXIT SIGNS SHALL BE CIRCUITED TO LIGHTING CIRCUIT SERVING OTHER LUMINAIRES IN THE SAME SPACE AS THE EXIT SIGNS.
9. LOSS OF UTILITY POWER SHALL ENERGIZE ALL EGRESS LIGHTING. THE DESIGN SHALL MEET ALL UL STANDARDS FOR LIFE SAFETY REQUIREMENTS.
10. VACANCY/OCCUPANCY SENSORS SHALL BE SET AT A MAXIMUM 15 MINUTE TIMEOUT.
11. CONTRACTOR SHALL VERIFY DIMMER SWITCHES ORDERED ARE COMPATIBLE WITH THE LUMINAIRES THEY CONTROL.

KEY NOTES (THIS SHEET)

1. PROVIDE LIGHTING CONTROL PANEL WITH TIMECLOCK AND DIMMING CAPABILITY TO CONTROL ALL PUBLIC AREA AND EXTERIOR LIGHTING.
2. RECHARGABLE LIGHT FIXTURE. REFER TO ARCHITECTURAL DRAWINGS FOR LAYOUT AND QUANTITY.
3. PROVIDE WALL MOUNTED SCENE CONTROLLER WITH DIMMING AND CAPABILITY AND 10 ZONE CONTROL FOR CONTROL OF LUMINAIRES IN LOBBY AND BAR AREA. ZONES b,c,d,e,f,g,k,m, and n. COORDINATE SPECIFICATION AND REQUIREMENTS WITH LIGHTING CONTROLS SUPPLIER.
4. THIS AREA TO BE COMPLETED UNDER SEPERATE PERMIT.

LIGHTING CONTROLS NOTES (ALL SHEETS)

1. ALL LIGHTING CONTROLS TO COMPLY WITH IECC 2018 AND LOCAL CODES.
2. BASIS OF DESIGN IS WATT STOPPER.
3. MANUFACTURER TO PROVIDE SHOP DRAWINGS INDICATING ALL LIGHTING DEVICES, ZONING, ETC. FOR REVIEW BY ENGINEER AND OWNER.
4. OCCUPANCY SENSOR CONTROL SHALL BE PROVIDED IN ALL ENCLOSED OFFICES, RESTROOMS, STORAGE ROOMS AND ANY ENCLOSED SPACES 300SF OR LESS.
5. ALL REGULARLY OCCUPIED SPACES TO HAVE DIMMING CONTROL, 0-10V PROTOCOL, UON.
6. PROVIDE LIGHTING CONTROL PANEL WITH DIMMING CAPABILITIES TO CONTROL INTERIOR LIGHTING IN CORRIDORS, LOBBIES, AND EXTERIOR LIGHTING.
7. LIGHTING IN LOBBIES, AND PUBLIC SPACES TO BE CONTROLLED VIA LIGHTING CONTROL PANEL WITH LOW-VOLTAGE SWITCHES FOR MANUAL 2-HOUR OVERRIDE AND DIMMING CAPABILITY. PROGRAM TO AUTOMATIC ON/OFF CORRESPONDING TO OFFICE HOURS.
8. LIGHTING IN PRIVATE OFFICES AND ANY SMALLER, REGULARLY OCCUPIED ROOMS SHALL BE CONTROLLED VIA WALL-SWITCH OCCUPANCY SENSOR WITH DIMMING CAPABILITY. PROGRAM TO MANUAL-ON, 15-MINUTE AUTO-OFF.
9. LIGHTING IN RESTROOMS SHALL BE CONTROLLED VIA PIR WALL SWITCH OCCUPANCY SENSOR SWITCH. PROGRAM TO MANUAL-ON, 20-MINUTE AUTO-OFF. PROVIDE MINIMAL UNSWITCHED NIGHTLIGHTS AS INDICATED.
10. CORRIDOR LIGHTS TO BE CONTROLLED BY CEILING MOUNTED OCCUPANCY SENSORS.

Autodesk Docs://2024-020 City Hotel/(2024) City Hotel - Elec.rvt
5/20/2026 9:03:43 AM

Ramirez, Johnson, & Associates
1801 Lawrence St. Ste C
Denver, CO 80205
P: 720.598.0774
HELTSHE
M1A MERIDIAN 105 ARCHITECTURE

CITY HOTEL
415 PERRY STREET, CASTLE ROCK, CO.

DATE: 05.20.2026	ISSUED FOR: 1st PERMIT COMMENTS	SHEET TITLE: ELECTRICAL LIGHTING PLAN - LEVEL 1	SHEET NUMBER E2.01
PROJ. NO. 2023.002			

COLORADO LICENSED
OMAR A MIRZA
43565
05/27/2026
PROFESSIONAL ENGINEER

GENERAL NOTES

1. SEE SHEET E0.00 FOR LEGEND AND ADDITIONAL GENERAL NOTES.
2. CONFIRM MOUNTING HEIGHT AND LOCATION OF ALL LUMINAIRES AND DEVICES WITH ARCHITECT PRIOR TO ROUGH-IN. REFER TO ARCHITECTURAL ELEVATIONS AND REFLECTED CEILING PLANS.
3. CONNECT ALL EXIT SIGNS AHEAD OF LOCAL SWITCHING.
4. ALL CEILING MOUNTED OCCUPANCY SENSORS AND VACANCY SENSORS SHALL BE DUAL TECHNOLOGY TYPE.
5. COORDINATE LUMINAIRE LOCATIONS WITH MECHANICAL PIPING, DUCTWORK, ETC. TO AVOID CONFLICTS. SEE SPECIFICATIONS FOR COORDINATION REQUIREMENTS.
6. FIELD COORDINATE EXACT LOCATIONS OF CEILING MOUNTED OCCUPANCY SENSORS AND VACANCY SENSORS PER MANUFACTURER'S INSTRUCTIONS. THE LOCATIONS OF THE SENSORS ON DRAWINGS ARE DIAGRAMMATIC. DO NOT LOCATE OCCUPANCY SENSORS WITHIN THREE FEET OF AN HVAC SUPPLY DEVICE. IF ADDITIONAL SENSORS ARE NEEDED FOR COMPLETE COVERAGE OF SPACE THEY SHALL BE PROVIDED AND INSTALLED BY THE CONTRACTOR AS REQUIRED TO PROVIDE COMPLETE SPACE COVERAGE.
7. CONTRACTOR SHALL PROVIDE ALL NECESSARY SWITCH PACKS FOR OCCUPANCY SENSORS TO PROVIDE FUNCTION INDICATED.
8. ALL EXIT SIGNS SHALL BE CIRCUITED TO LIGHTING CIRCUIT SERVING OTHER LUMINAIRES IN THE SAME SPACE AS THE EXIT SIGNS.
9. LOSS OF UTILITY POWER SHALL ENERGIZE ALL EGRESS LIGHTING. THE DESIGN SHALL MEET ALL UL STANDARDS FOR LIFE SAFETY REQUIREMENTS.
10. VACANCY/OCCUPANCY SENSORS SHALL BE SET AT A MAXIMUM 15 MINUTE TIMEOUT.
11. CONTRACTOR SHALL VERIFY DIMMER SWITCHES ORDERED ARE COMPATIBLE WITH THE LUMINAIRES THEY CONTROL.

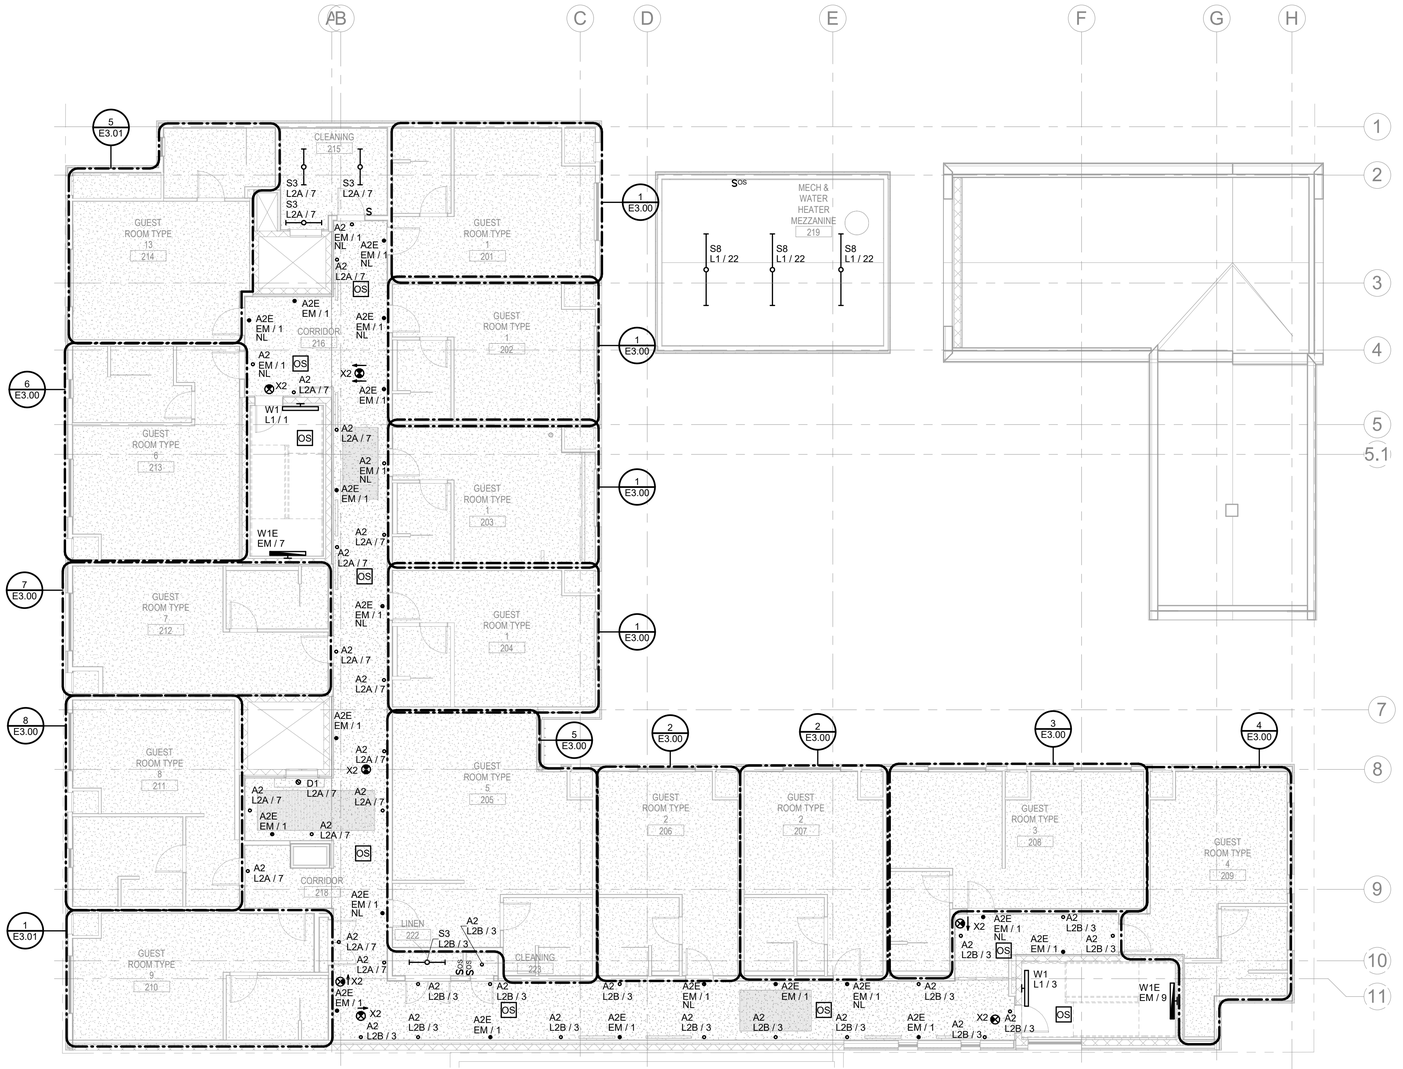

1 ELECTRICAL LIGHTING PLAN - LEVEL 2
SCALE: 1/8" = 1'-0"

Ramirez, Johnson, & Associates
3301 Lawrence St. Ste 2
Denver, CO 80205
P: 720.668.0774
HELTSHE

M1A MERIDIAN 105 ARCHITECTURE

CITY HOTEL
415 PERRY STREET, CASTLE ROCK, CO.

DATE: 05.20.2026	ISSUED FOR: 1st PERMIT COMMENTS	SHEET TITLE: ELECTRICAL LIGHTING PLAN - LEVEL 2	
PROJ. NO. 2023.002			

COLORADO LICENSED
DAMIAN A MIREZ
43565
05/27/2026
PROFESSIONAL ENGINEER

SHEET NUMBER
E2.02

Autodesk Docs://2024-020 City Hotel/(2024) City Hotel - Elec.rvt
5/20/2026 9:03:45 AM

GENERAL NOTES

1. SEE SHEET E0.00 FOR LEGEND AND ADDITIONAL GENERAL NOTES.
2. CONFIRM MOUNTING HEIGHT AND LOCATION OF ALL LUMINAIRES AND DEVICES WITH ARCHITECT PRIOR TO ROUGH-IN. REFER TO ARCHITECTURAL ELEVATIONS AND REFLECTED CEILING PLANS.
3. CONNECT ALL EXIT SIGNS AHEAD OF LOCAL SWITCHING.
4. ALL CEILING MOUNTED OCCUPANCY SENSORS AND VACANCY SENSORS SHALL BE DUAL TECHNOLOGY TYPE.
5. COORDINATE LUMINAIRE LOCATIONS WITH MECHANICAL PIPING, DUCTWORK, ETC. TO AVOID CONFLICTS. SEE SPECIFICATIONS FOR COORDINATION REQUIREMENTS.
6. FIELD COORDINATE EXACT LOCATIONS OF CEILING MOUNTED OCCUPANCY SENSORS AND VACANCY SENSORS PER MANUFACTURER'S INSTRUCTIONS. THE LOCATIONS OF THE SENSORS ON DRAWINGS ARE DIAGRAMMATIC. DO NOT LOCATE OCCUPANCY SENSORS WITHIN THREE FEET OF AN HVAC SUPPLY DEVICE. IF ADDITIONAL SENSORS ARE NEEDED FOR COMPLETE COVERAGE OF SPACE THEY SHALL BE PROVIDED AND INSTALLED BY THE CONTRACTOR AS REQUIRED TO PROVIDE COMPLETE SPACE COVERAGE.
7. CONTRACTOR SHALL PROVIDE ALL NECESSARY SWITCH PACKS FOR OCCUPANCY SENSORS TO PROVIDE FUNCTION INDICATED.
8. ALL EXIT SIGNS SHALL BE CIRCUITED TO LIGHTING CIRCUIT SERVING OTHER LUMINAIRES IN THE SAME SPACE AS THE EXIT SIGNS.
9. LOSS OF UTILITY POWER SHALL ENERGIZE ALL EGRESS LIGHTING. THE DESIGN SHALL MEET ALL UL STANDARDS FOR LIFE SAFETY REQUIREMENTS.
10. VACANCY/OCCUPANCY SENSORS SHALL BE SET AT A MAXIMUM 15 MINUTE TIMEOUT.
11. CONTRACTOR SHALL VERIFY DIMMER SWITCHES ORDERED ARE COMPATIBLE WITH THE LUMINAIRES THEY CONTROL.

N

1 ELECTRICAL LIGHTING PLAN - LEVEL 3
SCALE: 1/8" = 1'-0"

Ramirez, Johnson, & Associates
5301 Lawrence St. Ste 2
Denver, CO 80216
P: 720.549.0714

HELTSHE

M1A | MERIDIAN 105 ARCHITECTURE

CITY HOTEL
415 PERRY STREET, CASTLE ROCK, CO.

DATE: 05.20.2026	ISSUED FOR: 1st PERMIT COMMENTS	SHEET TITLE: ELECTRICAL LIGHTING PLAN - LEVEL 3	SHEET NUMBER E2.03
PROJ. NO. 2023.002			

COLORADO LICENSED
DAMIAN RAMIREZ
43565
05/27/2026
PROFESSIONAL ENGINEER

Autodesk Docs://2024-020 City Hotel/(2024) City Hotel - Elec.rvt
5/20/2026 9:03:47 AM

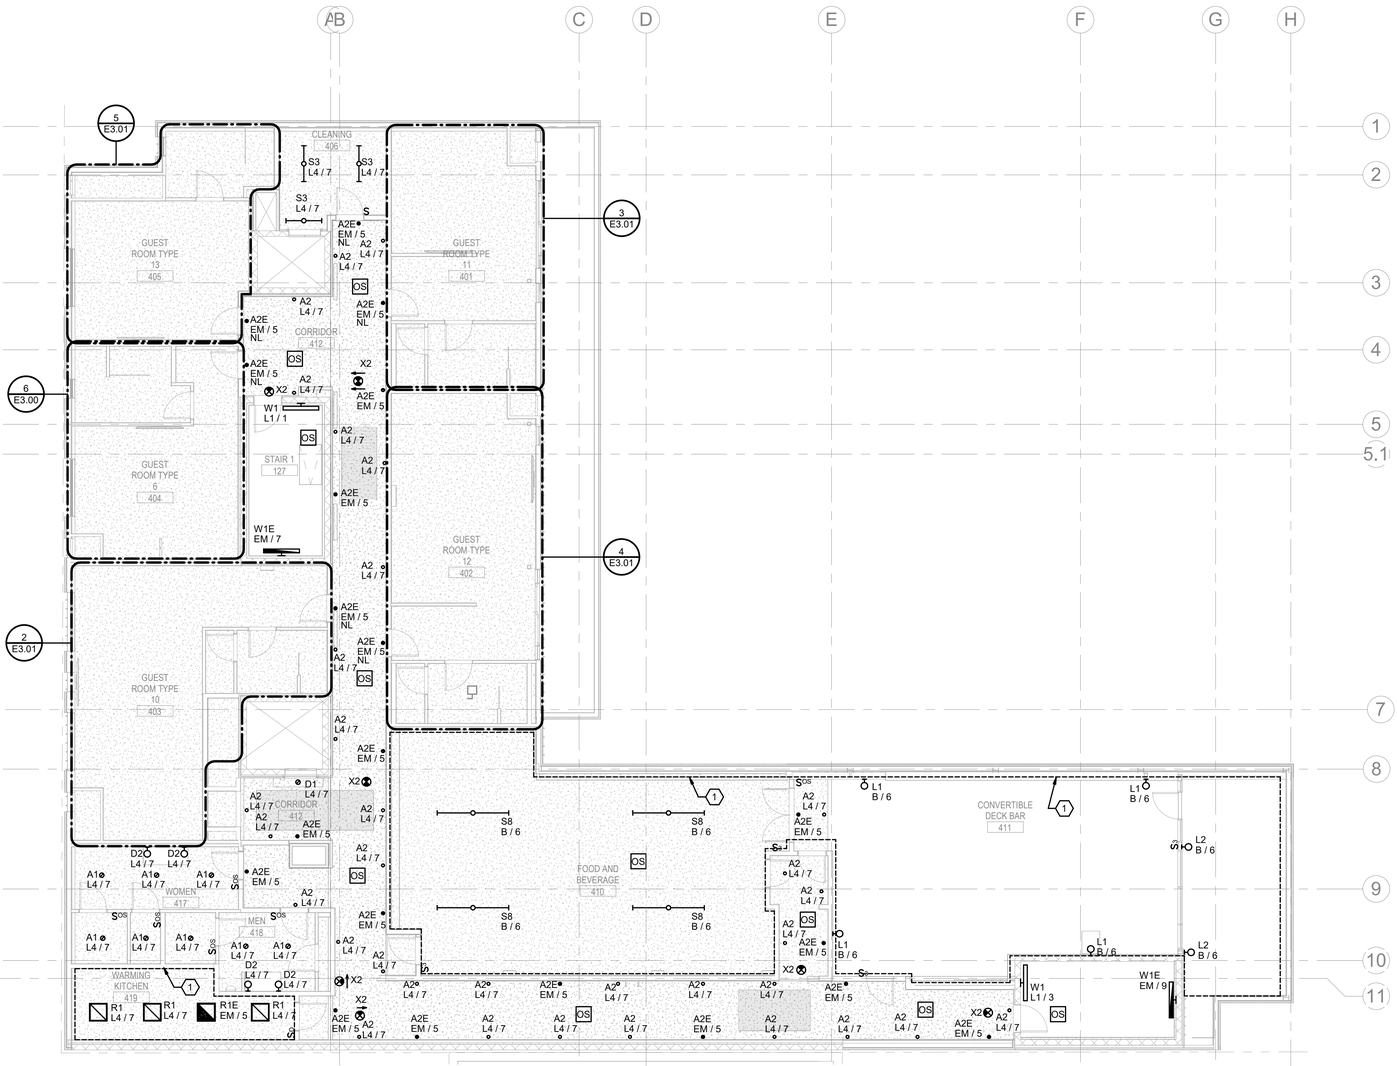

N

1 ELECTRICAL LIGHTING PLAN - LEVEL 4
SCALE: 1/8" = 1'-0"

GENERAL NOTES

1. SEE SHEET E0.00 FOR LEGEND AND ADDITIONAL GENERAL NOTES.
2. CONFIRM MOUNTING HEIGHT AND LOCATION OF ALL LUMINAIRES AND DEVICES WITH ARCHITECT PRIOR TO ROUGH-IN. REFER TO ARCHITECTURAL ELEVATIONS AND REFLECTED CEILING PLANS.
3. CONNECT ALL EXIT SIGNS AHEAD OF LOCAL SWITCHING.
4. ALL CEILING MOUNTED OCCUPANCY SENSORS AND VACANCY SENSORS SHALL BE DUAL TECHNOLOGY TYPE.
5. COORDINATE LUMINAIRE LOCATIONS WITH MECHANICAL PIPING, DUCTWORK, ETC. TO AVOID CONFLICTS. SEE SPECIFICATIONS FOR COORDINATION REQUIREMENTS.
6. FIELD COORDINATE EXACT LOCATIONS OF CEILING MOUNTED OCCUPANCY SENSORS AND VACANCY SENSORS PER MANUFACTURER'S INSTRUCTIONS. THE LOCATIONS OF THE SENSORS ON DRAWINGS ARE DIAGRAMMATIC. DO NOT LOCATE OCCUPANCY SENSORS WITHIN THREE FEET OF AN HVAC SUPPLY DEVICE. IF ADDITIONAL SENSORS ARE NEEDED FOR COMPLETE COVERAGE OF SPACE THEY SHALL BE PROVIDED AND INSTALLED BY THE CONTRACTOR AS REQUIRED TO PROVIDE COMPLETE SPACE COVERAGE.
7. CONTRACTOR SHALL PROVIDE ALL NECESSARY SWITCH PACKS FOR OCCUPANCY SENSORS TO PROVIDE FUNCTION INDICATED.
8. ALL EXIT SIGNS SHALL BE CIRCUITED TO LIGHTING CIRCUIT SERVING OTHER LUMINAIRES IN THE SAME SPACE AS THE EXIT SIGNS.
9. LOSS OF UTILITY POWER SHALL ENERGIZE ALL EGRESS LIGHTING. THE DESIGN SHALL MEET ALL UL STANDARDS FOR LIFE SAFETY REQUIREMENTS.
10. VACANCY/OCCUPANCY SENSORS SHALL BE SET AT A MAXIMUM 15 MINUTE TIMEOUT.
11. CONTRACTOR SHALL VERIFY DIMMER SWITCHES ORDERED ARE COMPATIBLE WITH THE LUMINAIRES THEY CONTROL.

KEY NOTES (THIS SHEET)

1. THIS AREA TO BE COMPLETED UNDER SEPERATE PERMIT.

Ramirez, Johnson, & Associates
3301 Lawrence St. Ste 2
Denver, CO 80205
P: 720.548.5714

HELTSHE

M1A MERIDIAN 105 ARCHITECTURE

CITY HOTEL
415 PERRY STREET, CASTLE ROCK, CO.

DATE: 05.20.2026	ISSUED FOR: 1st PERMIT COMMENTS	SHEET TITLE: ELECTRICAL LIGHTING PLAN - LEVEL 4	SHEET NUMBER E2.04
PROJ. NO. 2023.002			

COLORADO LICENSED
DAMIAN RAMIREZ
43565
05/27/2026
PROFESSIONAL ENGINEER

Autodesk Docs://2024-020 City Hotel\(2024) City Hotel - Elec.rvt
5/20/2026 9:03:50 AM

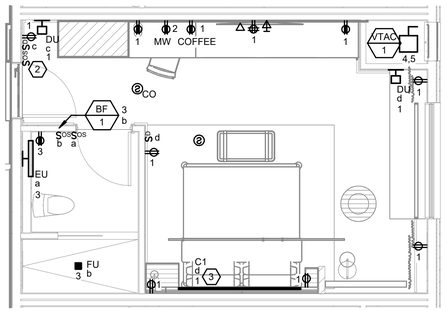

1 ELECTRICAL ENLARGED GUEST ROOM TYPE 1
SCALE: 1/4" = 1'-0"

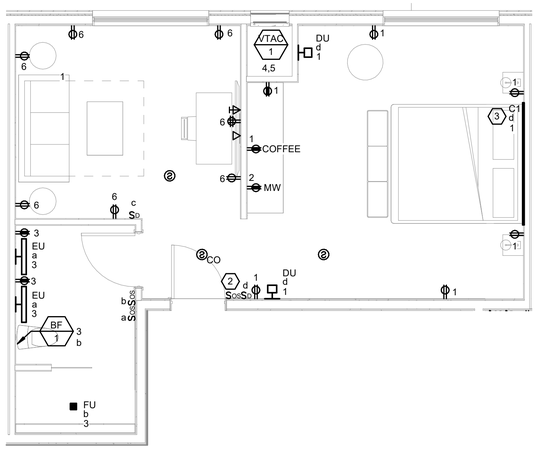

3 ELECTRICAL ENLARGED GUEST ROOM TYPE 3
SCALE: 1/4" = 1'-0"

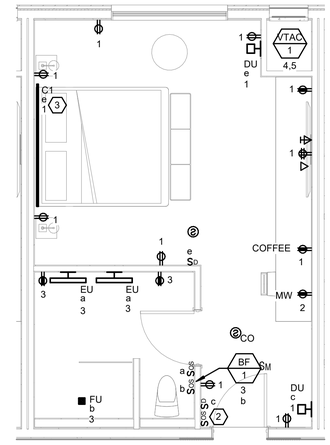

2 ELECTRICAL ENLARGED GUEST ROOM TYPE 2
SCALE: 1/4" = 1'-0"

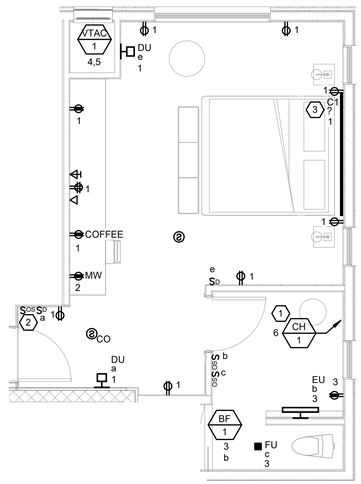

4 ELECTRICAL ENLARGED GUEST ROOM TYPE 4
SCALE: 1/4" = 1'-0"

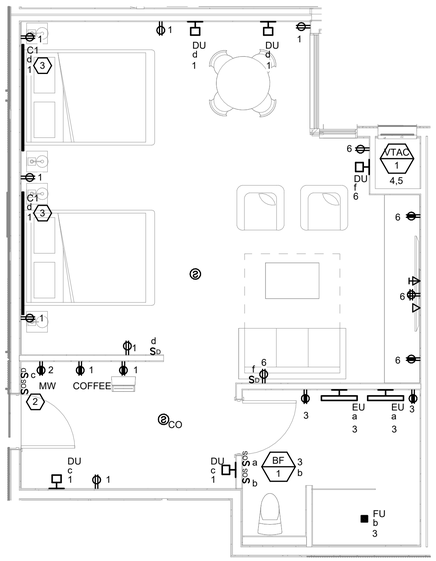

5 ELECTRICAL ENLARGED GUEST ROOM TYPE 5
SCALE: 1/4" = 1'-0"

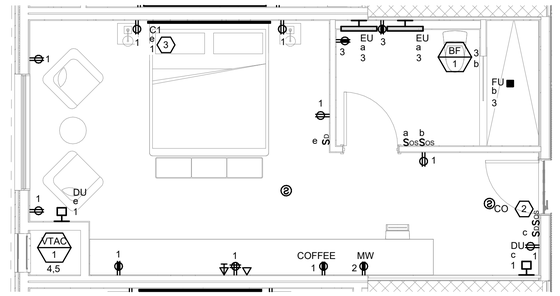

7 ELECTRICAL ENLARGED GUEST ROOM TYPE 7
SCALE: 1/4" = 1'-0"

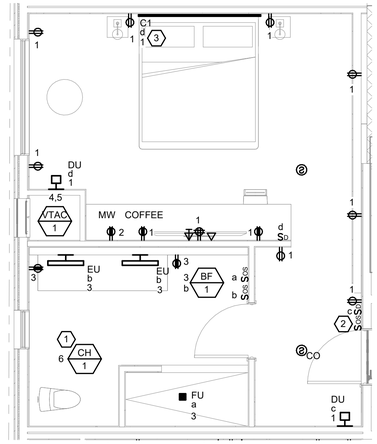

8 ELECTRICAL ENLARGED GUEST ROOM TYPE 8
SCALE: 1/4" = 1'-0"

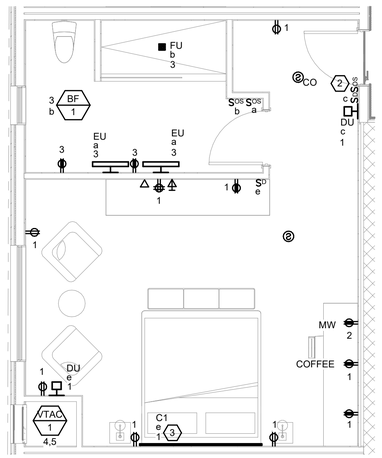

6 ELECTRICAL ENLARGED GUEST ROOM TYPE 6
SCALE: 1/4" = 1'-0"

GENERAL NOTES

1. SEE SHEET E0.0 FOR LEGEND AND ADDITIONAL GENERAL NOTES.
2. TELEPHONE WALL OUTLET SHALL BE MOUNTED AT 46" AFF TO THE CENTERLINE OF THE DEVICE UNO. JACKS AND CABLE TO BE PROVIDED AND INSTALLED BY TELECOMMUNICATIONS DESIGN/BUILD CONTRACTOR.
3. INSTALL TELEVISION RECEPTACLE AND COAXIAL OUTLET AT 60" AFF. COORDINATE EXACT LOCATION WITH ARCHITECT. JACKS AND CABLE TO BE PROVIDED AND INSTALLED BY TELECOMMUNICATIONS DESIGN/BUILD CONTRACTOR.
4. CONTRACTOR MEANS AND METHODS UTILIZED TO INSTALL WIRING DEVICES WITHIN 1-HOUR RATED WALLS, SUCH HAS STAGGERED SPACING OF BACK-TO-BACK DEVICES AND/OR USE OF FIRE RATED PUTTY PADS, SHALL MAINTAIN WALL RATING.
5. PROVIDE ELECTRICAL CONNECTION TO DWELLING UNIT CONDENSING UNITS LOCATED ON BUILDING ROOFTOP. RE: BUILDING ROOF PLAN FOR CONDENSING UNIT LOCATIONS AND MECHANICAL EQUIPMENT SCHEDULE FOR WIRING REQUIREMENTS.
6. COORDINATE LOCATION AND MOUNTING HEIGHTS OF ELECTRICAL DEVICES IN MILLWORK WITH ARCHITECT/OWNER PRIOR TO ROUGH-IN.
7. CONFIRM MOUNTING HEIGHT AND LOCATION OF ALL LUMINAIRES AND DEVICES WITH ARCHITECT PRIOR TO ROUGH IN.
8. COORDINATE EXACT ELECTRICAL REQUIREMENTS AND LOCATIONS OF MECHANICAL AND PLUMBING EQUIPMENT WITH MECHANICAL AND PLUMBING CONTRACTOR PRIOR TO ROUGH-IN.
9. RECEPTACLES INDICATED TO BE MOUNTED ABOVE COUNTER SHALL BE MOUNTED HORIZONTALLY 6" ABOVE COUNTER TO THE CENTERLINE OF THE DEVICE UNO.
10. COUNTERTOP RECEPTACLES SHALL BE INSTALLED AT 6" ABOVE THE BACK SPLASH TO THE CENTERLINE OF THE DEVICE UNO.
11. ALL RECEPTACLES WITHIN 6' OF A SINK SHALL BE GFCI.
12. GFCI PROTECTION IS INDICATED AS REQUIRED. GFCI TRIP SWITCH SHALL BE IN ACCESSIBLE LOCATION, EITHER AT ACCESSIBLE RECEPTACLE, A REMOTE-MOUNTEDGFCI SWITCH, OR AT CIRCUIT BREAKER. DO NOT PROVIDE GFCI PROTECTION IN TWO LOCATIONS.
13. ALL 120V RECEPTACLES TO BE TAMPER-PROOF.
14. WHERE BOTH AFCI AND GFCI PROTECTION ARE REQUIRED, PROVIDE PROTECTION AT CIRCUIT BREAKER. DO NOT PROVIDE PROTECTION IN MORE THAN ONE LOCATION. REFER TO LOAD CENTER SCHEDULE(S) FOR FURTHER INFORMATION.
15. NUMBERS ADJACENT TO DEVICES ON ELECTRICAL ENLARGED GUEST ROOM PLANS INDICATE CIRCUITING. SEE ELECTRICAL POWER PLANS FOR BRANCH PANEL CIRCUITING.

KEYNOTES (THIS SHEET)

1. CH-1 COVE HEATERS LOCATED IN GUESTROOMS WITH RESTROOMS ON EXTERIOR WALL(S). COORDINATE EXACT LOCATION AND REQUIREMENTS WITH MECHANICAL DRAWINGS.
2. PROVIDE MASTER CONTROL SWITCH AT ENTRY WITH OCCUPANCY SENSORS LOCATED WHERE NECESSARY IN EACH ROOM/SPACE CAPABLE OF AUTOMATICALLY SWITCHING OFF ALL LUMINAIRES INSTALLED WITHIN HOTEL ROOM WITHIN 20 MINUTES OF OCCUPANTS LEAVING THE ROOM AS REQUIRED BY IECC C405.2.4.
3. MOUNT TAPELIGHT AT HEADBOARD. COORDINATE MOUNTING AND TAPELIGHT LENGTH WITH ARCHITECT.

Ramirez, Johnson, & Associates
3301 Lawrence St. Ste 2
Denver, CO 80205
P: 720.548.5774

HELTSHE

M1A | MERIDIAN 105 ARCHITECTURE

CITY HOTEL
415 PERRY STREET, CASTLE ROCK, CO.

DATE: 05.20.2026	ISSUED FOR: 1st PERMIT COMMENTS	SHEET TITLE: ELECTRICAL ENLARGED UNIT PLANS	SHEET NUMBER E3.00
PROJ. NO. 2023.002			

COLORADO LICENSED DAMIAN RAMIREZ 43565 05/27/2026 PROFESSIONAL ENGINEER

Autodesk Docs://2024-020 City Hotel/(2024) City Hotel - Elec.rvt
5/20/2026 9:03:53 AM

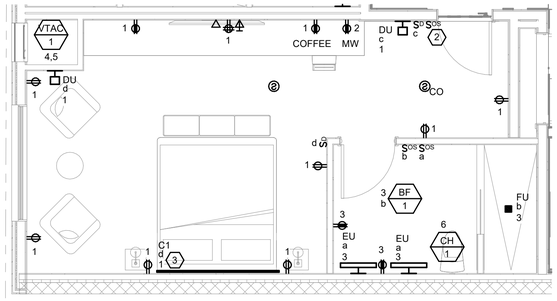

1 ELECTRICAL ENLARGED GUEST ROOM TYPE 9

SCALE: 1/4" = 1'-0"

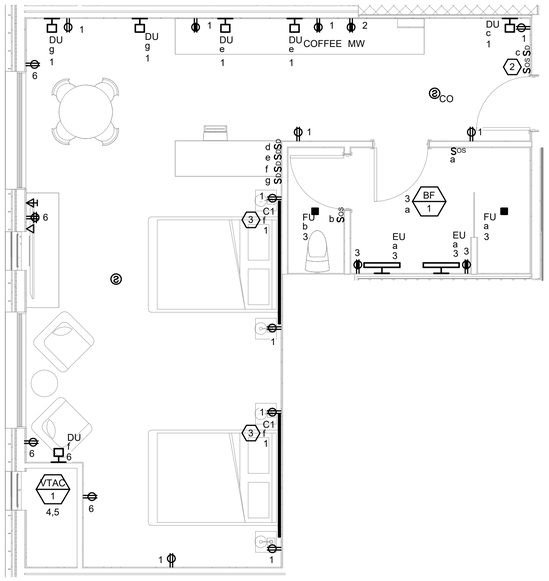

2 ELECTRICAL ENLARGED GUEST ROOM TYPE 10

SCALE: 1/4" = 1'-0"

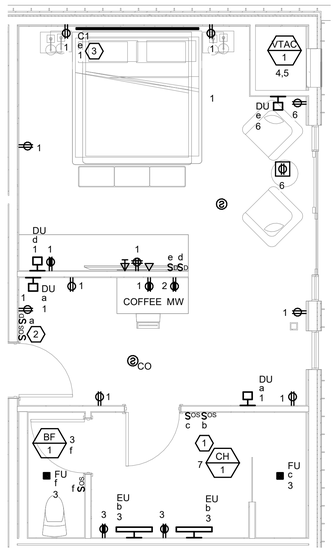

3 ELECTRICAL ENLARGED GUEST ROOM TYPE 11

SCALE: 1/4" = 1'-0"

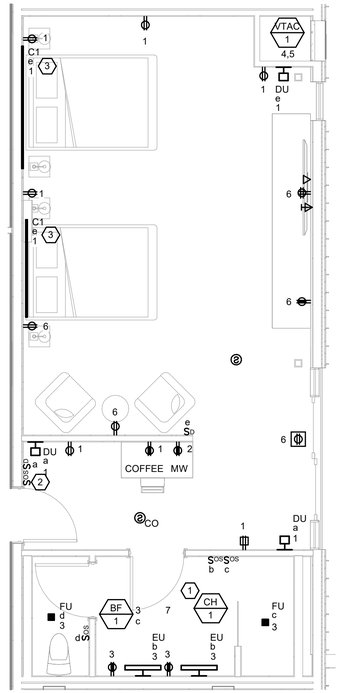

4 ELECTRICAL ENLARGED GUEST ROOM TYPE 12

SCALE: 1/4" = 1'-0"

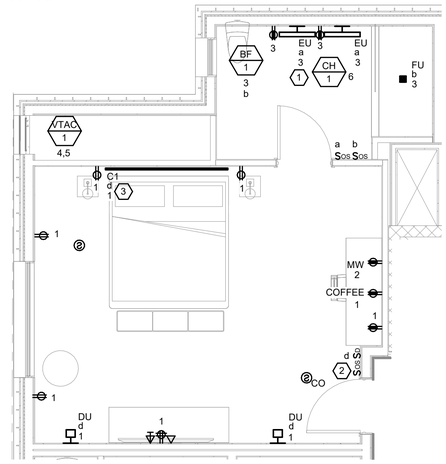

5 ELECTRICAL ENLARGED GUEST ROOM TYPE 13

SCALE: 1/4" = 1'-0"

GENERAL NOTES

1. SEE SHEET E0.0 FOR LEGEND AND ADDITIONAL GENERAL NOTES.
2. TELEPHONE WALL OUTLET SHALL BE MOUNTED AT 46" AFF TO THE CENTERLINE OF THE DEVICE UNO. JACKS AND CABLE TO BE PROVIDED AND INSTALLED BY TELECOMMUNICATIONS DESIGN/BUILD CONTRACTOR.
3. INSTALL TELEVISION RECEPTACLE AND COAXIAL OUTLET AT 60" AFF. COORDINATE EXACT LOCATION WITH ARCHITECT. JACKS AND CABLE TO BE PROVIDED AND INSTALLED BY TELECOMMUNICATIONS DESIGN/BUILD CONTRACTOR.
4. CONTRACTOR MEANS AND METHODS UTILIZED TO INSTALL WIRING DEVICES WITHIN 1-HOUR RATED WALLS, SUCH HAS STAGGERED SPACING OF BACK-TO-BACK DEVICES AND/OR USE OF FIRE RATED PUTTY PADS, SHALL MAINTAIN WALL RATING.
5. PROVIDE ELECTRICAL CONNECTION TO DWELLING UNIT CONDENSING UNITS LOCATED ON BUILDING ROOFTOP. RE: BUILDING ROOF PLAN FOR CONDENSING UNIT LOCATIONS AND MECHANICAL EQUIPMENT SCHEDULE FOR WIRING REQUIREMENTS.
6. COORDINATE LOCATION AND MOUNTING HEIGHTS OF ELECTRICAL DEVICES IN MILLWORK WITH ARCHITECT/OWNER PRIOR TO ROUGH-IN.
7. CONFIRM MOUNTING HEIGHT AND LOCATION OF ALL LUMINAIRES AND DEVICES WITH ARCHITECT PRIOR TO ROUGH IN.
8. COORDINATE EXACT ELECTRICAL REQUIREMENTS AND LOCATIONS OF MECHANICAL AND PLUMBING EQUIPMENT WITH MECHANICAL AND PLUMBING CONTRACTOR PRIOR TO ROUGH-IN.
9. RECEPTACLES INDICATED TO BE MOUNTED ABOVE COUNTER SHALL BE MOUNTED HORIZONTALLY 6" ABOVE COUNTER TO THE CENTERLINE OF THE DEVICE UNO.
10. COUNTERTOP RECEPTACLES SHALL BE INSTALLED AT 6" ABOVE THE BACK SPLASH TO THE CENTERLINE OF THE DEVICE UNO.
11. ALL RECEPTACLES WITHIN 6' OF A SINK SHALL BE GFCI.
12. GFCI PROTECTION IS INDICATED AS REQUIRED. GFCI TRIP SWITCH SHALL BE IN ACCESSIBLE LOCATION, EITHER AT ACCESSIBLE RECEPTACLE, A REMOTE-MOUNTEDGFCI SWITCH, OR AT CIRCUIT BREAKER. DO NOT PROVIDE GFCI PROTECTION IN TWO LOCATIONS.
13. ALL 120V RECEPTACLES TO BE TAMPER-PROOF.
14. WHERE BOTH AFCI AND GFCI PROTECTION ARE REQUIRED, PROVIDE PROTECTION AT CIRCUIT BREAKER. DO NOT PROVIDE PROTECTION IN MORE THAN ONE LOCATION. REFER TO LOAD CENTER SCHEDULE(S) FOR FURTHER INFORMATION.
15. NUMBERS ADJACENT TO DEVICES ON ELECTRICAL ENLARGED GUEST ROOM PLANS INDICATE CIRCUITING. SEE ELECTRICAL POWER PLANS FOR BRANCH PANEL CIRCUITING.

KEYNOTES (THIS SHEET)

1. CH-1 COVE HEATERS LOCATED IN GUESTROOMS WITH RESTROOMS ON EXTERIOR WALL(S). COORDINATE EXACT LOCATION AND REQUIREMENTS WITH MECHANICAL DRAWINGS.

2. PROVIDE MASTER CONTROL SWITCH AT ENTRY WITH OCCUPANCY SENSORS LOCATED WHERE NECESSARY IN EACH ROOM/SPACE CAPABLE OF AUTOMATICALLY SWITCHING OFF ALL LUMINAIRES INSTALLED WITHIN HOTEL ROOM WITHIN 20 MINUTES OF OCCUPANTS LEAVING THE ROOM AS REQUIRED BY IECC C405.2.4.

Ramirez, Johnson, & Associates
3301 Lawrence St. Ste 2
Denver, CO 80205
P: 720.598.5774
HELTSHE
M1A MERIDIAN 105 ARCHITECTURE

CITY HOTEL

415 PERRY STREET, CASTLE ROCK, CO.

DATE: 05.20.2026	ISSUED FOR: 1st PERMIT COMMENTS	SHEET TITLE: ELECTRICAL ENLARGED UNIT PLANS	SHEET NUMBER E3.01
PROJ. NO. 2023.002			

COLORADO LICENSED
SAMIRA MIR
43565
05/27/2026
PROFESSIONAL ENGINEER

Autodesk Docs://2024-020 City Hotel/(20024) City Hotel - Elec.rvt
5/20/2026 9:03:56 AM

TAKE-OFF MARKUPS - LEGEND

Source: the take-off Excel (Partition Takeoff) · one PDF annotation (Line / PolyLine) per wall on the plan sheet where it was measured · Subject = type · Contents = TYPE · LF · H · SF · DETAIL · id

Sample	Type	Walls	LF	Marked	No geometry	Walls without geometry (not marked): 0
	CH.6-2 - BOARD ONLY (WOOD FRAMING EXCLUDED)	30	101.04	30	0	
	DW.4-1 - BOARD ONLY (WOOD FRAMING EXCLUDED)	49	962.39	49	0	
	FI.2-0 - BOARD ONLY (WOOD FRAMING EXCLUDED)	14	212.39	14	0	
	FI.6-0 - BOARD ONLY (WOOD FRAMING EXCLUDED)	8	265.50	8	0	
	FW.1-0 - BOARD ONLY (WOOD FRAMING EXCLUDED)	6	52.03	6	0	
	FW.2-0 - BOARD ONLY (WOOD FRAMING EXCLUDED)	41	387.45	41	0	
	FW.4-0 - BOARD ONLY (WOOD FRAMING EXCLUDED)	106	426.37	106	0	
	FW.6-0 - BOARD ONLY (WOOD FRAMING EXCLUDED)	21	149.26	21	0	
	W.4-0 - BOARD ONLY (WOOD FRAMING EXCLUDED)	229	1510.81	229	0	
	W.6-0 - BOARD ONLY (WOOD FRAMING EXCLUDED)	43	396.08	43	0	
	W.6-1 - BOARD ONLY (WOOD FRAMING EXCLUDED)	13	107.02	13	0	
	W.6-2 - BOARD ONLY (WOOD FRAMING EXCLUDED)	16	118.34	16	0	
	W.62-1 - BOARD ONLY (WOOD FRAMING EXCLUDED)	88	1462.47	88	0	
	XW.6.2-0 - BOARD ONLY (WOOD FRAMING EXCLUDED)	1	9.33	1	0	
	XW.6.2-2 - BOARD ONLY (WOOD FRAMING EXCLUDED)	2	19.82	2	0	
	XW.6.3-0 - BOARD ONLY (WOOD FRAMING EXCLUDED)	5	146.30	5	0	
	XW.6.3-2 - BOARD ONLY (WOOD FRAMING EXCLUDED)	41	1312.75	41	0	
	XW.6.4-0 - BOARD ONLY (WOOD FRAMING EXCLUDED)	2	20.43	2	0	
	XW.6.4-2 - BOARD ONLY (WOOD FRAMING EXCLUDED)	8	64.86	8	0	
	XW.6.6-0 - BOARD ONLY (WOOD FRAMING EXCLUDED)	7	82.29	7	0	
	XW.6.6-1 - BOARD ONLY (WOOD FRAMING EXCLUDED)	8	85.90	8	0	
	XW.6.6-2 - BOARD ONLY (WOOD FRAMING EXCLUDED)	27	404.69	27	0	
	TOTAL	**765**	**8297.52**	**765**	**0**	